

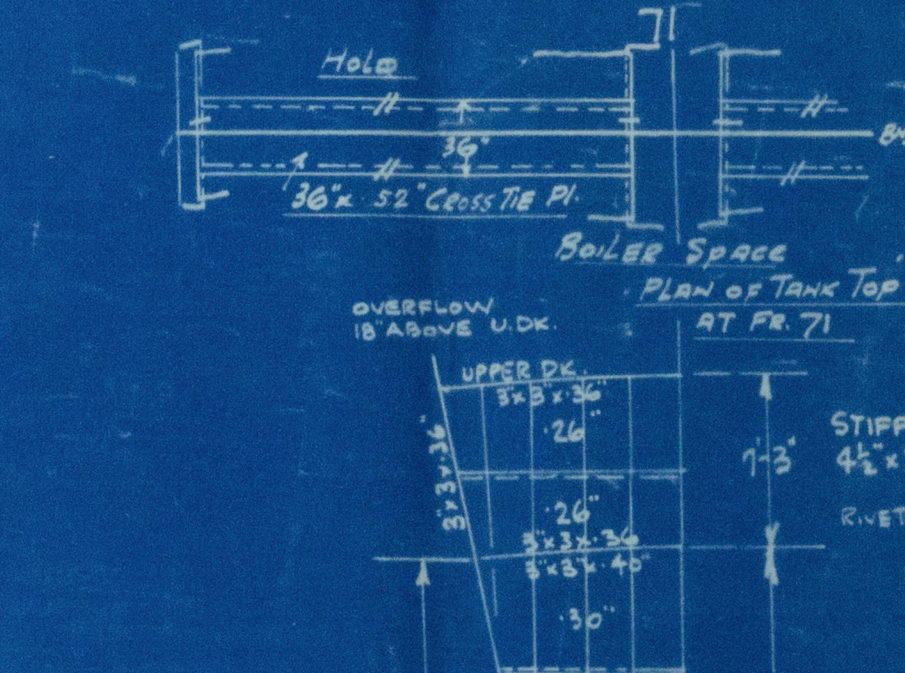
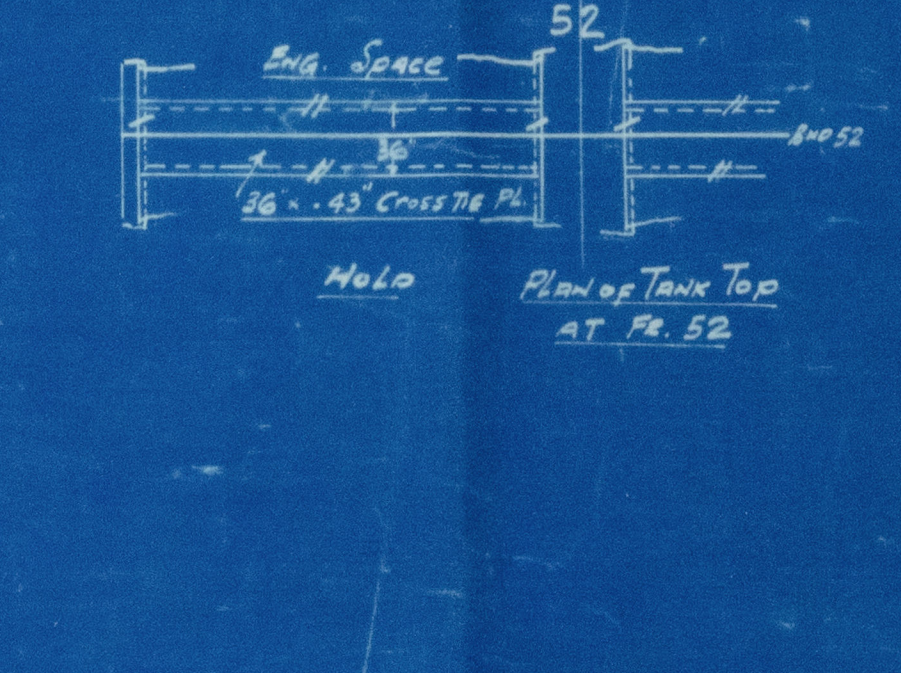
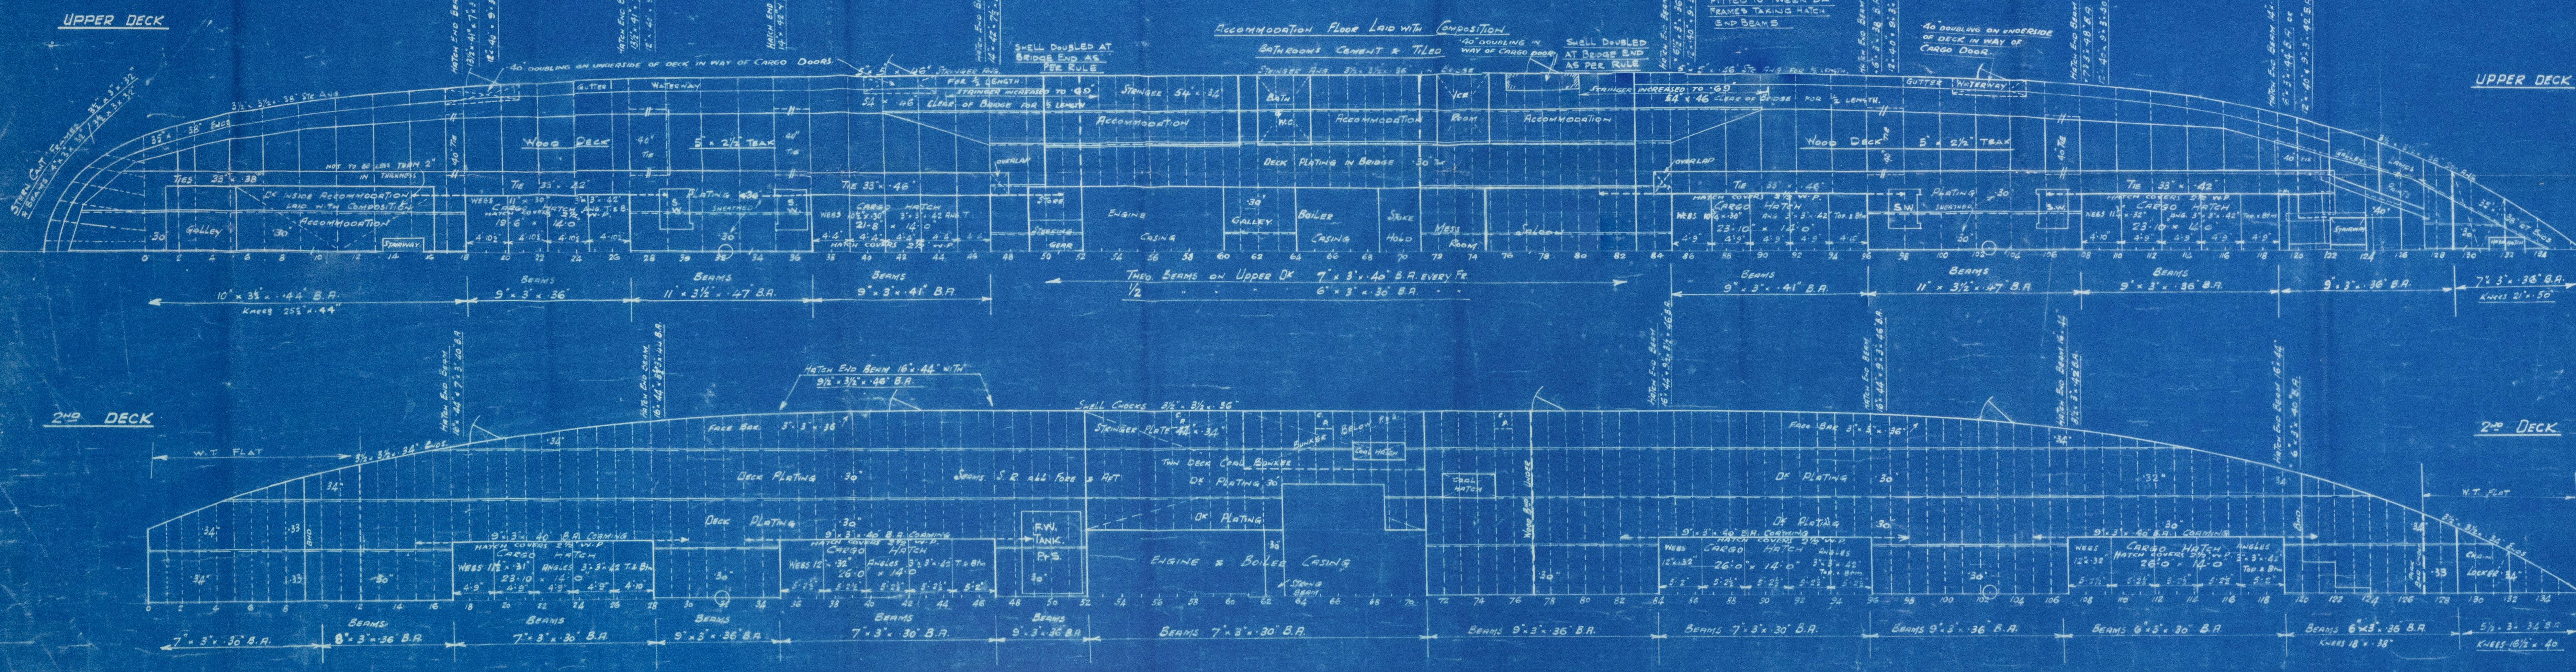
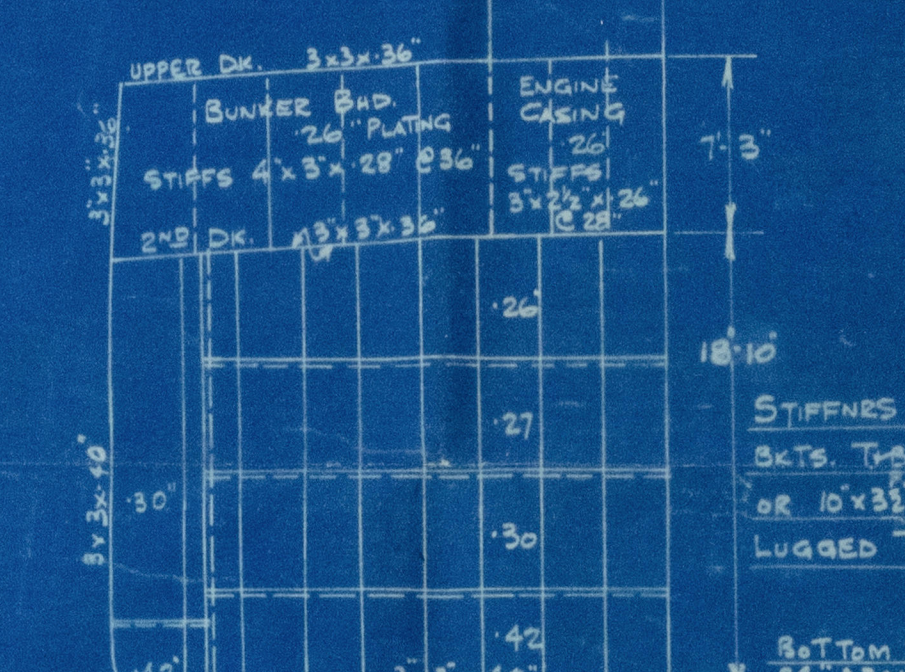
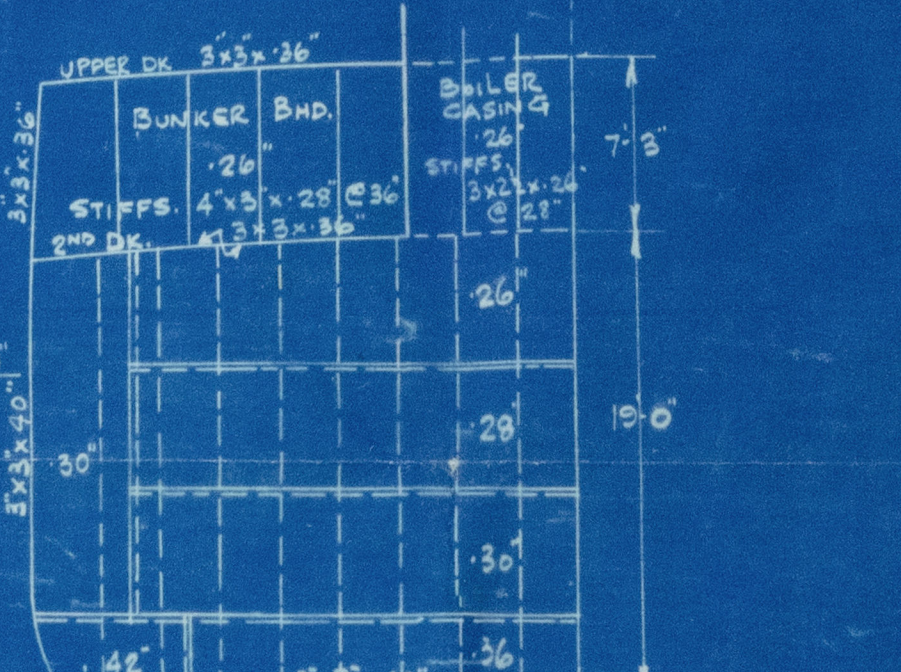
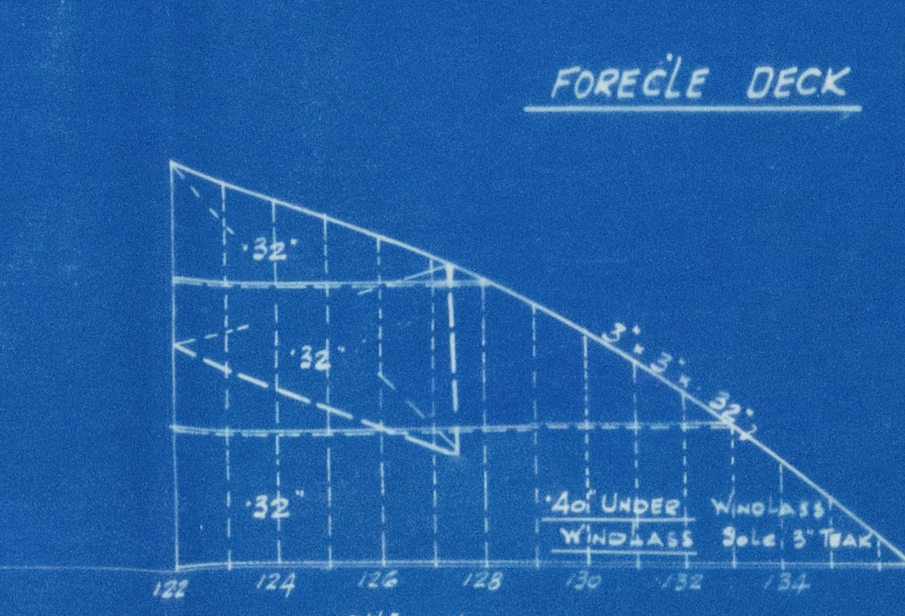


**PROFILE & DECK PLAN**  
**S.S. SANDVIKEN, No. 394.**

Scale 1/8" = 1 Ft  
 Rule Dimensions: Length 294'-0", Breadth 45'-6", Depth Mid 28'-3"  
 295'-0" B.P.  
 To Class 100 A.I. LLOYDS with FREEBOARD  
 CORRESPONDING TO A DRAFT OF 19'-6" MOULDED.

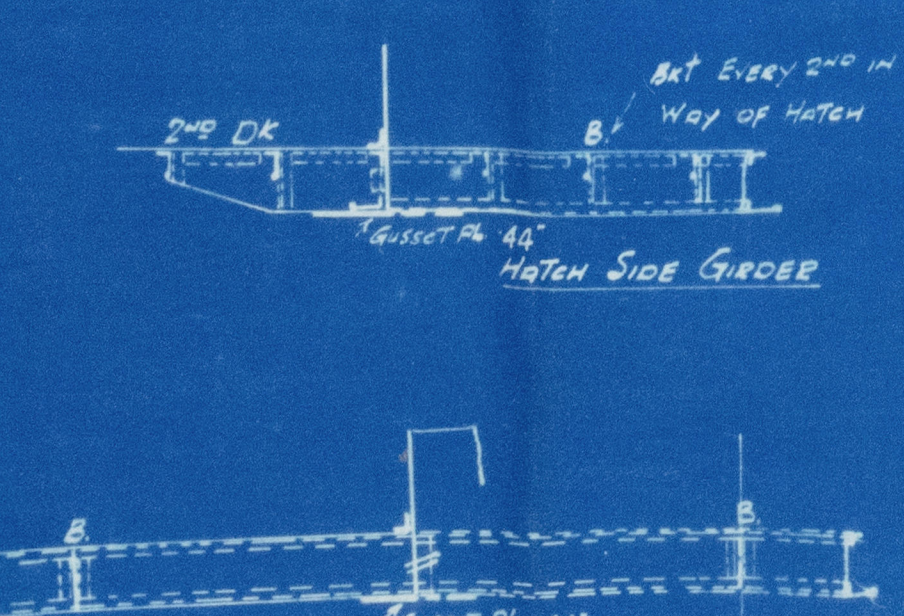

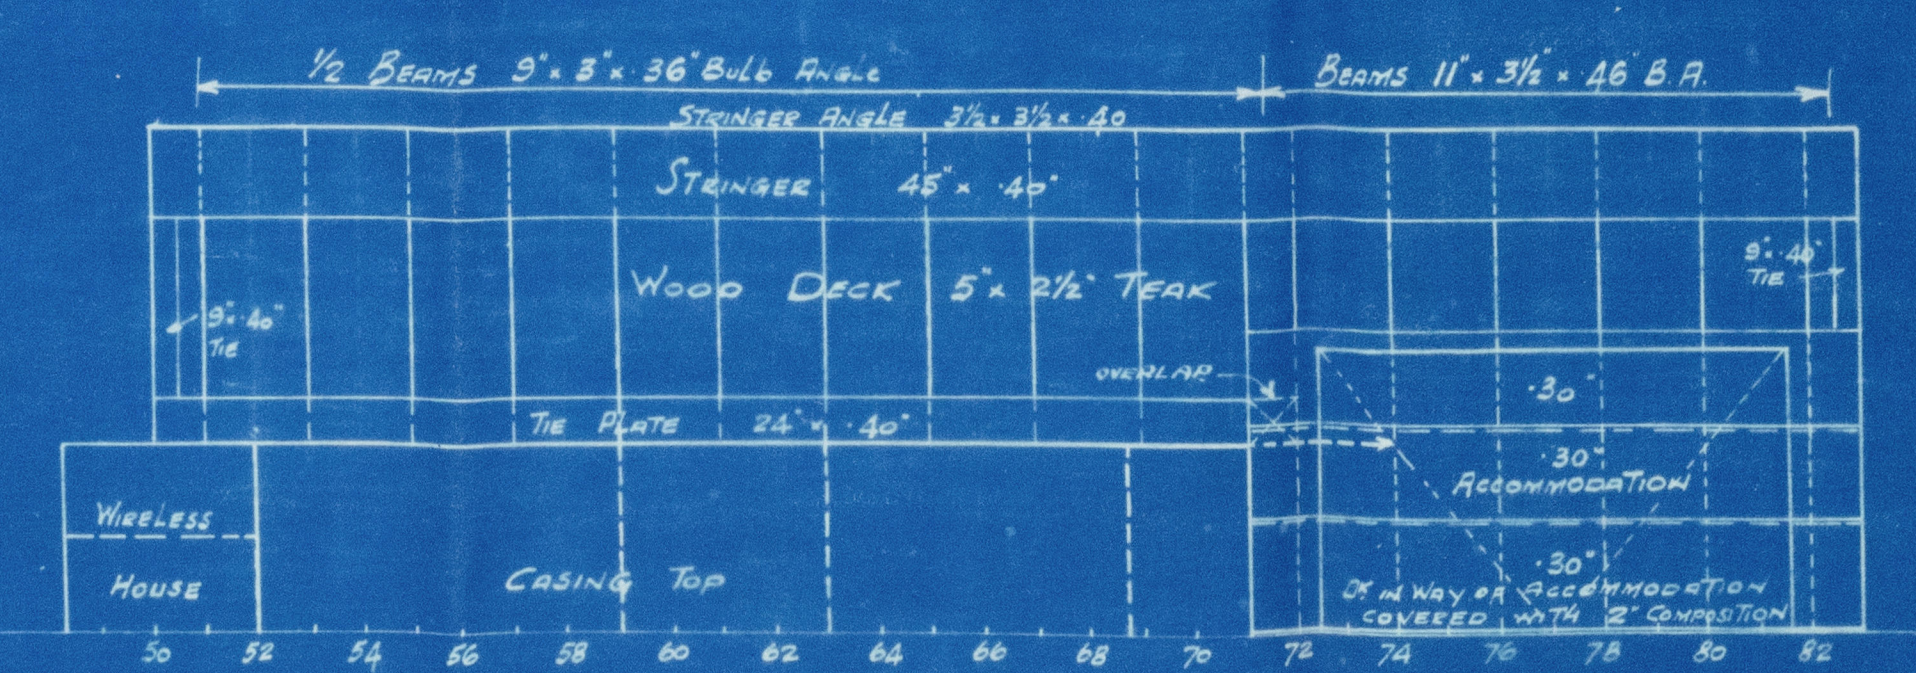

WM HAMILTON & Co

N<sup>o</sup> 394

S. S. SANDVIKEN

PROFILE & DECKS  
As BUILT

GRNK REPORT N<sup>o</sup> 18503.



© 2021

Lloyd's Register  
Foundation

010189-010199-0183