

OVERALL LENGTH 300'-0"
 LENGTH BETW. PERRS. 291'-3"
 BREADTH MOLO. 43'-4"
 DEPTH 21'-0"

M.S. DOLOMITE 4"

DOLOMITE MARINE CORP. - ROCHESTER, N. Y.

MIDSHIP SECTION

Draw. # D4-1	Date 5-15-37
Drawn by P.W.	Revised 1-37
Scale 1/4" = 1 FT.	Revised

010200-010207-0175

M. Nickelner

DOLomite 4.


MIDSHIP SECTION
(AS BUILT)

010200- 010207- 0175



© 2020

Lloyd's Register
Foundation

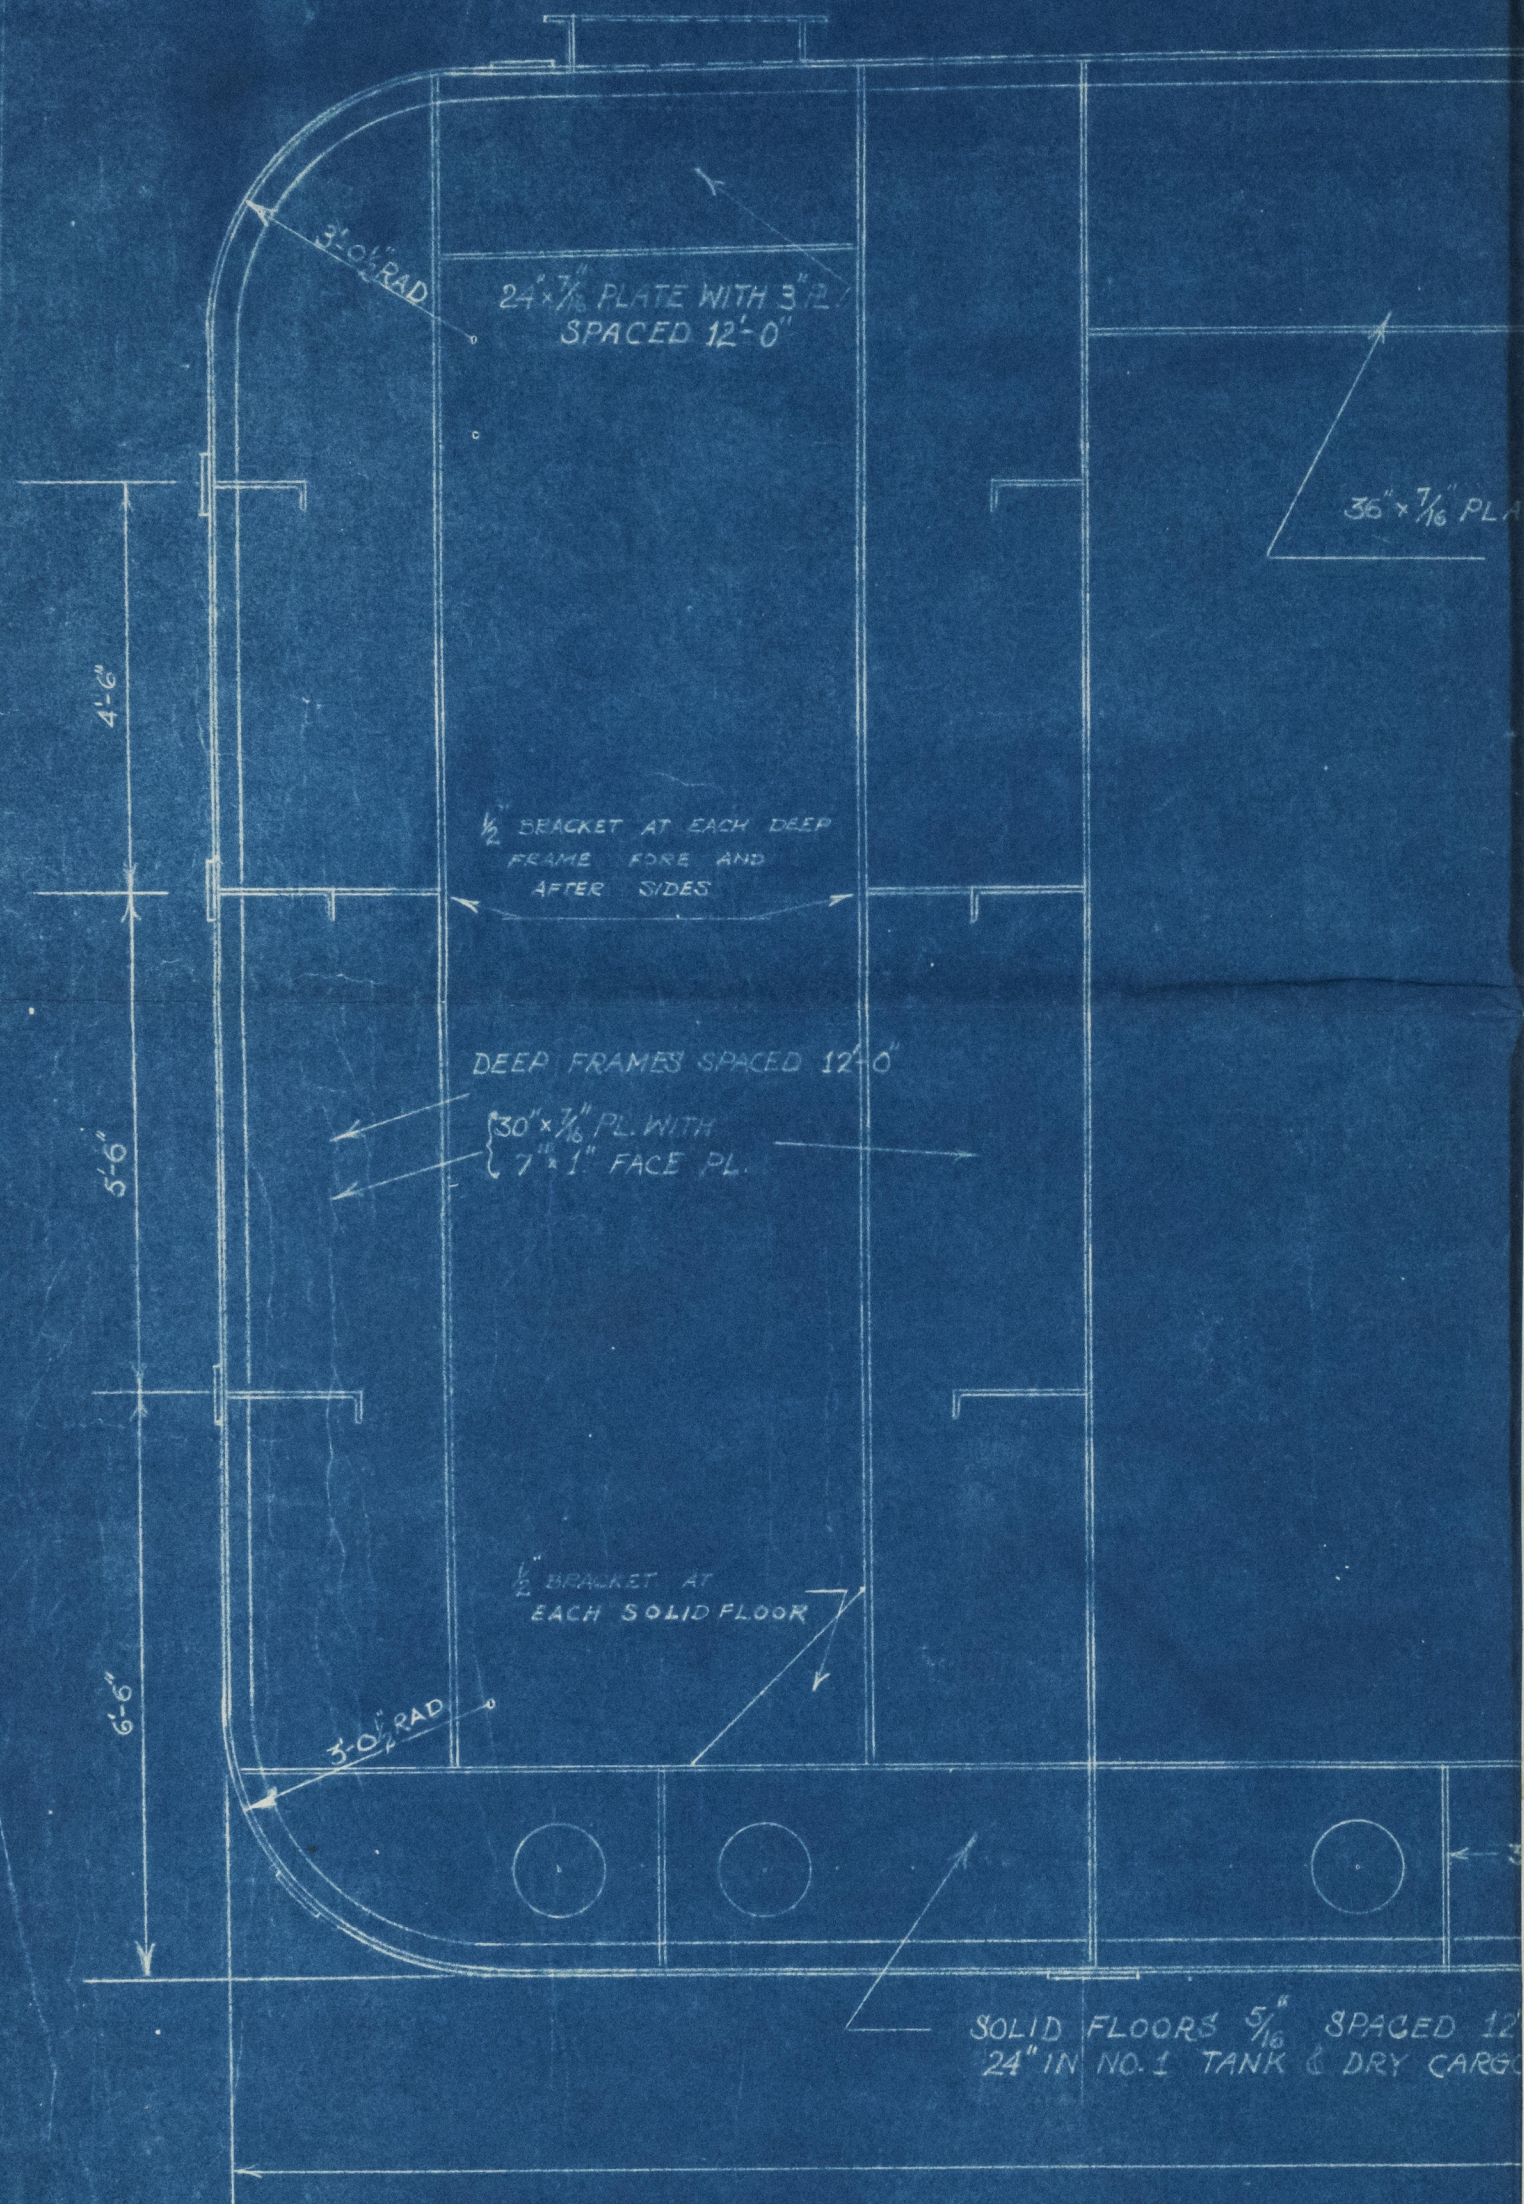

72h
 18 18 18 18
 174 174 174 174