


12 Oct 1945

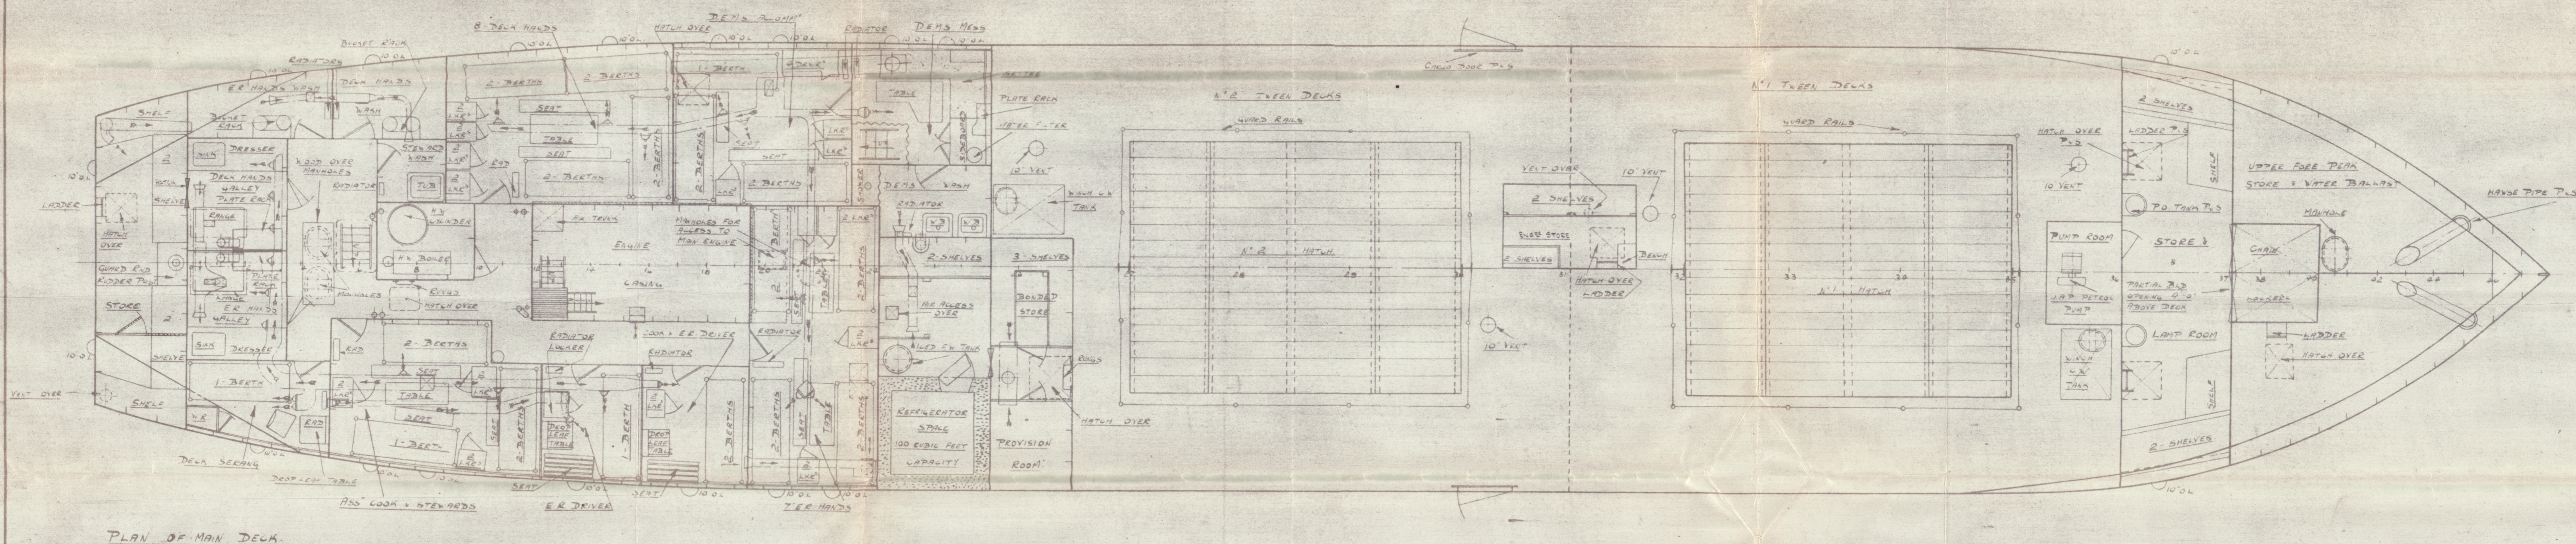

"EMPIRE SEALION"
A/MS. NO. 1119

RICHARD DUNSTON LTD.
SHIPBUILDERS,
THORNE, YORKSHIRE

DRAWN BY <i>bf</i>	DATE 31-5-45
TRACED BY <i>bf</i>	DATE 6-7-45
CHECKED BY	DATE

REVISIONS		
No.	DATE	PARTICULARS

This Drawing and the Information it contains are the Property of RICHARD DUNSTON LTD.
It is not to be Traced, Copied or Published without their Written Consent, nor is the
Information thereon to be misused in any way.

YARD No. S. 473

DRG. No. 4 500/298

TITLE: GENERAL ARRANGEMENT (AS FITTED)

SCALE :- $\frac{1}{4}$ TO ONE FOOT

© 2021
Lloyd's Register
Foundation

010308-010318-031

2

General Argt. - Decks

R Dunston Ltd

No. 5473.

As built

EMPIRE SEALION NOW SERUDOM.

General Argt. (SHEET 2)
R. Dunston 473.

12 OCT 1945

"Empire Sealion"

Sealion

473②

