

# MOTORCOASTER OF 425 M.TONS D.W.

MOTOR SHIP FOR THE CLASS 100A1  
LLOYD'S REG. OF SHIPPING  
THE SCANTLINGS BEING SUITABLE FOR A SUMMER MOULDED DRAFT OF ABOUT 2.88

## PRINCIPAL DIMENSIONS:

LENGTH BETWEEN PERPENDICULARS	49.00 M.
BREADTH MOULDED	9.40 "
DEPTH MOULDED TO MAIN DECK	2.95 "
DEPTH MOULDED TO SHELTER DECK	5.05 "
DRAUGHT (FULL LOAD)	2.88 "

ALL FRAME SPACINGS 550%

EQUIPMENT NUMBER 750, TABLE 53, LETTER .I.

## EQUIPMENT LIST:


3 - 735 KILLO BOWER ANCHORS, TEST LOAD	16290 KILOS
1 - 215 ... STREAMANCHOR (EXCEPTED STOCK) TEST LOAD	6690 KILOS
385 METRES OF 30% STUD LINKED ANCHOR CHAIN, TEST LOAD	25520 KILOS
110 ... 75% CIRC. STREAM STEEL WIRE CABLE BREAKING LOAD	18900 KIL.
135 ... 70% ... TOWLINE	15450 "
165 ... 152% ... HAWSER MANILLA ROPE	9100 "
165 ... 57% ... STEEL WIRE CABLE	11000 "

## PLATING CONNECTIONS:

DECKS AND TANKTOP: ALL SEAMS AND ENDLAPS WELDED  
SHEEL PLATING: ALL ENDLAPS WELDED  
ALL SEAMS RIVETED

## WELDING:

6/75 - CHAIN INTERMITTENT	180	75	6 - THE SIDES OF FILLETS
12/180 - STAGGERED	180	75	ITEM
1/6 - DOUBLE CONTINUOUS FILLED WELDS			ITEM

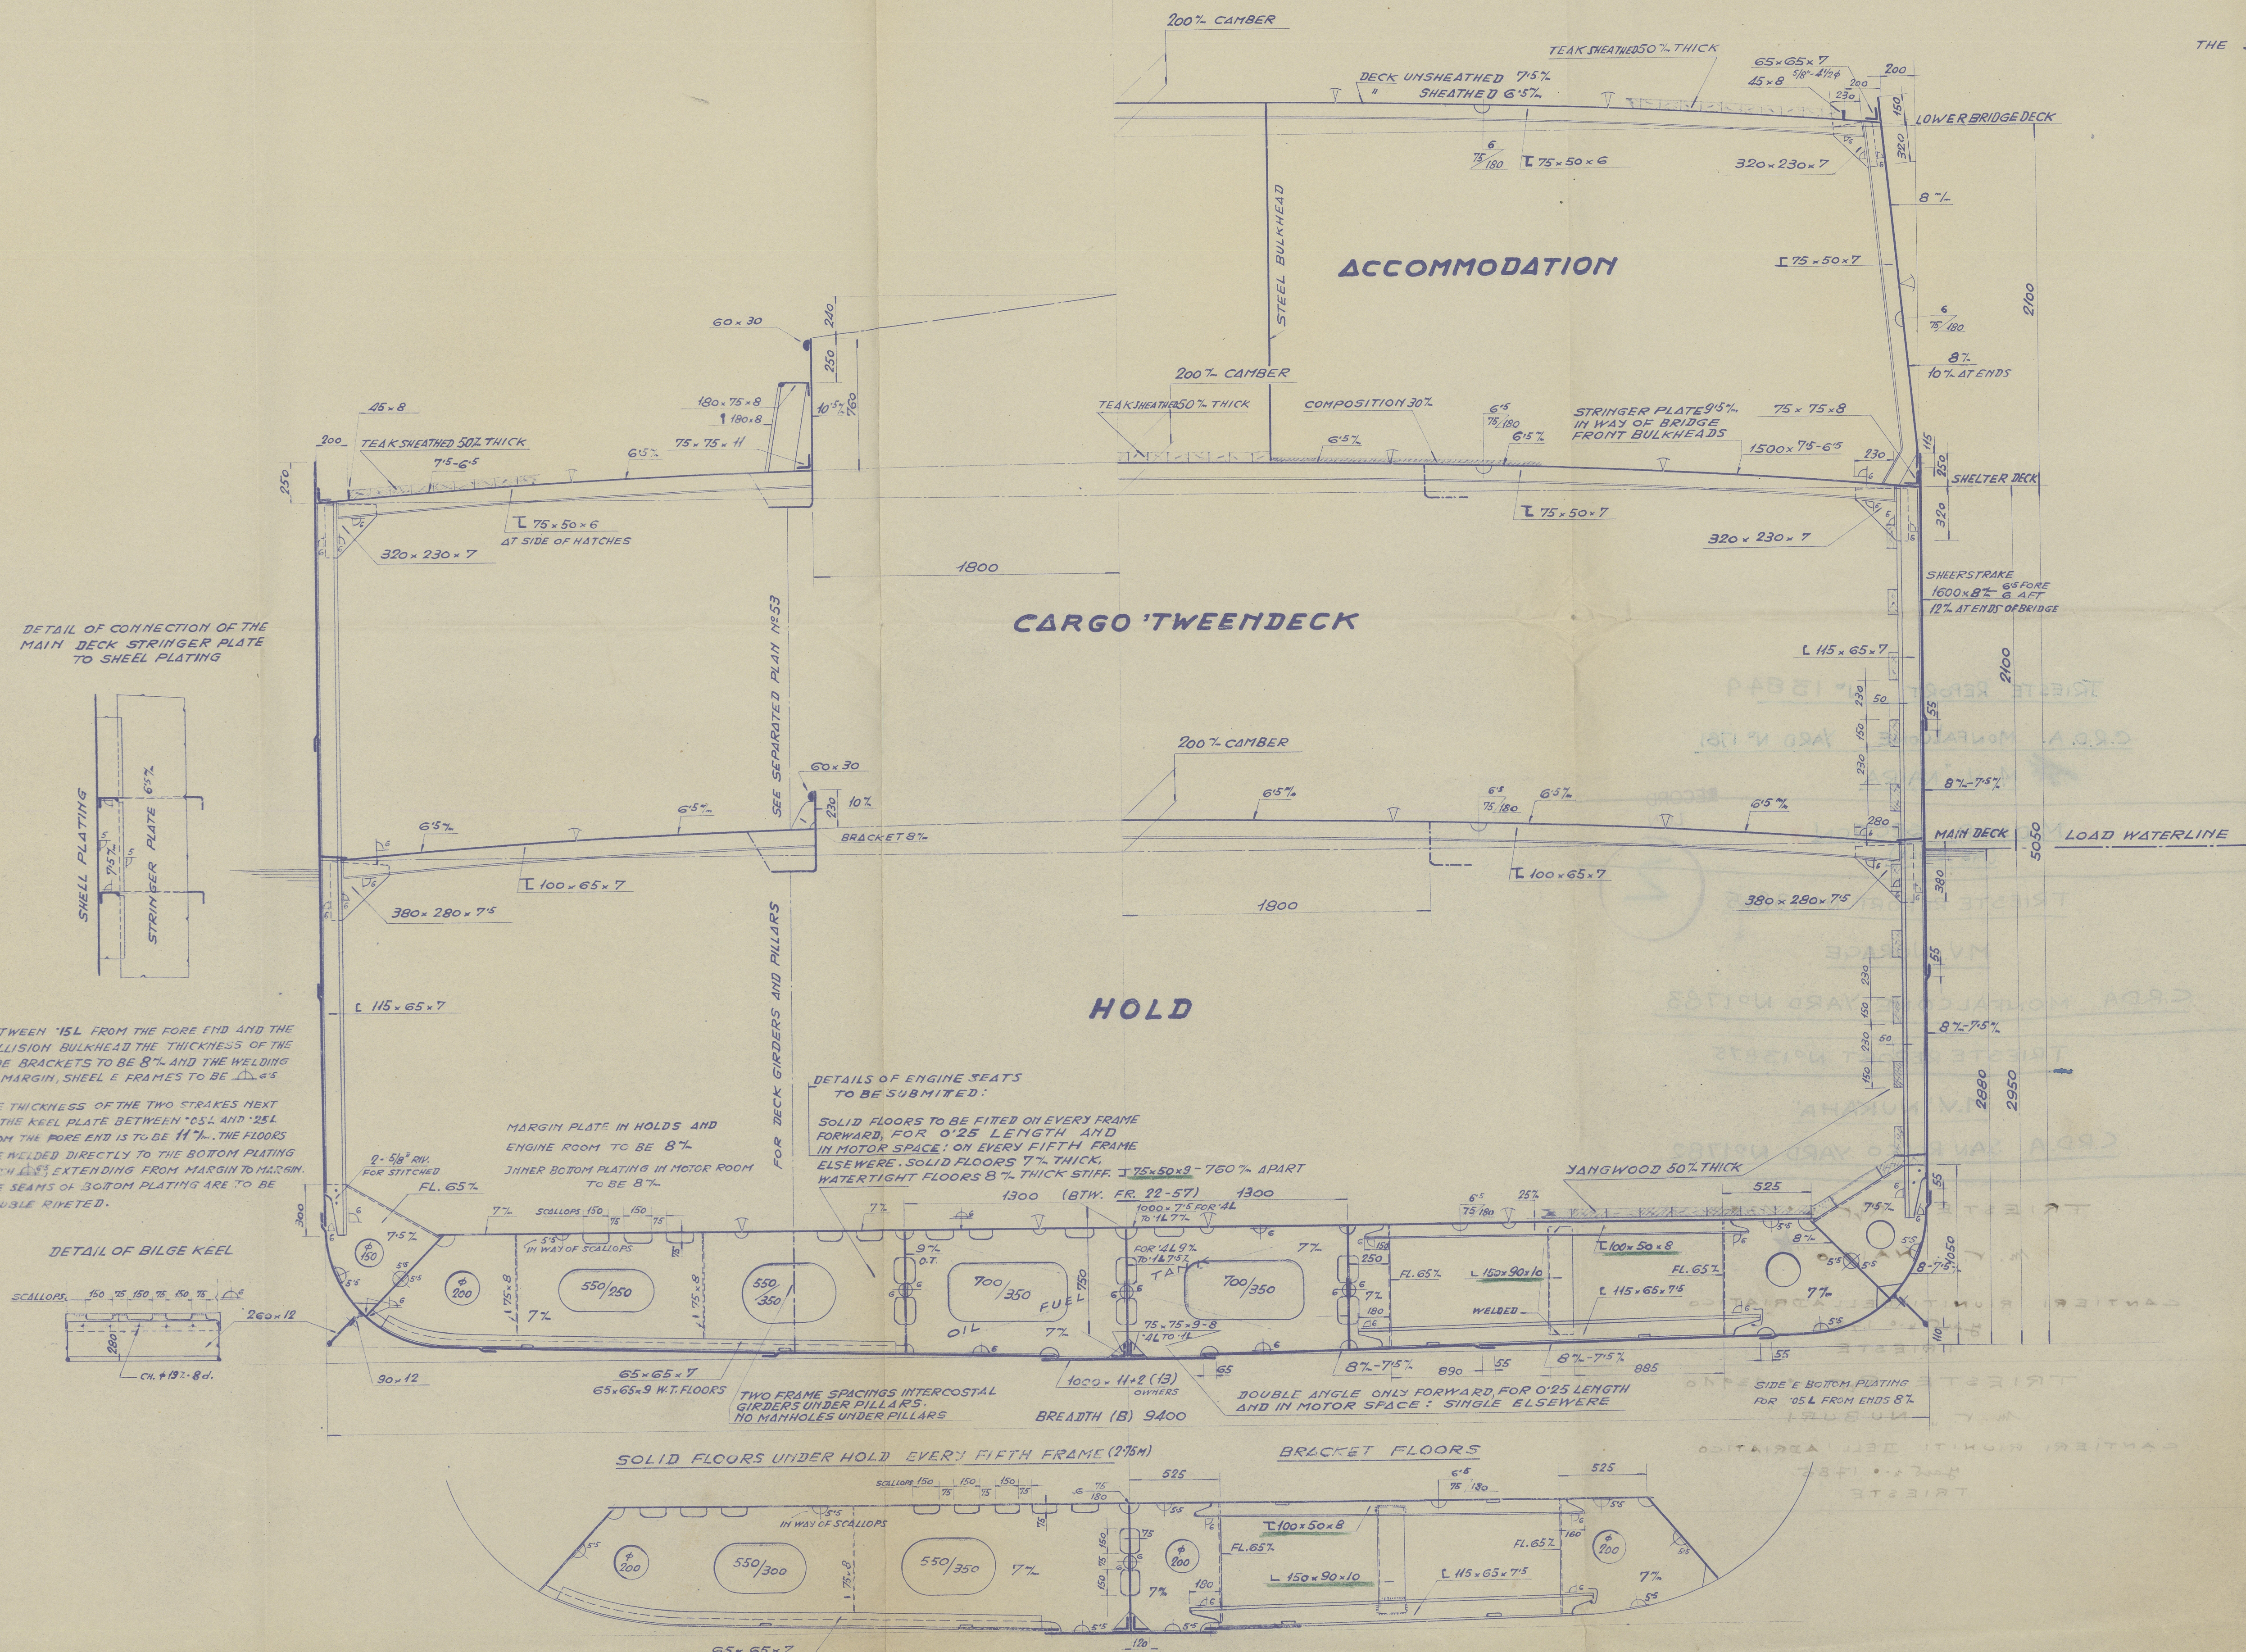



TRIESTE REPORT N° 13849

C.R.D.A. MONFALCONE YARD N° 1781

~~M.V.~~ M.V. "NAIRA"

RECORD

LON

X MIDSHIP SECTION X  
(AS BUILT)

TRIESTE REPORT N° 13865

M.V. NURAGE

C.R.D.A. MONFALCONE YARD N° 1783

TRIESTE REPORT N° 13875

M.V. "NUKAHA"

C.R.D.A. SAN ROCCO YARD N° 1782

TRIESTE R.F. N° 13902

M.V. "NAIKO" ★

CANTIERI RIUNITI DELL'ADRIATICO  
Yard N° 1784  
TRIESTE

TRIESTE R.F. N° 13910

M.V. "NUBURI"

CANTIERI RIUNITI DELL'ADRIATICO  
Yard N° 1785  
TRIESTE



© 2021

Lloyd's Register

010355 Foundation 0262