


GROOTSPANT

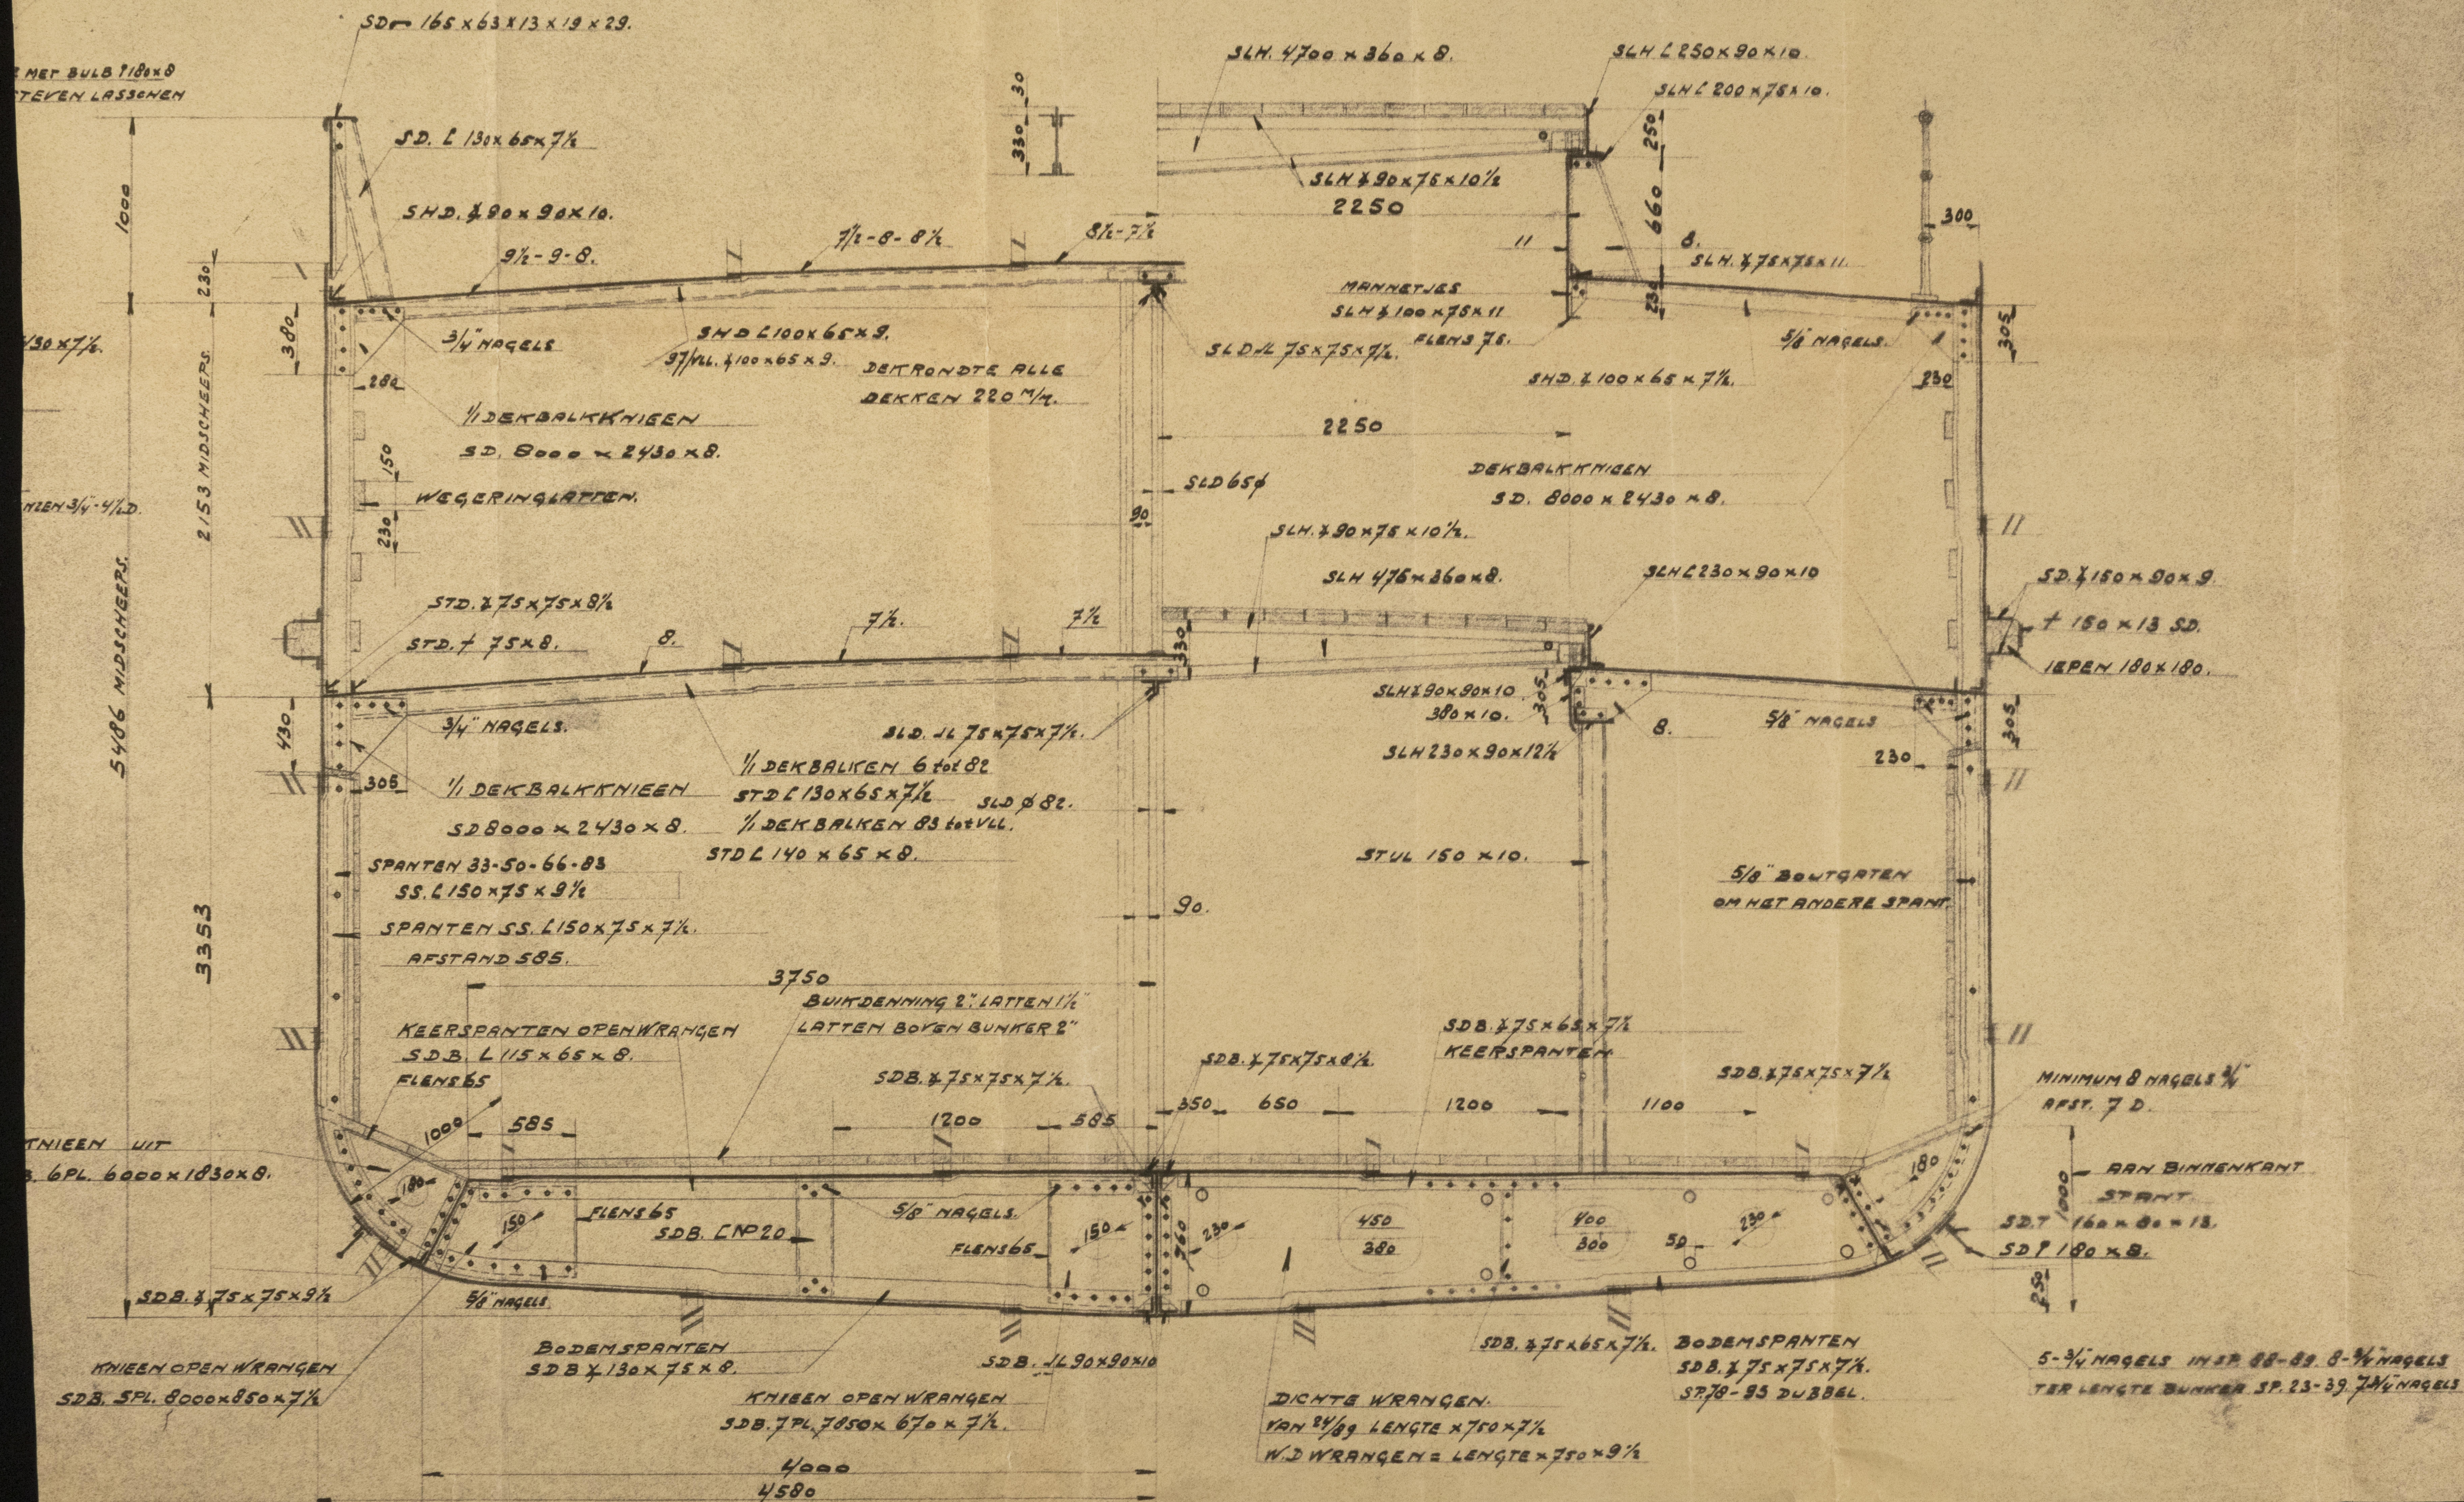

LONDON.

M/S "SCOTTISH CO-OPERATOR"

ROTTERDAM RPT. 24493.

MIDSHIP SECTION

(AS BUILT)

ROT. LETTER M. 18-2-39.



010461-010465-0003

© 2021

Lloyd's Register
Foundation