

"AMHERST ISLANDER"

As Built.

ELECTRICALLY
WELDED STEEL MOTOR FERRY
FOR
AMHERST ISLAND SERVICE
FOR THE
ONTARIO DEPARTMENT OF HIGHWAYS
TORONTO, ONTARIO

MIDSHIP SECTIONS

SCALE 1/2" = 1'-0"


PRINCIPAL PARTICULARS
LENGTH B.P. 99'-6"
LENGTH O.A. 106'-0"
BREADTH MLD. 37'-6"
DEPTH MLD. 10'-0 1/2"
DRAFT LOADED 6'-6"

CLASSIFICATION

VESSEL TO BE BUILT TO THE REQUIREMENTS
OF LLOYD'S REGISTER OF SHIPPING CLASS "A1".
FOR SERVICE BETWEEN AMHERST ISLAND & MILHAVEN ONTARIO
WITH THE NOTATION "ELECTRICALLY WELDED"

EQUIPMENT

1 DANFORTH ANCHOR 350# + 1 SPARE DANFORTH ANCHOR 350# READILY AVAILABLE ACHORE
60 FATHOMS 5/8" BBB CHAIN.
HAWERS 60 FATHOMS 4 CIRC. MANILA ROPE
MOORING LINES 3/4" 85 FEET EACH; 5" CIRC. MANILA ROPE.

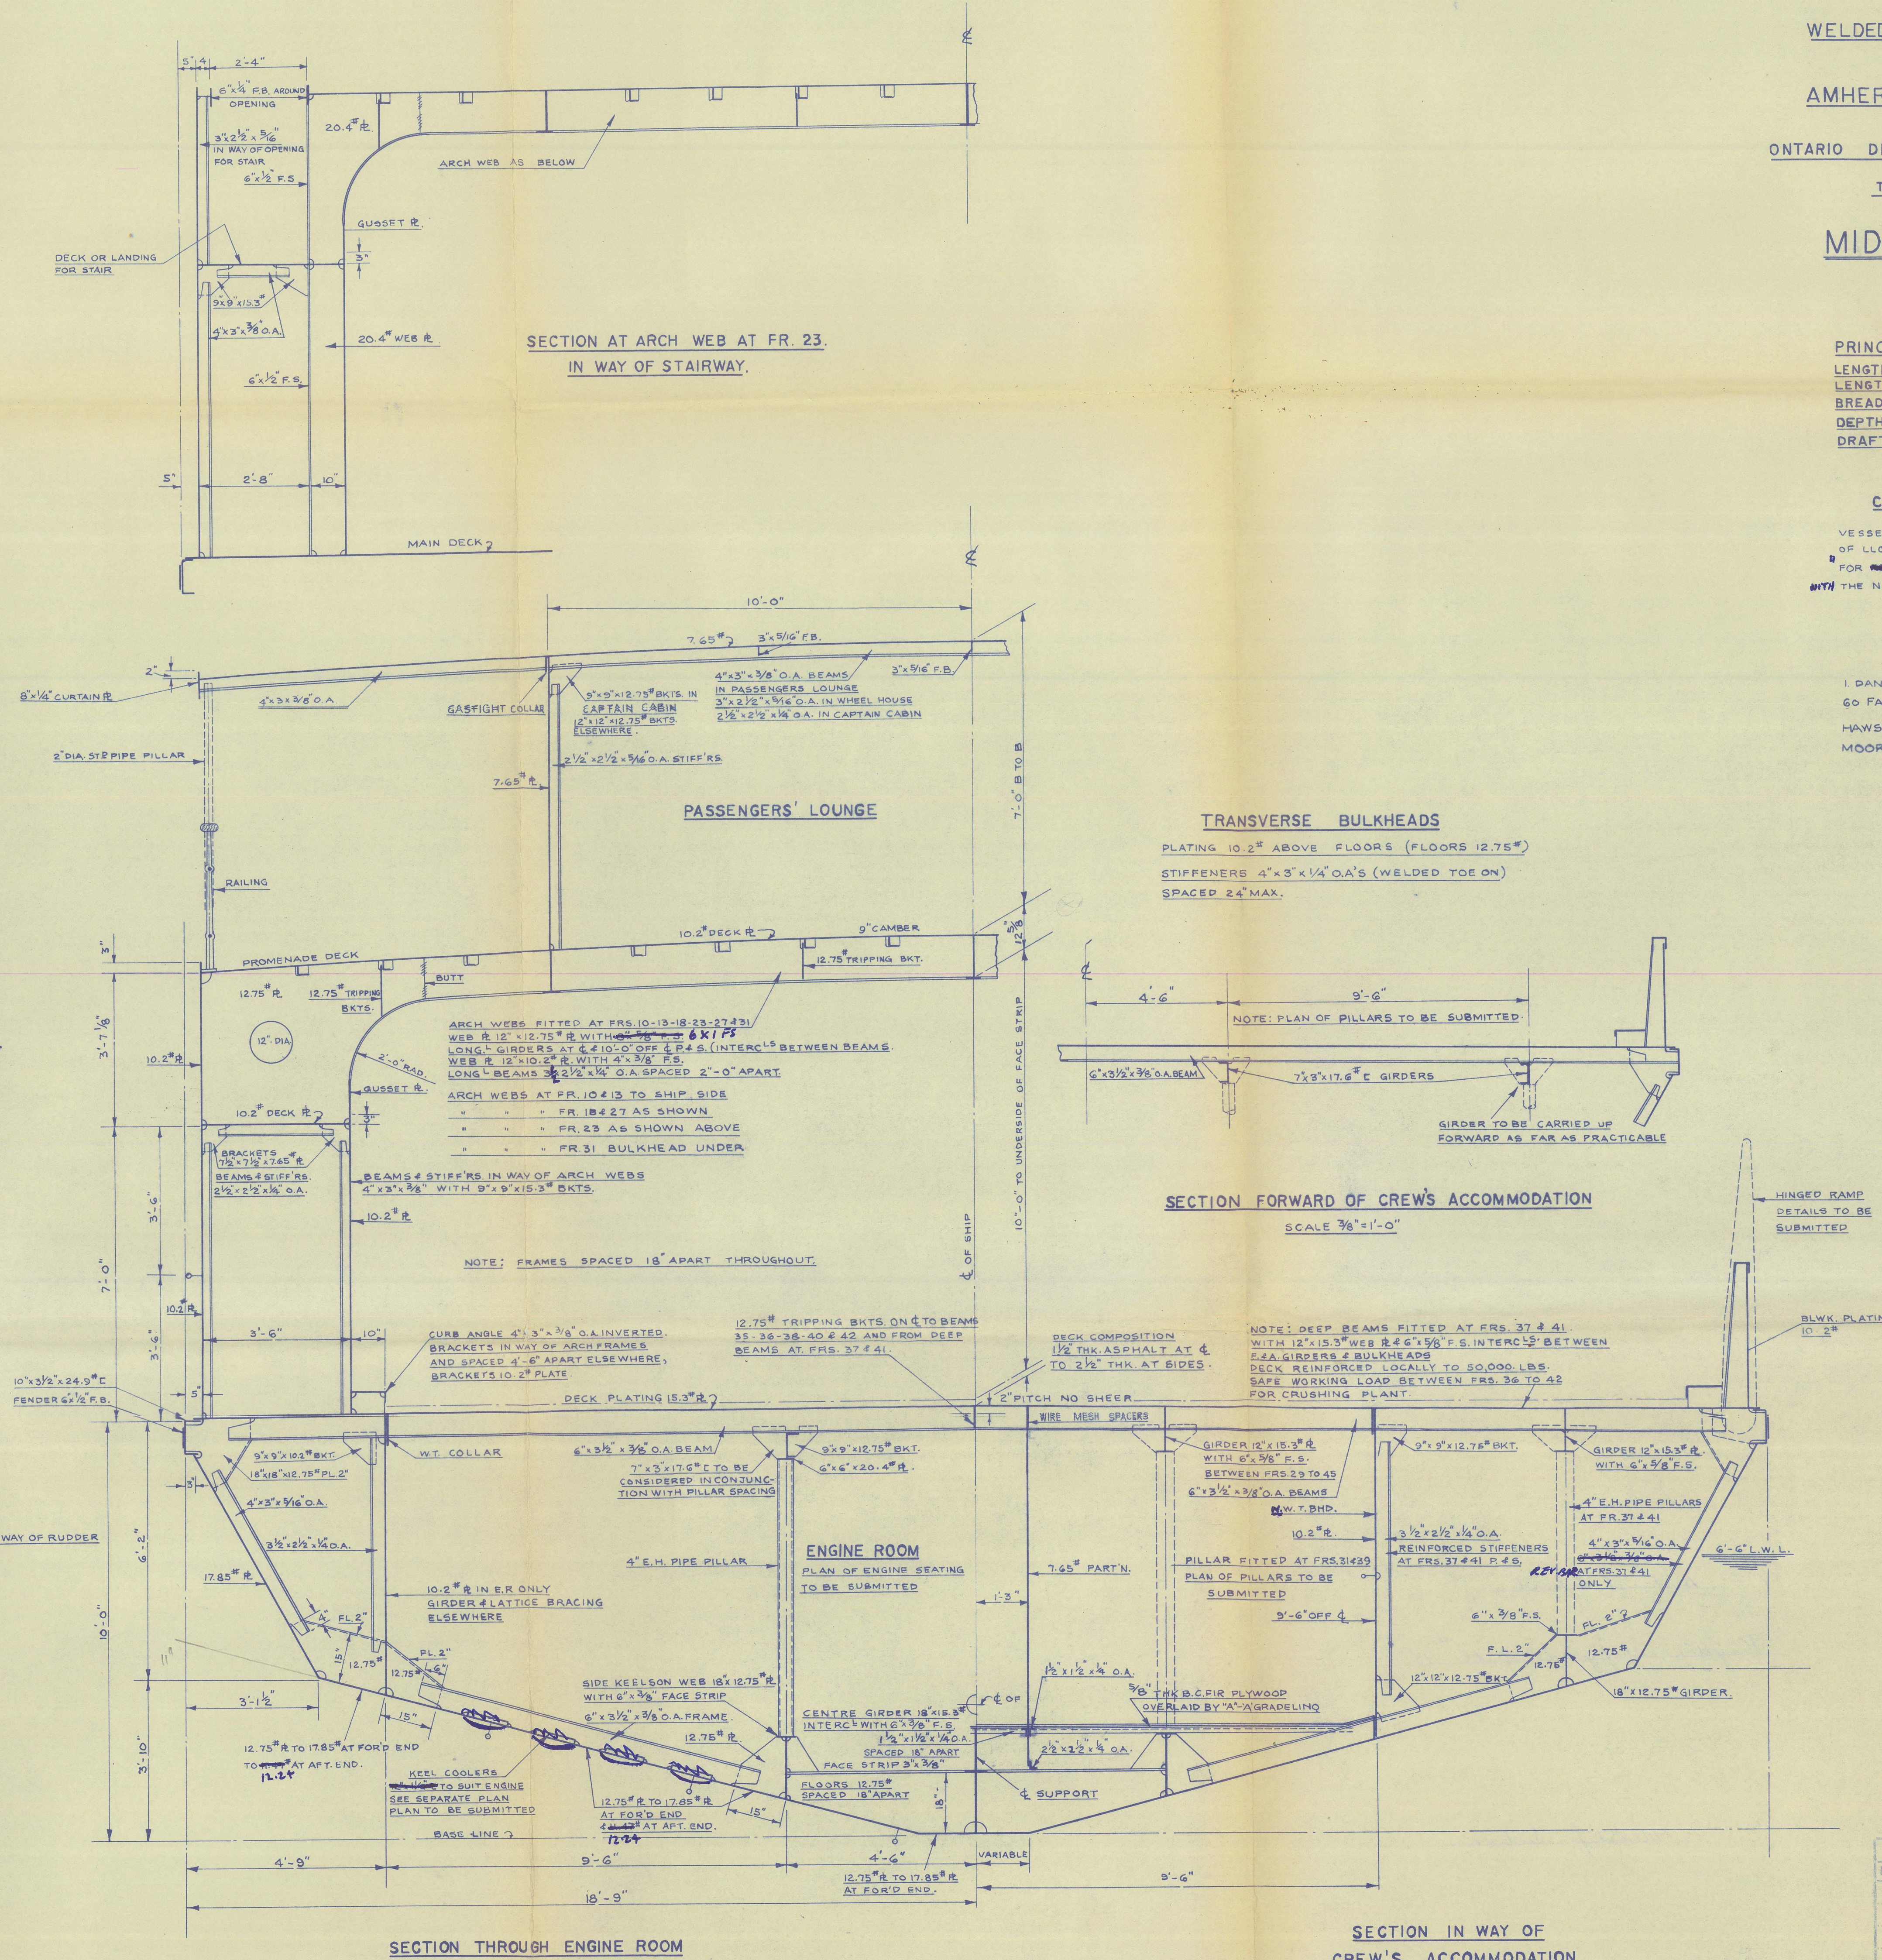

PRINTS			
No.	DEPT.	DATE	RETD.

THE COLLINGWOOD SHIPYARD LIMITED
KINGSTON, ONTARIO
No. 67417
Date 12-7-55

MIDSHIP SECTION

DRAWING No. 48-K-3
FILE
DATE DEC. 29 - 1954

DRAWN BY
TRADED BY R.I.
CHECKED BY

010545-5010553-0184

* "Amherst Islander" *

Kingston Shipyards' Hull # 48

as Built

Midship Section

①

RECORDS DEPT.:
LONDON.

MONTREAL Rpt. 10665

③



© 2021

Lloyd's Register
Foundation

010545-010553-0184