

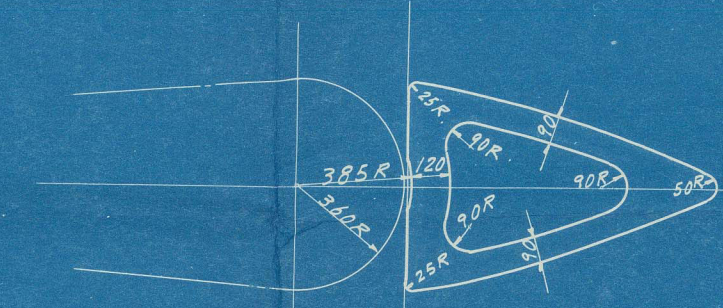


(A) SECTION

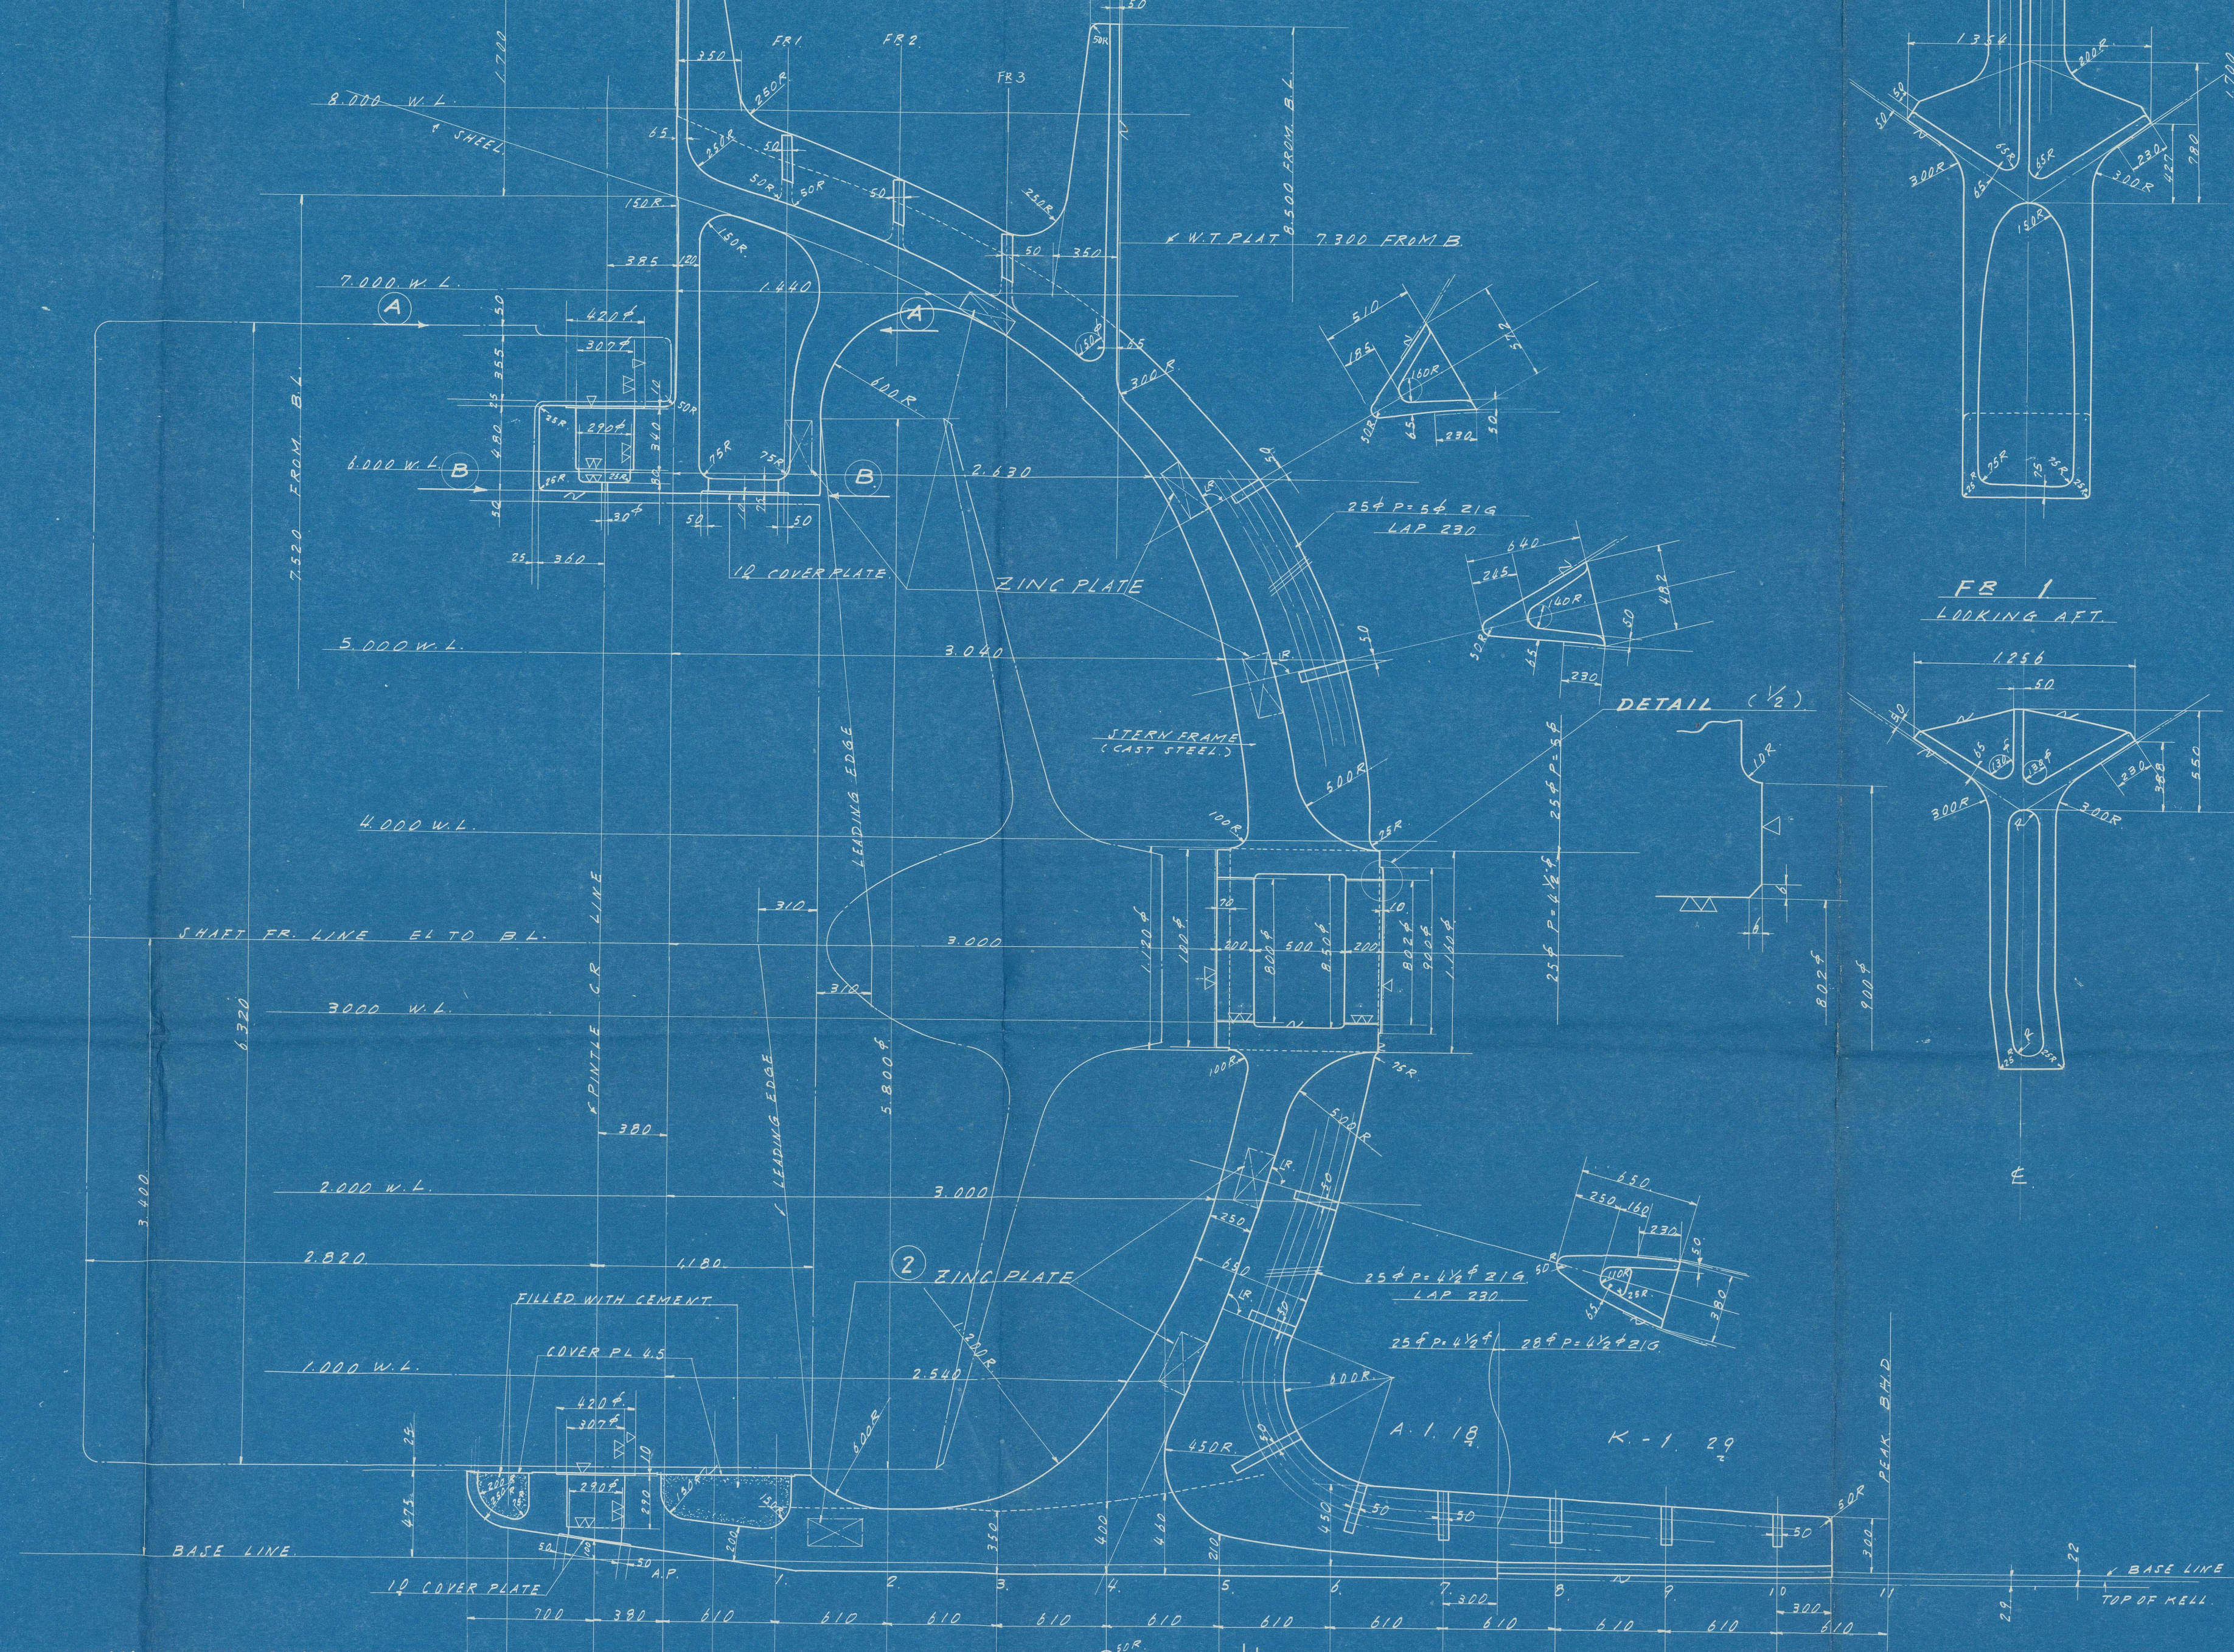


(B) SECTION

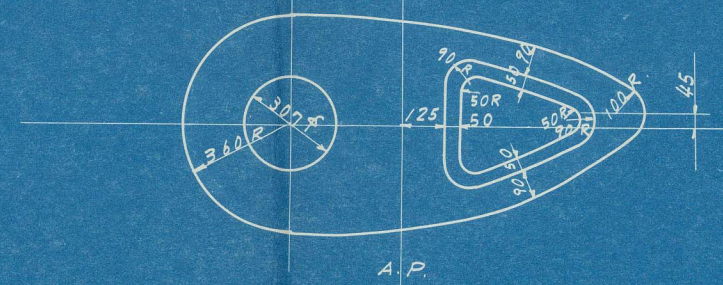


DETAIL OF ZINC PLATE (1/10)




PLAN

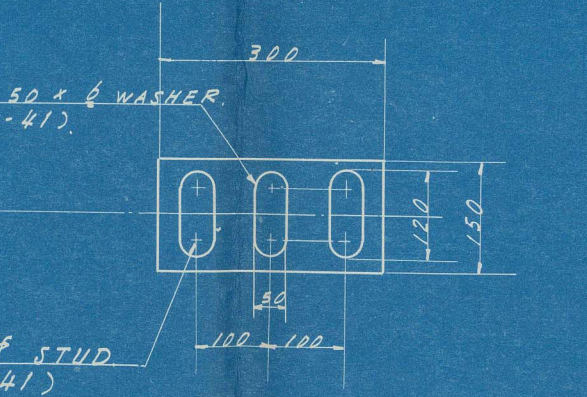


FR 0 (A.P.)
LOOKING AFT.

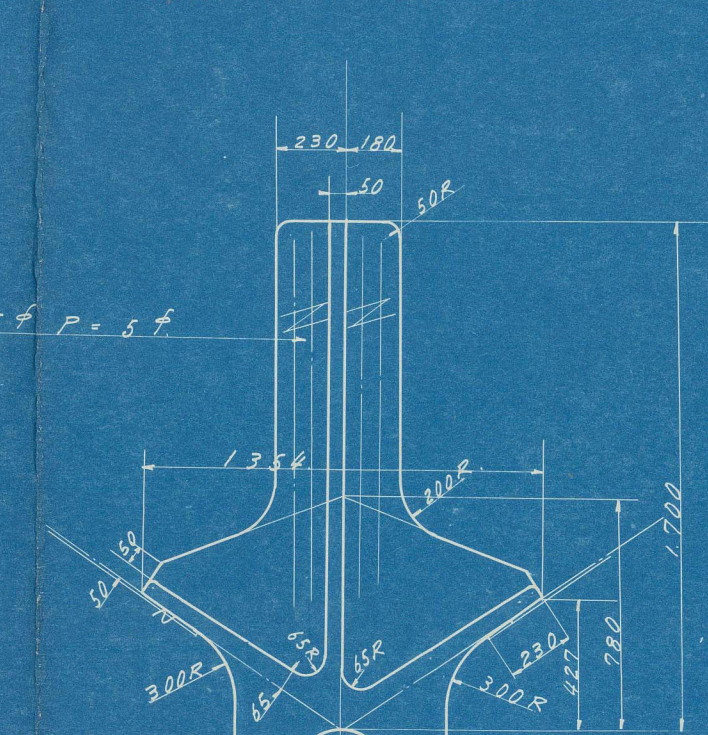


FR 1
LOOKING AFT.

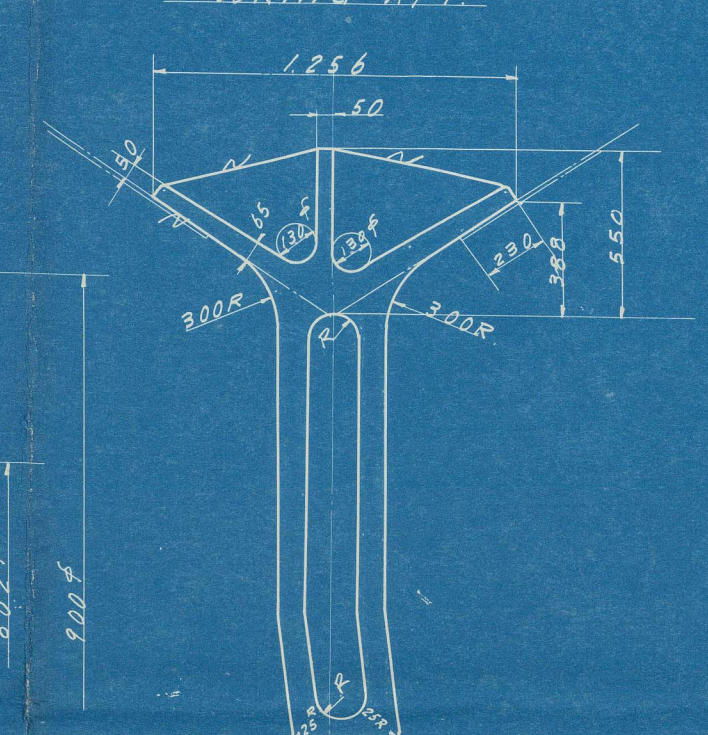


FR 2
LOOKING AFT.

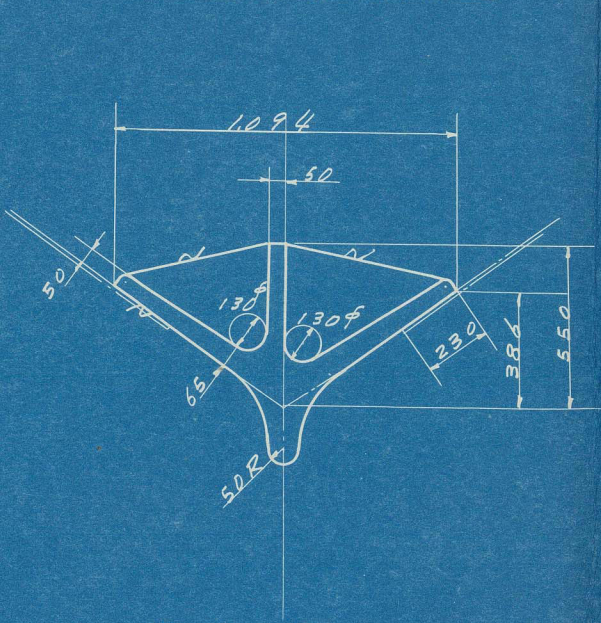


FR 3
LOOKING AFT.

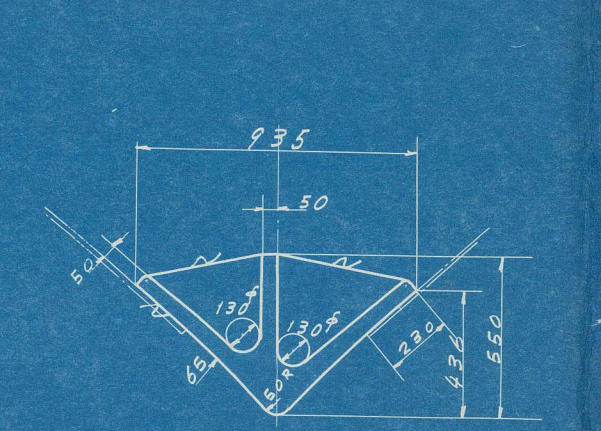

FR 4
LOOKING AFT.

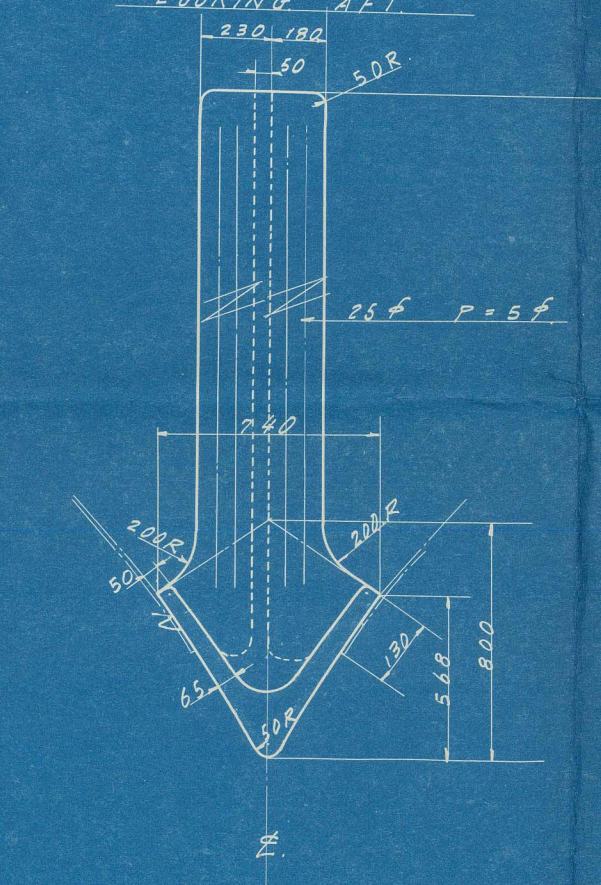

LOOKING AFT
EXPANSION

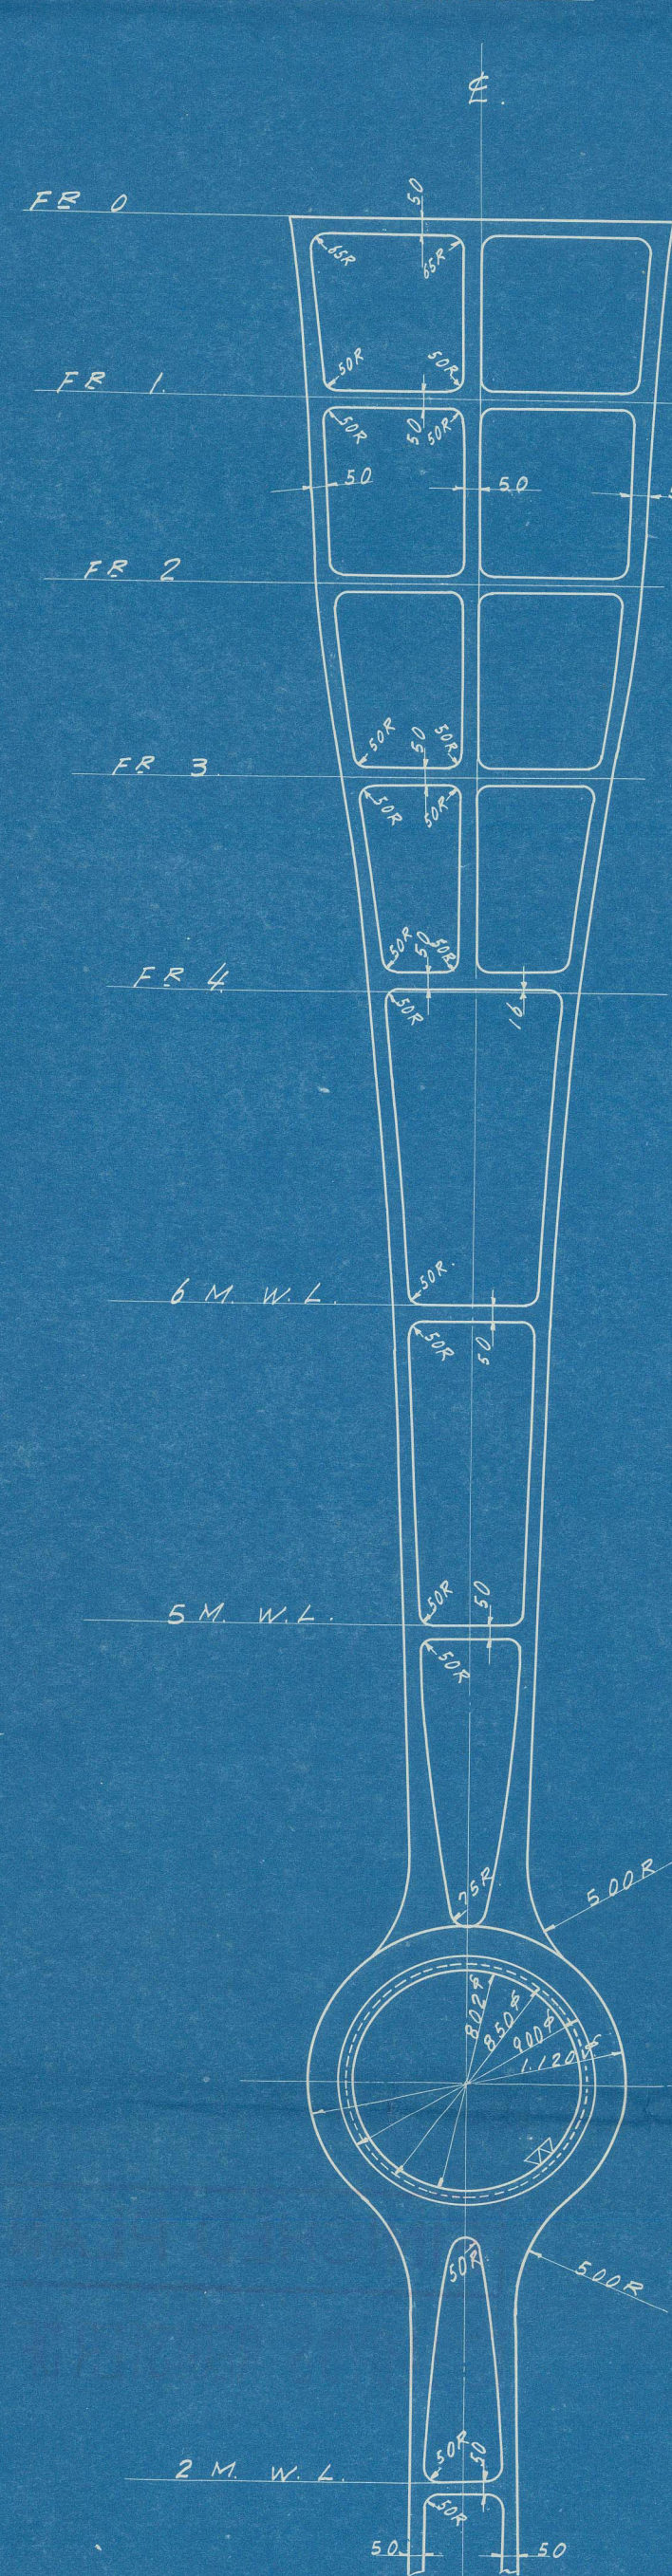

RUDDER AREA: A $23.70 \text{ M}^2 (255.2 \text{ 呎}^2)$
 $A/L \times d = 23.70 / 147 \times 9.3$
 SEA SPEED OF SHIP := (DESIGNED) $14 \frac{1}{2} \text{ K}$

仕上程度記号				
上仕上	並仕上	荒仕上	滑り止地	生地
上	上	上	上	上

聖邦丸
SEIHO MARU

船
尾
枠

STERN FRAME

1/25


A-17

FINISHED PLAN

TO LLOYDS REGISTER OF SHIPPING

RECORDS DEPT:
LONDON



SEIHO MARU 

Sternframe

As Built.

