

# MIDSHIP SECTION

SCALE 1/50, 1/25

CLASS : \*100A1 "LONGITUDINALLY FRAMED AT BOTTOM" & \*L.M.C. OF LLOYD'S

## PRINCIPAL DIMENSIONS:-

LENGTH B.P.	178' 3 60 (421' 1")
BREADTH MLV	17' 8 00 (58' 4")
DEPTH MLV	10' 4 00 (31' 1")
DRAUGHT MLV	8' 2 90 (27' 0")

FRAME SPACE 1' 00" AMIDSHIPS, 68" FWD OF O.Z.L. FORD, 610" IN PEAKS

EQUIPMENT	NUMBER IN ENGLISH UNIT (L.R.)
HULL	421 (1582 * 271) + 0.85 * 421 (1582 * 271) = 38509.60
BRIDGE	133.86 * 7.87 * 0.85 = 895.46
FORECASTLE	34.40 * 7.55 * 0.85 = 220.76
POOP	30.58 * 7.55 * 0.85 = 196.25
DECK HOUSES	(82.68 * 82.68) * 7.71 * 0.75 = 955.14
TOTAL	40777.82


EQUIPMENT	NUMBER IN ENGLISH UNIT (L.R.)
1. 550' OF 2 1/2" X 8" STUD. MAIN (CAST STEEL)	1. 550' OF 2 1/2" X 8" STUD. MAIN (CAST STEEL)
2. 240' OF 40" X 5" S.F.W. (S.S. 24W)	2. 240' OF 40" X 5" S.F.W. (S.S. 24W)
3. 185' OF 65" X 4" MANILA ROPE	3. 185' OF 65" X 4" MANILA ROPE
4. 185' OF 65" X 4" MANILA ROPE	4. 185' OF 65" X 4" MANILA ROPE

## EQUIPMENT "6"



3. ISOWER ANCHORS (STOCKLESS)	3T + 10" EACH
CABLE	1. 550' OF 2 1/2" X 8" STUD. MAIN (CAST STEEL)
TOW LINE	1. 240' OF 40" X 5" S.F.W. (S.S. 24W)
MANISERS	2. 185' OF 65" X 4" MANILA ROPE
WARPS	2. 185' OF 65" X 4" MANILA ROPE

## NOTES:-



- 1) ALL SIZES ARE GIVEN IN MILLIMETERS.
- 2) ALL BUTTS OF DECK & SHELL PLATING ARE WELDED.
- 3) LONGITUDINALLY FRAMED IN BOTTOM SHELL & INNER BOTTOM.
- 4) LENGTH OF THE BRIDGE IS ABOUT 32% OF THE LENGTH OF THE SHIP.
- 5) SIZES OF BEAM KNEES WHICH ARE WELDED ARE SHOWN BY a \* b \* t AS SKETCHES BELOW.

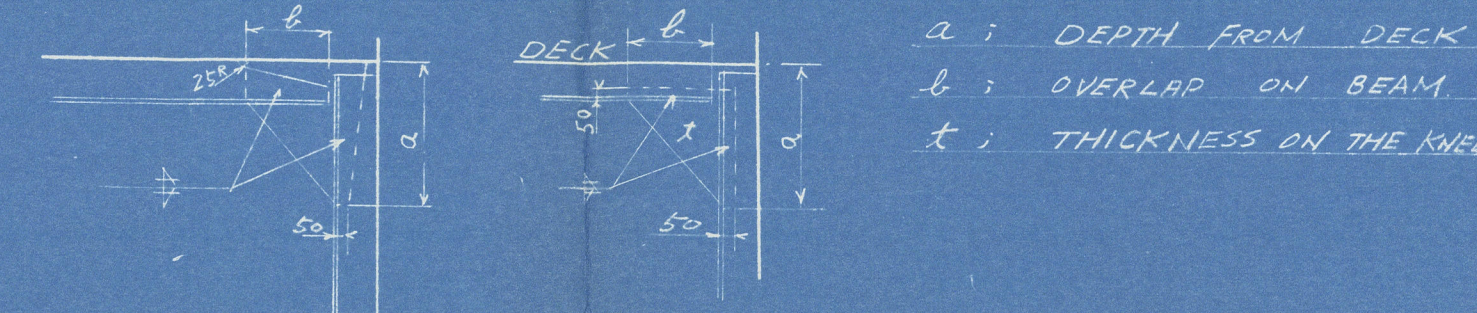

- 6) PARTICULARS OF THE STEEL TO BE USED IN THE PARTS INDICATED \* TO BE OF THE QUALITY IN ACCORDANCE WITH PARA 3 OF THE RULES.
- 7) REVISED SHOWN IN RED

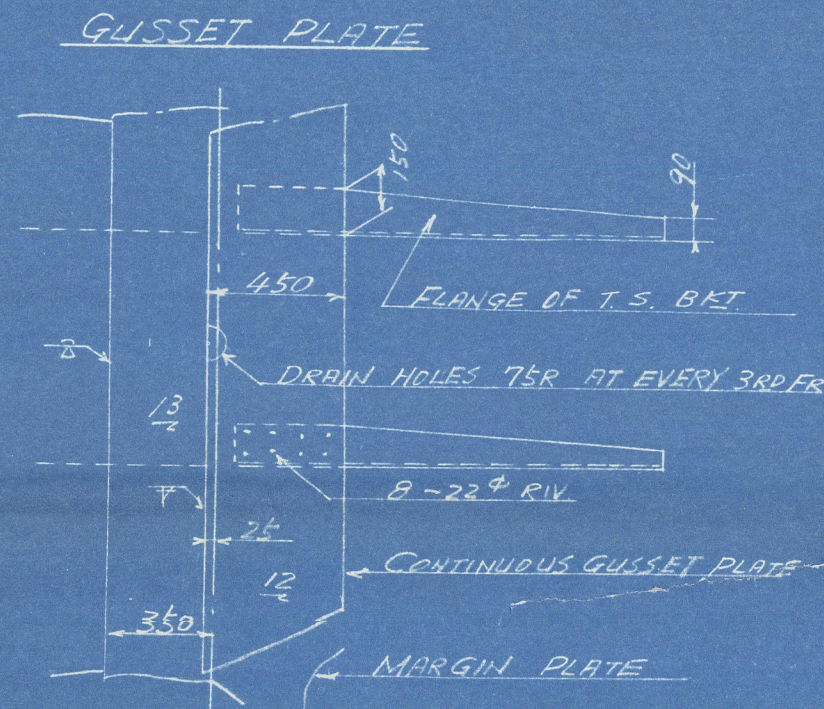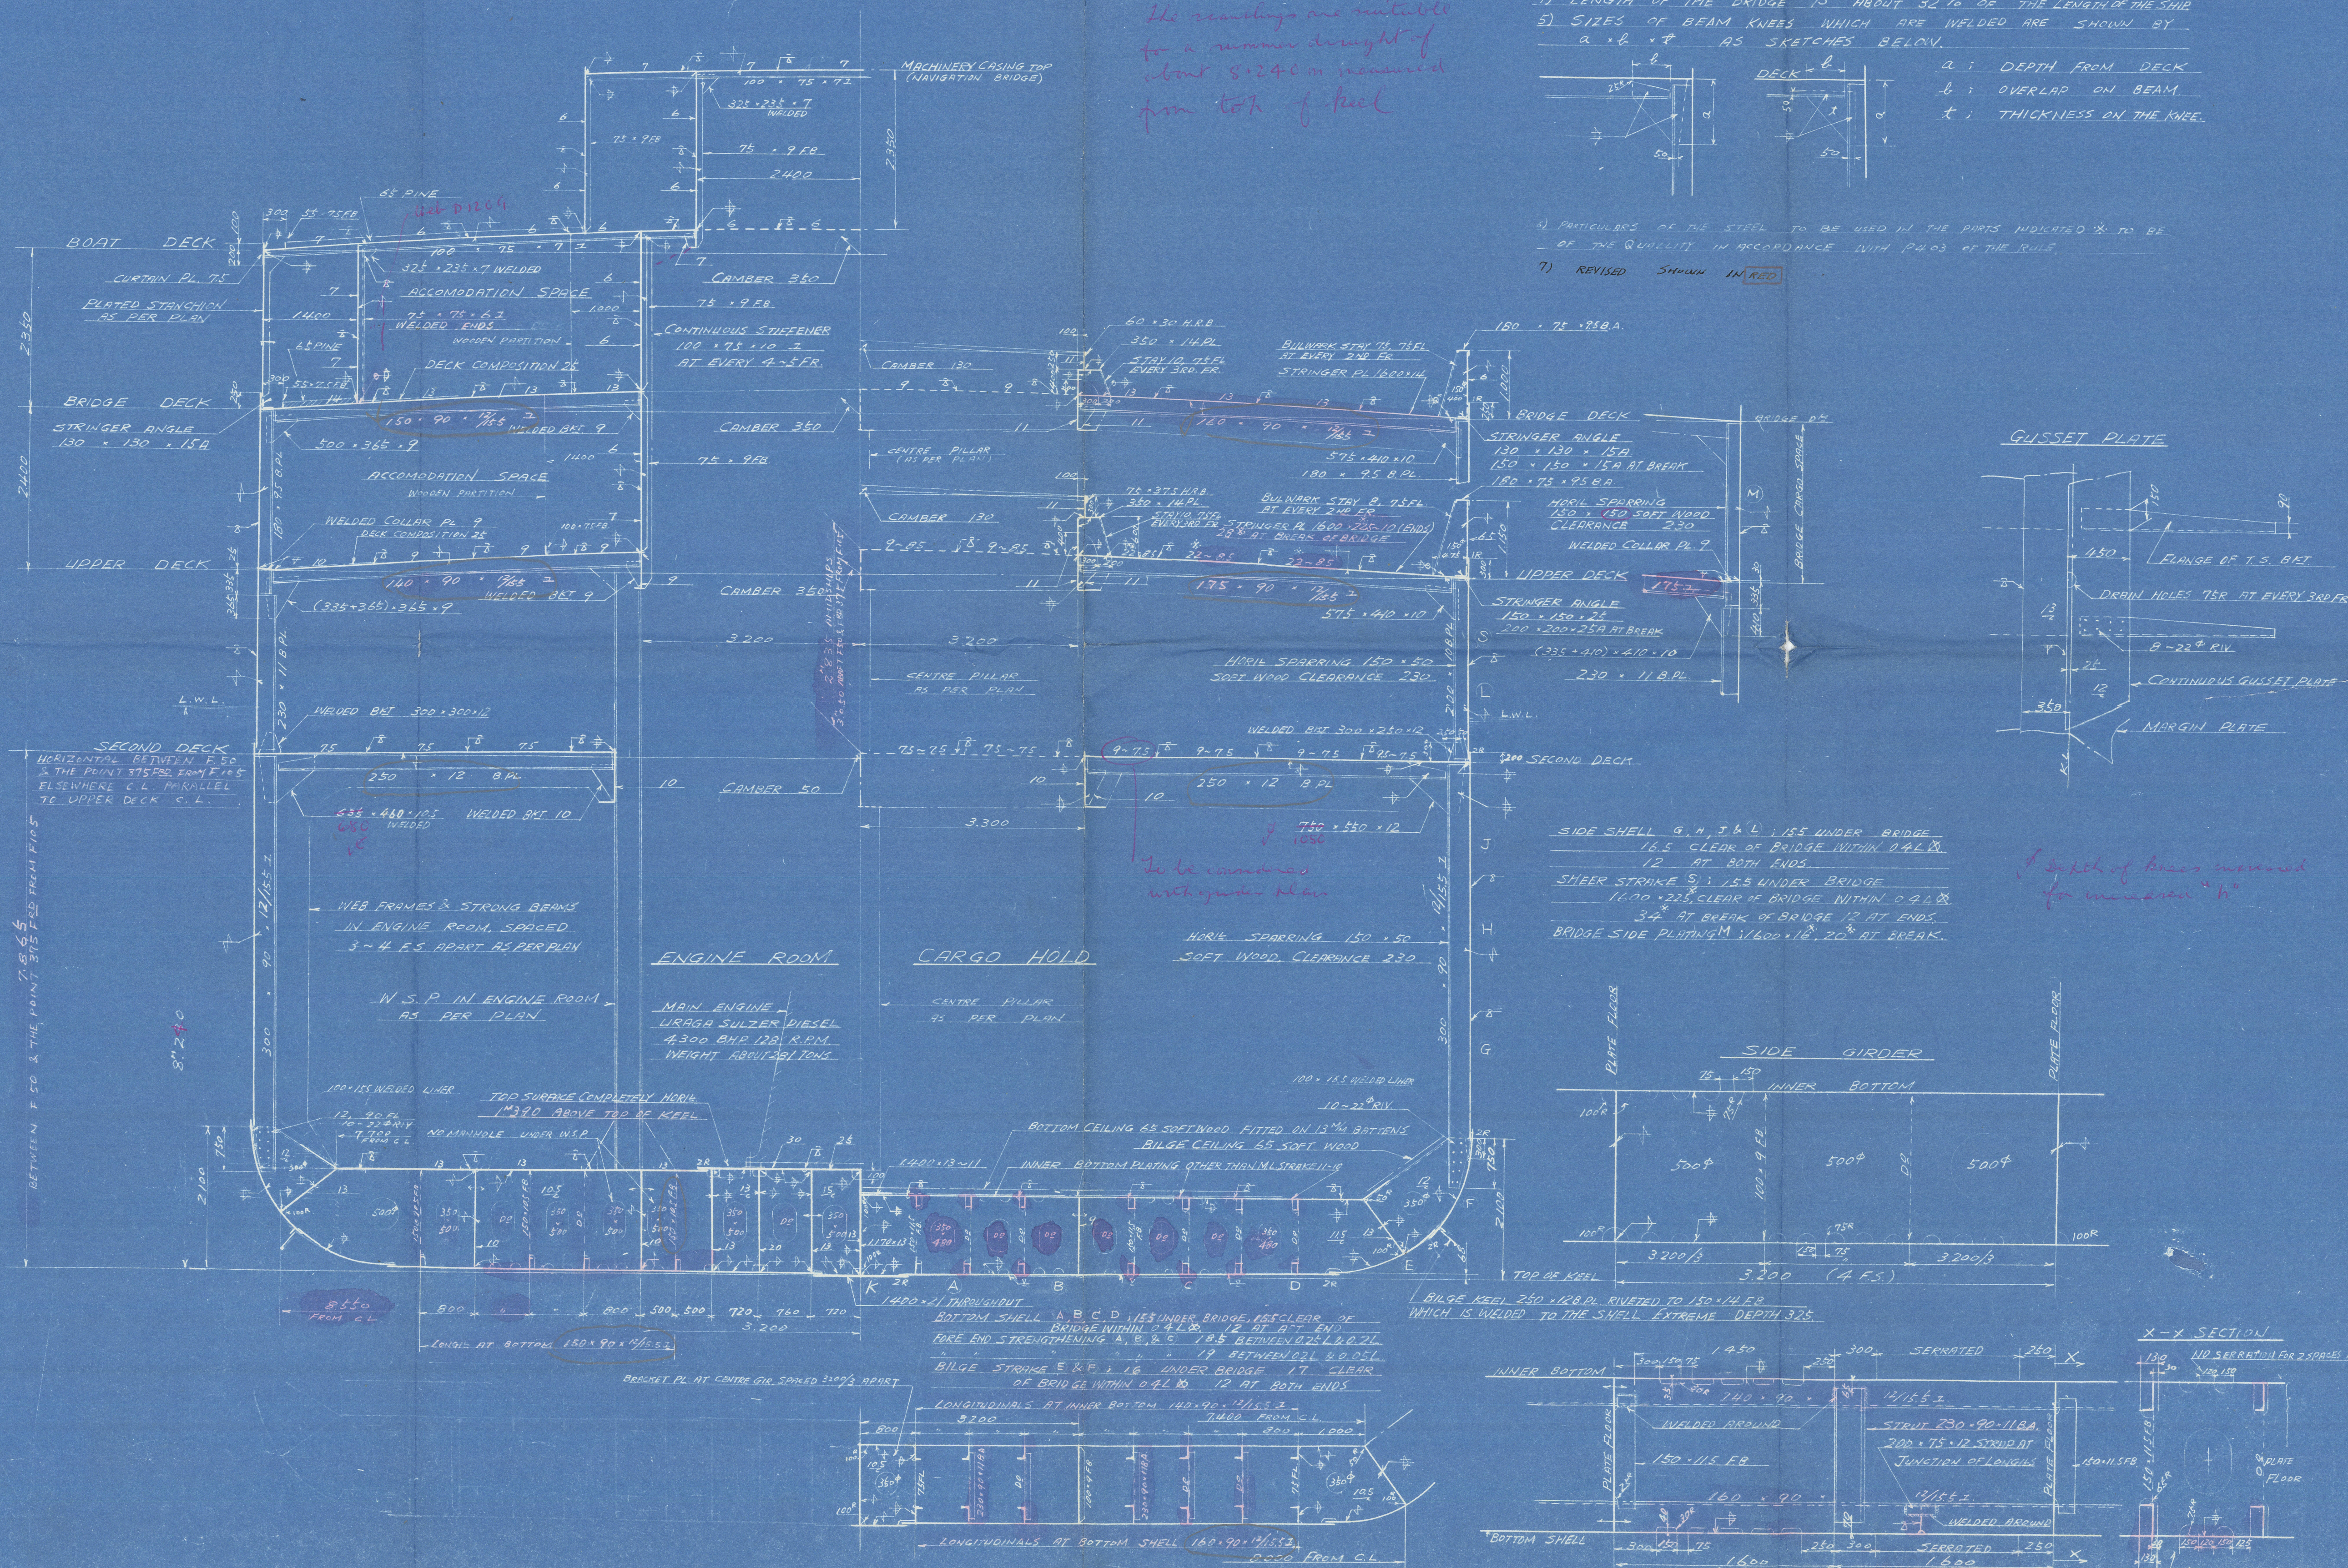

- SIDE SHELL G.H. 5.6 L. 155 UNDER BRIDGE
- 12.5' CLEAR OF BRIDGE WITHIN 0.4 L
- 12' AT BOTH ENDS
- SHEER STRONG S. 1.15 UNDER BRIDGE
- 1600 \* 225' CLEAR OF BRIDGE WITHIN 0.4 L
- 3.5' AT BREAK OF BRIDGE 22' AT ENDS
- BRIDGE SIDE PLATING 1600 \* 12' 20' AT BREAKS

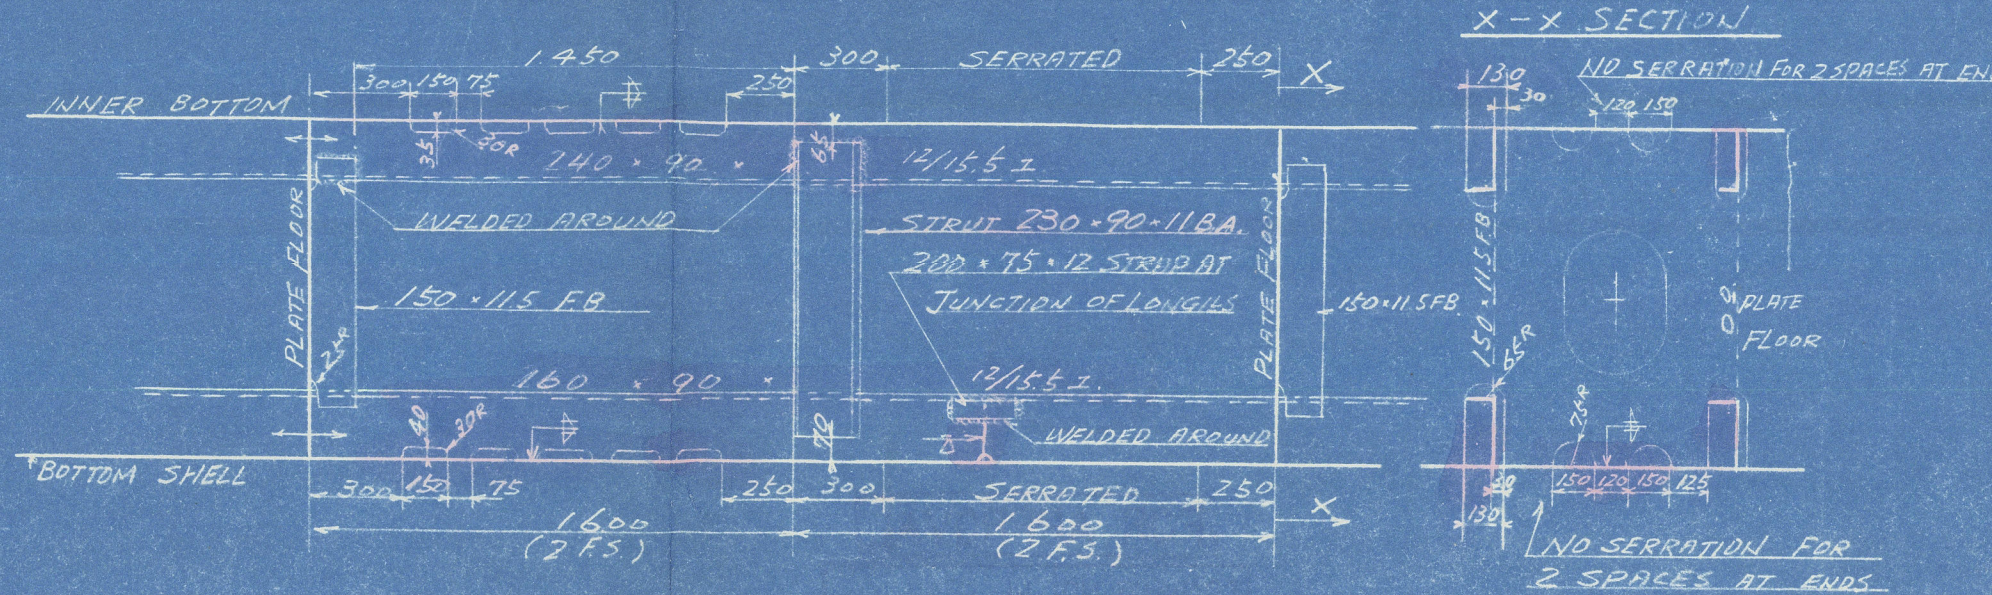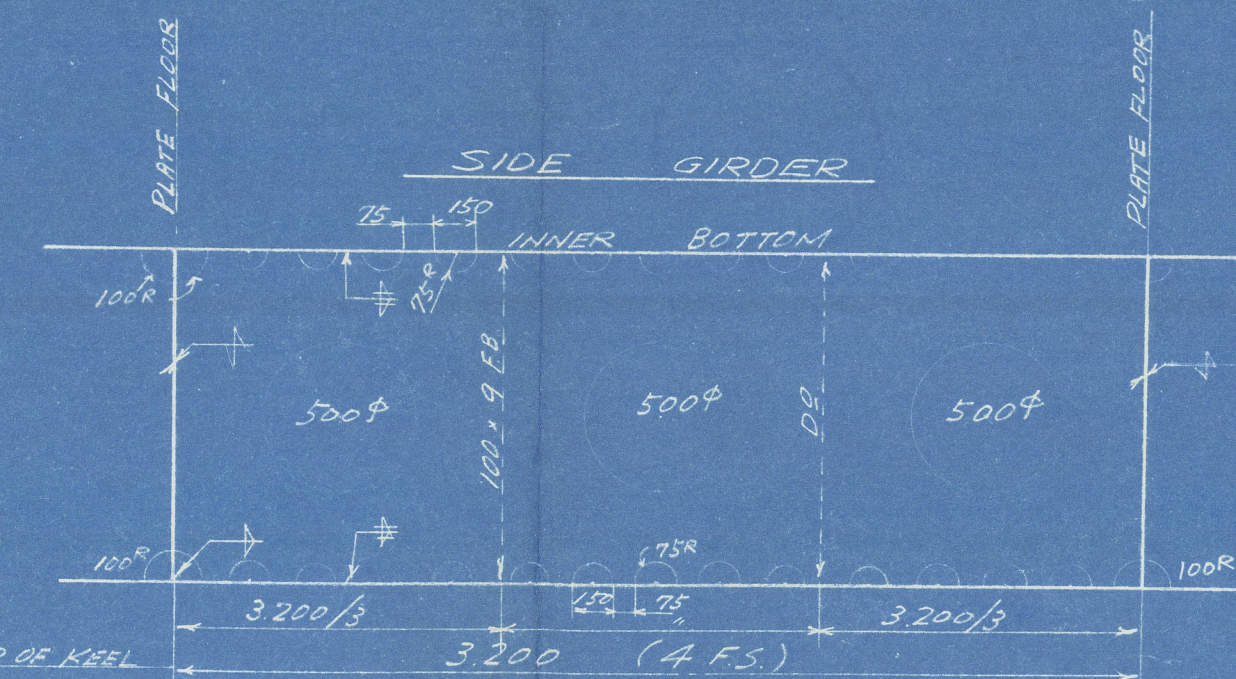


NO 673  
DW 10150FT  
S.S. CARGO MOTORSHIP

MIDSHIP  
SECTION  
(REVISED)  
L B D  
128.36 \* 17.80 \* 10.40

中央切斷

SCALE 1/50, 1/25

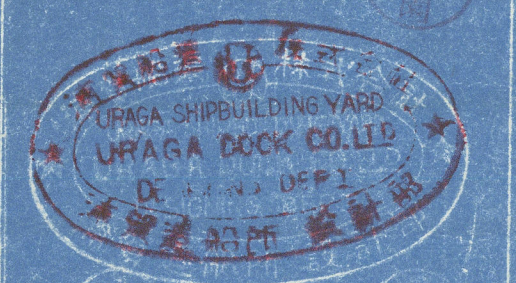

YAGA SHIPBUILDING WORKS  
YAGA DOCK CO. LTD.  
YAGA SHIPBUILDING WORKS  
YAGA DOCK CO. LTD.



APPROVED  
15-11-54  
No. 673


D.W. 10,150 KT  
S.S. CARGO MOTOR SHIP

MIDSHIP  
SECTION  
(REVISED)

L B D  
128.36 x 17.80 x 10.40

中央切断

SCALE 1/50, 1/25

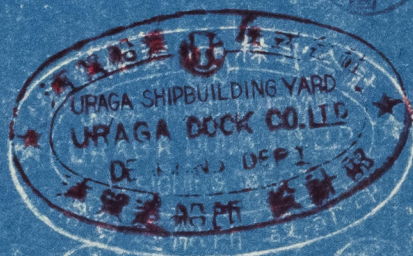

配	1
輪	1
主	1
機	1
油	1
水	6
電	1
管	1
架	4
本	1
計	18

類別番号 1  
圖面番号 MH-11.382

740 x 900




010615-010623-0134

ロイド  
シッピング  
スター

(神戸)

As app

RECORDS DEPT.,  
LONDON.

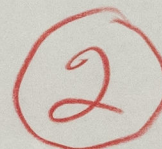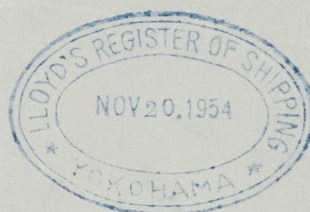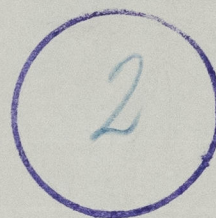

FOR APPROVAL

DRAWING NO. H 201  
DATE OCT. 28.1954

NOV. - 2.1954

010615-010623-0134