


SCALE: $\frac{1}{2}$ " = 1 FOOT

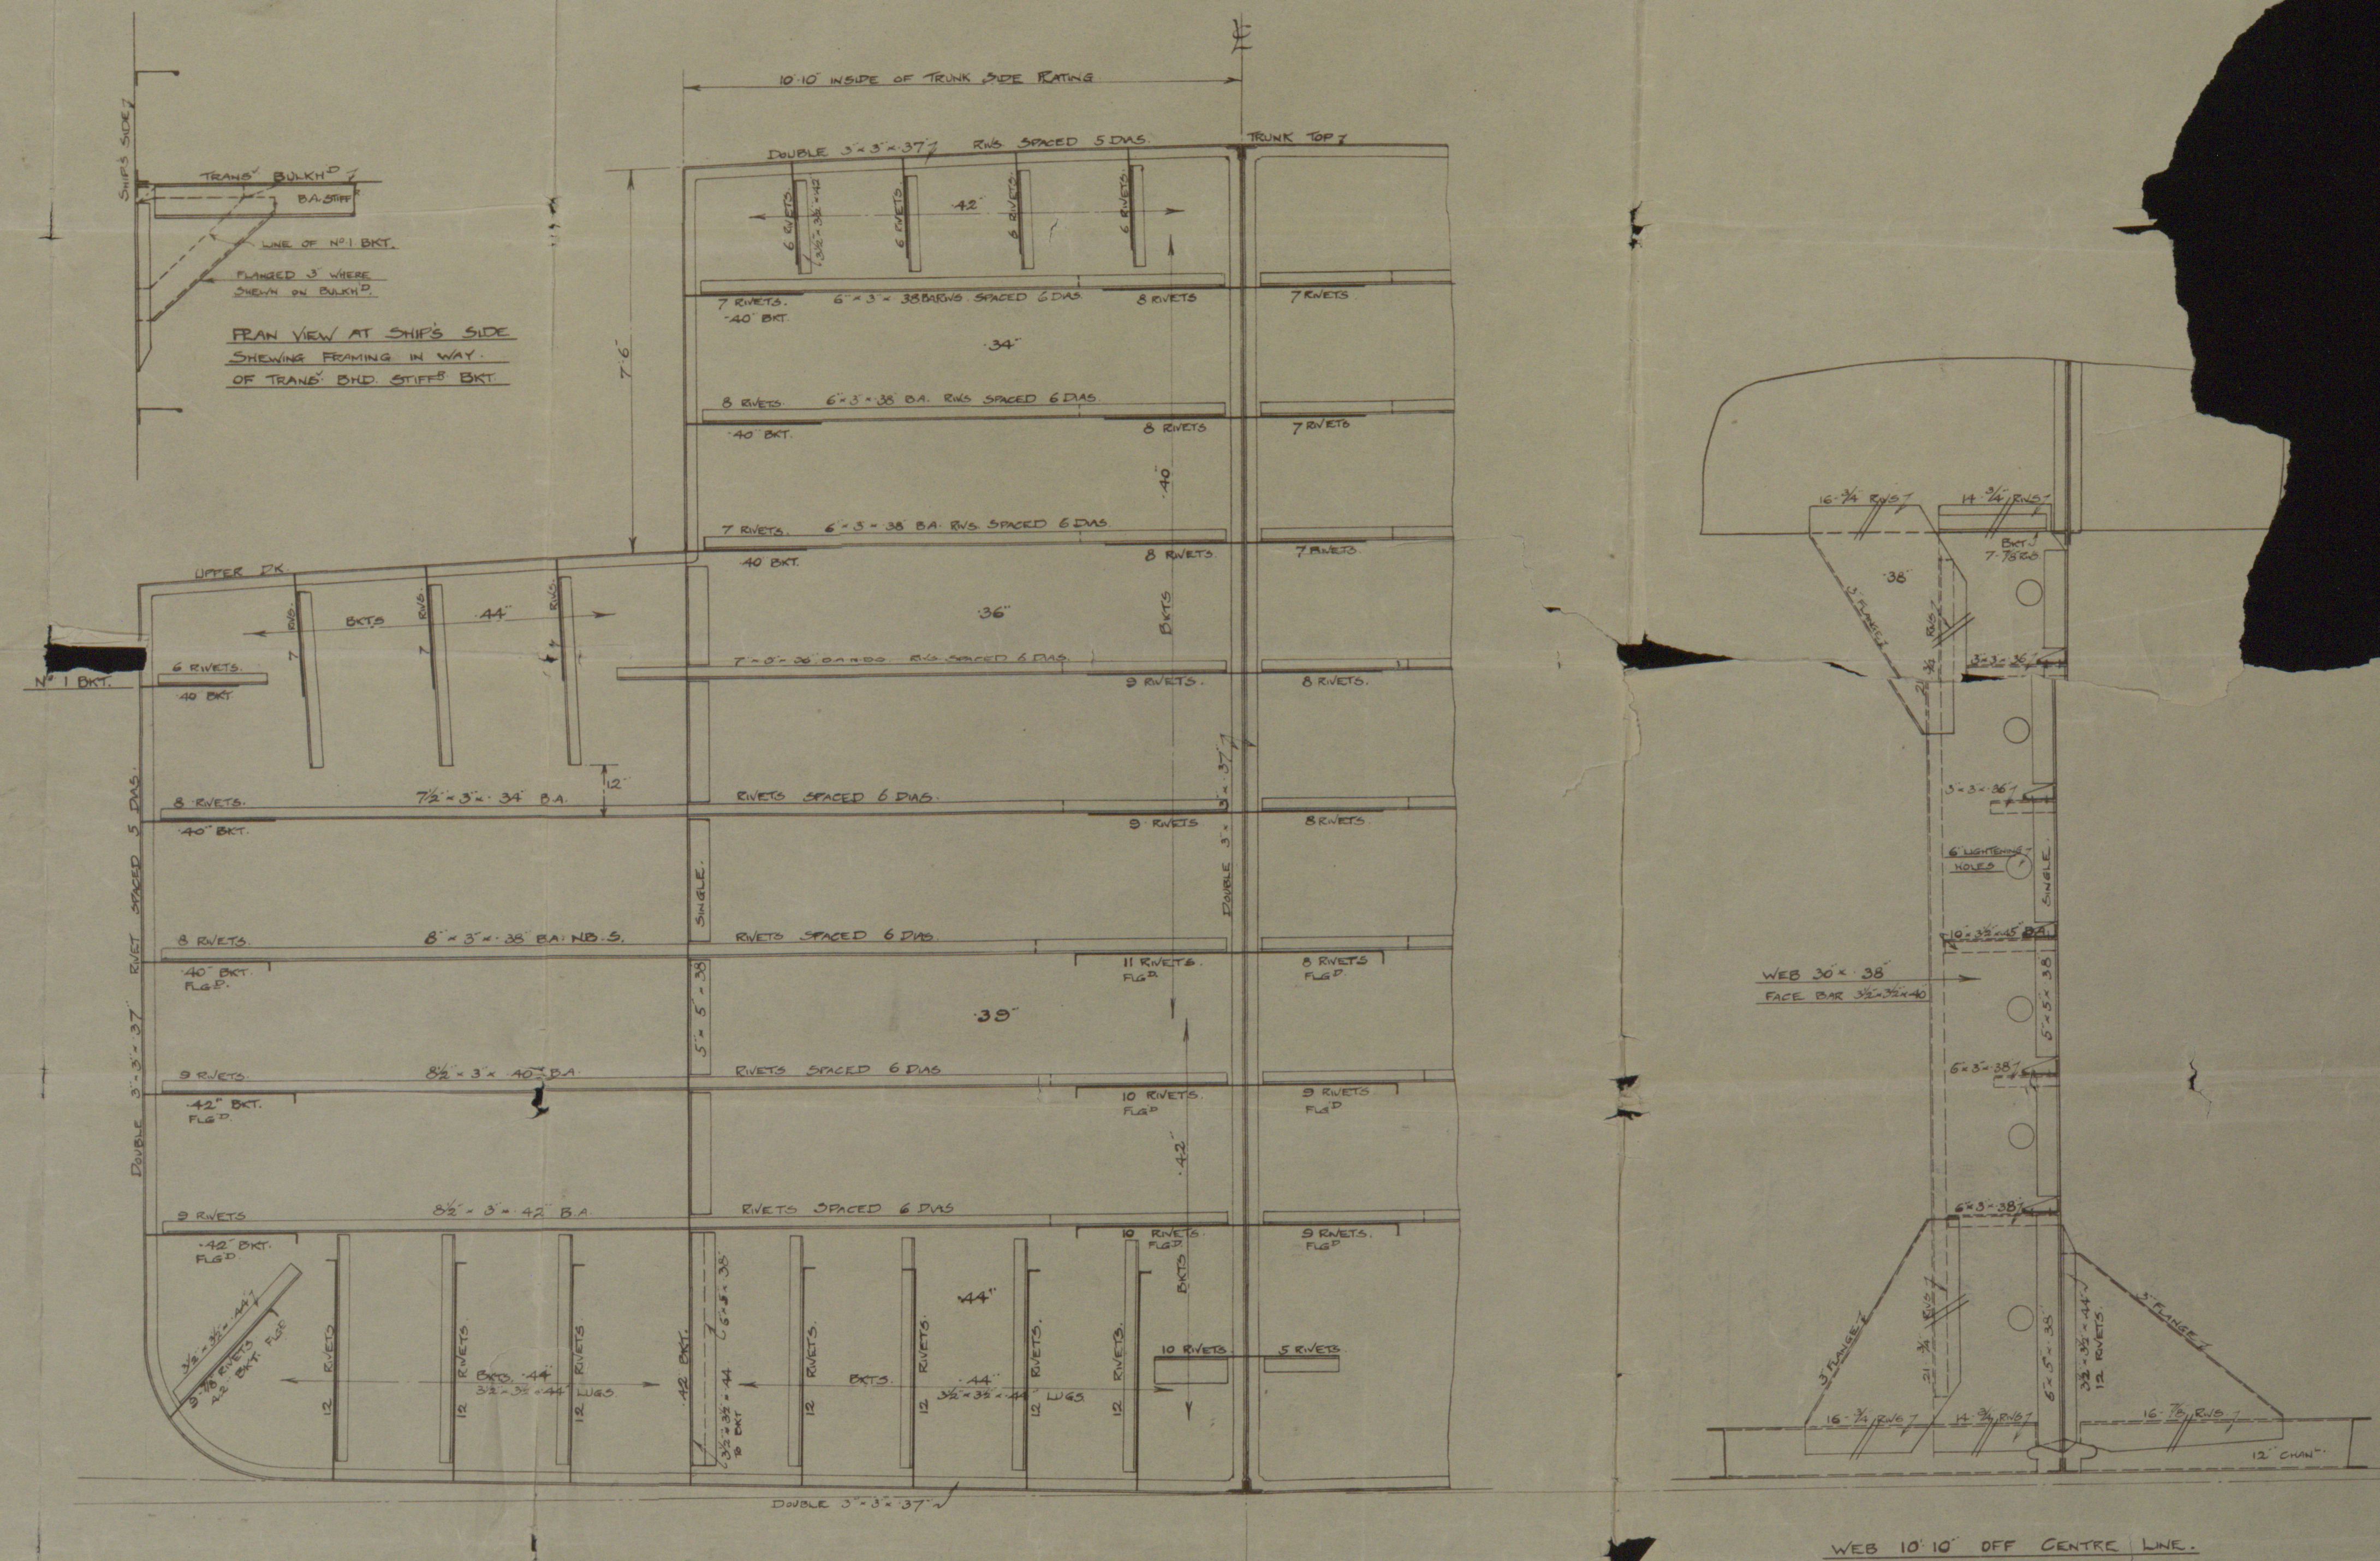

FURNESS S.B. CO.

N^o 199 - 200

MIDSHIP SECTION

(AS BUILT)


S.S. Britamail
MDB. RPT. No. 14414

S.S. Britamolene
MDB. RPT. No. 14417

S.S. Britamlube
MDB. RPT. No. 14605

S.S. Britamoco
MDB. RPT. No. 14643

010805-010815-0046

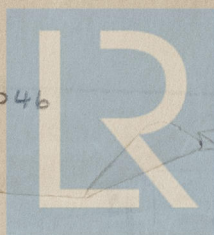

© 2021

Lloyd's Register
Foundation