


## PROFILE & DECK PLANS.

SCALE  $\frac{1}{8}'' = 1 \text{ FOOT.}$



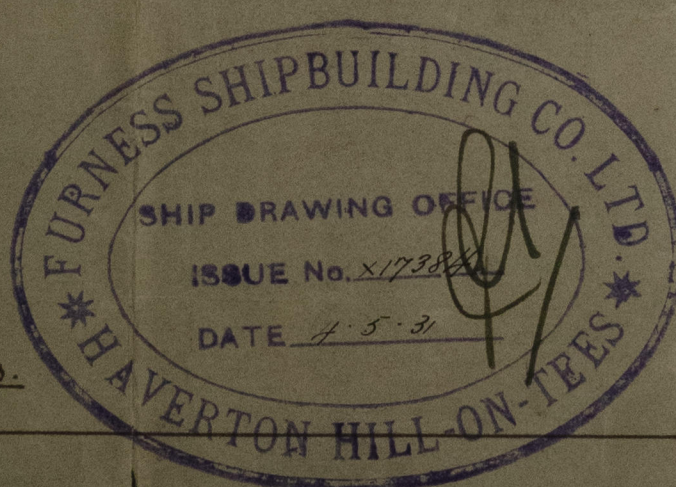

MESS<sup>RS</sup> FURNESS S. L.

Nos 199 + 200

PROFILE + DK. PLANS  
(AS BUILT)

S.S. Britamoil

MDB. RPT. No. 14414

S.S. Britamolene


MDB. RPT. No. 14417

S.S. Britamlube

MDB. RPT. No. 14605

S.S. Britamoco

MDB. RPT. No. 14643

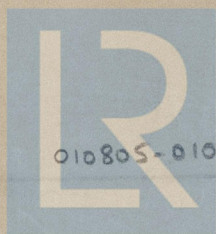

© 2021

010805-010815-0047

Lloyd's Register  
Foundation