
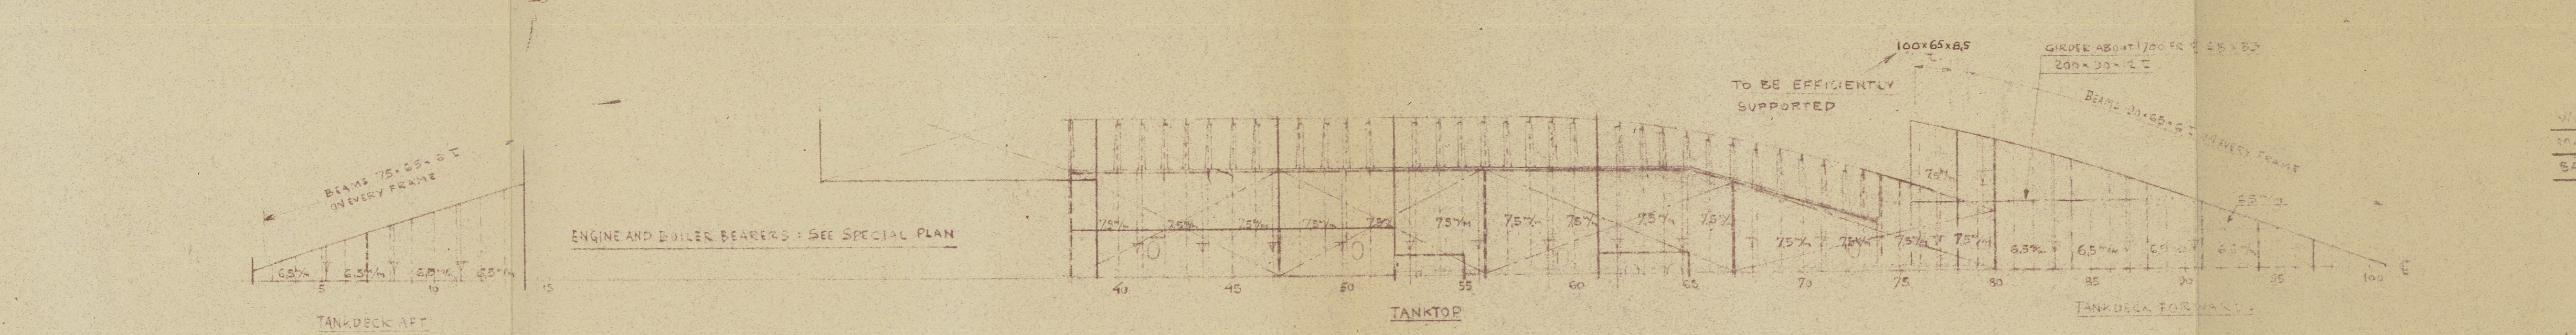
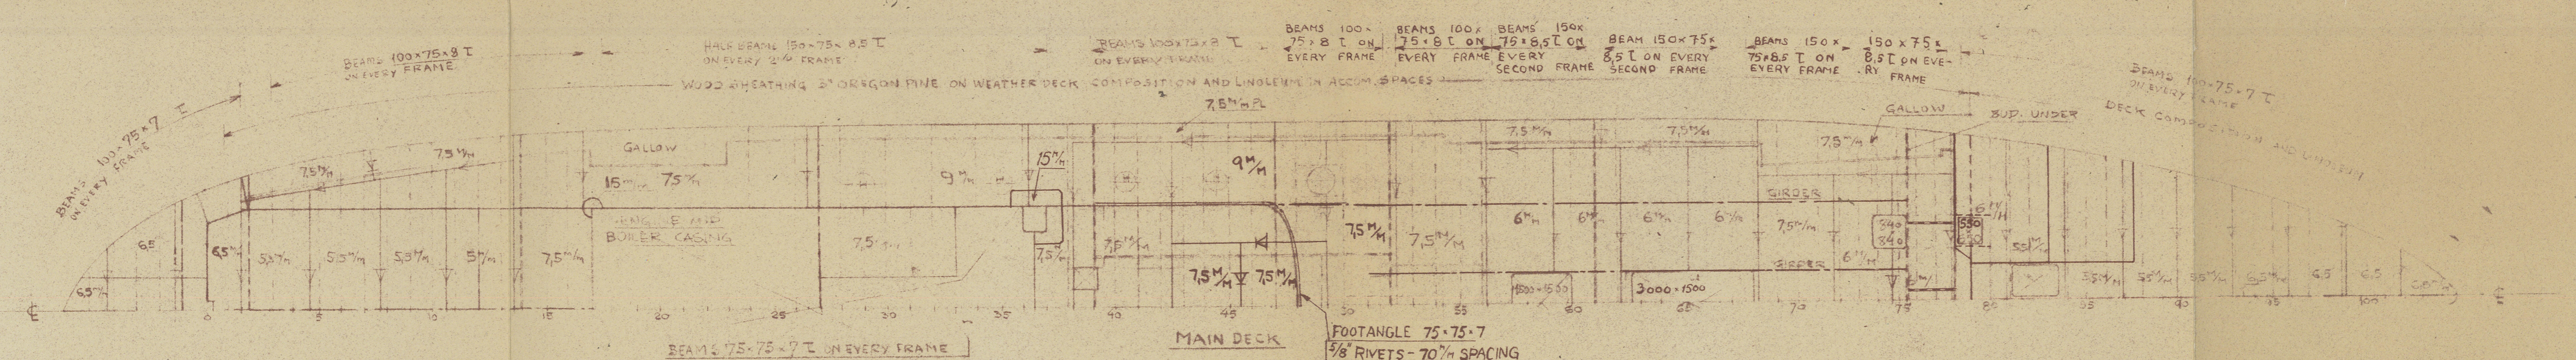
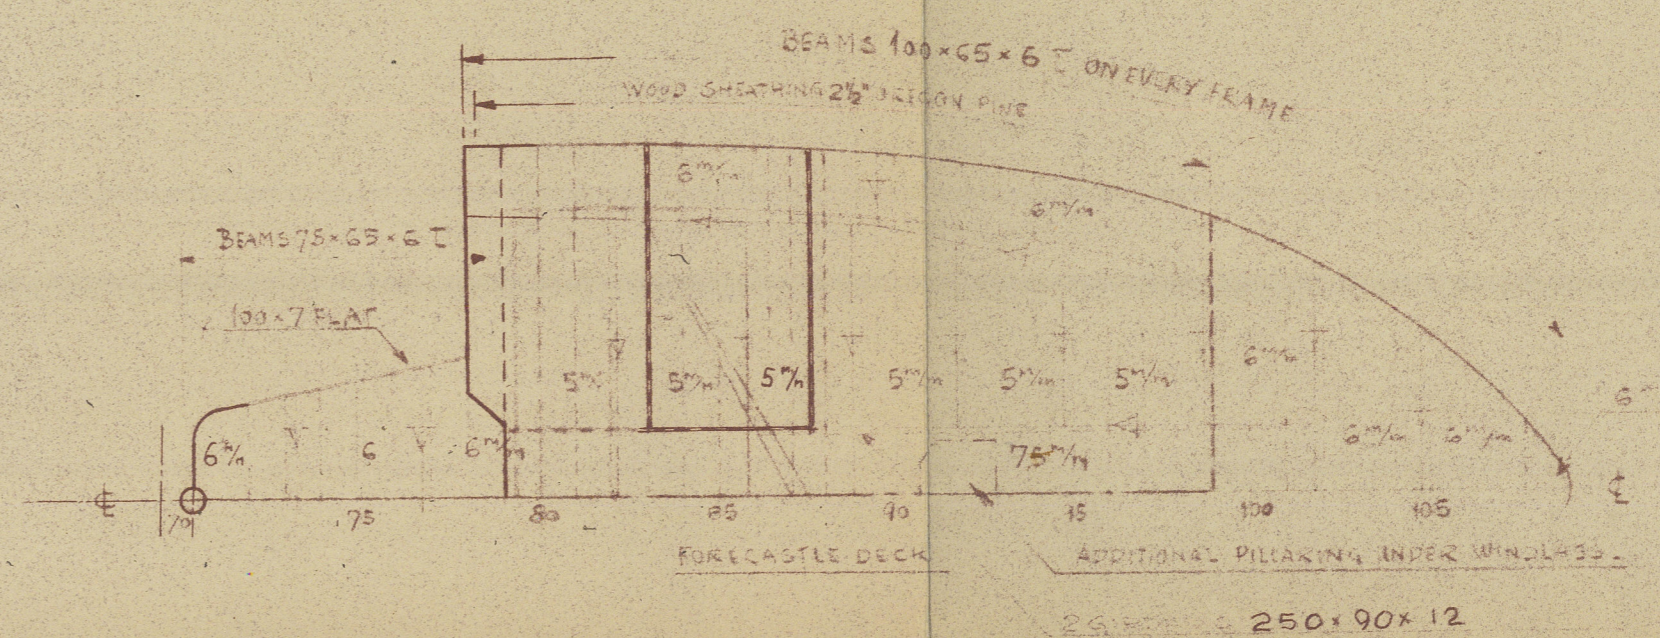
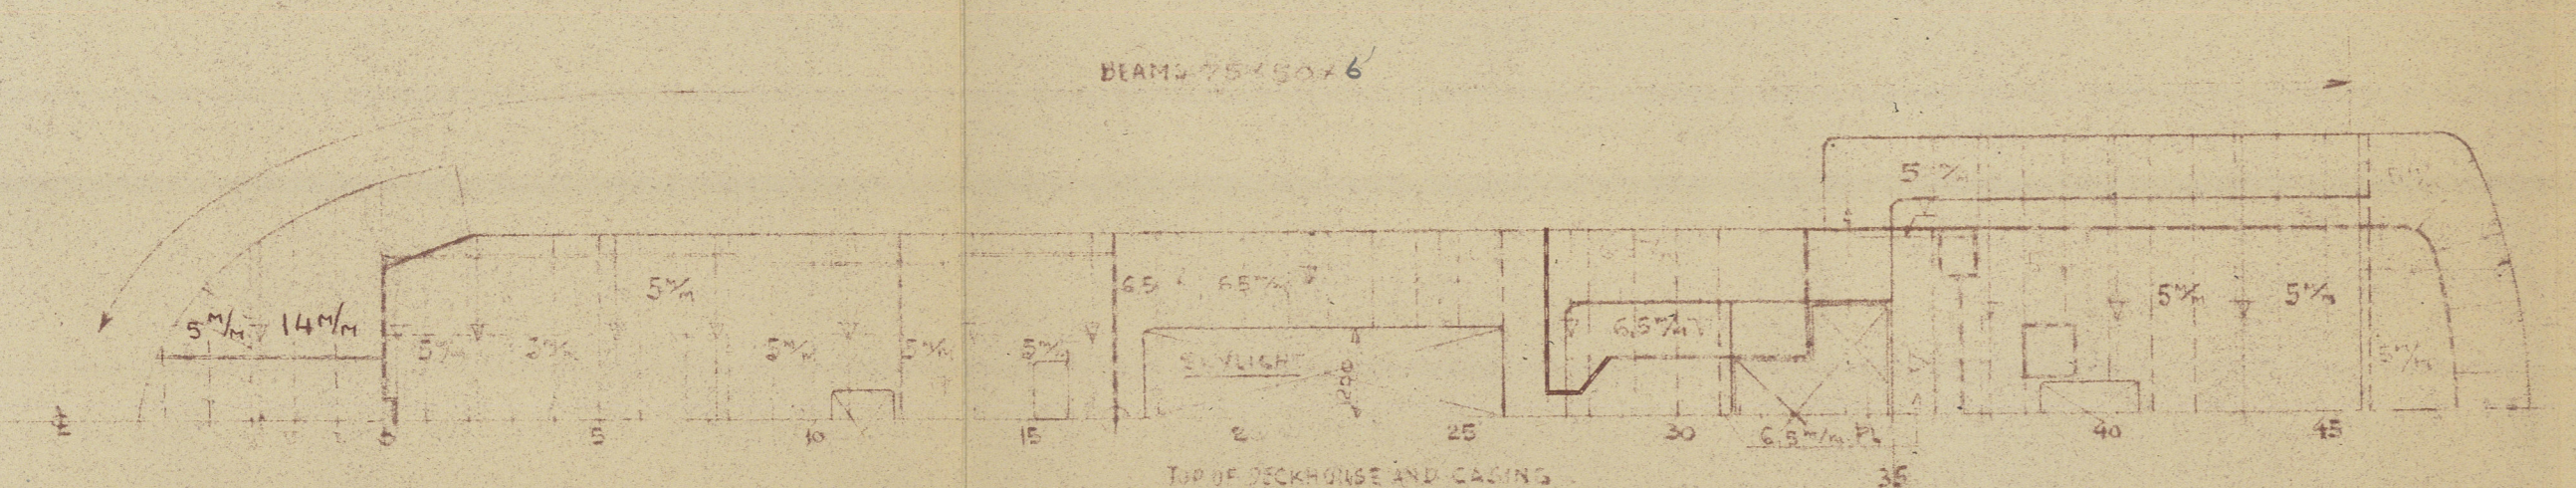


WATERTIGHT BULKHEADS
SEE DRAWING No. G10.570 "TRANSVERSE BULKHEADS"

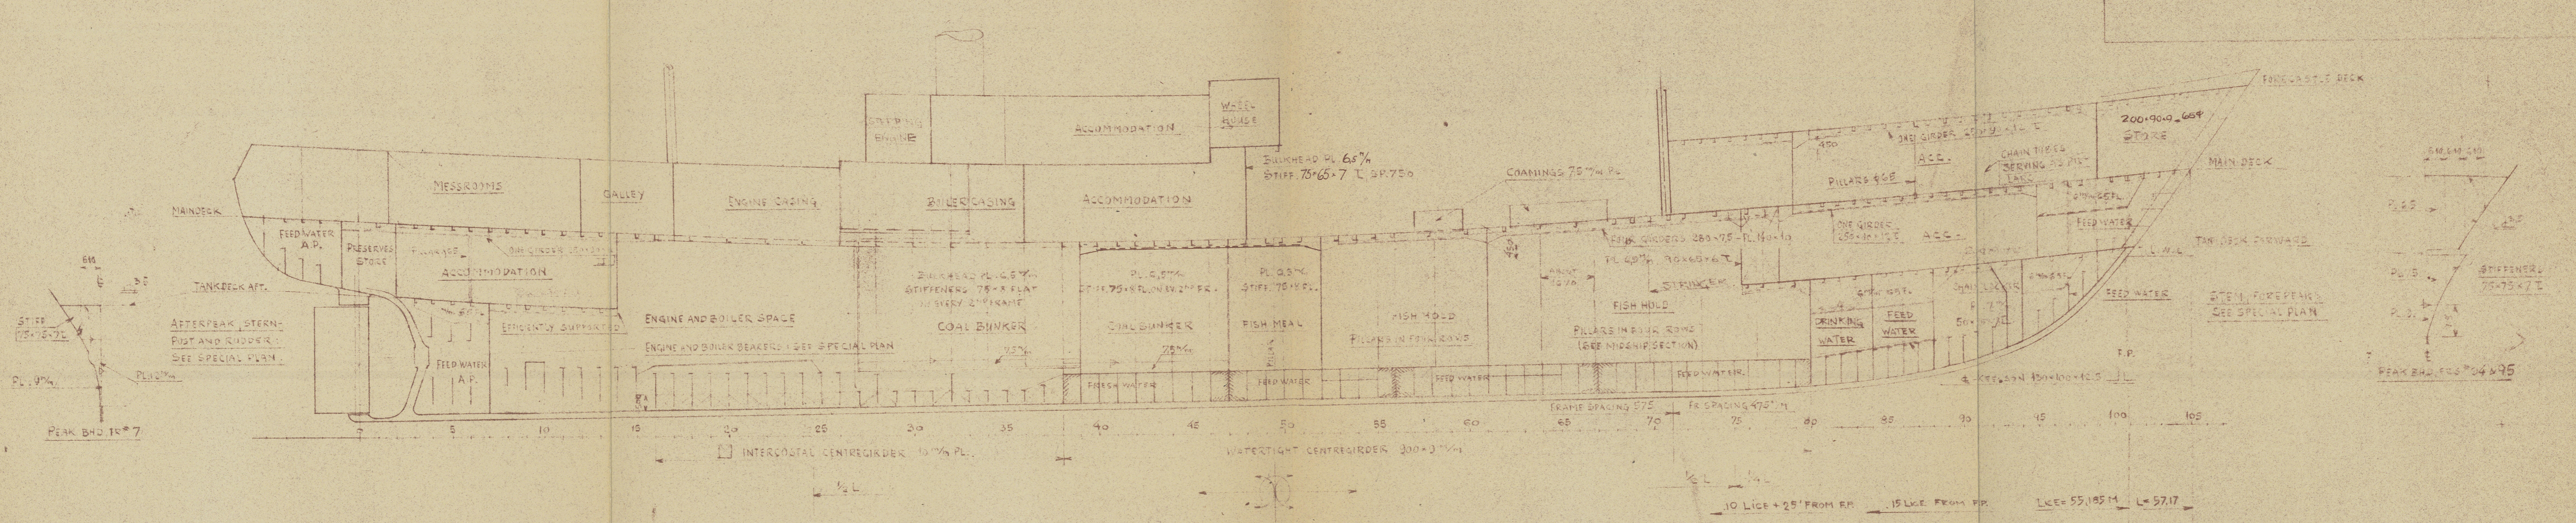

WINDLASS STEERING GEAR TRAWL WINCH
ETC. ETC. SUPPORTED TO SURVIVORS
SATISFACTION.

STOCKHOLM REPORT No. 10608
"Capit"

APPROVED BY LLOYD'S REG. 12-2-54

As BUILT 5/4 91

87-6

AKTIEBOLAGET GÄVLE VARV

S/T 87-93
LONGITUDINAL SECTION AND PLANS

RITAD AV: L. H.	SKALA: 1:100
DATUM: 9.11.1949.	RITN
GRANSK AV:	NR G-10.566

DIMENSIONS:
LENGTH FROM THE FORE SIDE OF THE STEEL TO THE
CENTRE OF THE RUDDER STOCK ON THE MAINDECK
LENGTH BETWEEN PERPENDICULARS
BREADTH MOULDED
DEPTH MOULDED TO MAINDECK

SCANTLING NUMERALS: a) D = 15 3/4" b) L/D = 208 4

CLASS: LLOYD'S REGISTER 100 A 1 STEAM TRAWLER. STRENGTHENED FOR
NAVIGATION IN ICE. ELECTRICALLY WELDED

010824-010834-0002