

0871

500 Ton Dumb Aviation Spirit Lighter

PROFILE AND DECKS

SCALE - $\frac{1}{8}" = 1 \text{ FOOT}$

(AS BUILT)


DIMS - 150'0" O.A. x 14'2"0" B.P. x 32'0" MLD x 10'0" MLD

ESTIMATED MEAN DRAUGHT 7'9"

APPROVED BY LLOYDS 22/7/58

APPROVED BY ADMIRALTY / /

PLEASE INDICATE MINIMUM SCANTLINGS

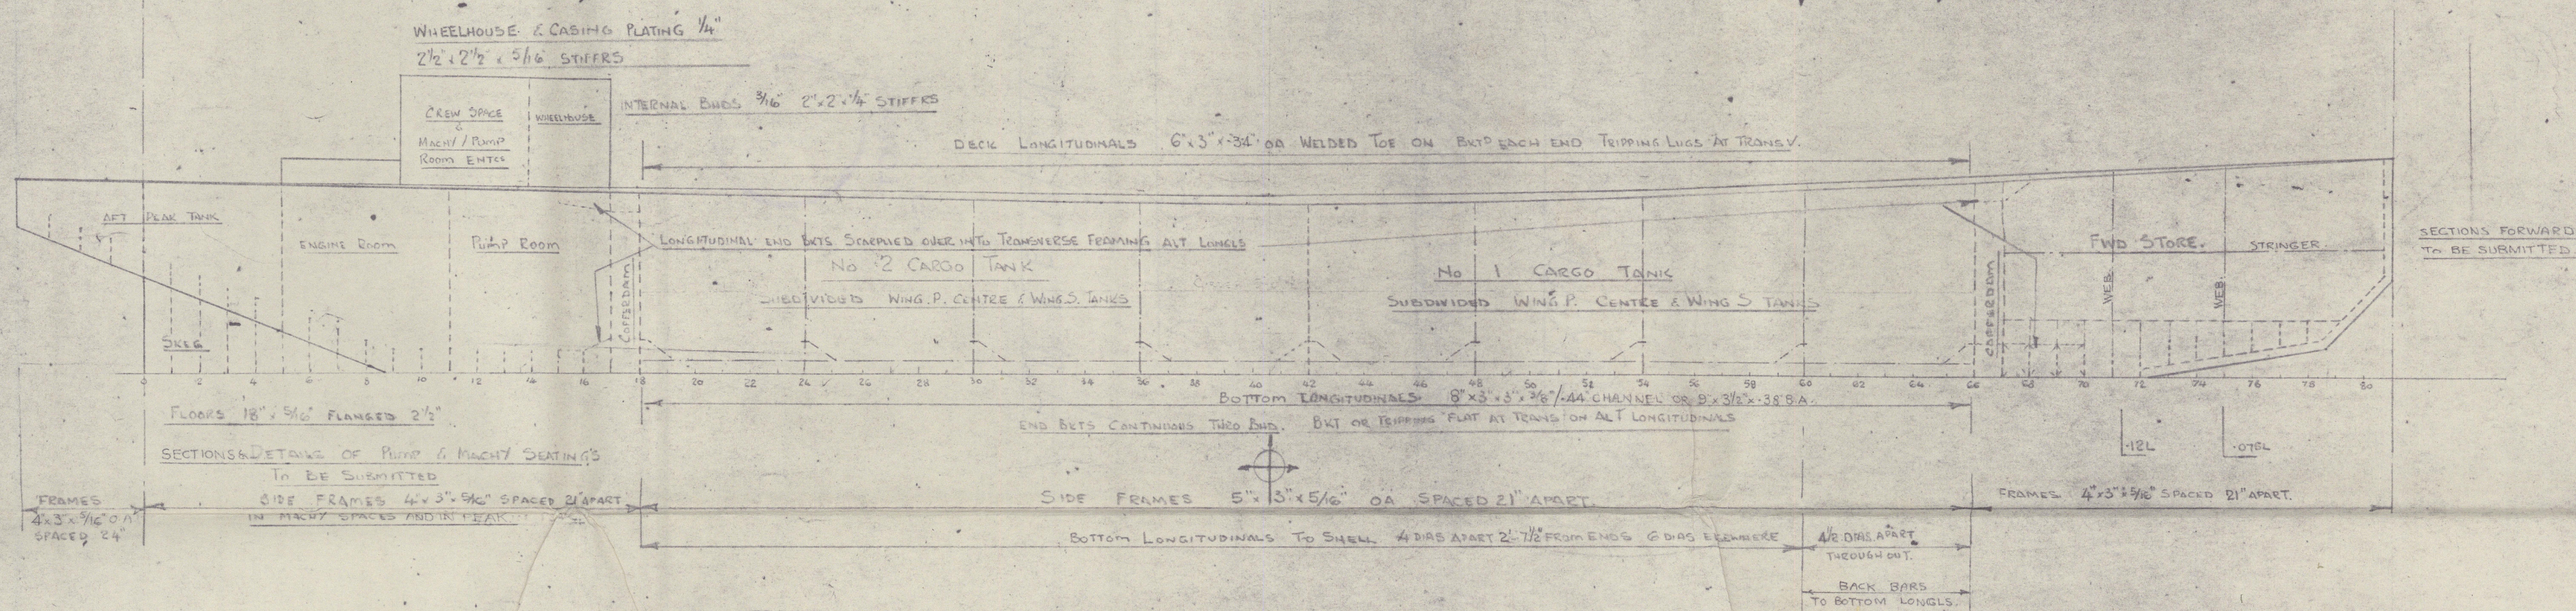

BUDS IN CARGO TANKS & COFFER DAM BUDS

$\frac{5}{16}"$ PLATING THROUGHOUT

$4' \times 3' \times \frac{5}{16}"$ OR STIFFERS WELDED TOE ON SPACED 24" APART


DETAILS OF STIFFER END BOTS TO BE SUBMITTED

BUDS 5 & 11

$\frac{23}{32}"$ PLATING THROUGHOUT

$3' \times 2' \times \frac{1}{4}"$ STIFFERS WELDED TOE ON

SPACED 24" APART BKT. AT ENDS

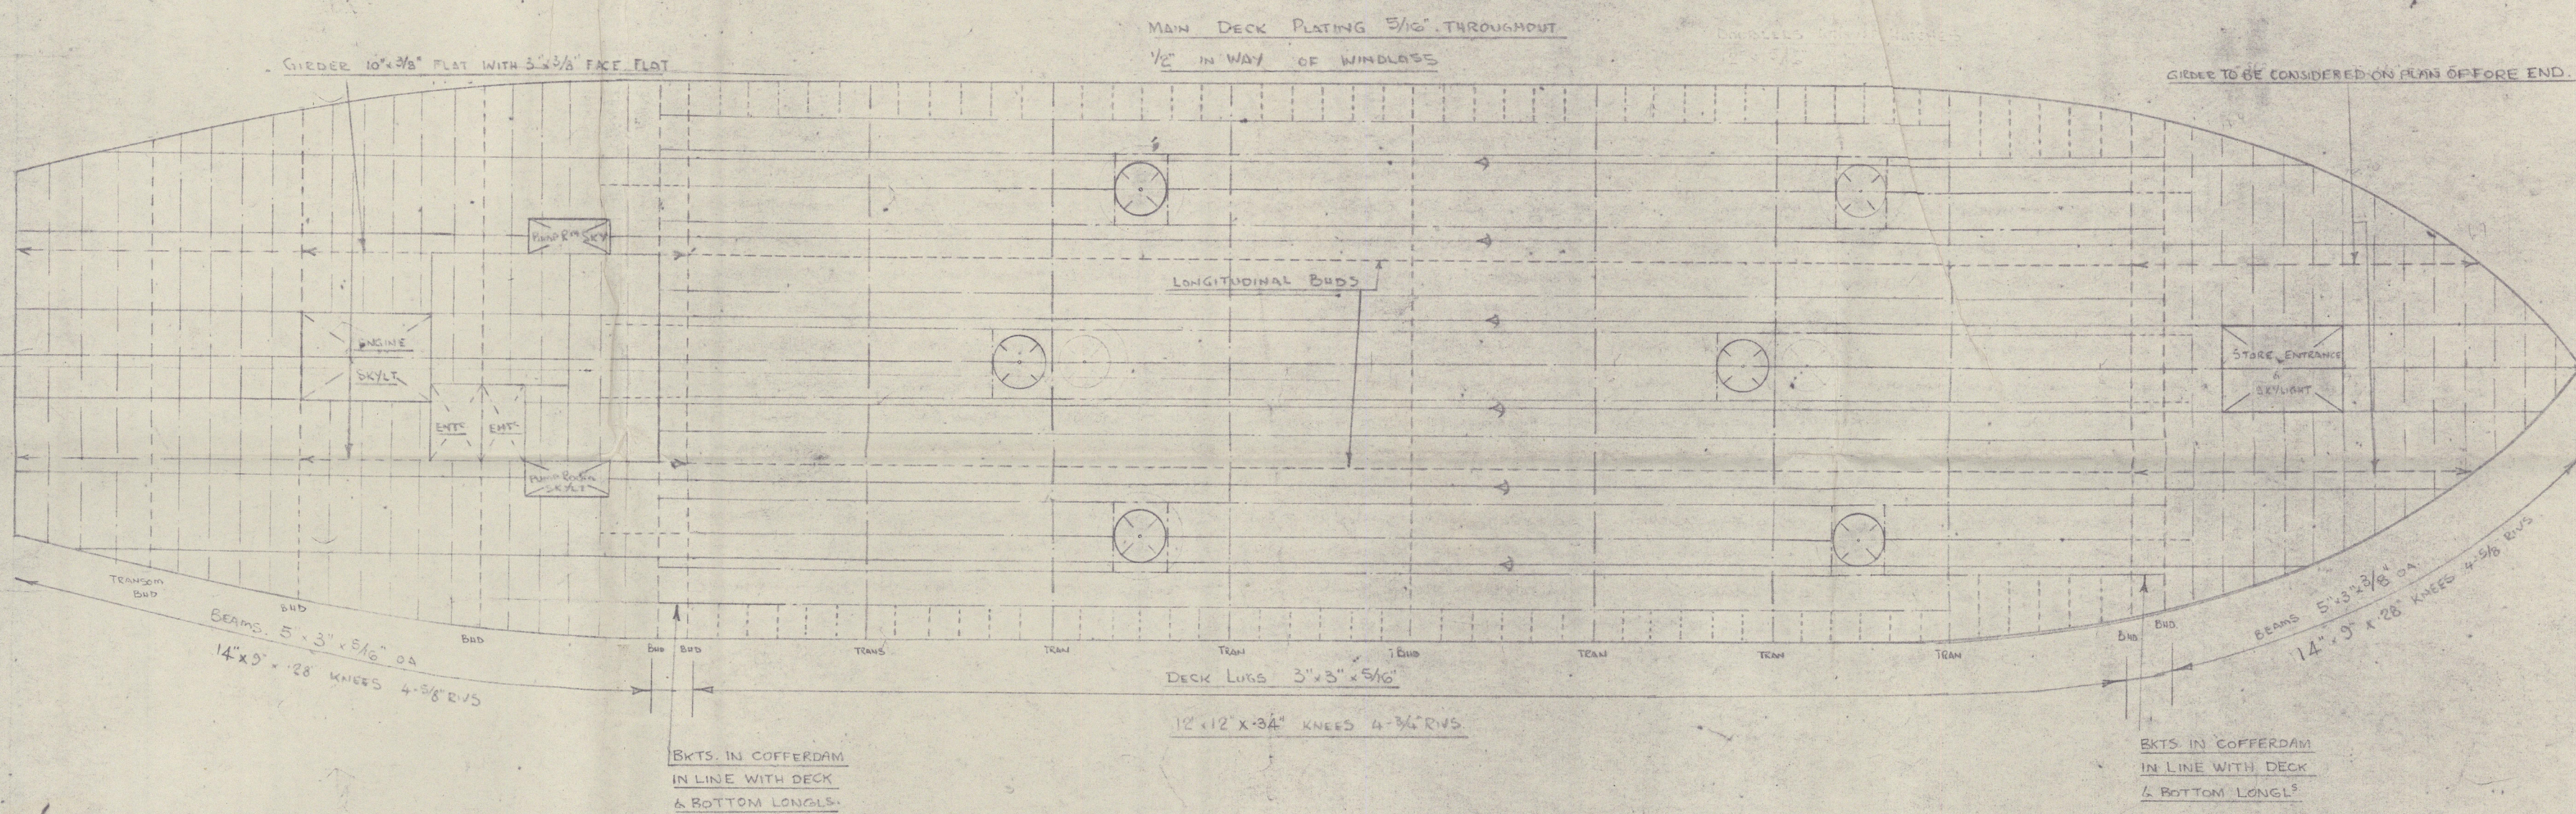

C. CAMPLING (GOOLE) LTD.

GOOLE Drawn by: *QJ* Date: 14/5/58 YORKS



Profile & Decks (As built)

C. Campling (Good) Ltd

Tank No 16

Barge C 871

Full F.E. Report No 66257

RECORDS DEPT.,
LONDON.



© 2020

Lloyd's Register
Foundation

010943 - 010952 - 0059