


MIDSHIP SECTION & O.T. TRANS^y BULKHEAD.

SCALE :- $\frac{1}{2}'' = 1 \text{ FOOT}$



PLAN N° 10829

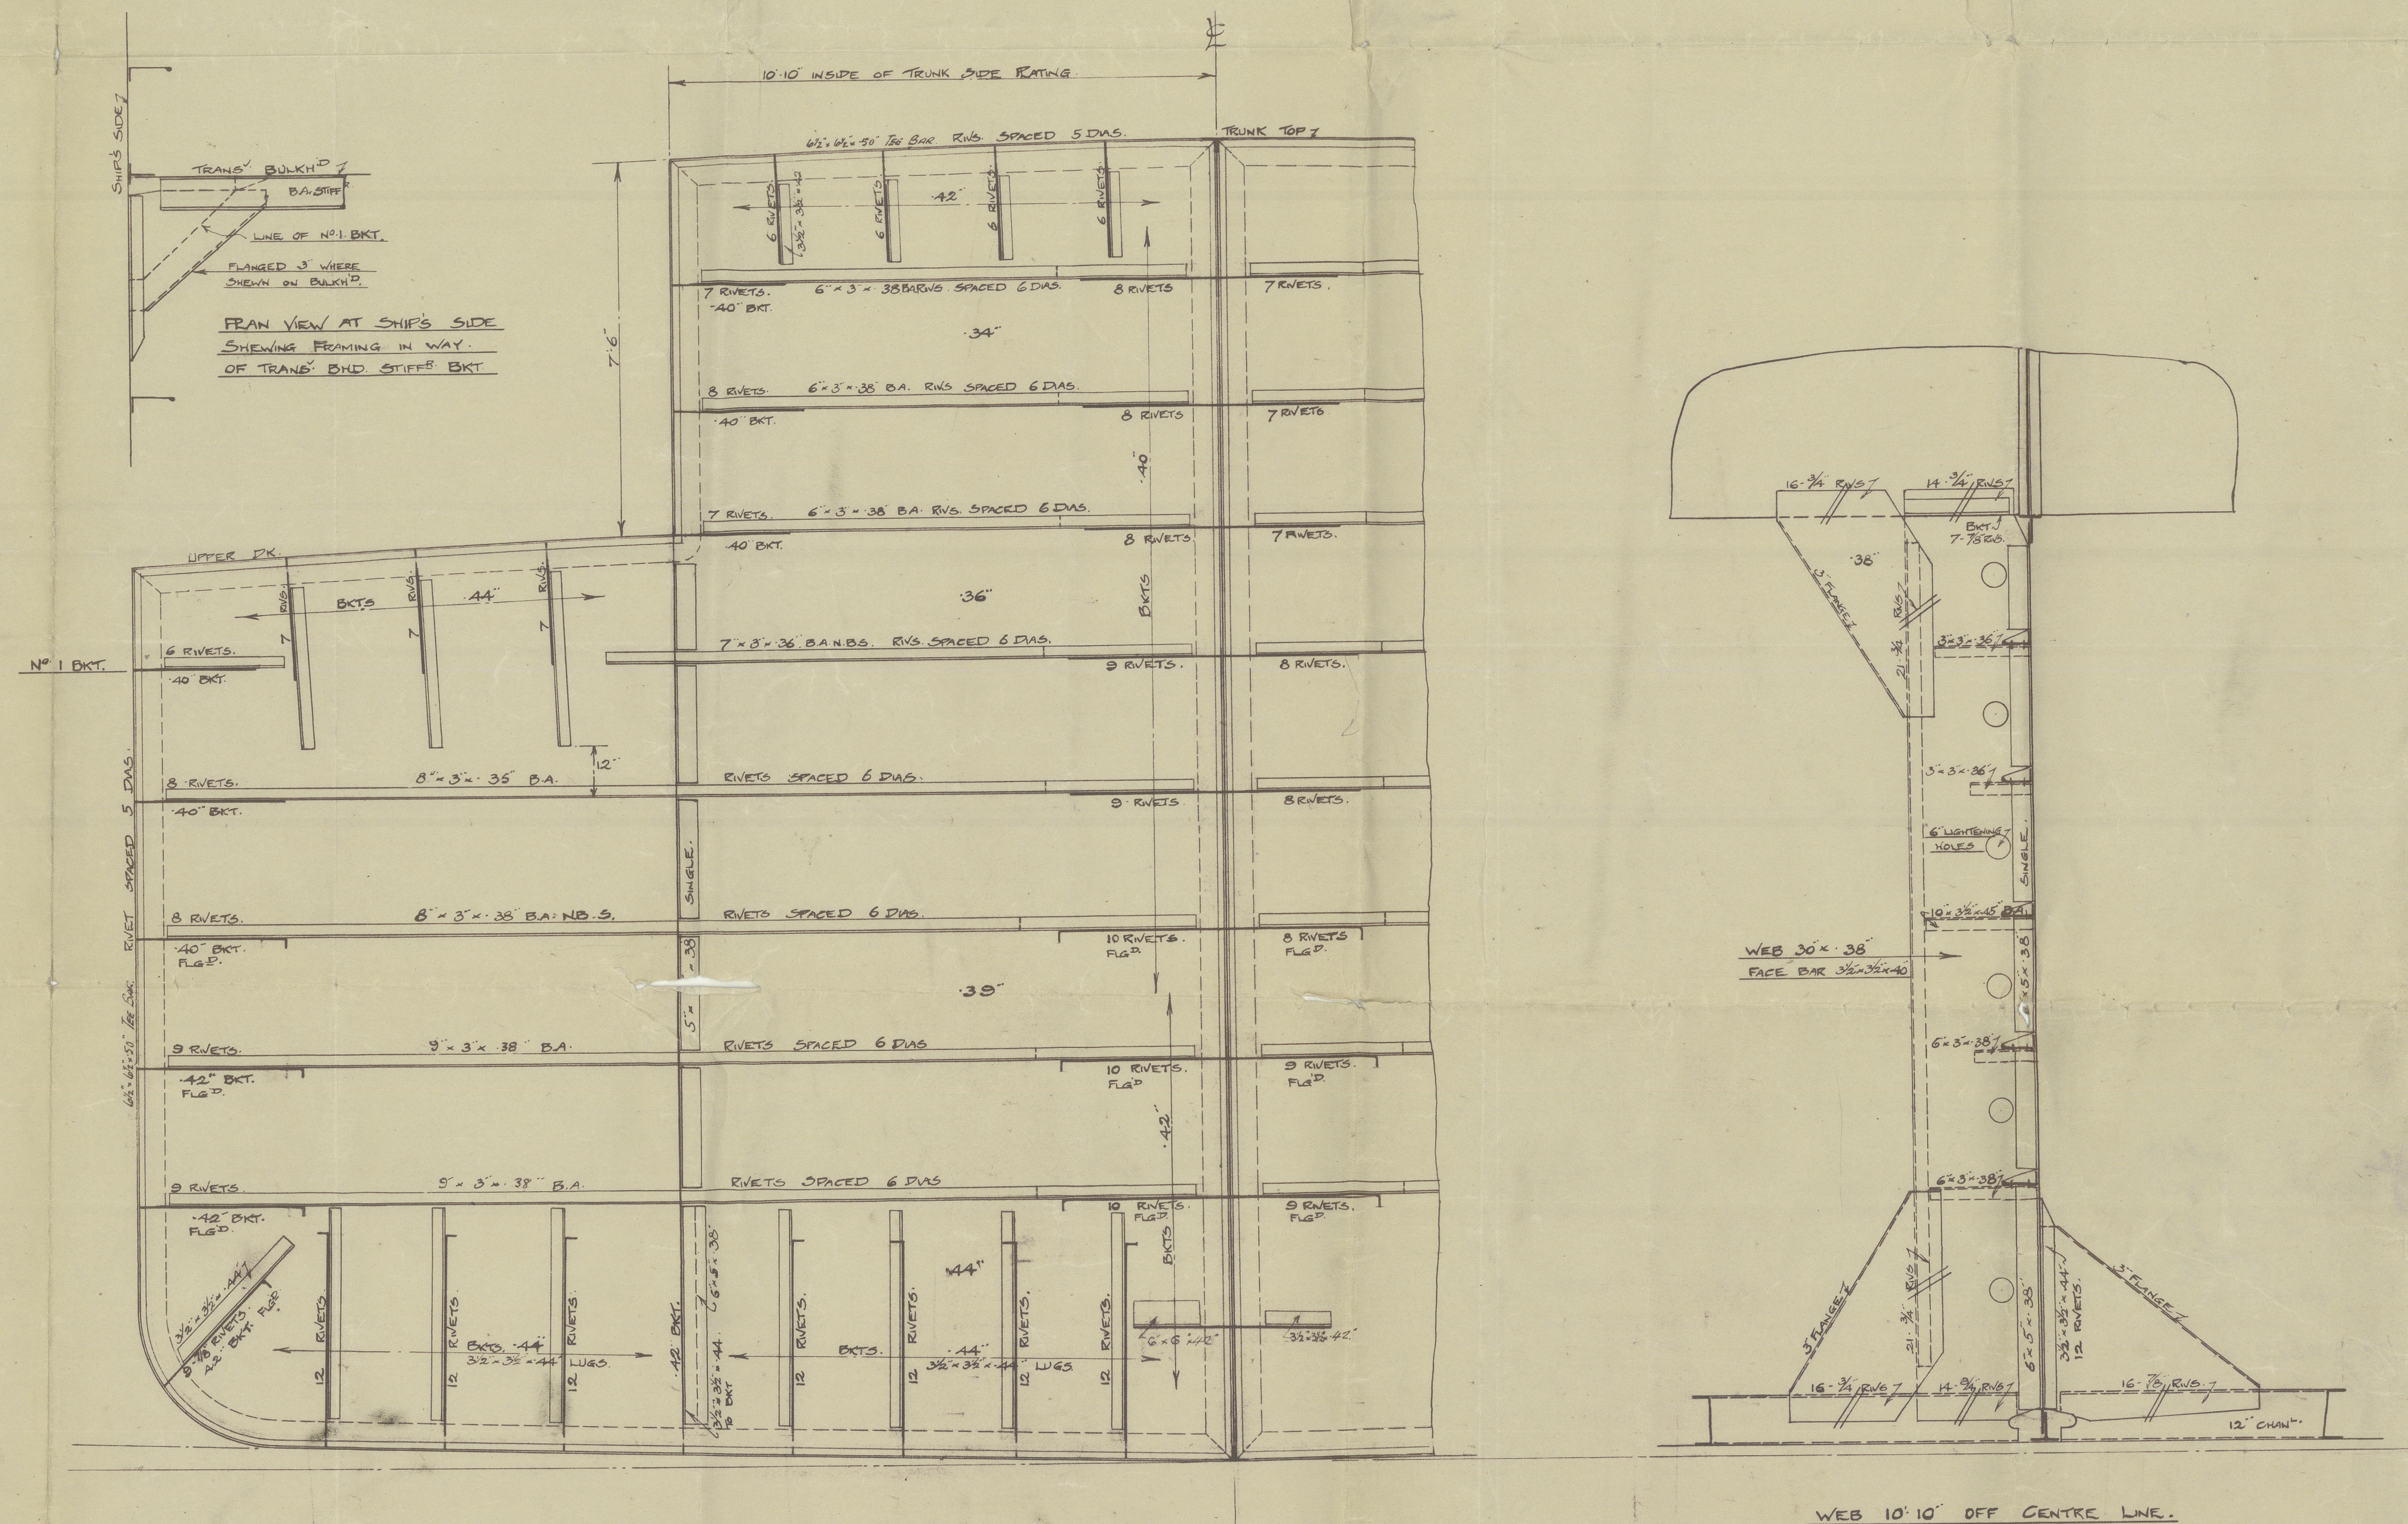

MES⁴⁵ FURNESS S.B. CO.
N^o 209 "BRITAM LUBE"
WV

MIDSHIP SECTION T
O.T. TRANSVERSE BULK^o
AS BUILT.

Abd up No 14605

$\Delta 2 \text{ 85' } \text{ of } 18'$
 $= 3790 \text{ tons FW}$


$d = 16.08'$

Equp

28 33 at

1st G out reat

210 ft 1 $\frac{11}{16}$

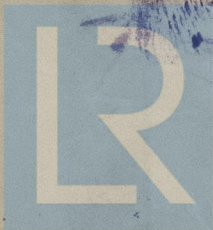

© 2021

Lloyd's Register
Foundation

01197-01206-0015