
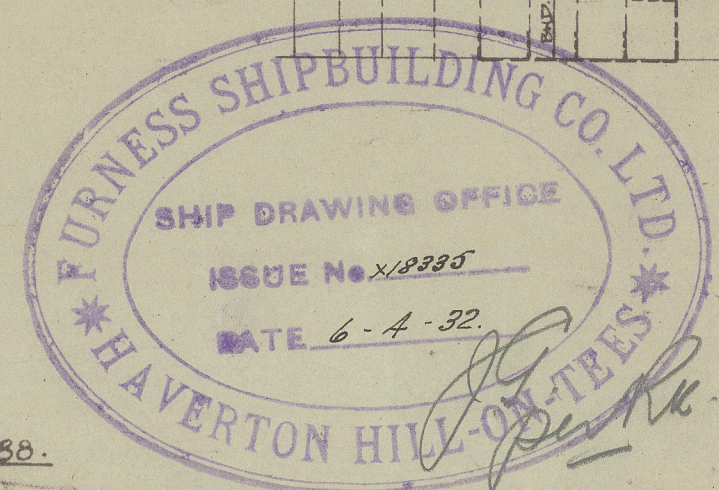
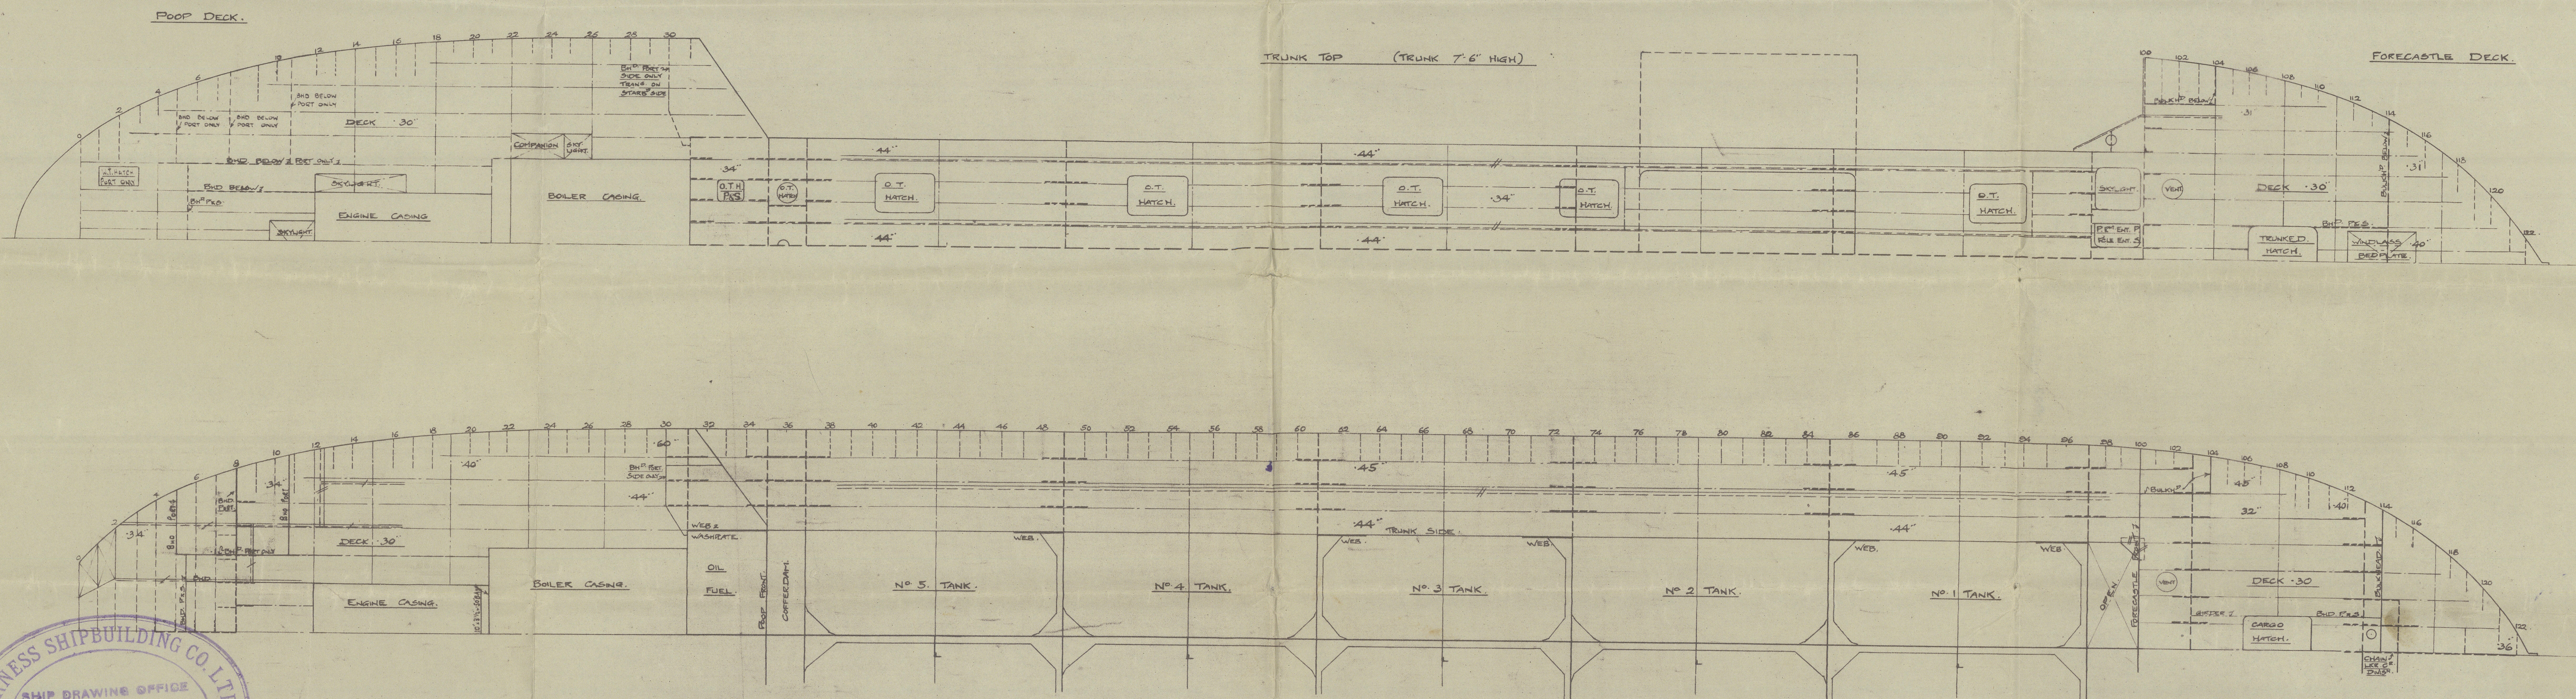


N^o 212 212
PROFILE & DECK PLANS.

DIMENSIONS:- LENGTH B.P. 250'-0", BREADTH MLD 43'-0", DEPTH MLD 18'-0"
 SCALE 1/8" = 1 FOOT.

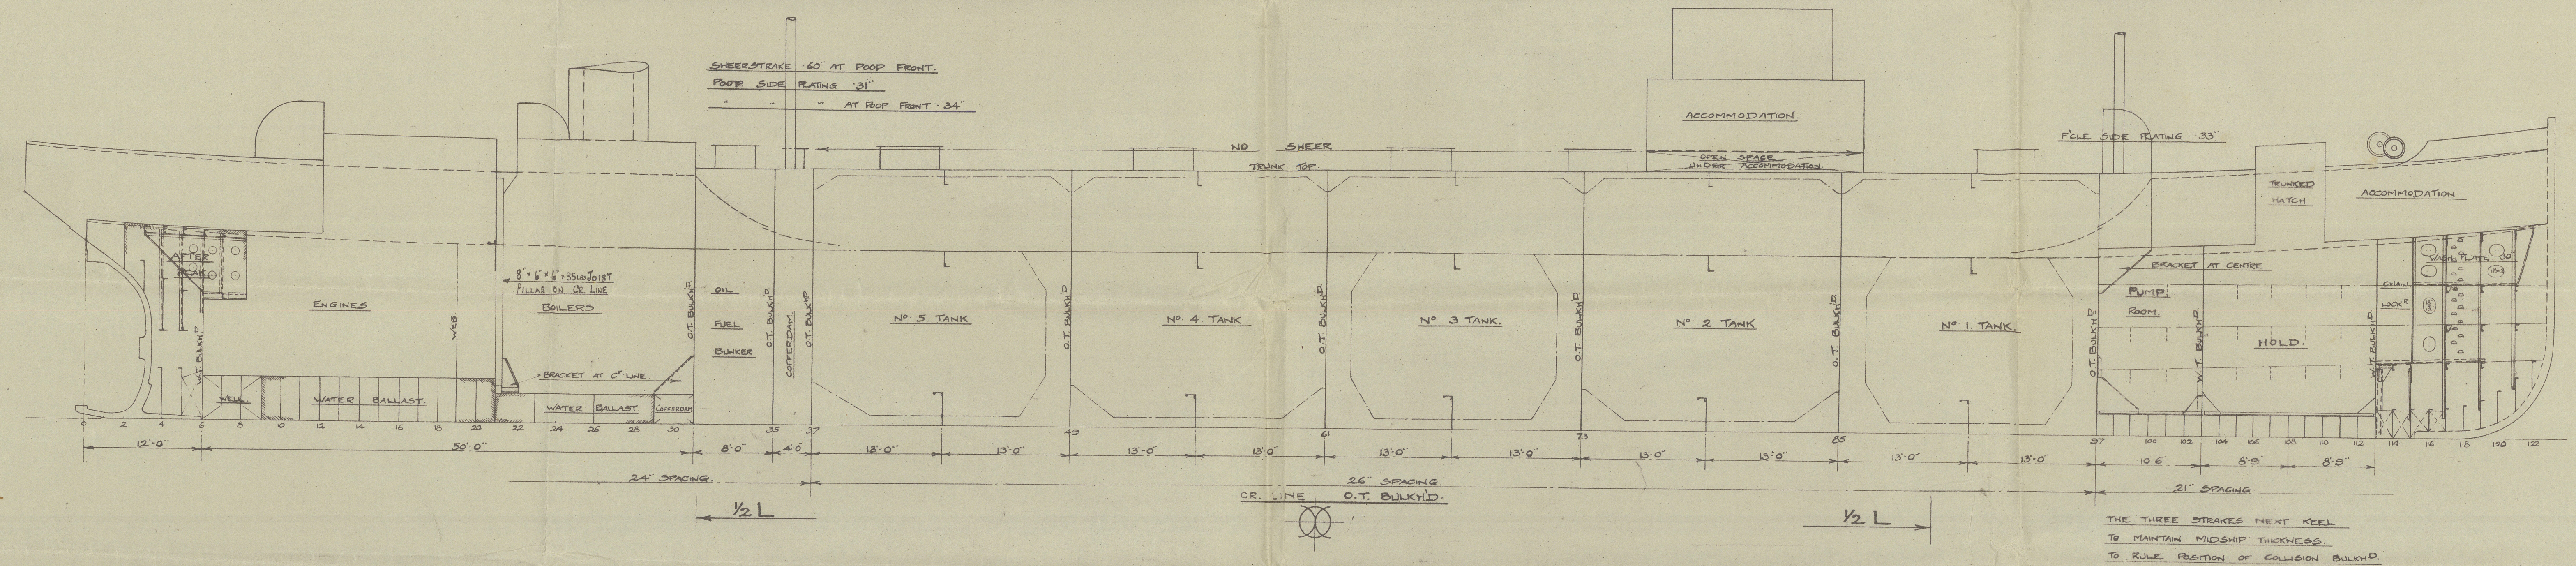

S.N. 10988.

MESS^{rs} FURNESS S.B. CO.
N^o 212 "BRITAM LUBE"

PROFILE + OK. PLANS
AS BUILT.

Mod. up to 14605



© 2021

Lloyd's Register
Foundation

01197-01206-0016