


No. 234.

# GENERAL ARRANGEMENT. *as built etc.*

SCALE: 1/8" = 1 FOOT.

Moulded Dimensions: 220'-0" x 39'-0" x 16'-0" / 24'-0".

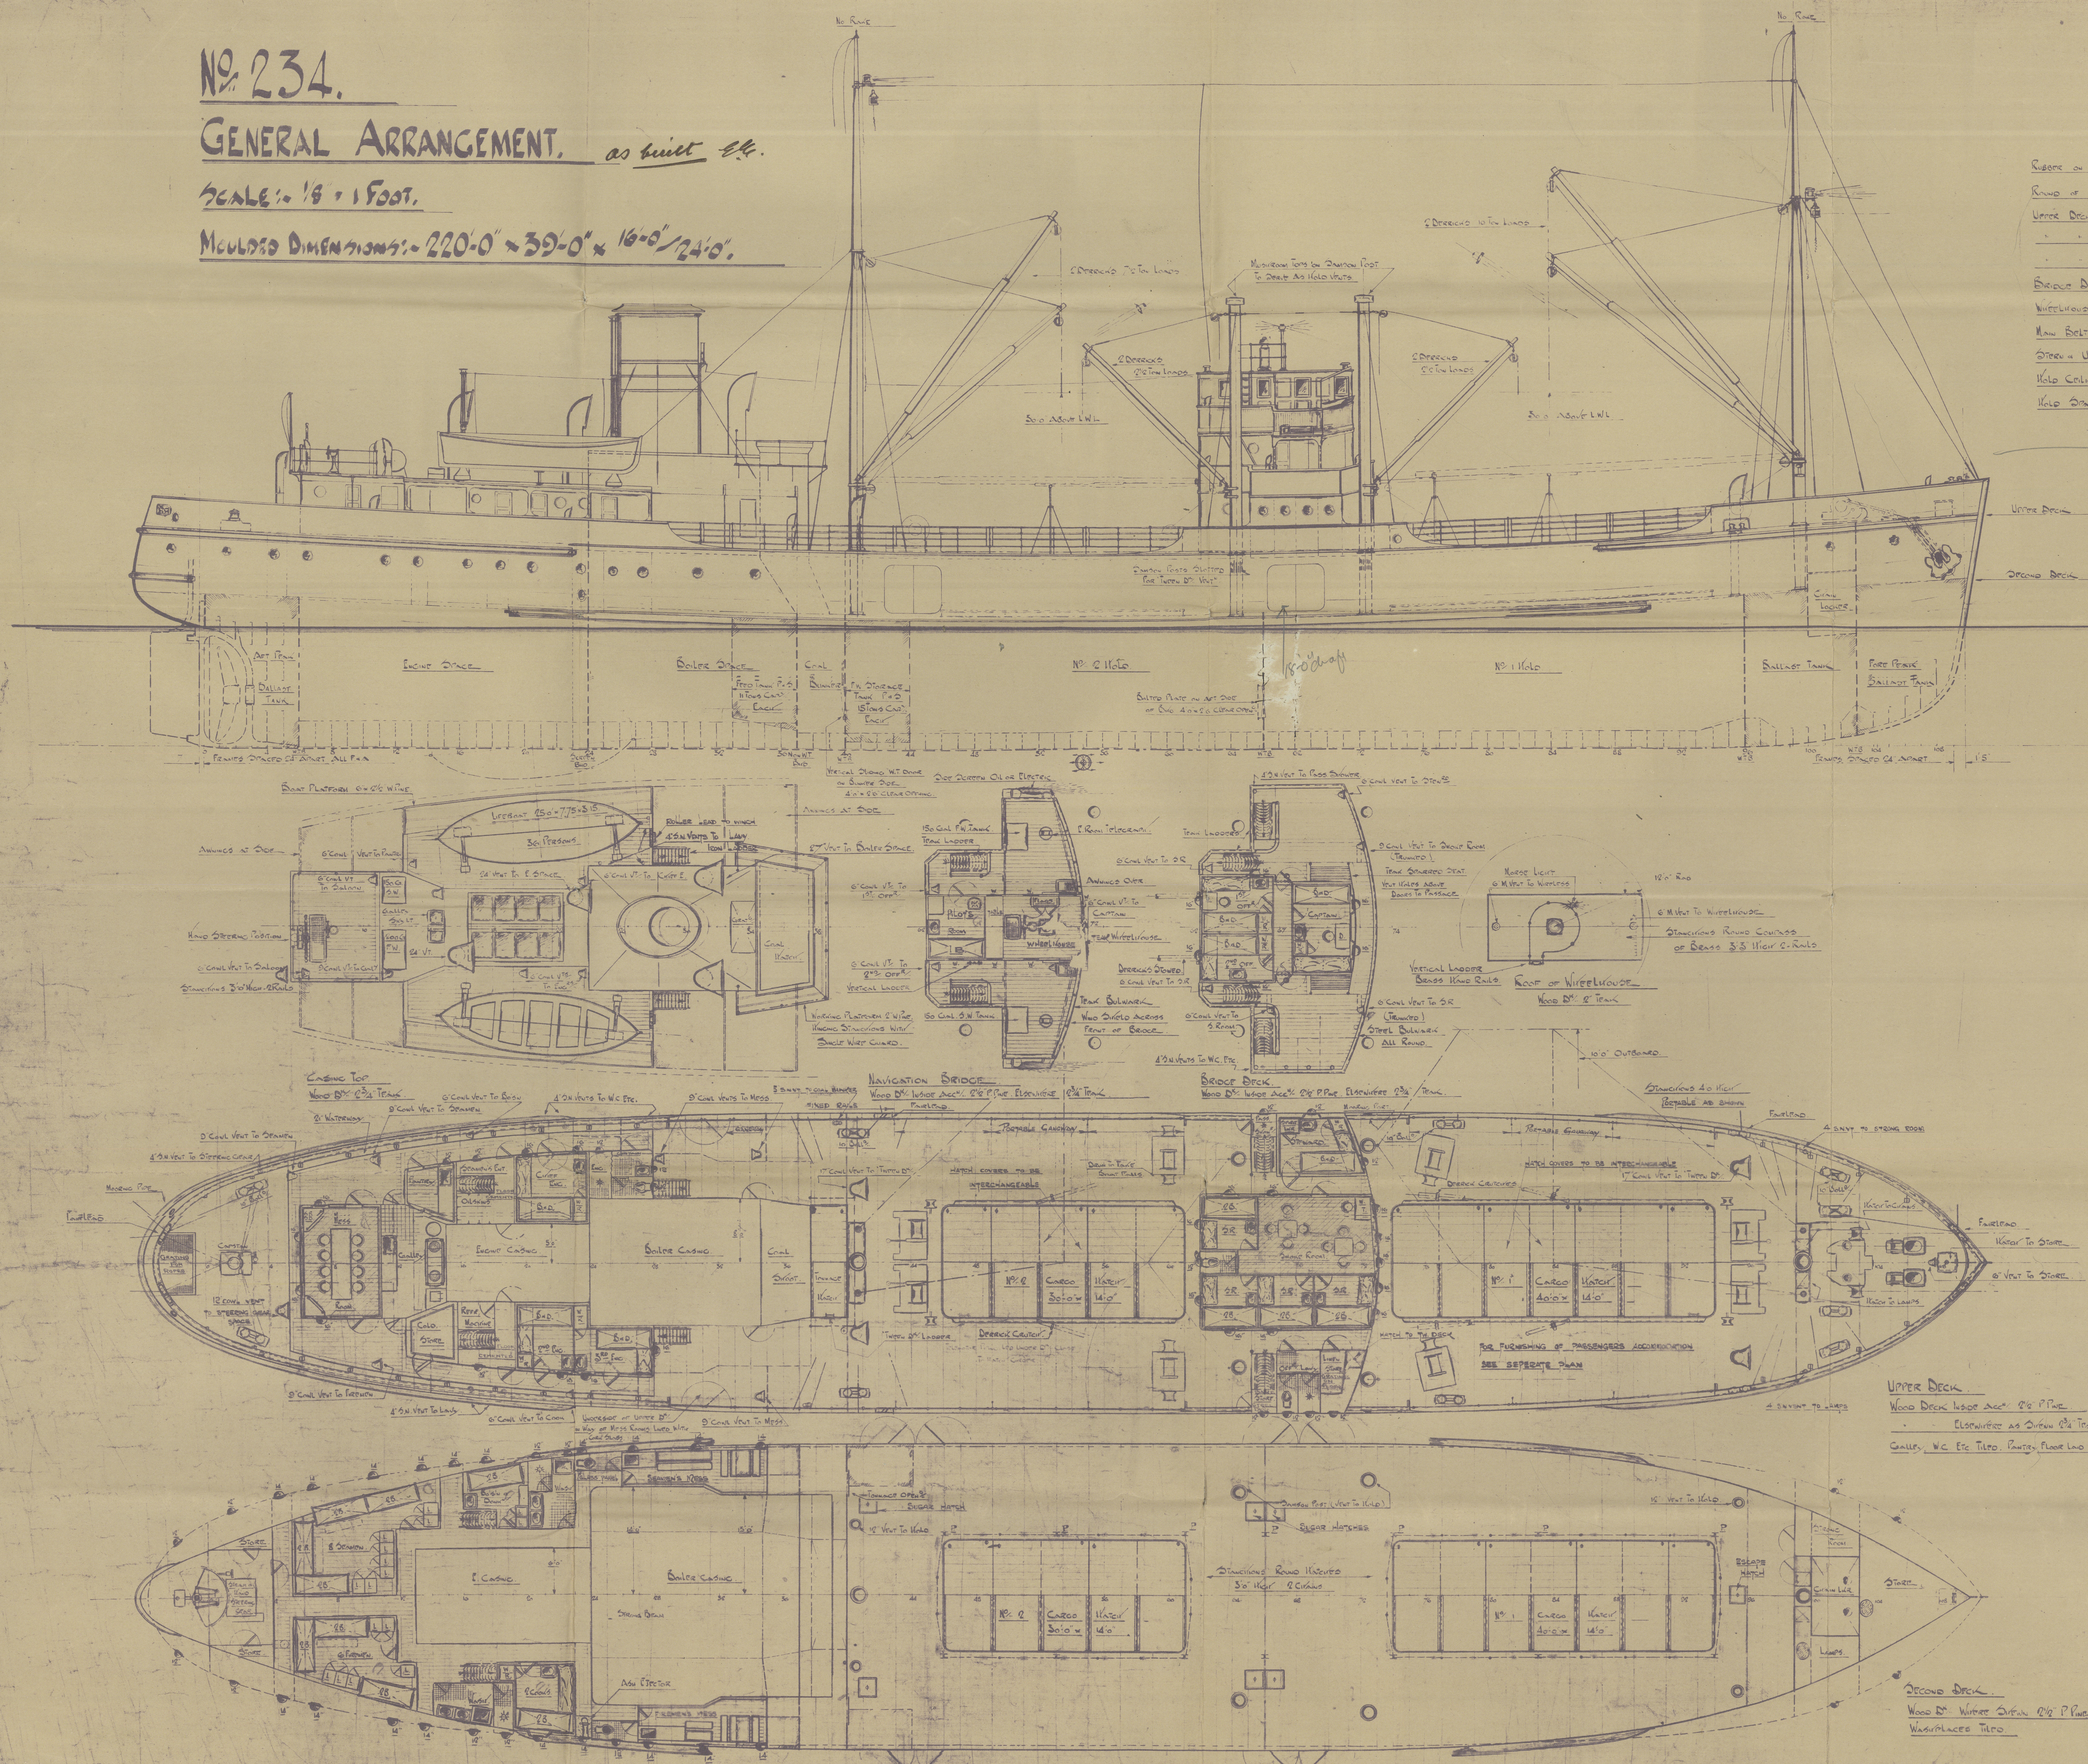

Structural Particulars

Rigging on Mast Full Length of 240' 0" 0"	
Round of Beam All Decks 39' 0" 0"	
Upper Deck to Lower Deck	7' 0" Beam to Beam
Casings Top	7' 0"
Lower Casings Top	7' 0"
Bridge Deck to Flyer Deck	7' 0"
Wharfhouse 7' 0" Beam to Beam	
Main Belting 10' 0" (Vertical)	
Deck in Upper Deck Belting 0' 0"	
Hold Ceiling 4' 0" for Bottom of Mast (Domestic 3)	
Hold Structure 0' 0" Bottom of Mast	

*no foot's LE.*

UPPER DECK  
Wood Deck 140' 0" 0" P. Pine  
Structure as shown on Plan  
Galleys, W.C. Etc. Tiers, Pumps, Floor Laid on Board Per.

SECOND DECK  
Wood Deck 140' 0" 0" P. Pine  
Structure as shown on Plan  
Wardrooms, Tiers.

Drawing No. 234



Henry Robt L<sup>d</sup>

N<sup>o</sup> 234

General Arrangement  
as built

S.S. "Mulubinba"

Lth. Rpt. No. 19330.

2



© 2021

Lloyd's Register  
Foundation

011235-011243-0237