



No 185. MIDSHIP TRANSVERSES.

SCALE - $\frac{1}{2}$ " = 1 FOOT.

ALL SECTIONS DRAWN LOOKING AFT.

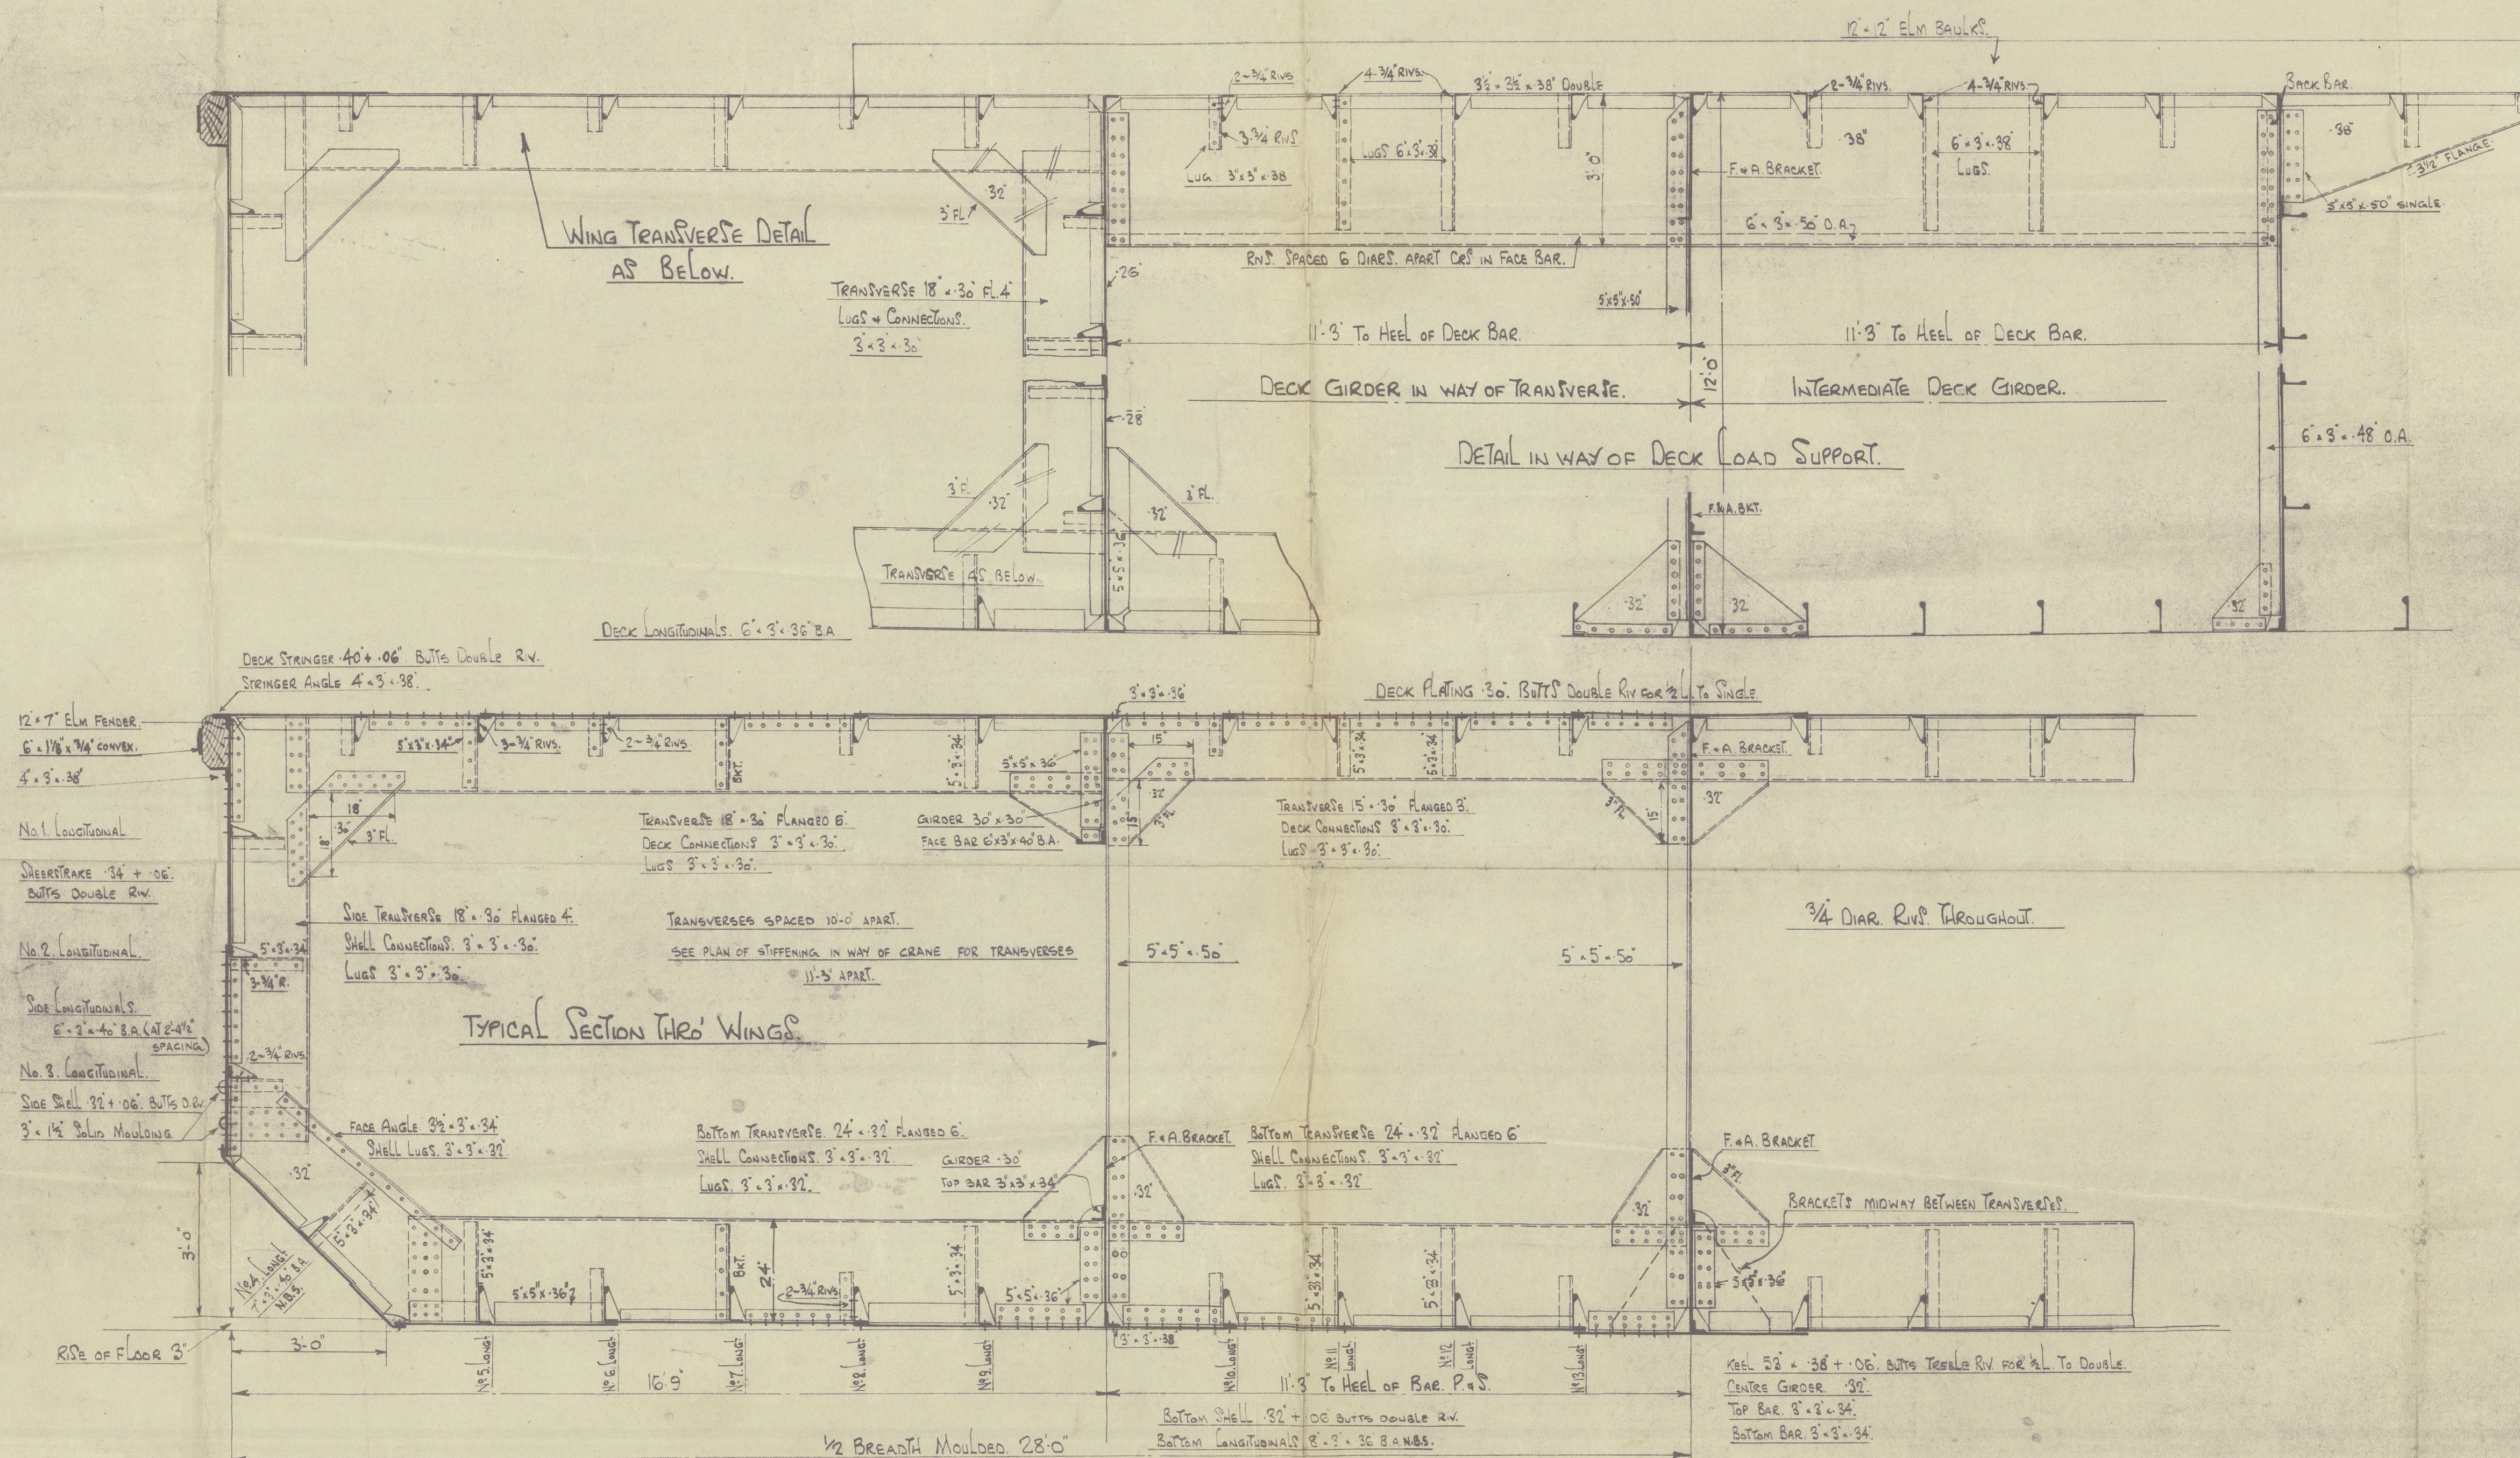

NOTE:- INCREASES AS SHOWN ON SHELL & KEEL & DECK STRINGER ARE OWNERS REQUIREMENTS.

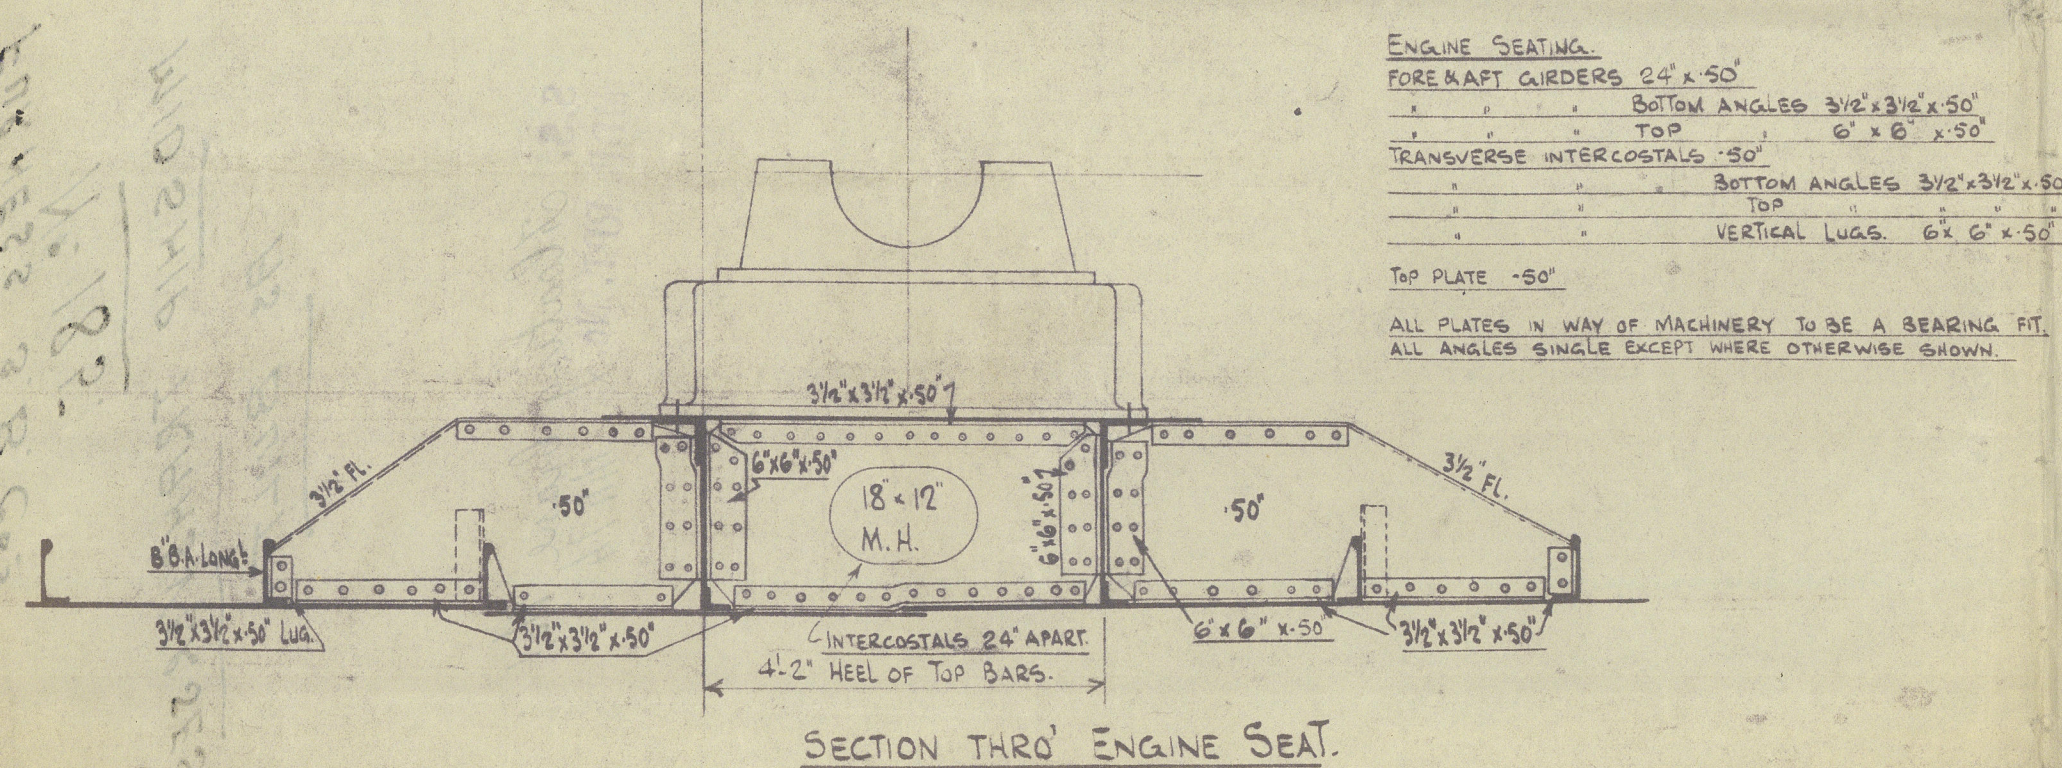

S. 10,492.

FURNESS S.B. CO'S

Nº 185.

MIDSHIP TRANSVERSES

AS BUILT.

S.S. Floating crane No. 1
MDB. RPT. No. X 144 74



© 2021

Lloyd's Register
Foundation

011251-011258-0075