

No 185.

# PROFILE & DECK PLAN.

(PONTON FOR 60 TON ELECTRIC FLOATING CRANE.)

SCALE:  $\frac{1}{8}" = 1 \text{ FOOT}$ .




DIMENSIONS:  $160'-0" \times 56'-0" \times 12'-0"$

TO CLASS A- CRANE PONTON FOR HARBOUR SERVICE.


SPECIAL NOTATION ~ LONGITUDINAL FRAMING.

## EQUIPMENT.

- 2 STOCKLESS ANCHORS @ 18 CWTG. EACH.
- 1 STOCKLESS ANCHOR @ 12 1/2 CWTG.
- 2 @ 36 FATHOM 1 3/8" STUD LINK CHAIN CABLE.
- 1 @ 36 " 1 1/8"

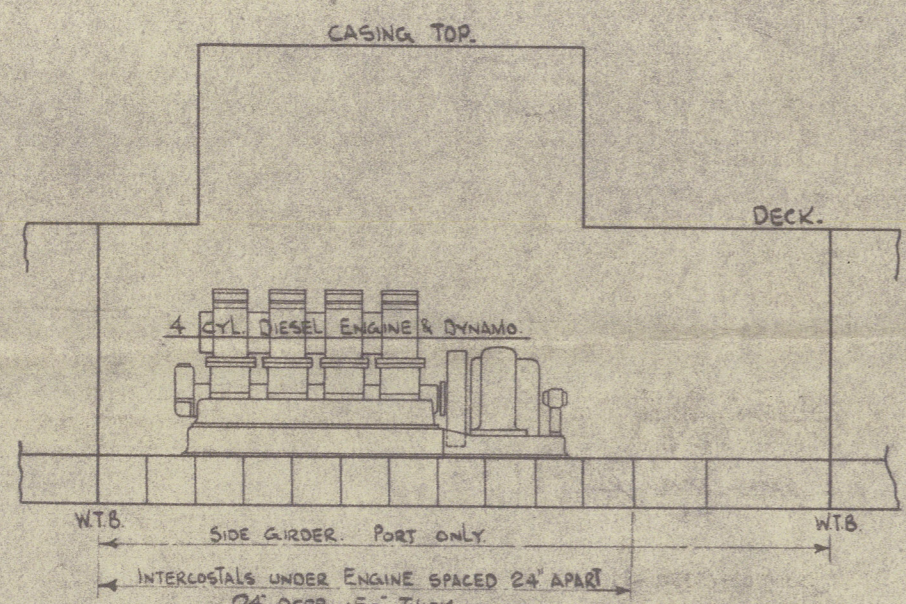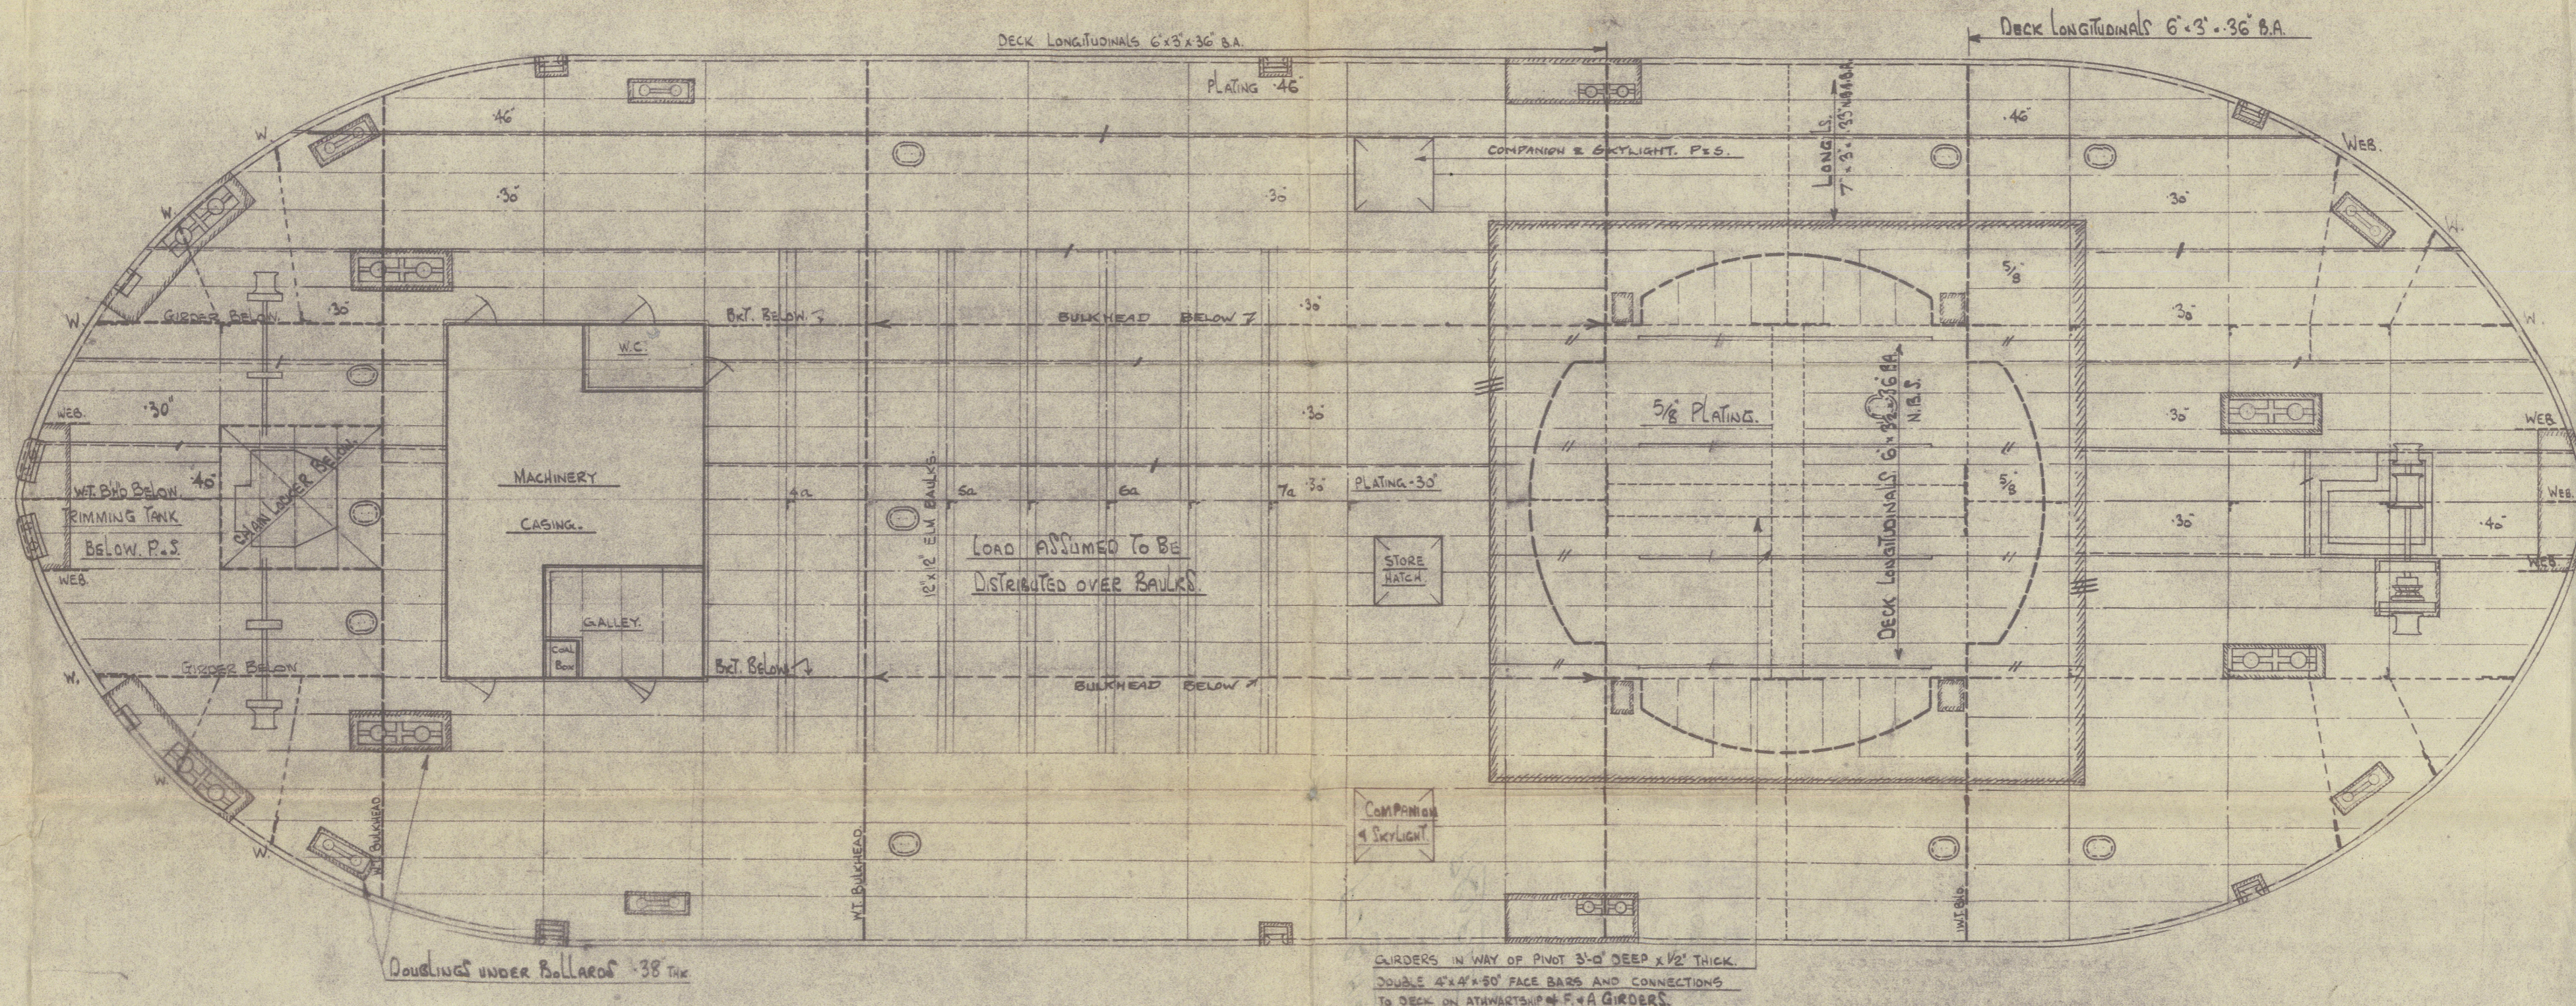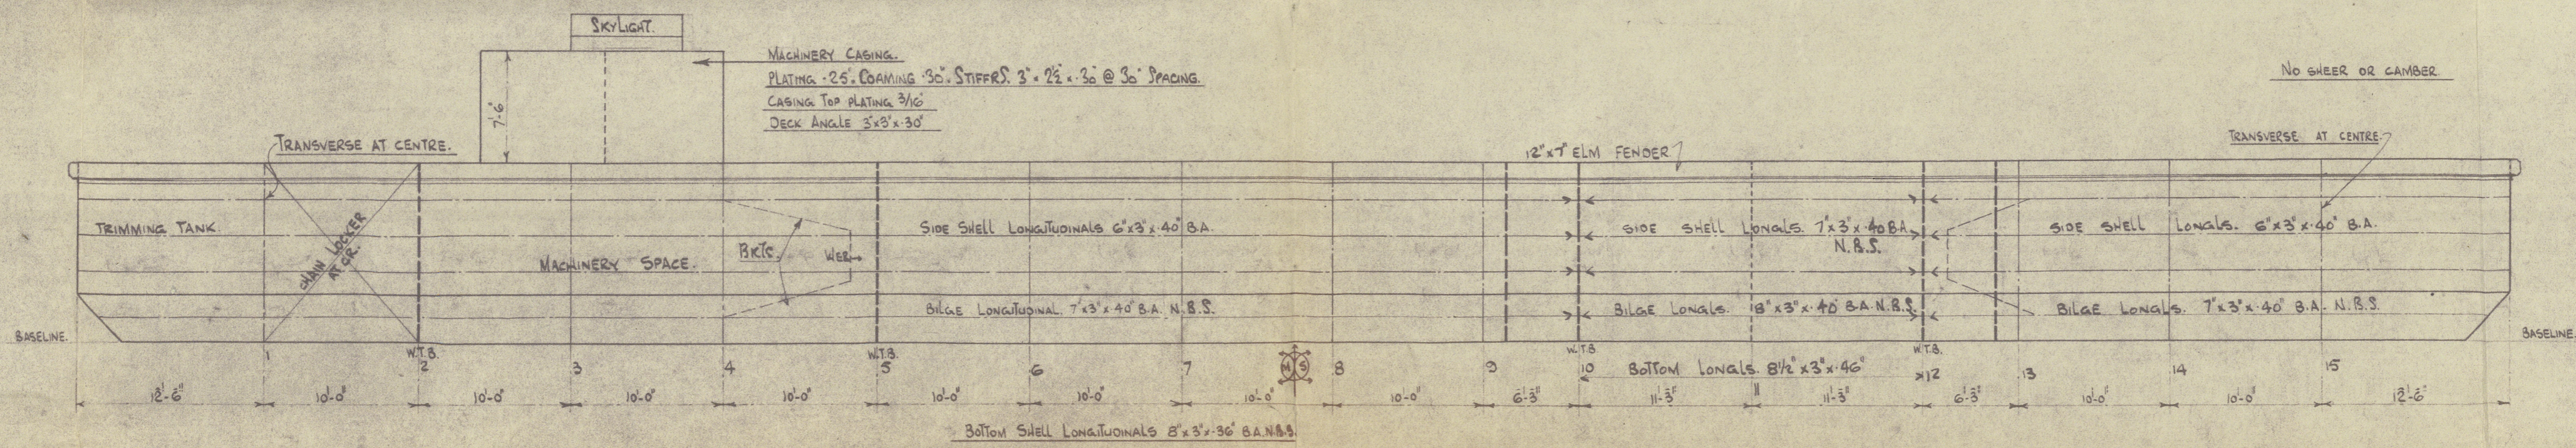

ELEVATION IN WAY OF MACHINERY SPACE.

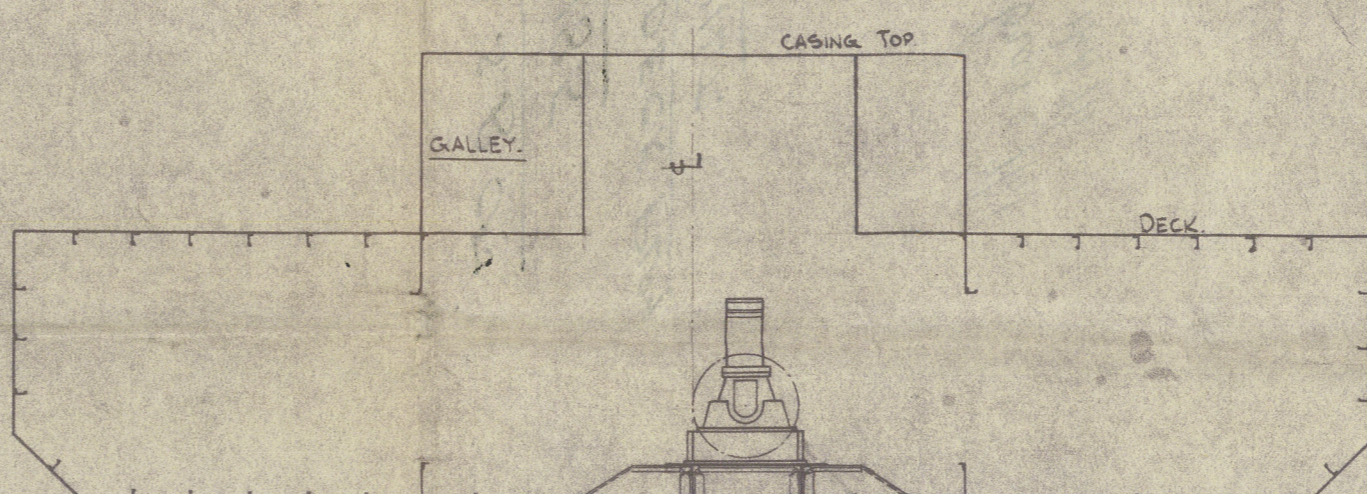

SECTION THROUGH MACHINERY SPACE.  
LOOKING AFT.



S.N. 10473.

011251-011258-0076

FURNESS S. B. CO.

No 185

PROFILE & DECK PLAN  
AS BUILT.

S.S. Floating crane No. 1  
MDB. RPT. No. 1447 1/4



© 2021

Lloyd's Register  
Foundation

011251-011258-0076