



PRINCIPAL DIMENSION		
L _{pp}	128.000	419'94
B	18.400	60'37
D	11.400	37'40
d	8.550	28'05

HISTORY


1. ORIGINALLY DRAWN JULY 13, '54
2. REVISED BY REQ. OF LLOYD DATED DEC. 14, '54
3. REVISED BY REQ. OF N. K. DATED NOV. 26, '54
4. REVISED BY REQ. OF OWNER DATED NOV. 30, '54
5. FINALLY DRAWN JUNE 8, '55

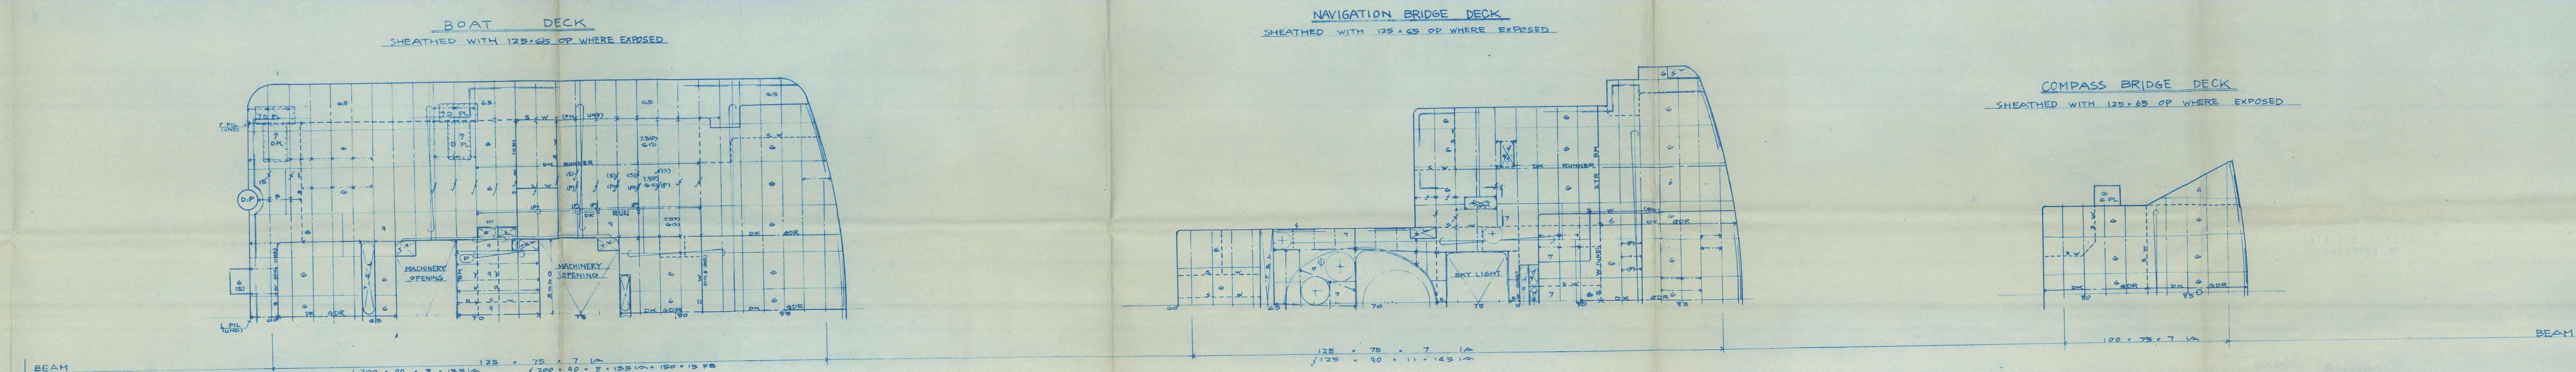

FINISHED PLAN

AL 1 : 100	DATE DRAWN JUNE 8 1966
YOKOHAMA  SHIPYARD & ENGINE WORKS MITSUBISHI NIPPON HEAVY INDUSTRIES LTD. HULL DESIGNING DEPARTMENT	
APPROVED	<i>Ichimada</i>
CHECKED	<i>H. Matsushita</i> (大井)
DRAWN	<i>J. Kawasaka</i> (川崎)
TRACED	<i>Y. Katsuta</i>
DATE ISSUED	
DRAWING NO	H-D-2


RECORDS DEPT.,
LONDON.

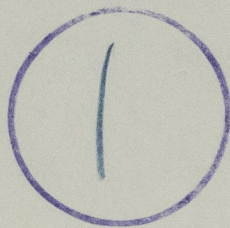

¹
Virginia Marsa ★
As Built.

Yka F.E. Rpt N°1693

*Certified Copy of
Approved Plan.*

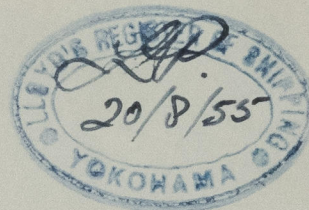

*General Construction
(Sheet .1)*



© 2021
18365

Lloyd's Register
Foundation

011368-011377-0169