



# SHELL EXPANSION AND LONGITUDINAL SECTION. SKALA 1:50

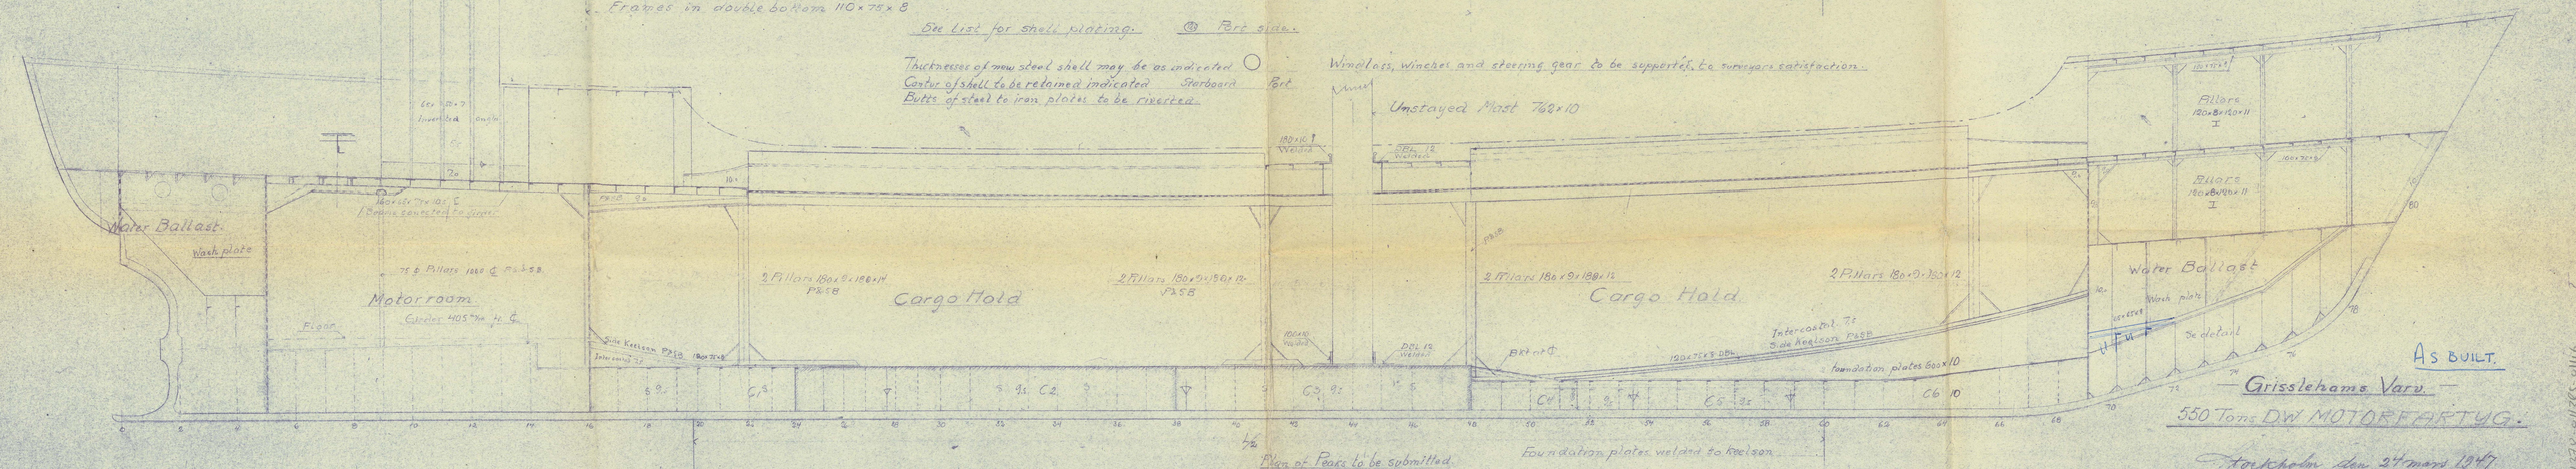

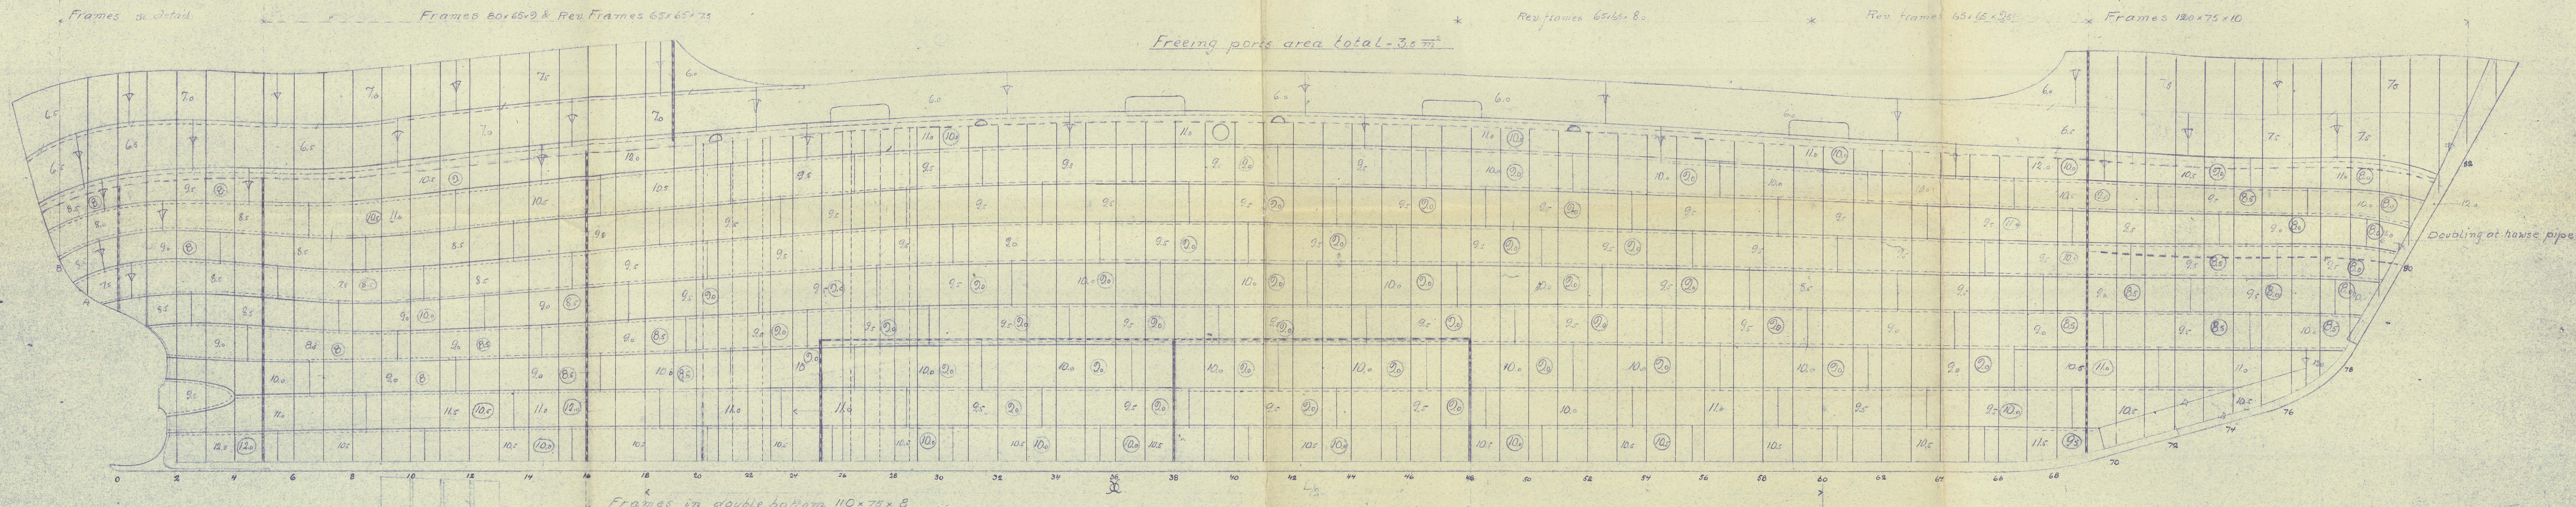

'BLENDA' ★


Shell Expansion

and

Longitudinal Section

(as built).

RECORDS DEPT.  
LONDON

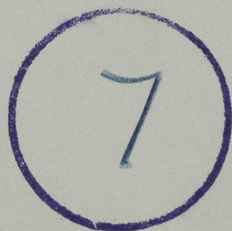

© 2021

Lloyd's Register  
Foundation

011378-011385-0146