

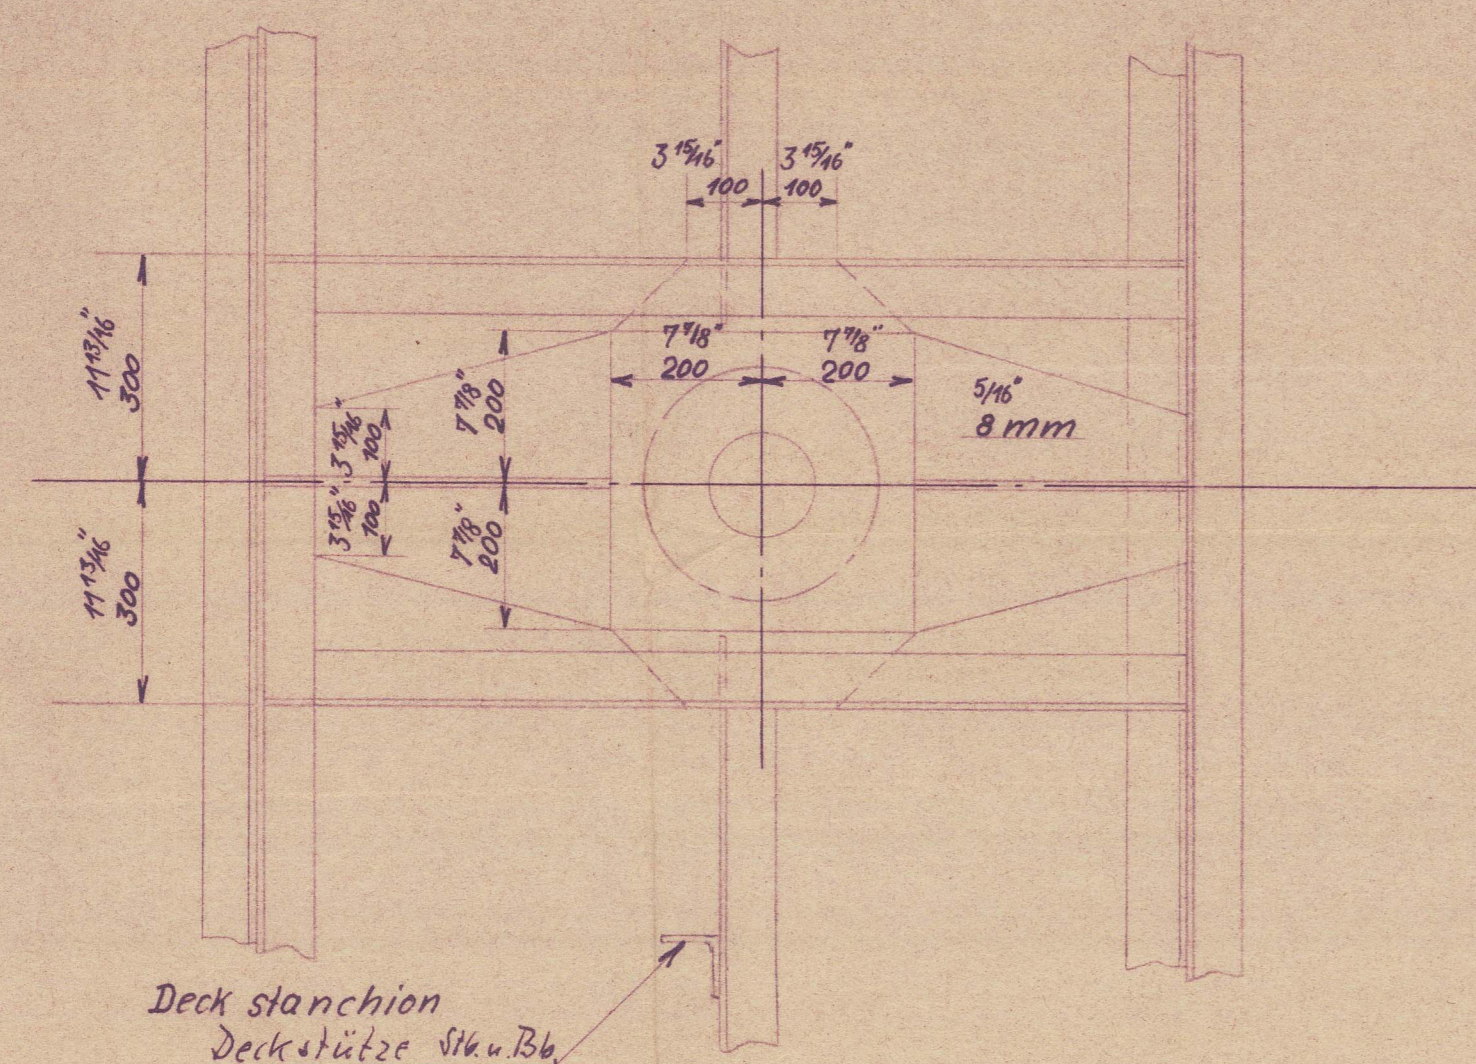


M. 1:10

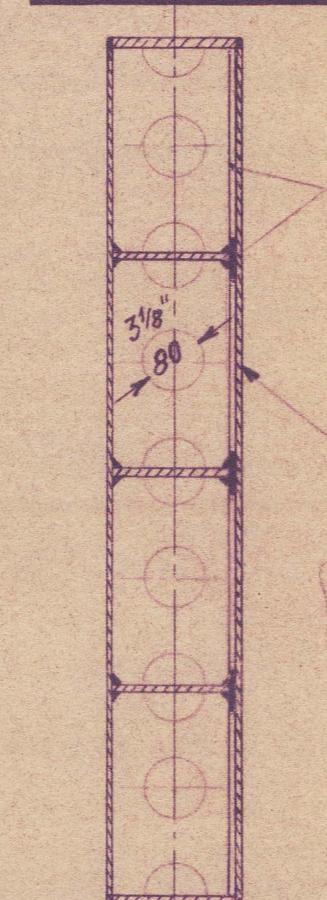


M 1:10

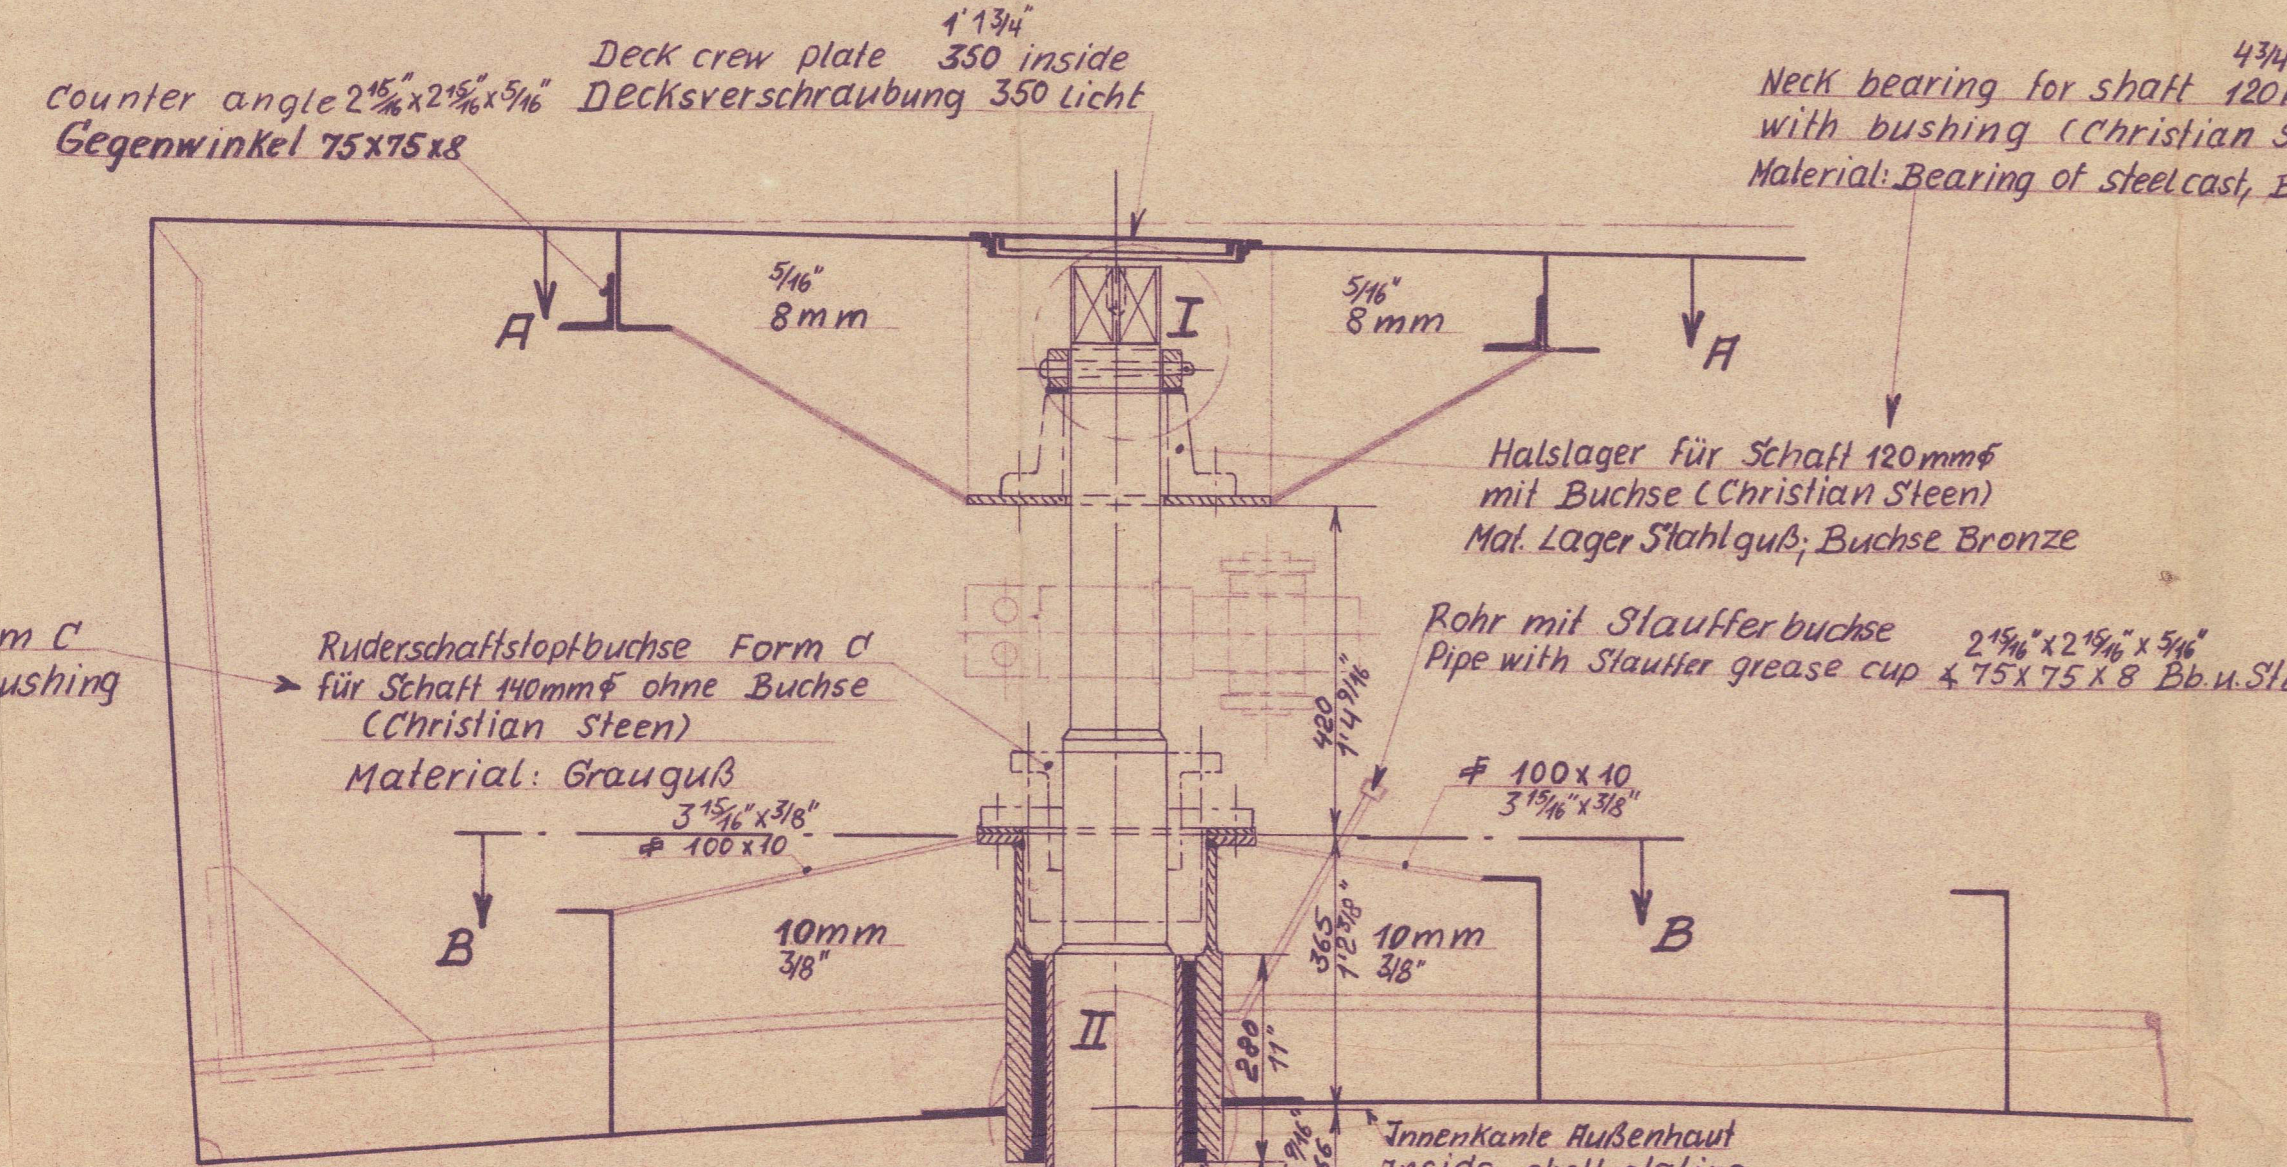


Bemerkung:

Verschweißung nach den Vorschriften von Lloyd's Register of Shipping  
Electr. welding according to Lloyd's Register of Shipping


M. 1:10

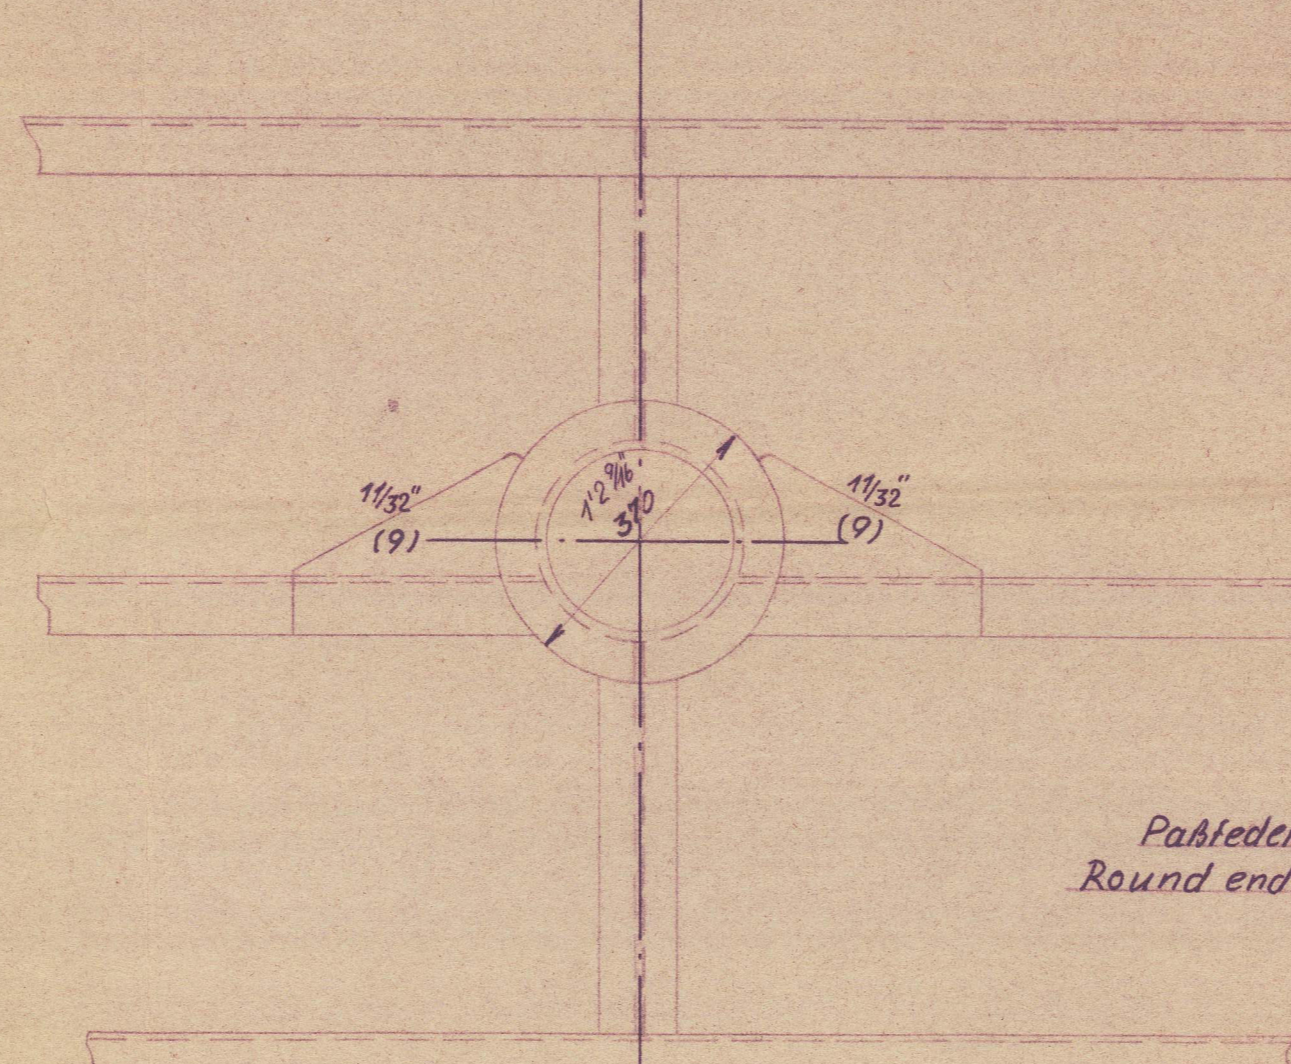


M 1:10

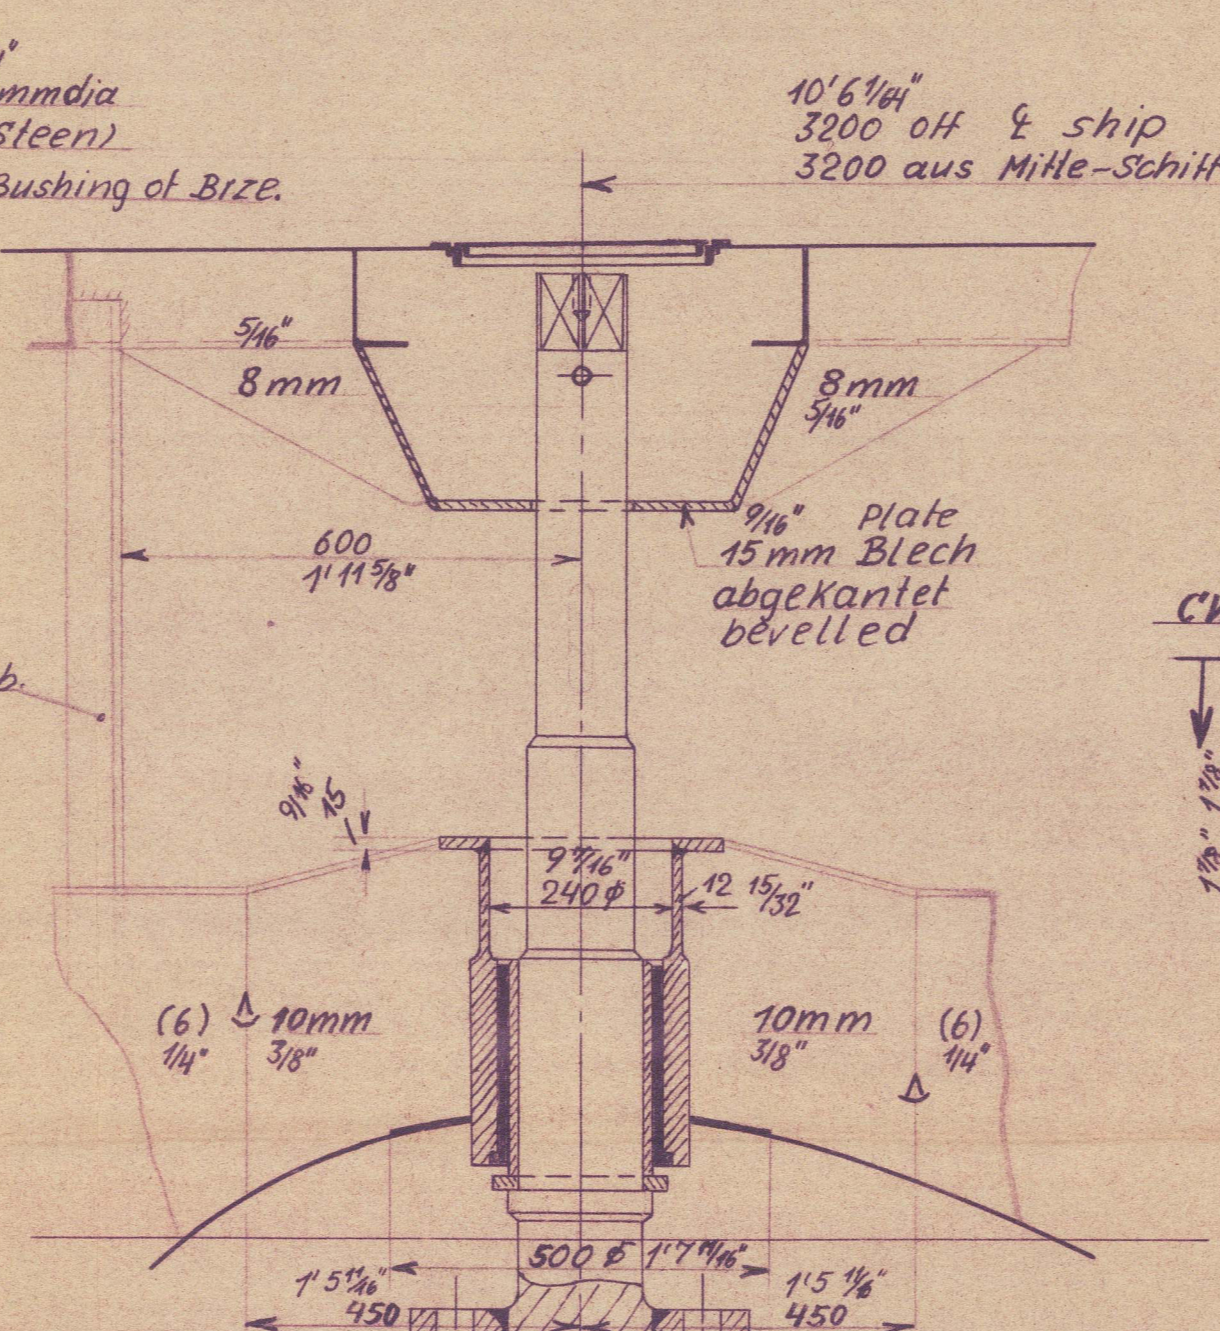


1 9/16" x 7/8" x 1 2"

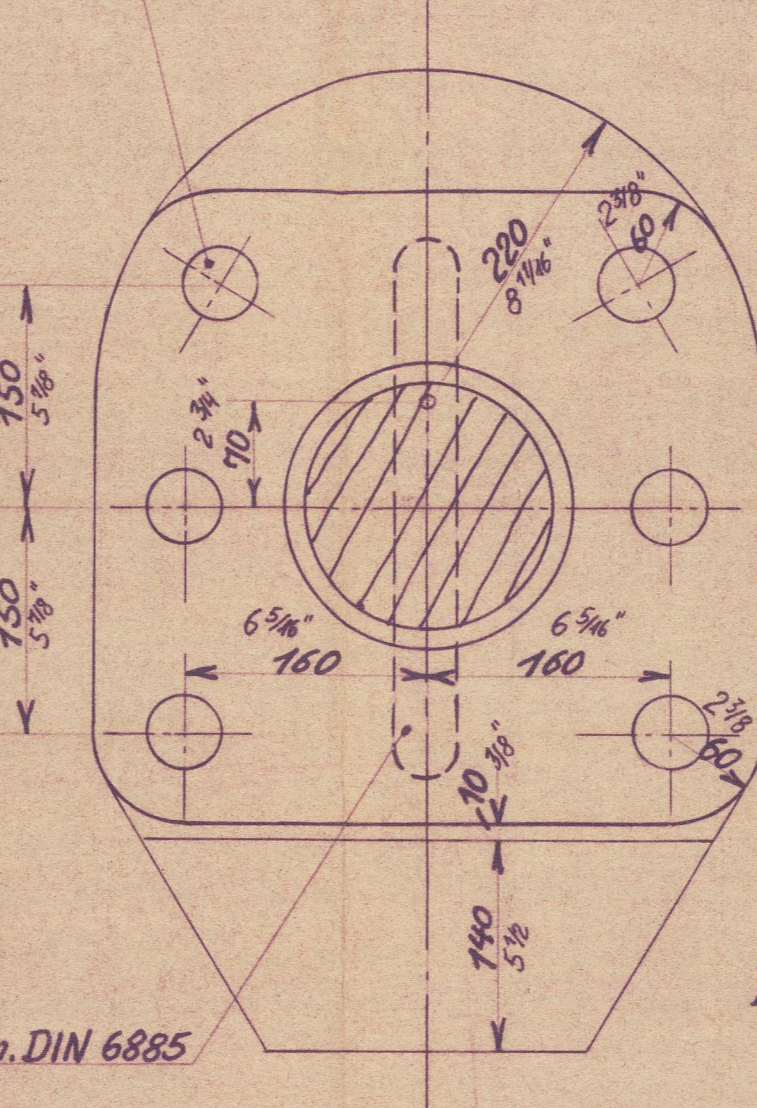

## M 1:5

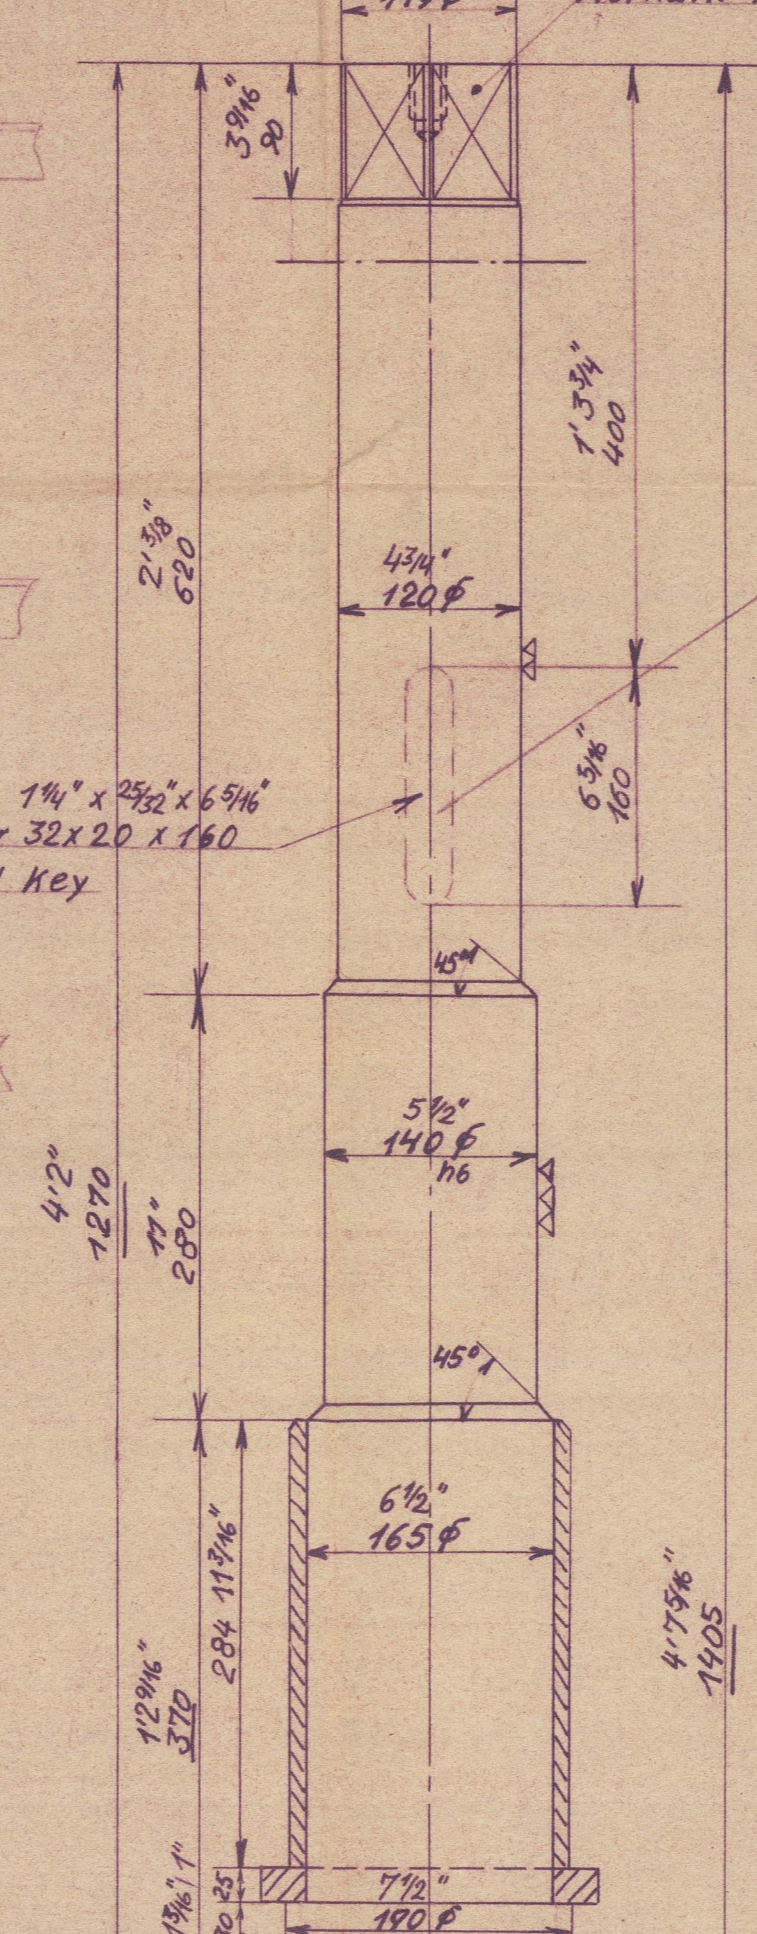


Fitting bolt M48 with nut  
Paßbolzen M48 mit Mutter  
und Sicherungsblech DIN93

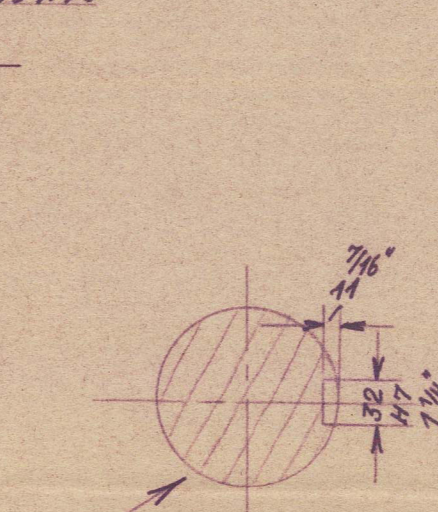

Cone pin  $25\frac{1}{32}'' \times 7\frac{1}{2}''$   
Kegelstift  $20 \times 20$   
Material: St 60 -

## M 1.1

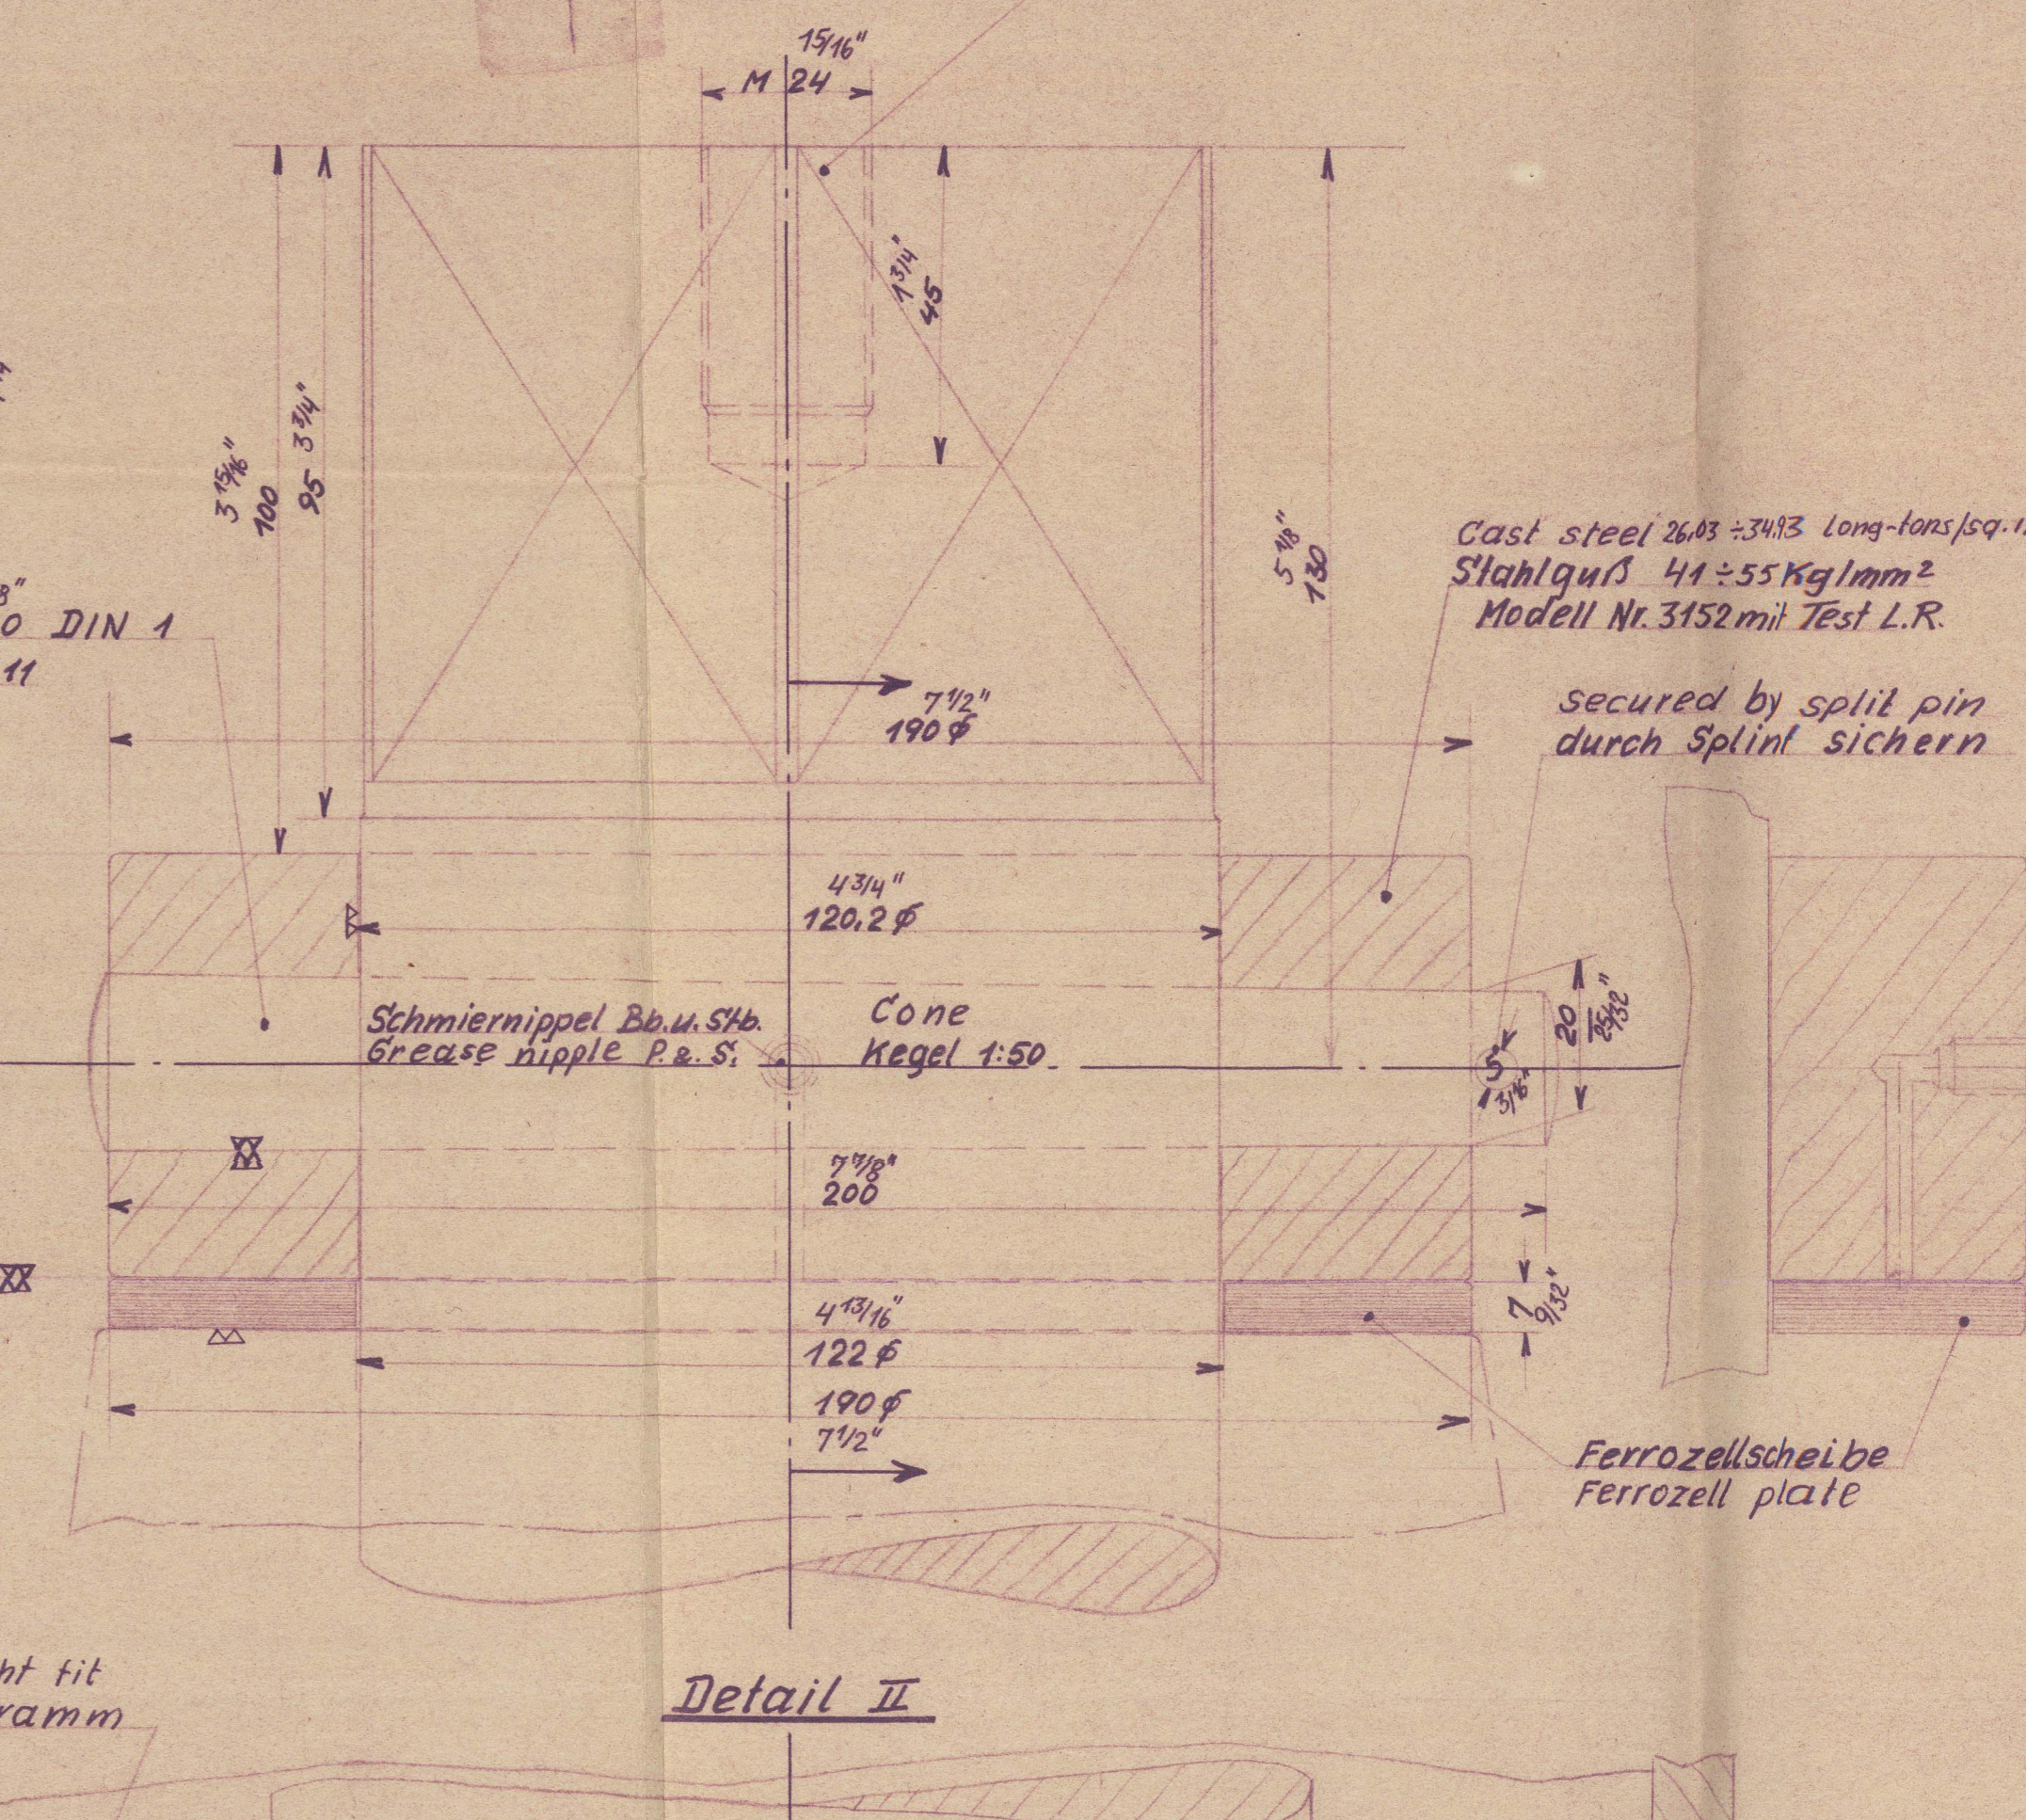

1

The choice of approved materials for bushes and liners is to be the responsibility of the Builders and Owners

Remanit bushing shrunk on  
Remanitbuchse aufschrumpten  
(Remanit = Korrosion Stahl)  
(Stainless-Steel)

Ohne unsere Genehmigung darf diese  
Zeichnung weder vervielfältigt noch dritten  
Personen mitgeteilt werden.  
(§ 1 und 11 des Gesetzes vom 19. 3. 1911)

**Abeking & Rasmussen**  
Lemwerder i. O.

Steel cast 26.0 ÷ 34.9 long tons/sq. in.  
Stahlguß 41 ÷ 55 kg/mm<sup>2</sup>  
(Schweißbar mit Test L.R.)  
Modell Nr. 3151

87% plans, and includes any modifications and/or  
2250 additions to the original approved arrangements made during construction which have  
been approved locally as being in accordance  
with or equivalent to Rule requirements. 12

Signature L. O. Hummel Yard No. 5894  
 Consignee(s) to Lloyd's Register of Shipping

Date 21.7.94 Speed abt 9.25 knots  
 Rudder shaft dia with 10% reinforcement Geschwindigkeit ca 9.25 Knoten  
 Ruderschafte Ø mit 10% Verstärkung  
 2794 = 40.00 long-tonnage in weldable  
 Material: SM St. 44 + 63 kg/mm<sup>2</sup> schweißbar, C-Gehalt 0.22

Ruderanlage Rudder System  
5892/93 u. 94 Passagier und Wagen-Fähre

512.62 *Arrest*  
Verst. nach Lloyd: 18.1.63/PD  
Ruder Kupplung 25.1.63 *Arrest*  
Puffballer & Rudermaschine 31.3.63


2.1.63	1:10		34517
	1:5		
"	1:1		
	Bayar		

20

© 2021


 Lloyd's Register  
Furnace data

RECORDS DEPT.,  
LONDON.

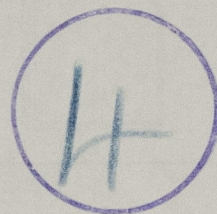

AS BUILT

Title of Plan Rudder System  
Builders Abeking & Rasmussen  
Yard No. 5894  
Engine or Boiler No. 7189  
Name of Ship "IWTA FARIDPUR" ★  
REMEN Report No. 7189

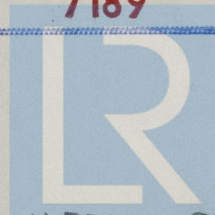

© 2021

Lloyd's Register  
Foundation

011544 - 011554 - 0058