
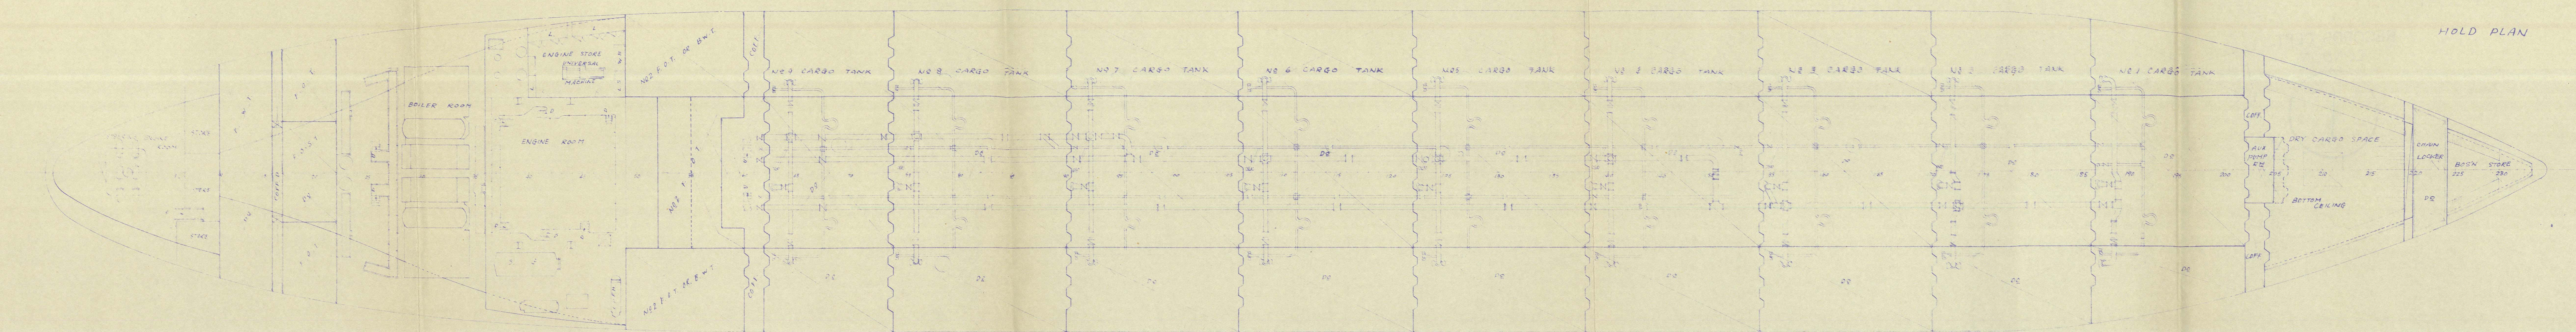
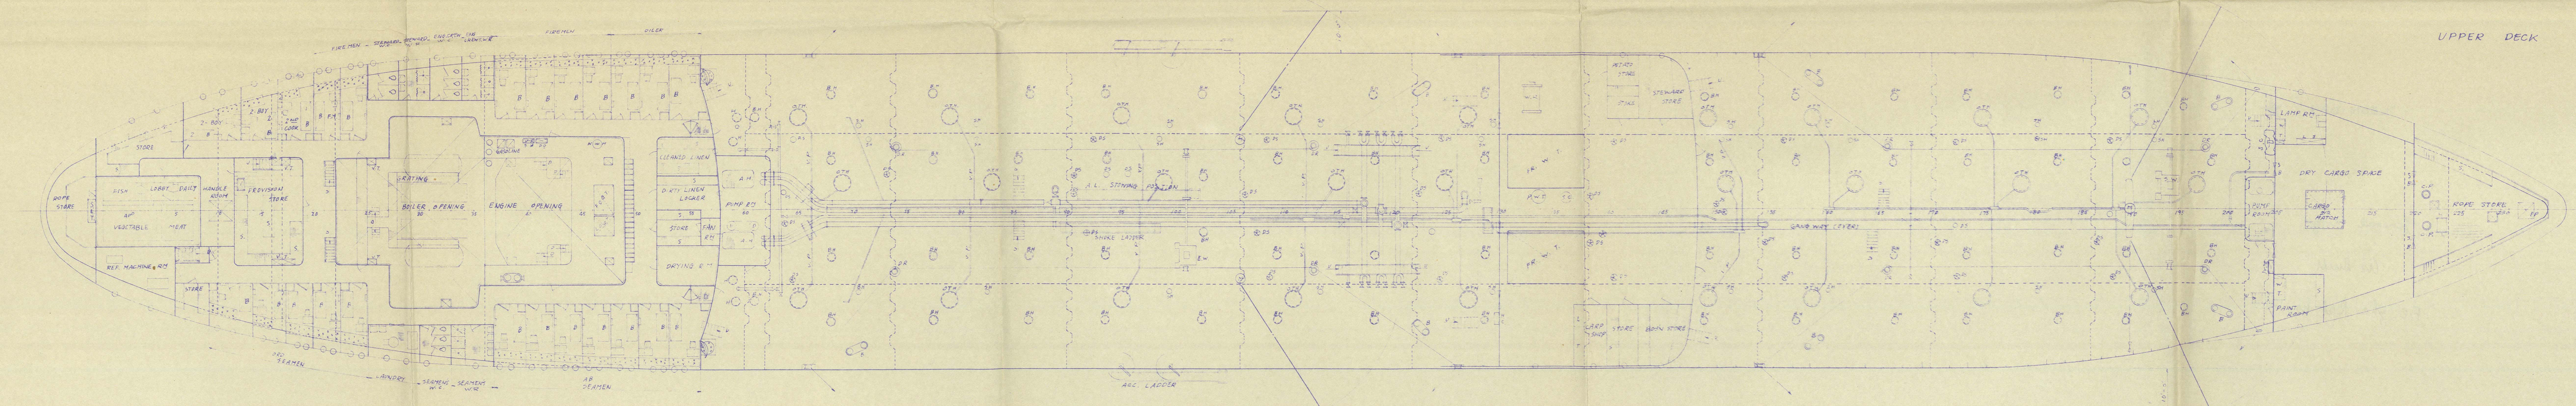
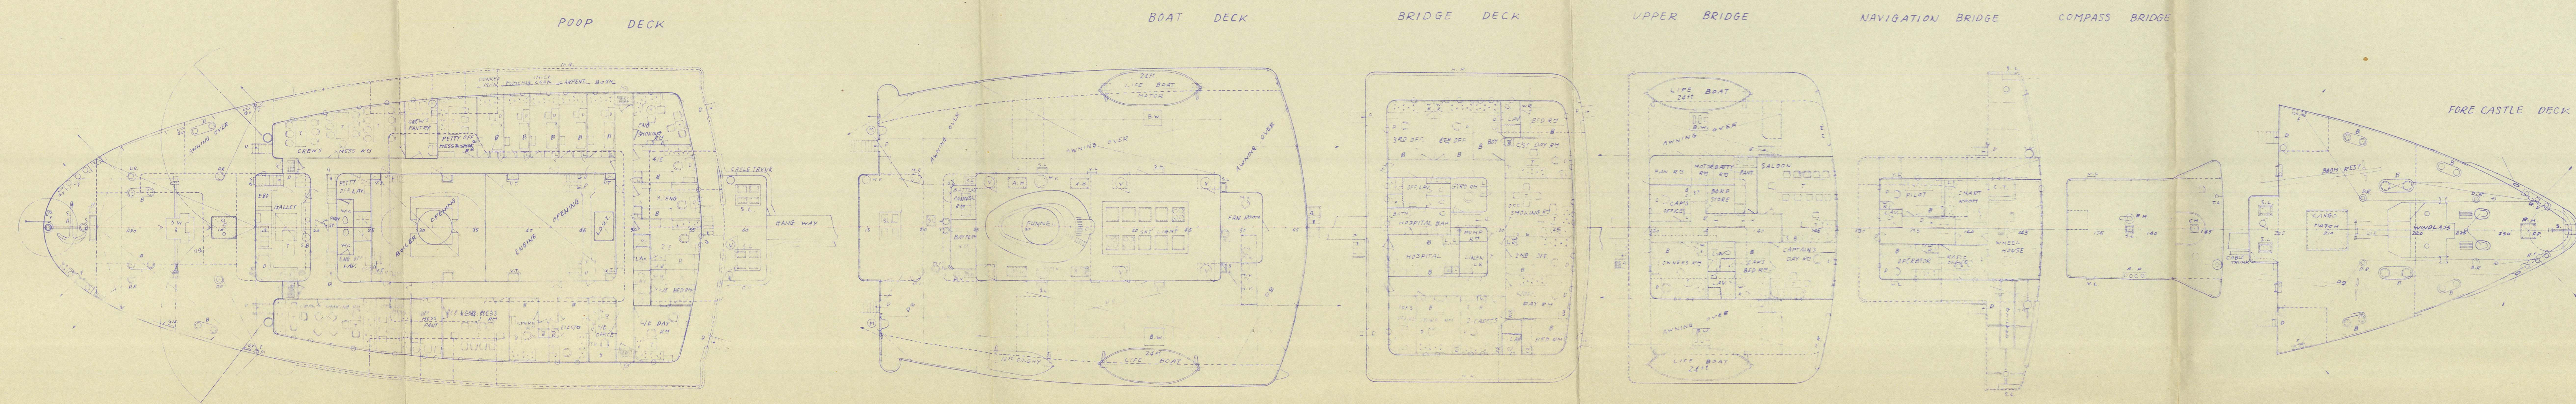


# 20000 DWT. OIL TANKER S.S. "LEONIDAS" GENERAL ARRANGEMENT. SCALE 1/200

## BIBLIOGRAPHY

DRAWN AT SHIMIZU SHIP-  
YARD N.S.T. CO. LTD.  
MAY, 7<sup>th</sup> 1953.

PRINCIPAL DIMENSIONS	
LENGTH BETWEEN PERPENDICULARS	550'-0"
BREADTH MAILED	74'-0"
DEPTH MAILED	60'-0"
SUPER. LEAD DRAFT EXTREME	31'-4"
DEAD WEIGHT CAPACITY IN SEA WATER	20,022.58 T
CARGO TONNAGE	13,555 T
MAIN ENGINE STEAM TURBINE	1 SET
MAX. CONTINUOUS OUTPUT	9500 SHP
MAIN BOILER WATER TUBE BOILER	2 SETS
SPEED TRIAL	16.23 KTS
SERVICE	15.5 KTS

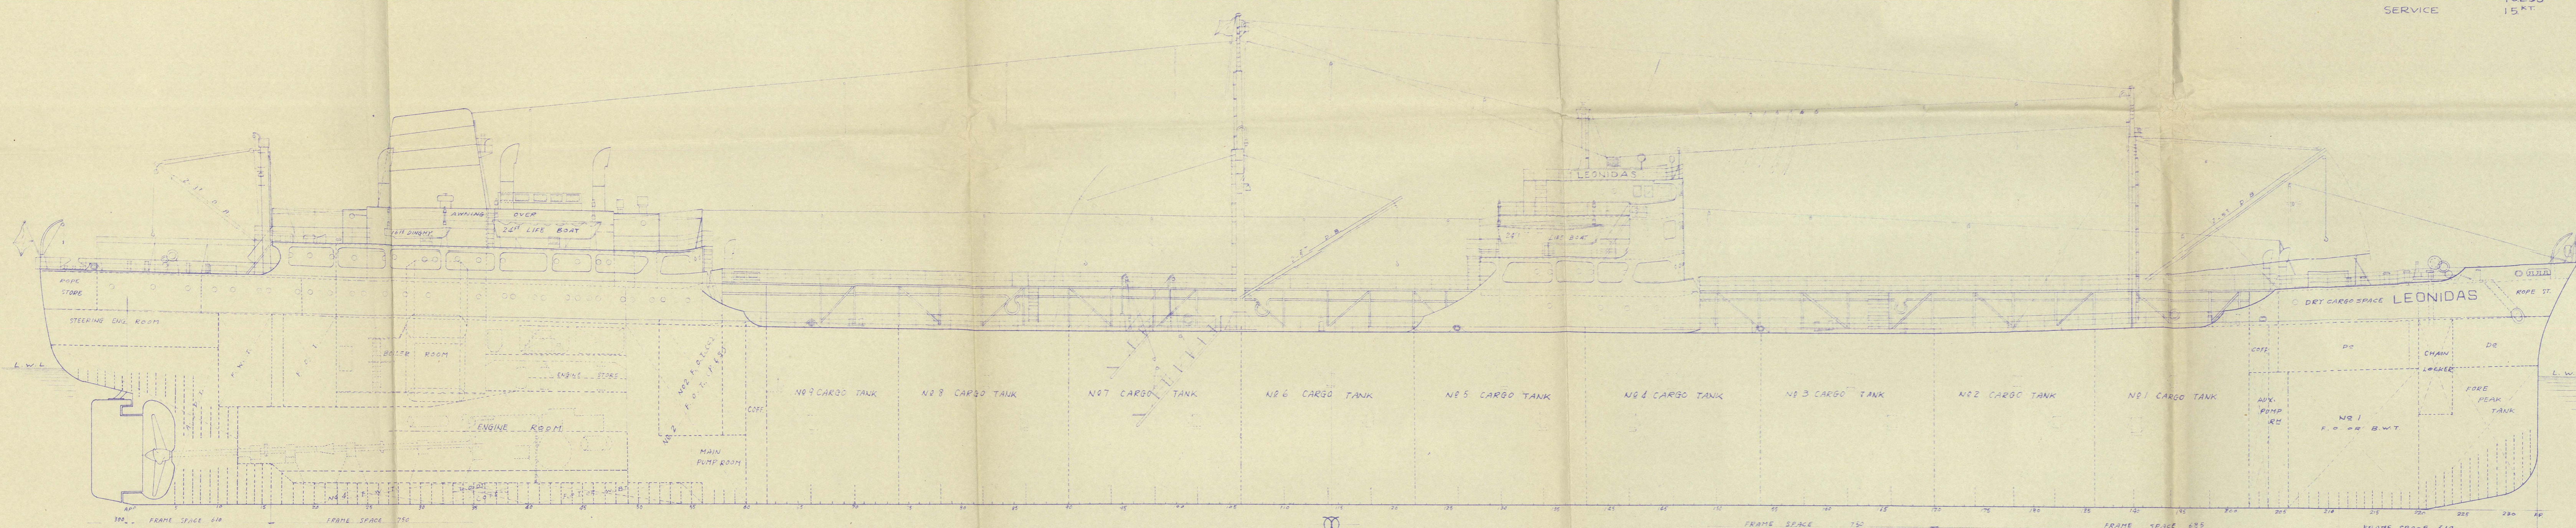

**LEONIDAS**  
20,000 DWT  
OIL TANKER

GENERAL ARRANGEMENT  
SCALE 1/200

**FINISHED PLAN**

NIPPON STEEL TUBE CO. LTD.  
SHIMIZU SHIP-YARD  
SHIMIZU JAPAN

HULL DEPT.  
DESIGNING SECTION

CHIEF DESIGNER: S. Shimizu

APPROVED: S. Shimizu

CHECKED: S. Shimizu

DATE DRAWN: MAY-7-1953

DATE REVIS: JF-1

0125-01162-1462

Lloyd's Register  
Foundation




"LEONIDAS" ★

General Arrog.

"As Built"

F.E. Yka Rpt. no. 1000

RECORDS DEPT.  
LONDON

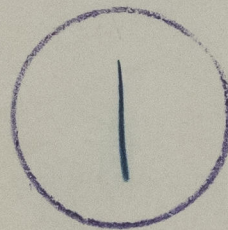

© 2021

Lloyd's Register  
Foundation

011595-011602-0162