


1. DESIGNED BY SHIMIZU SHIPYARD  
IN N.S.T. CO., LTD. SHIMIZU IN JAPAN  
(MAY 10TH 1953)

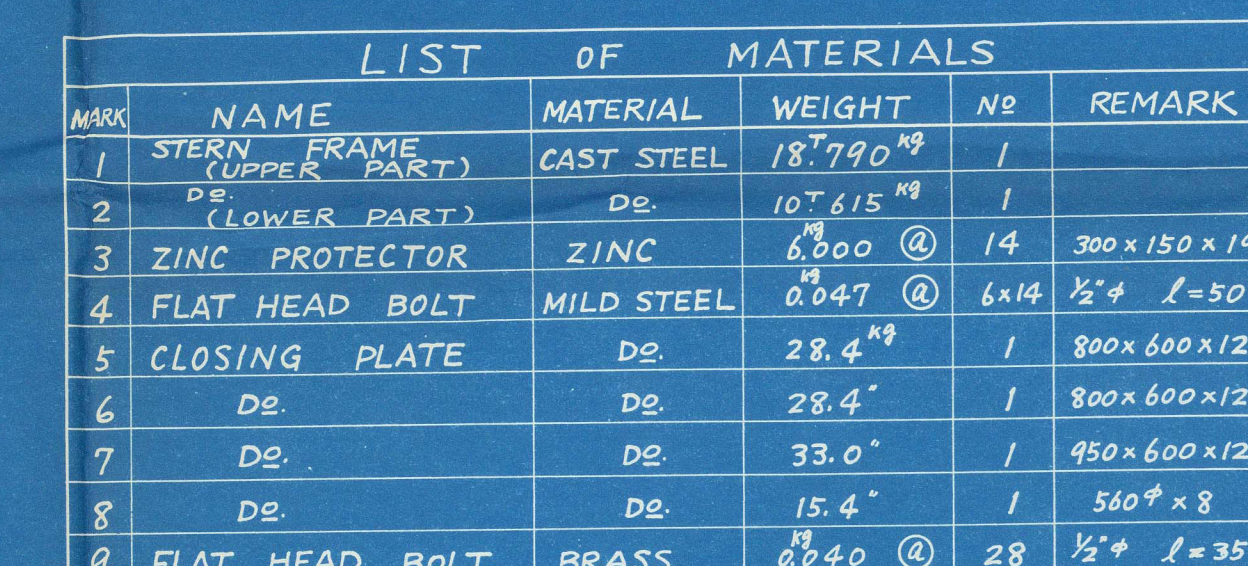

NOTES : —

<u>FINISHING</u>	<u>MARKS</u>
<u>▽▽</u> -----	FINE FINISH
<u>▽</u> -----	ORDINARY FINISH
<u>▽</u> -----	ROUGH FINISH
<u>○</u> -----	SMOOTH SURFACE

SCALE $\frac{1}{16}$ "	
FINISHED PLAN	
NIPPON STEEL TUBE CO. LTD.	
SHIMIZU SHIP YARD	
SHIMIZU, YAM.	
HULL	DEPT.
DESIGNING SECTION	
CHIEF WILL DEPT.	<i>21.16</i>
CHIEF DESIGNER	<i>S. S. Kurokabe</i>
APPROVED BY	
CHECKED BY	
DESIGNED BY	
DATE OF DRAWN	MAY 10TH 1953
DATE OF ISSUE	MAY 26 1953
DRAWING NO.	HF - 22




'LEONIDAS' ★

*Stemframe*


*"As Built"*

F.E. Yka Rpt. no. 1000

*Beautiful copy of  
Approved plan.*

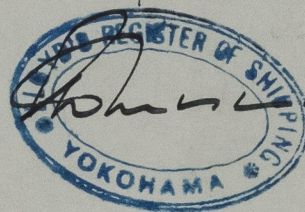

RECORDS DEPT.  
LONDON

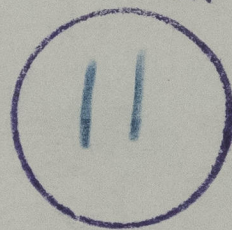

© 2021

Lloyd's Register  
Foundation

011595-011602-0167