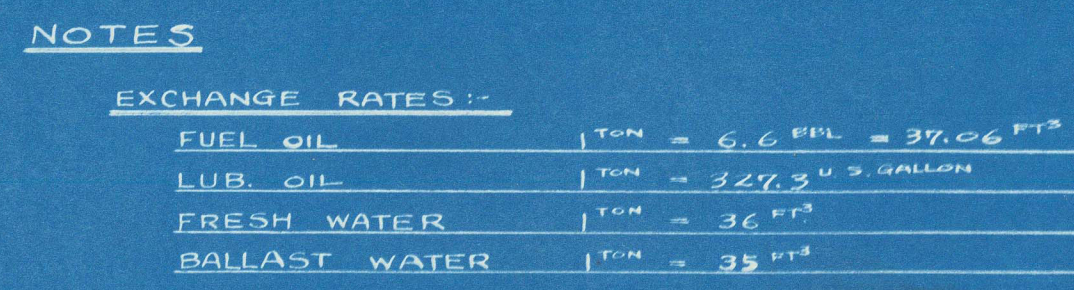
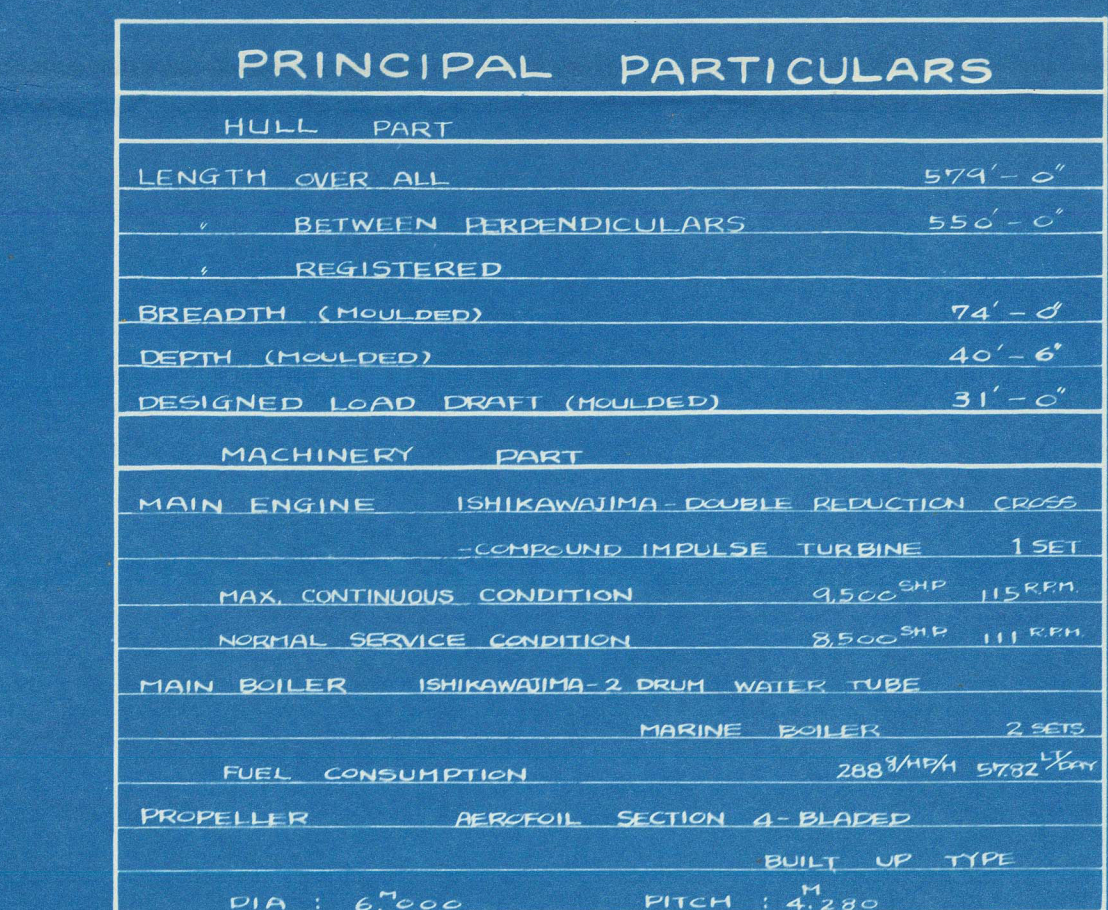
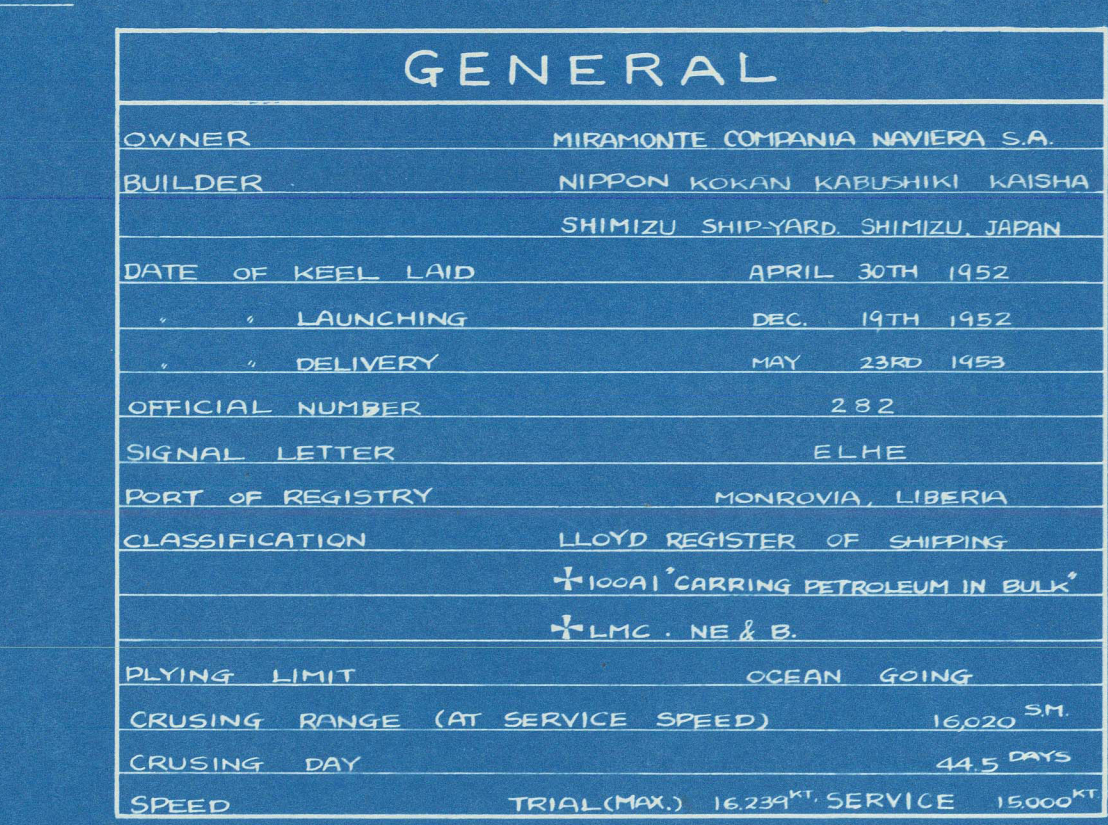
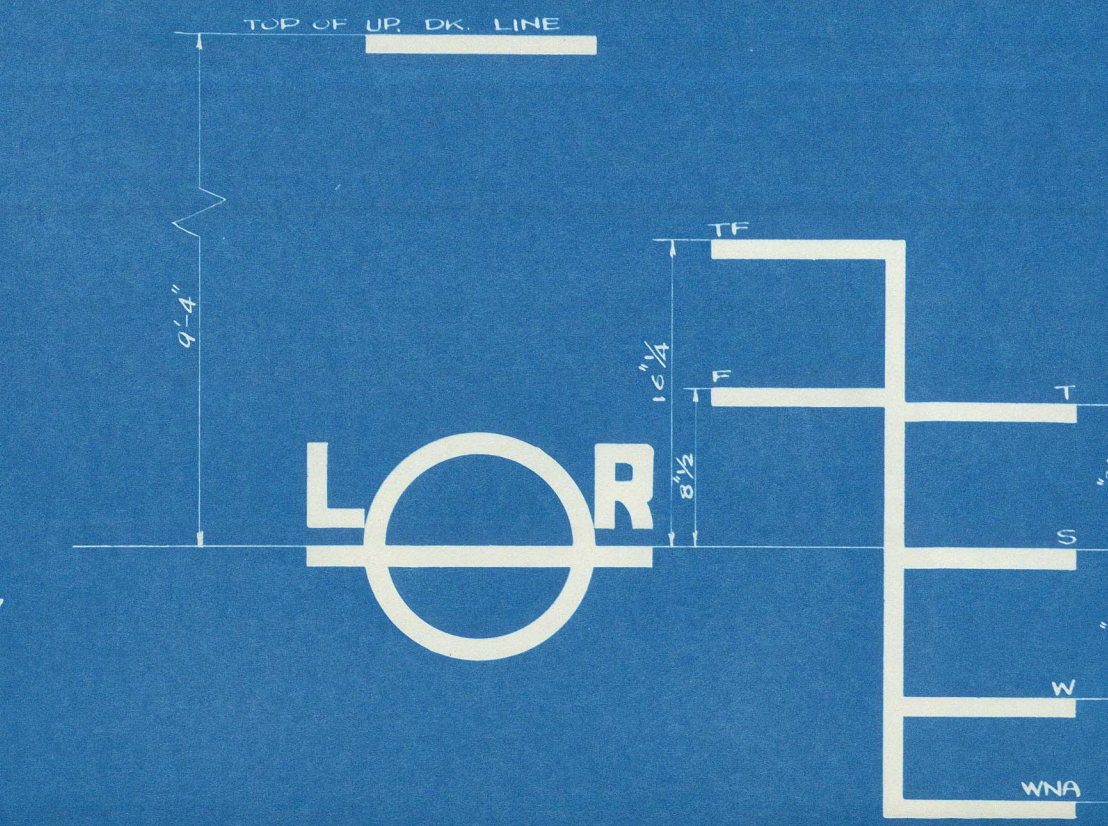


SCALE 1/200

[illegible]

STORE		CAPACITY	
ITEM	DECK	VOLUME	EST.
BOARD - STORE	1000-1000	1000-1000	7.28
STIRLER		148-1000	6.25
LINEN - LOCKER	1000-1000	1000-1000	8.81
ROPE - STORE	1000-1000	1000-1000	8.81
ROPE - STORE	1000-1000	200-1000	138.56
LAMP - STORE	100	100-1000	19.46
ROPE - STORE	100	100-1000	19.46
SHOWER - STORE	100	100-1000	25.27
STOVE - STORE	100	100-1000	25.27
STOVE - STORE	100	100-1000	4.81
	100	100-1000	14.16
VENTILATOR - SHOP	100	100-1000	18.22
VENTILATOR - STORE	100	100-1000	22.85
ONLY - LINEN - LOCKER	100	100-1000	42.50
STOVE - STORE	100	100-1000	17.76
HEAT - HEATING - STORE	100	100-1000	44.20
STOVE - STORE	100	100-1000	11.50
	100	100-1000	34.60
ROPE - STORE	100	100-1000	50.11
STOVE - STORE	100	100-1000	20.47
STOVE - STORE	100	100-1000	18.41
STOVE - STORE	100	100-1000	21.47
STOVE - STORE	100	100-1000	16.15
TOTAL			624.34
PROVISION - STORE	1000-1000	1000-1000	4.81
PROTECTOR - STORE	1000-1000	1000-1000	9.01
ROPE - STORE	1000-1000	1000-1000	11.73
TOTAL			85.65
DAILY - ROPE	1000-1000	5-100	8.84
DAILY - ROPE	1000-1000	5-100	4.68
DAILY - ROPE	1000-1000	5-100	7.44
VEGETABLE - STORE	1000-1000	5-100	1.56
TOTAL			46.52
PROVISION - STORE	1000-1000	1000-1000	8.84
TOTAL			78.36

TONNAGE			
ITEM	LIBERIA	PANAMA CANAL	SUEZ CANAL
GROSS TONNAGE	13559	13930.54	13939.36
NET TONNAGE	9757	9750.62	10663.05

DEAD WEIGHT		
ITEM	DRAFT	DEAD WEIGHT
SUMMER	31'-4"	26,622.58
TROPICAL	31'-11 3/4"	21,233.67
WINTER	30'-8 1/2"	13,489.15
FRESH	32'-0 1/2"	21,320.15
TROPICAL FRESH	32'-0 3/8"	21,458.36
WINTER NORTH ATLANTIC	30'-2 3/8"	19,541.12

DEAD WEIGHT SCALE					
FREE BOARD	DEAD WEIGHT	DRAFT	DISPLACEMENT	MOMENT TO CHANGE TRIM 1 INCH	TON PER INCH
FEET	LONG TON	FEET	LONG TON	FEET-LONG	LONG
7	12000				2000
8	12000	33	21000		
9	12000	32	20800	2400	
10	12000	31	20700		
11	12000	30	20500	2800	
12	12000	29	20300	2700	
13	12000	28	20000		
14	12000	27	19800	2600	
15	12000	26	19500	2500	
16	12000	25	19300		
17	12000	24	19000	2400	
18	12000	23	18800		
19	12000	22	18500	2300	
20	12000	21	18300		
21	12000	20	18000	2200	
22	12000	19	17800		
23	12000	18	17500	2100	
24	12000	17	17300		
25	12000	16	17000	2000	
26	12000	15	16800		
27	12000	14	16500	1900	
28	12000	13	16300		
29	12000	12	16000	1800	
30	12000	11	15800		
31	12000	10	15500	1700	
32	12000	9	15300		
		8		1600	

LEONIDAS

M. K.
kimokobe
Akimoto
T. Koizumi
MAY 22 1953

"LEONIDAS" ★

Capacity plan

"As Built"

F.E. Yka Rpt. No. 1000

RECORDS DEPT:
LONDON

32



© 2021

Lloyd's Register
Foundation

011595-011602-0169