


BOAT'S PLATING 5/16"
BEAMS ON EVERY 2ND FRAME 130x75x8

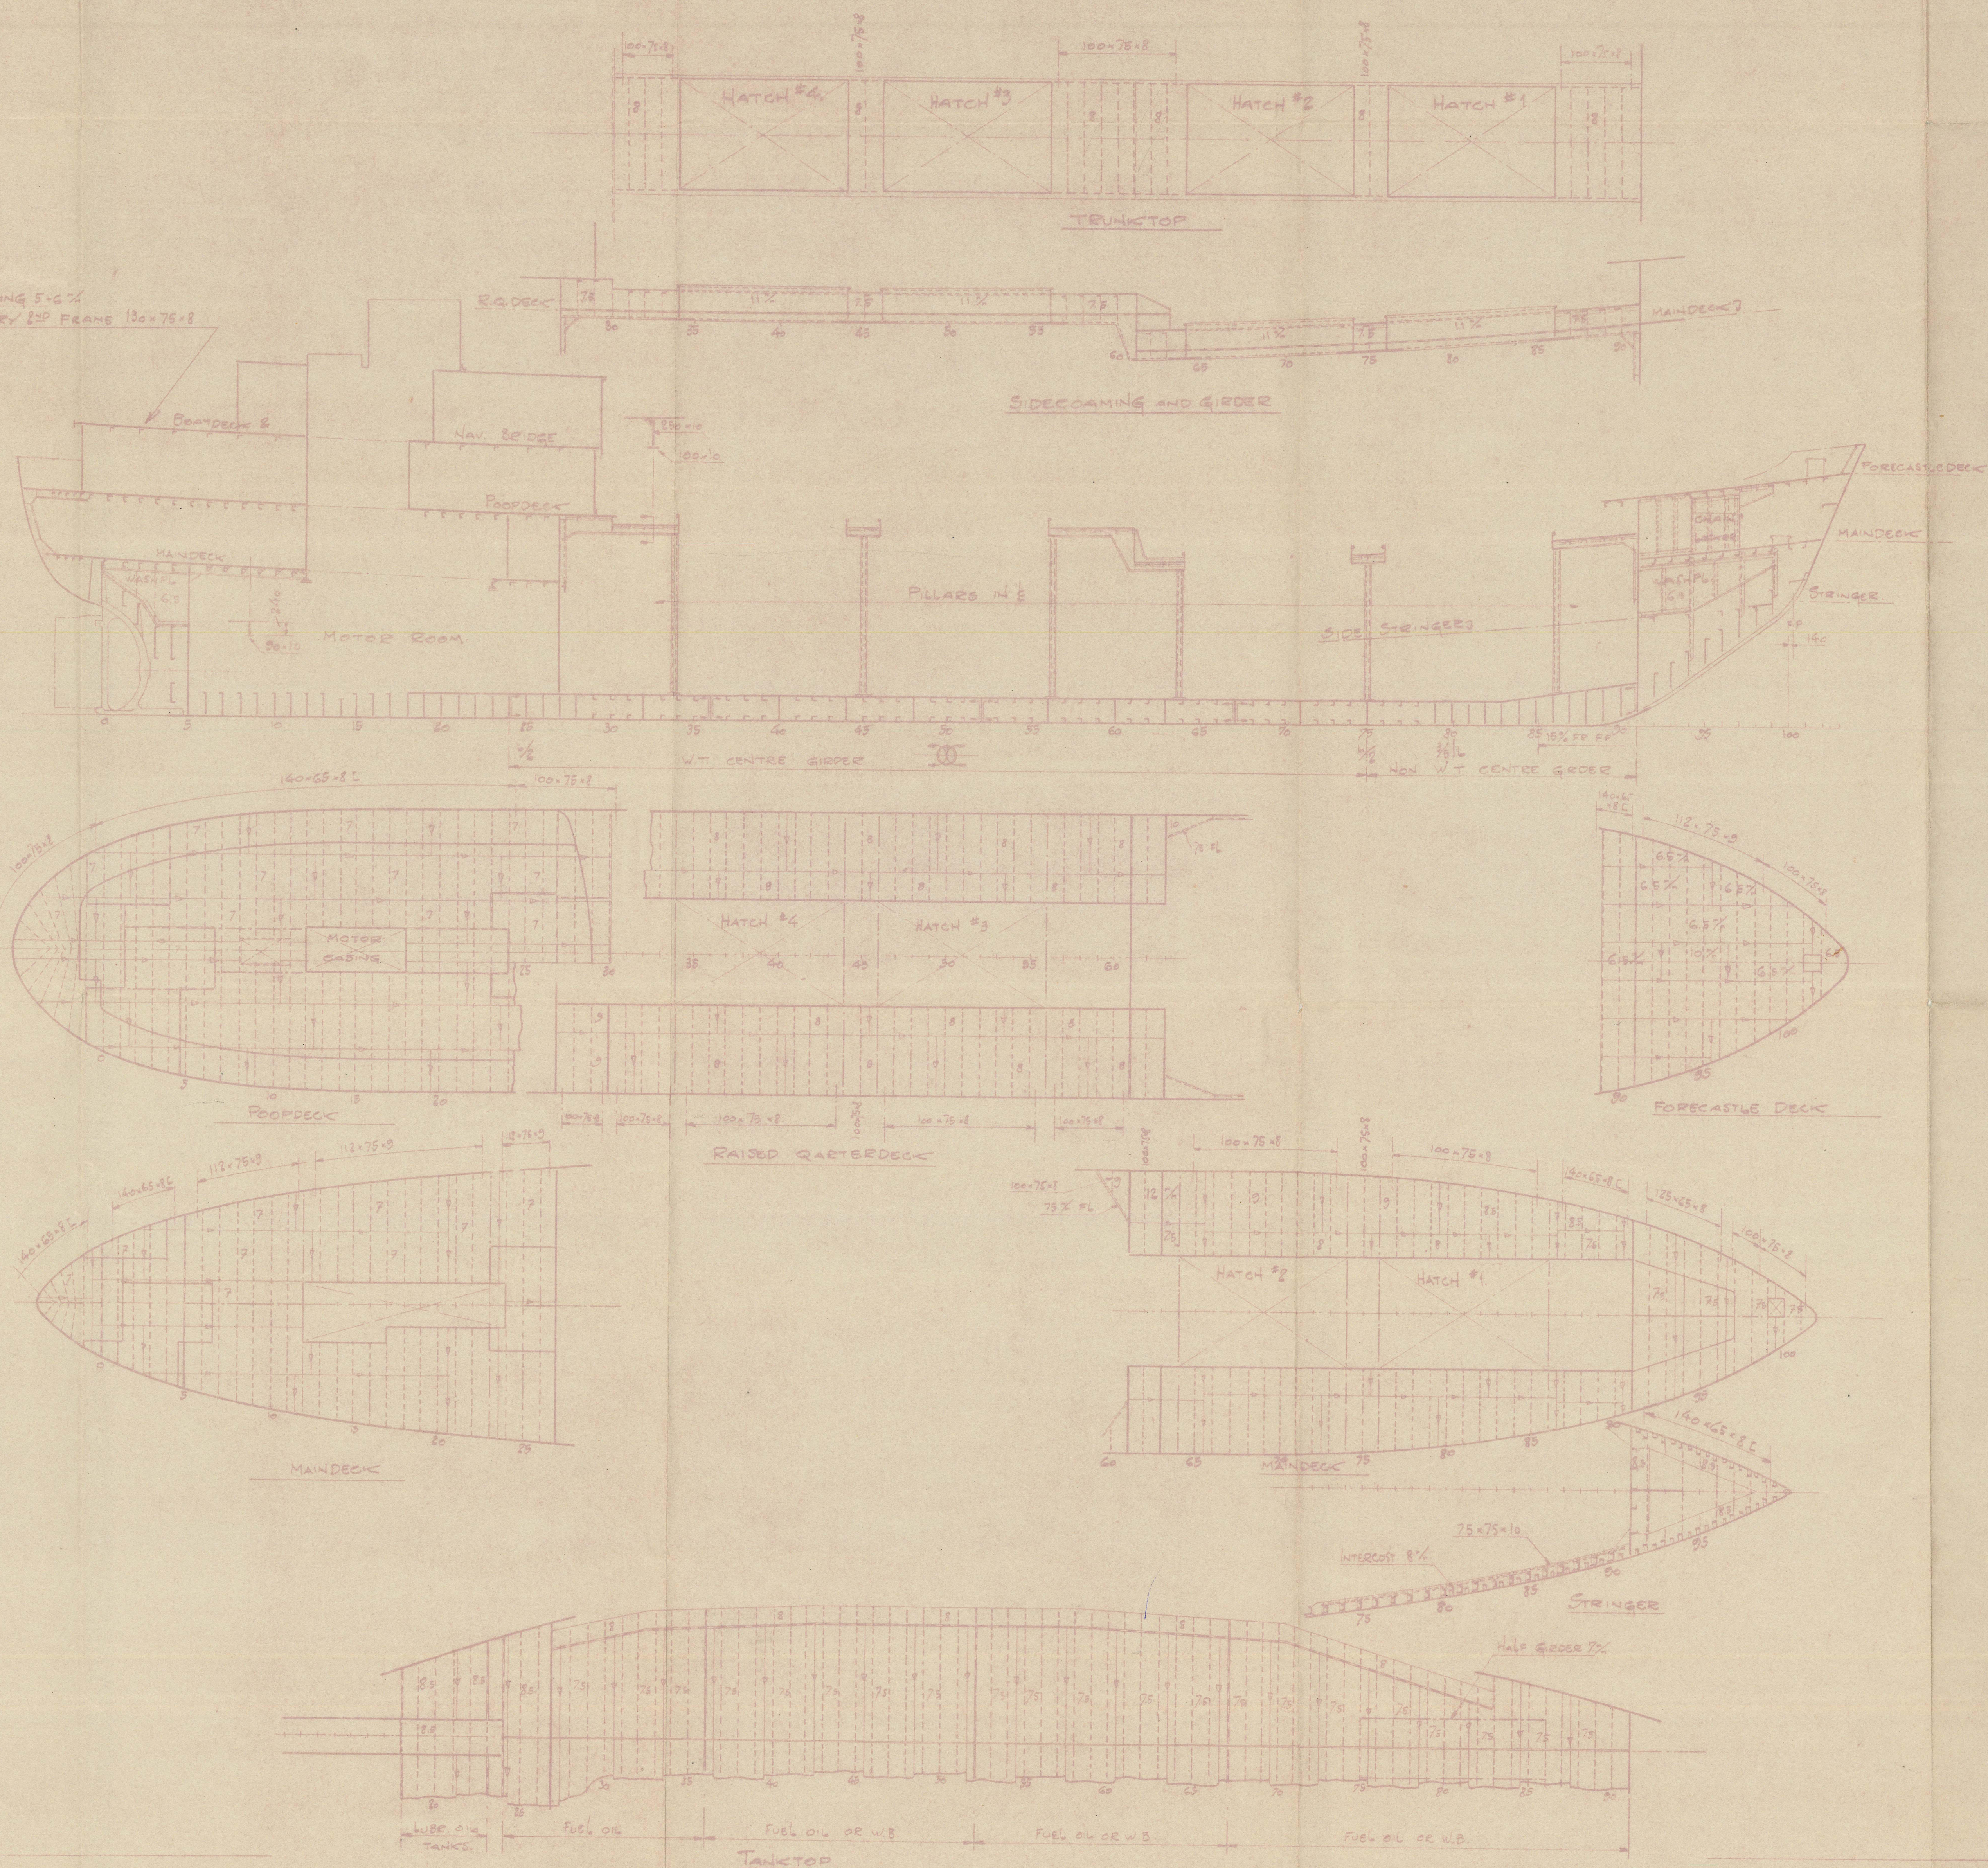

DIMENSIONS.

LENGTH BETW. P.P.	184'-2 1/2"	56.14m
BREADTH MOULDED	31'-6"	9.6m
DEPTH TO MAINDECK	14'-6"	4.42m
--- R.O. DECK	18'-6"	5.64m

CLASS:

LLOYDS REGISTER + 100 A1
STRENGTHENED FOR NAVIGATION IN ICE
ELECTRICALLY WELDED.

As built plan.

Stockholm Report No. 6612

1/3 "Patrijaskull"

4

CORRECTED AS APPROVED BY LLOYDS REG.
18.2.47. AAR

LIDINGÖ NYA VARV & VERKST.

M/S 5

LONGITUDINAL SECTION
AND PLANS.

Scale: 1/100 Datum: 28-7-47 R.T.N. No

5/53