

# No 1156. "CITY OF CARLISLE." MIDSHIP SECTION. [AS FITTED.] SCALE: - 1/2" = ONE FOOT.

DIMENSIONS: 465'-0" B.P. x 64'-0" MLD. x 42'-8" MLD. TO UPPER DK.  
x 32'-1 1/2" MLD. TO 2<sup>ND</sup> DECK.  
TO CLASS 100A, WITH FREEBOARD SCANTLINGS SUITABLE FOR A  
MOULDED DRAFT WITH T.O. CLOSED OF 29'-7 1/4".


## SECTION THRO' HOLDS

### EQUIPMENT. [No 49610.]



2 BOWER ANCHORS 85/CWTS EACH STOCKLESS.	
1 STRAIGHT " 75 CWTS WITH STOCK	
210 FATHOMS OF 2 1/2" STUD CHAIN CABLE	
1 AT 120 " 4 1/4" STEEL WIRE STEERING LINE	
1 AT 130 " 5 1/2" " " " " " "	
1 AT 140 " 5 1/2" " " " " " "	
2 AT 30 " 3 1/2" " " " " " "	
2 AT 100 " 2 3/4" " " " " " "	
2 AT 100 " 2 3/4" " " " " " "	
4 AT 75 " 2 3/4" " " " " " "	
4 AT 40 " 7" SISAL	

NOTE: ALL B.A. SECTIONS ARE NEW BRITISH STANDARD  
REVISED JULY 1942.

## SECTION THRO' BOILER ROOM.

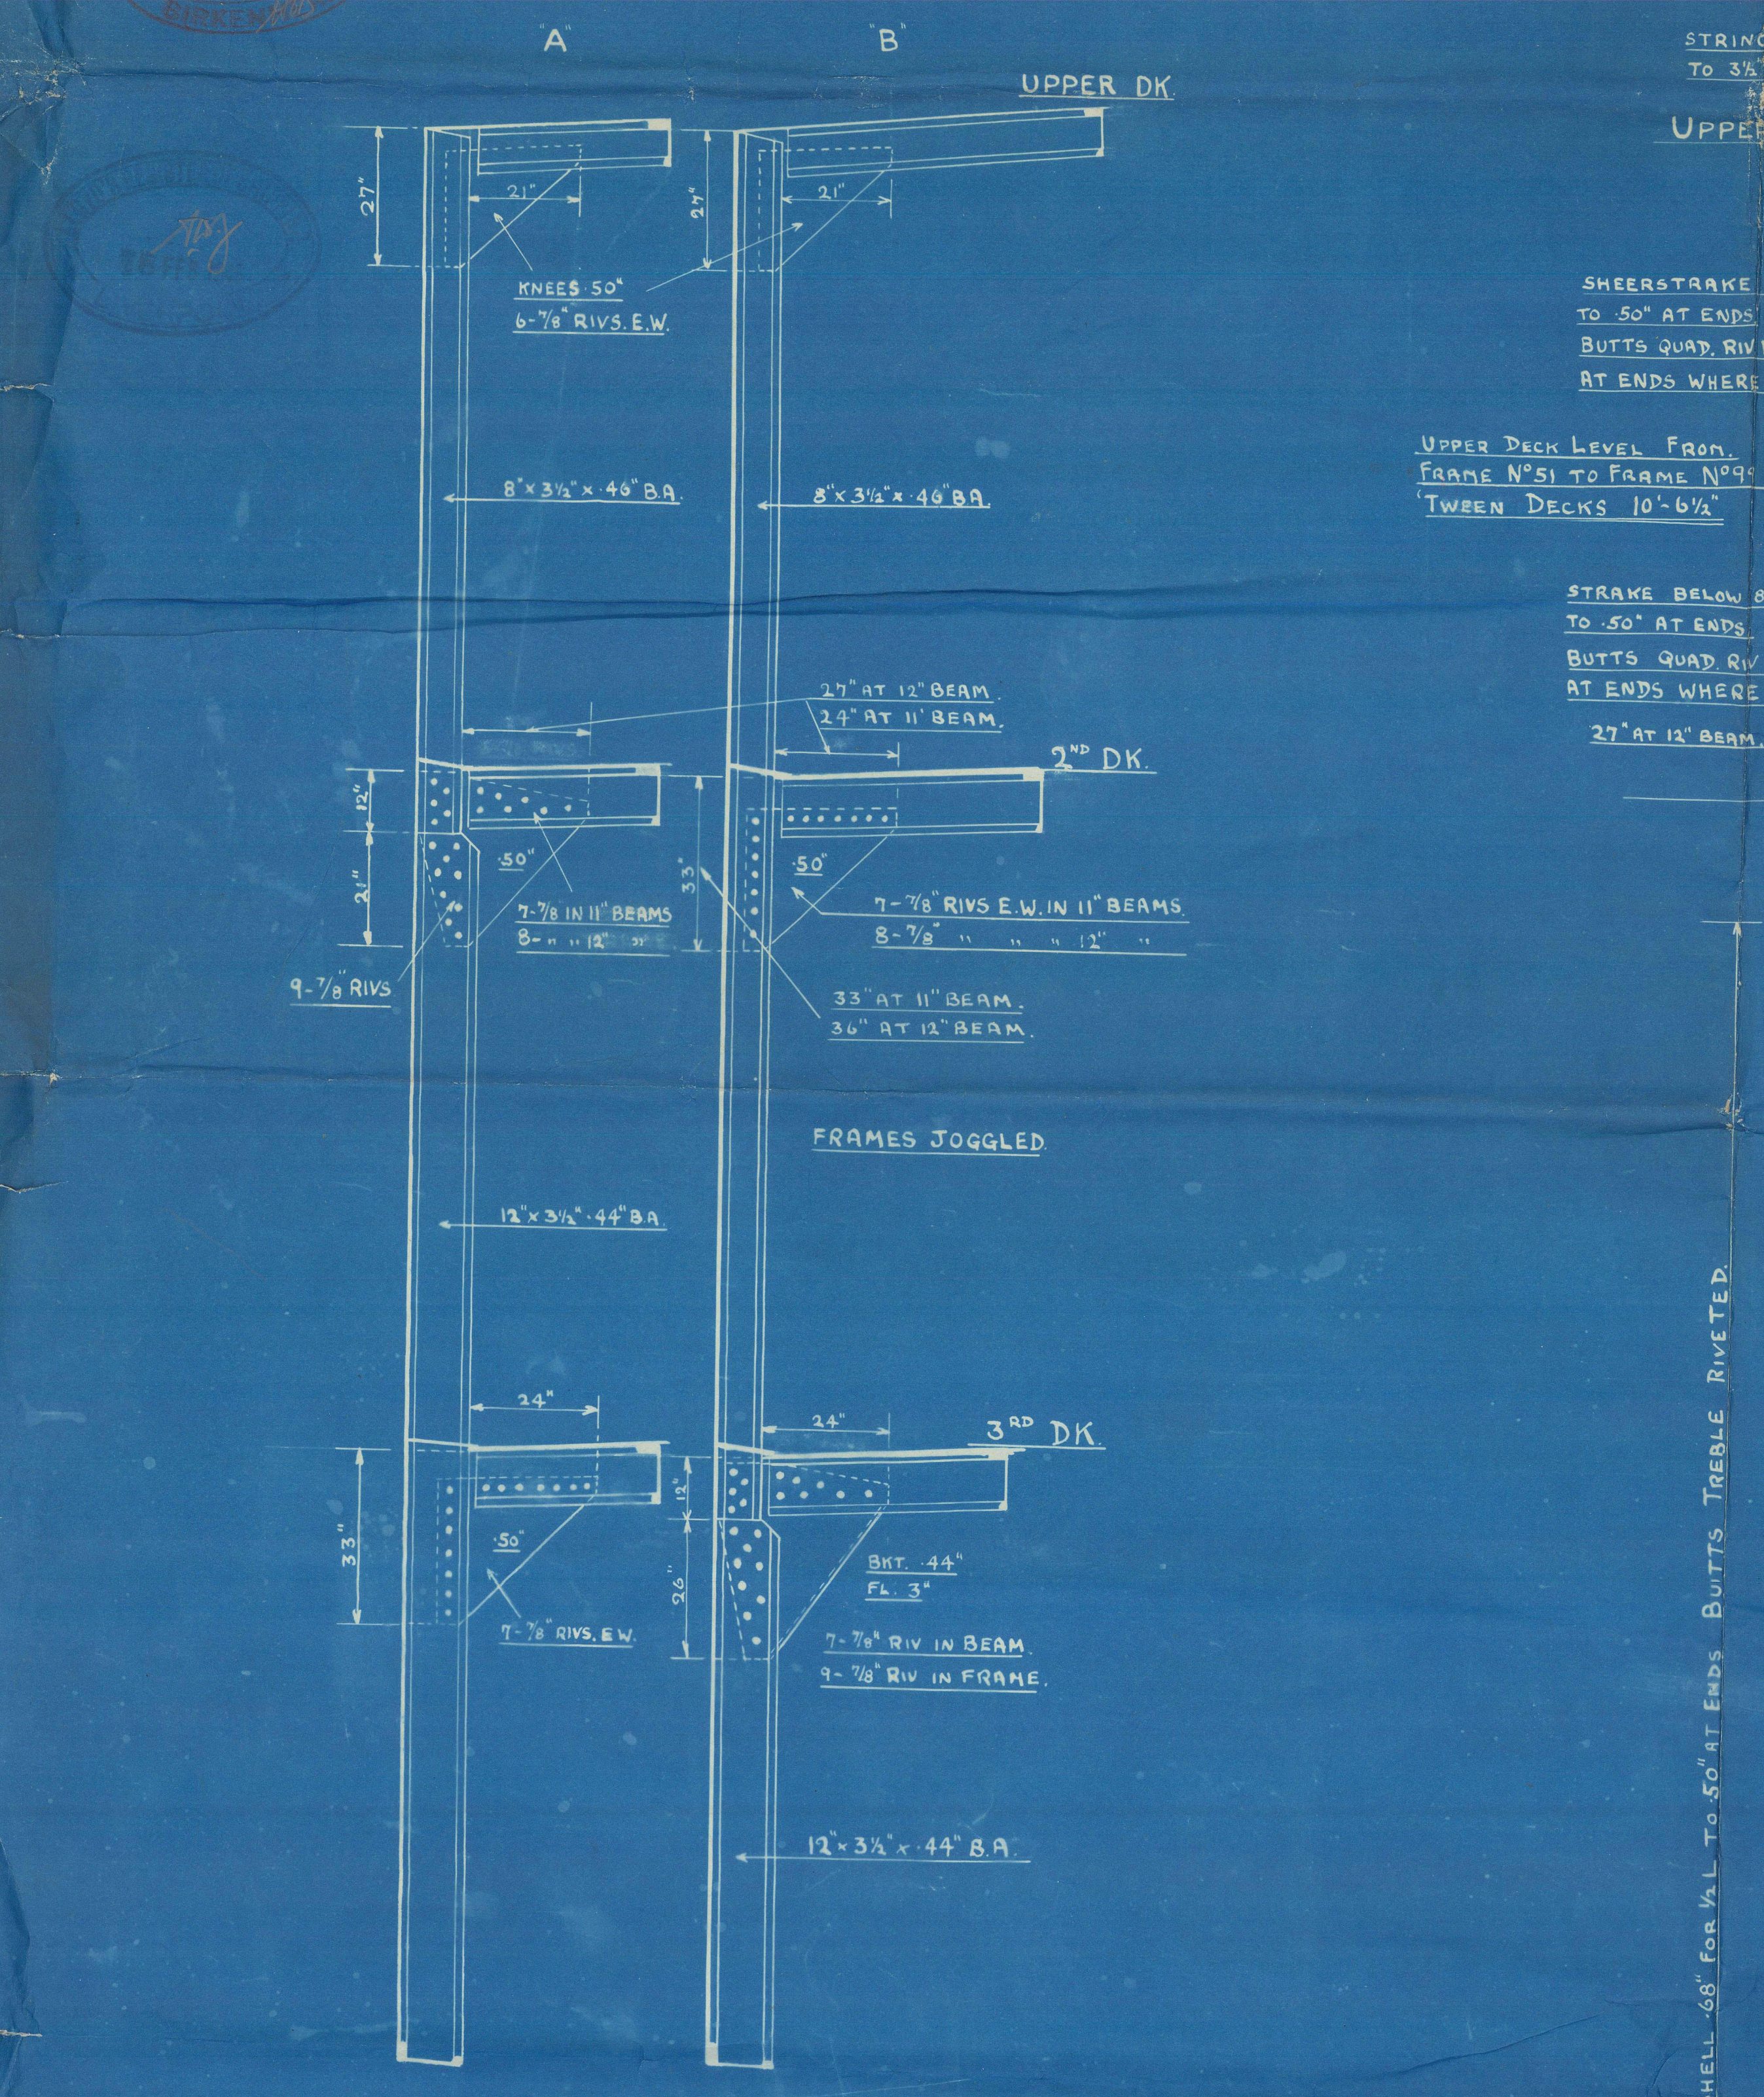

ALTERNATIVE SIDE FRAMING.  
FRAMES 'A' & 'B' FITTED  
AT ALTERNATE FRAMES.

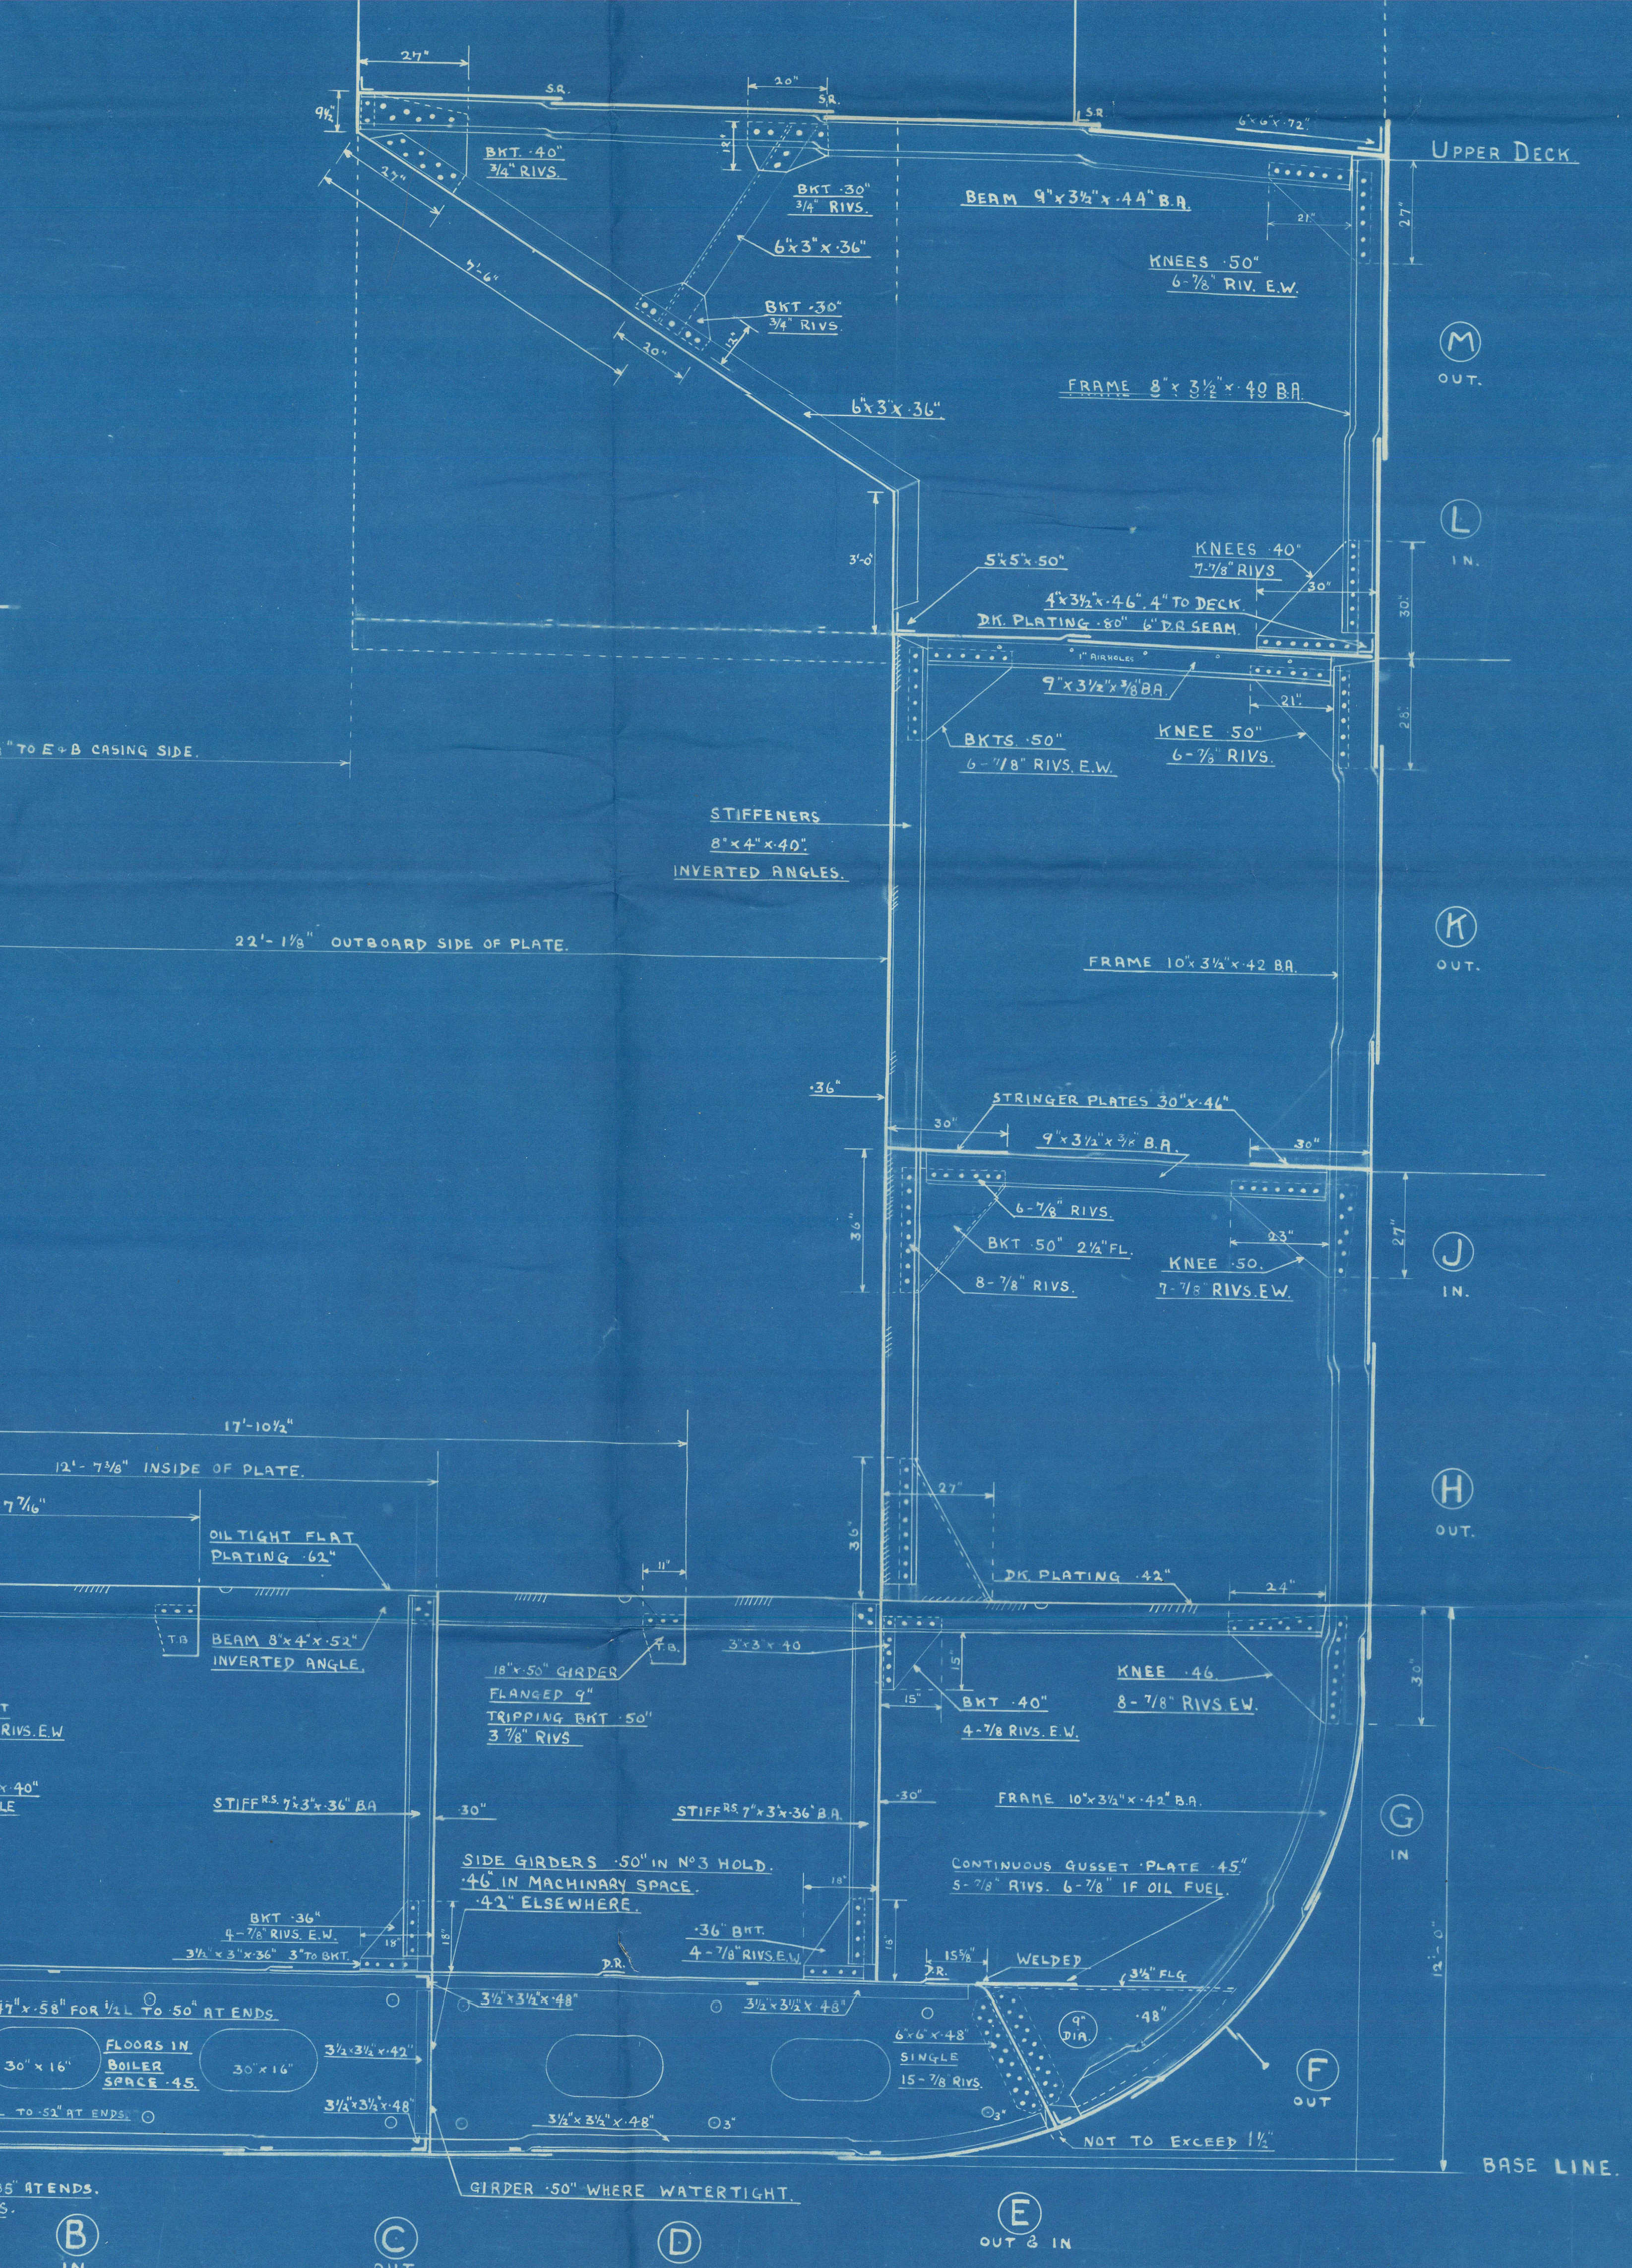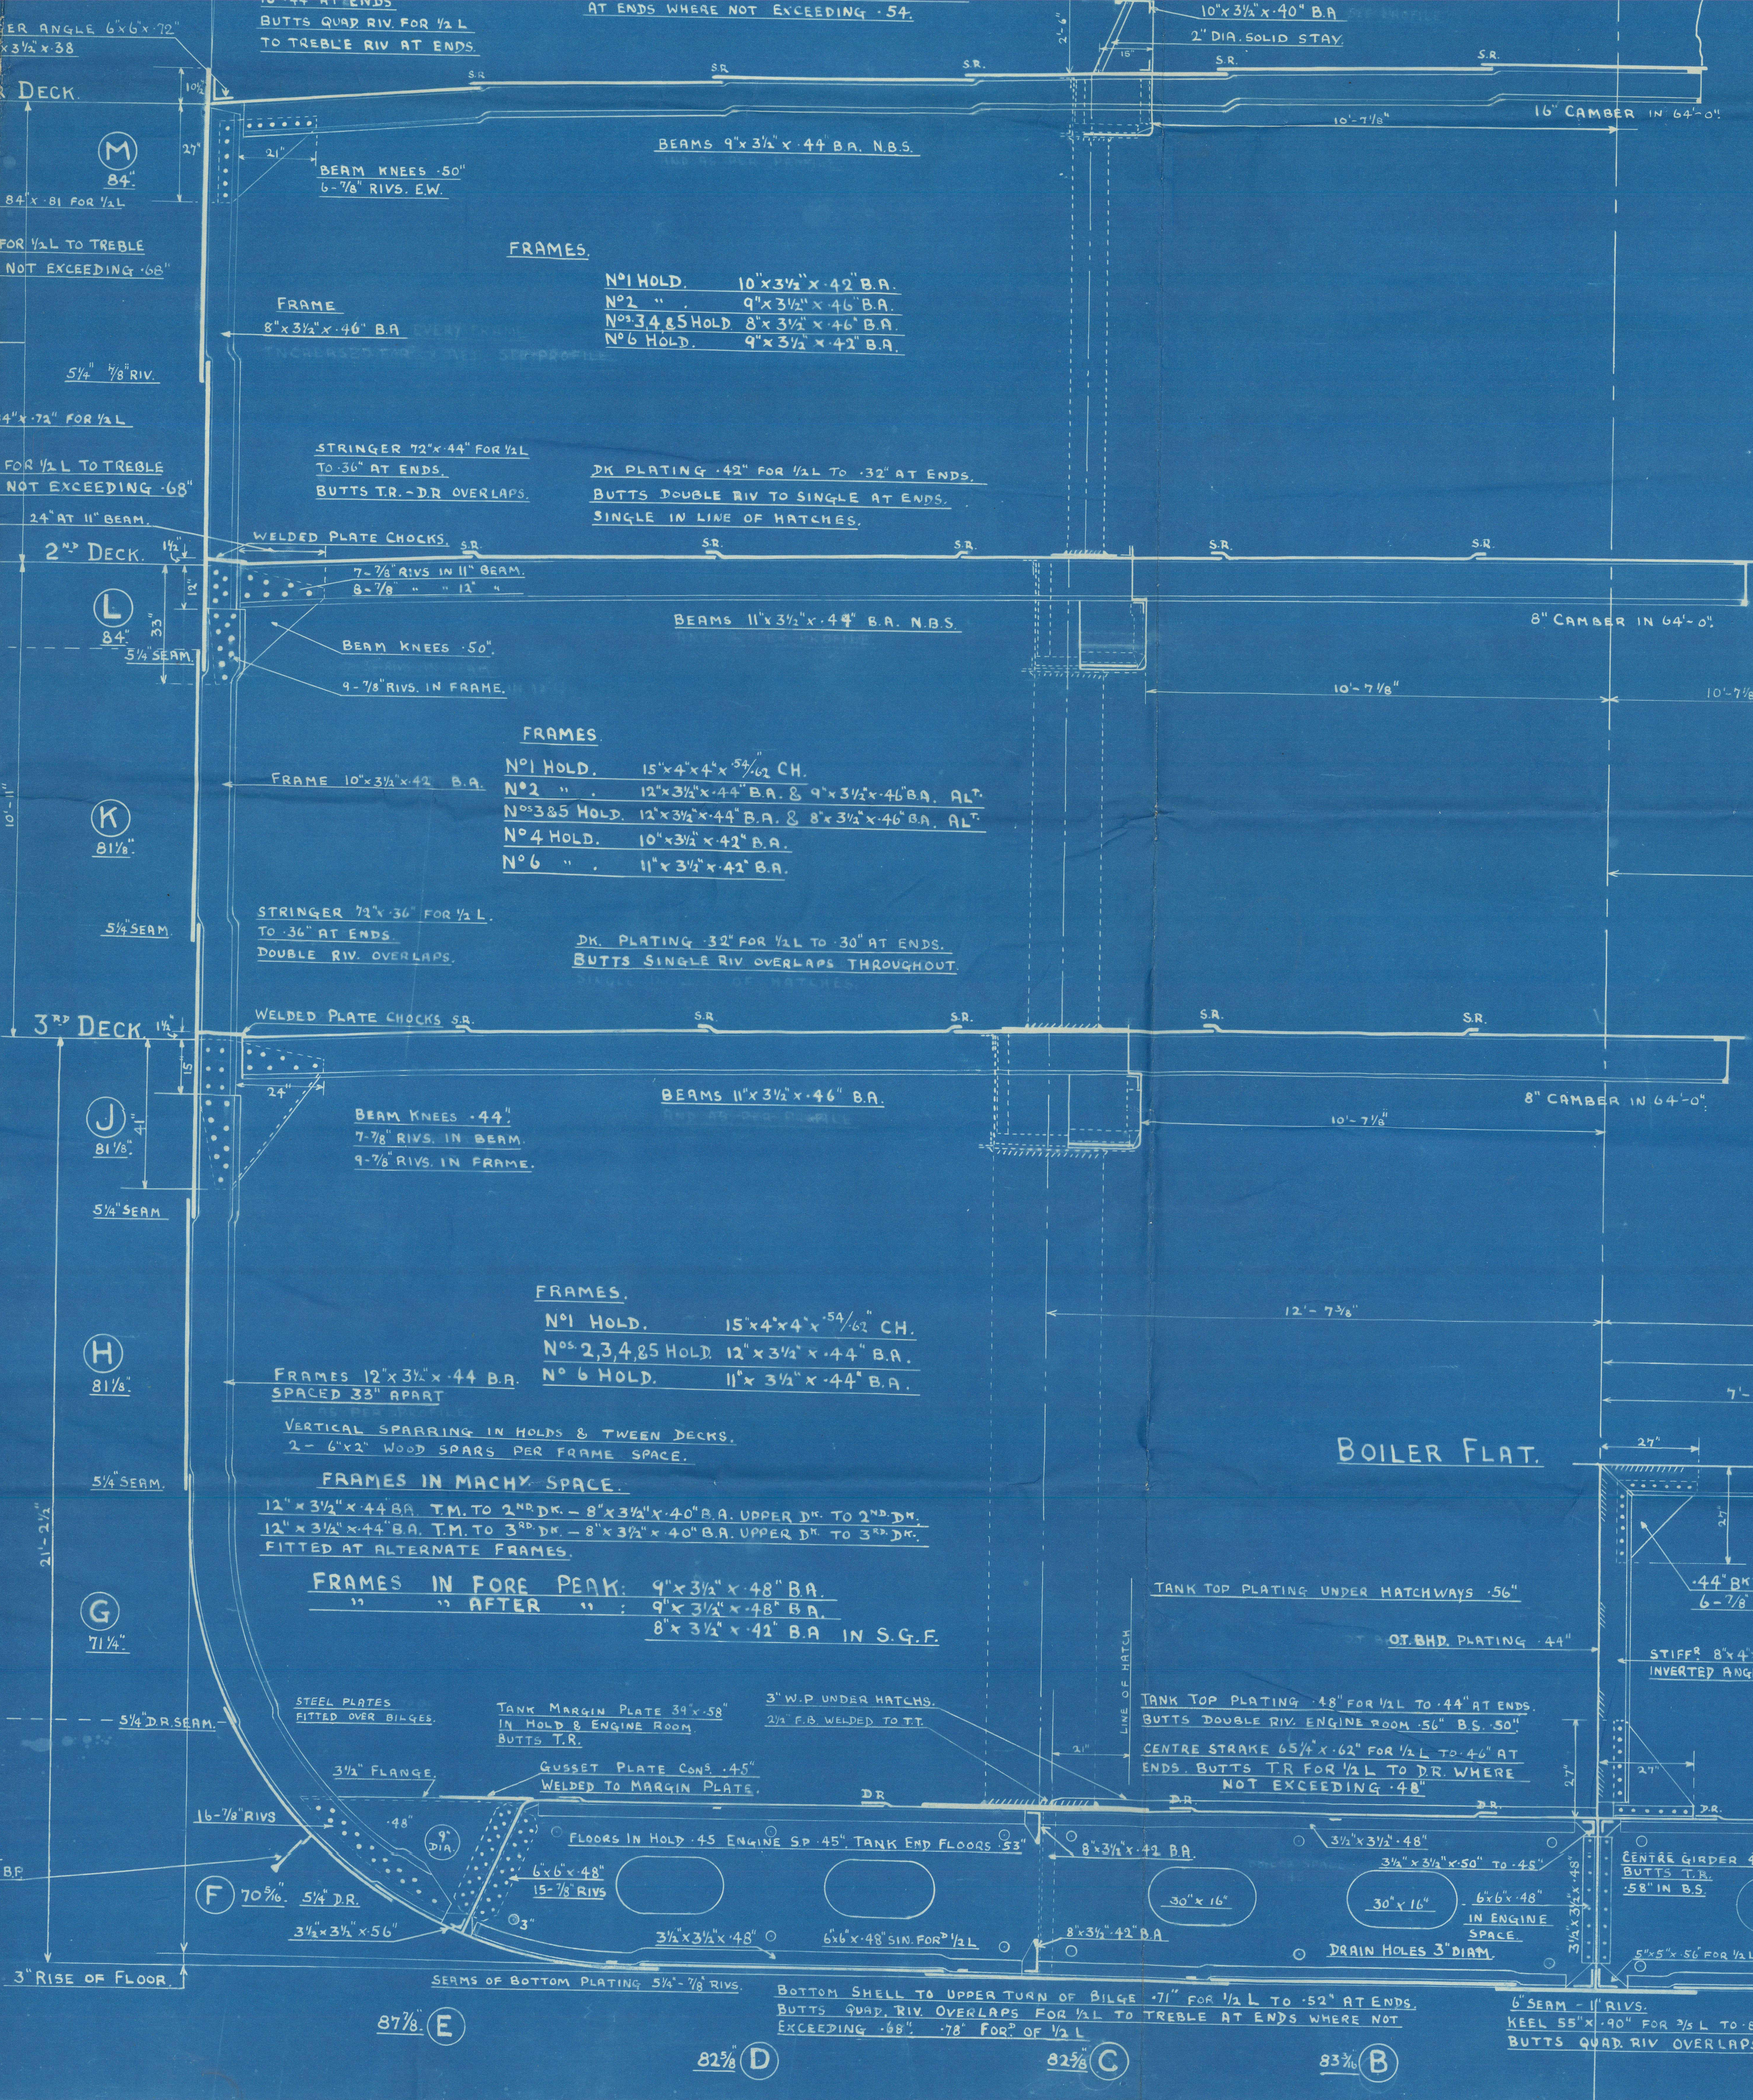



"City of Carlisle"

MIDSHIP SECTION

(As built)

①



© 2021

011800 011804 0216

Lloyd's Register  
Foundation