



HATCHWAY BEAMS

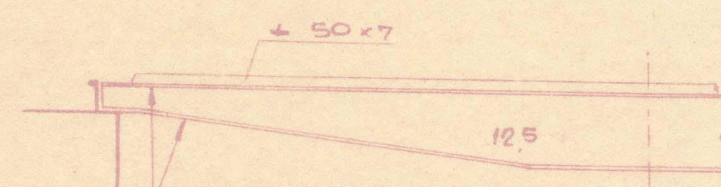


DECK	HATCH N°	HATCHWAY BEAMS N°	THICKNESS OF WOOD COVERS
SECOND DECK	1	5	66
"	2	5	72
"	3	7	69
"	4	7	66
"	5	6	72
UPPER DECK	1	5	66
THIRD DECK	3	7	66

DECK	HATCH N°	HATCHWAY BEAMS N°	THICKNESS OF WOOD COVERS
UPPER DECK	1	5	66
SECOND DECK	1	5	72
"	2	5	69
"	3	7	66
"	4	7	69
"	5	6	72
UPPER DECK	1	5	66
THIRD DECK	3	7	66



SECT. A-A

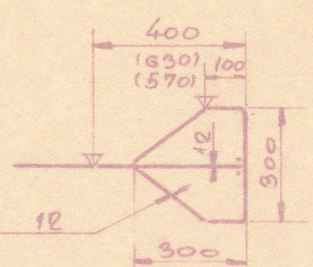

SECT. B-B

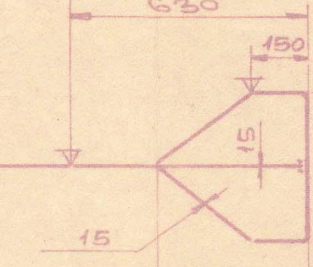


SECT. C-C

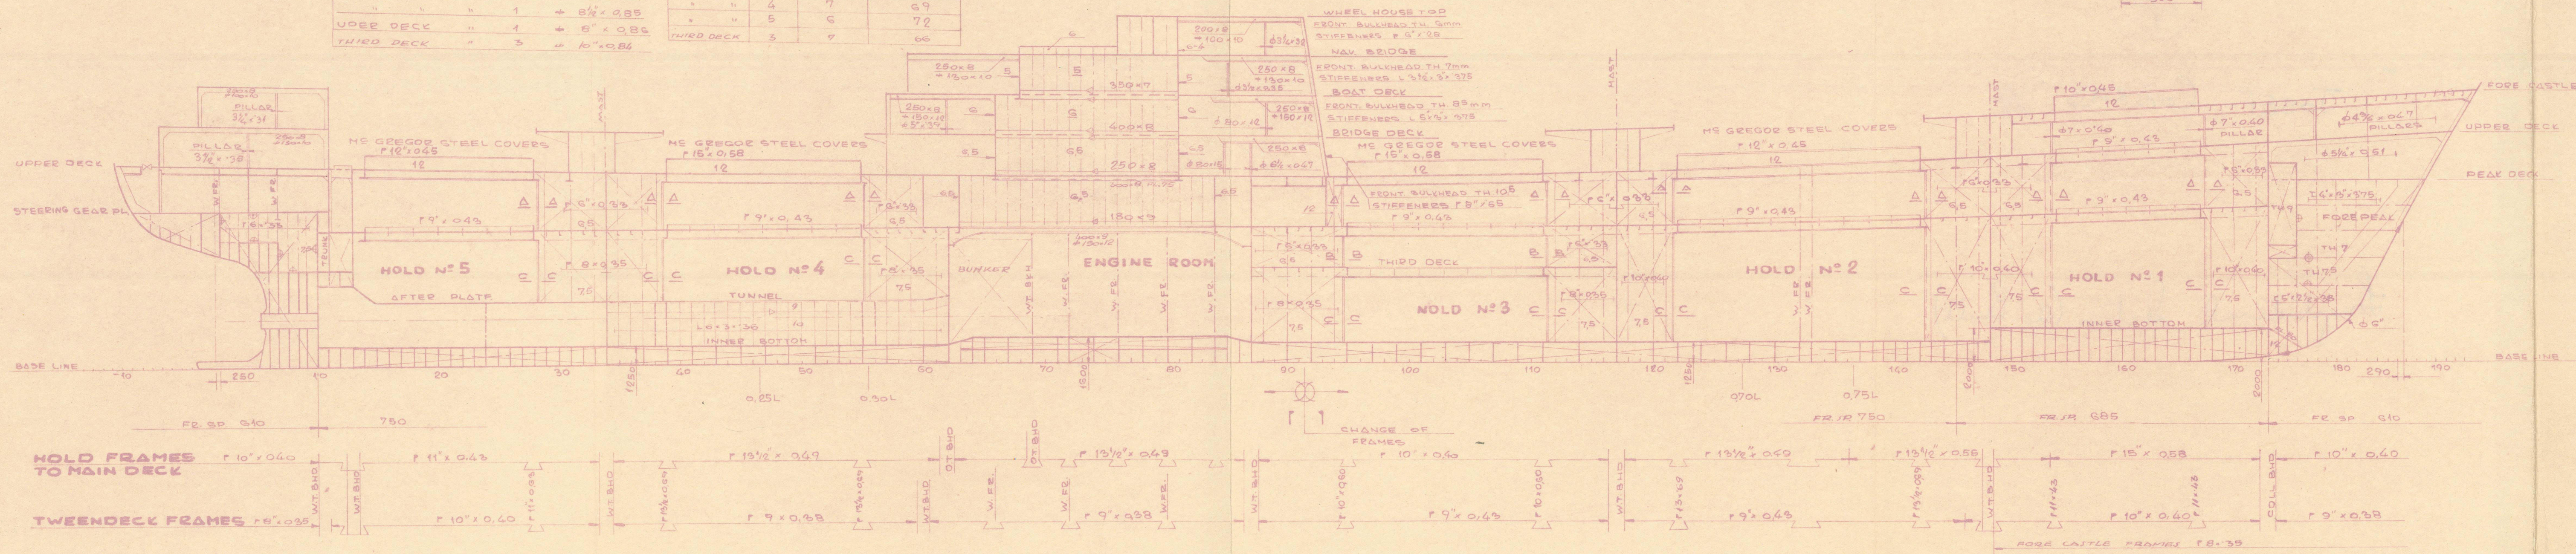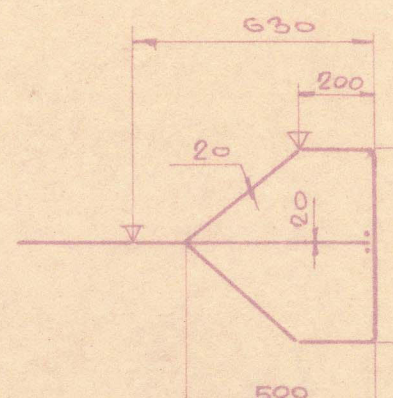

LONGITUDINAL SECTION
 AS BUILT
 03142
 © 2021
 1:200
 Lloyd's Register Foundation

823-011825-0002
 10149
 480

RECORDS DEPT.
LONDON.

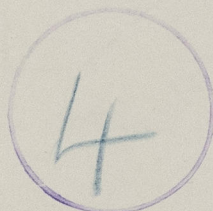

JOSEF CONRAD ★

Longitudinal Section (as Built)



© 2021

Lloyd's Register
Foundation

011823-011825-0002