




TYPICAL WEB

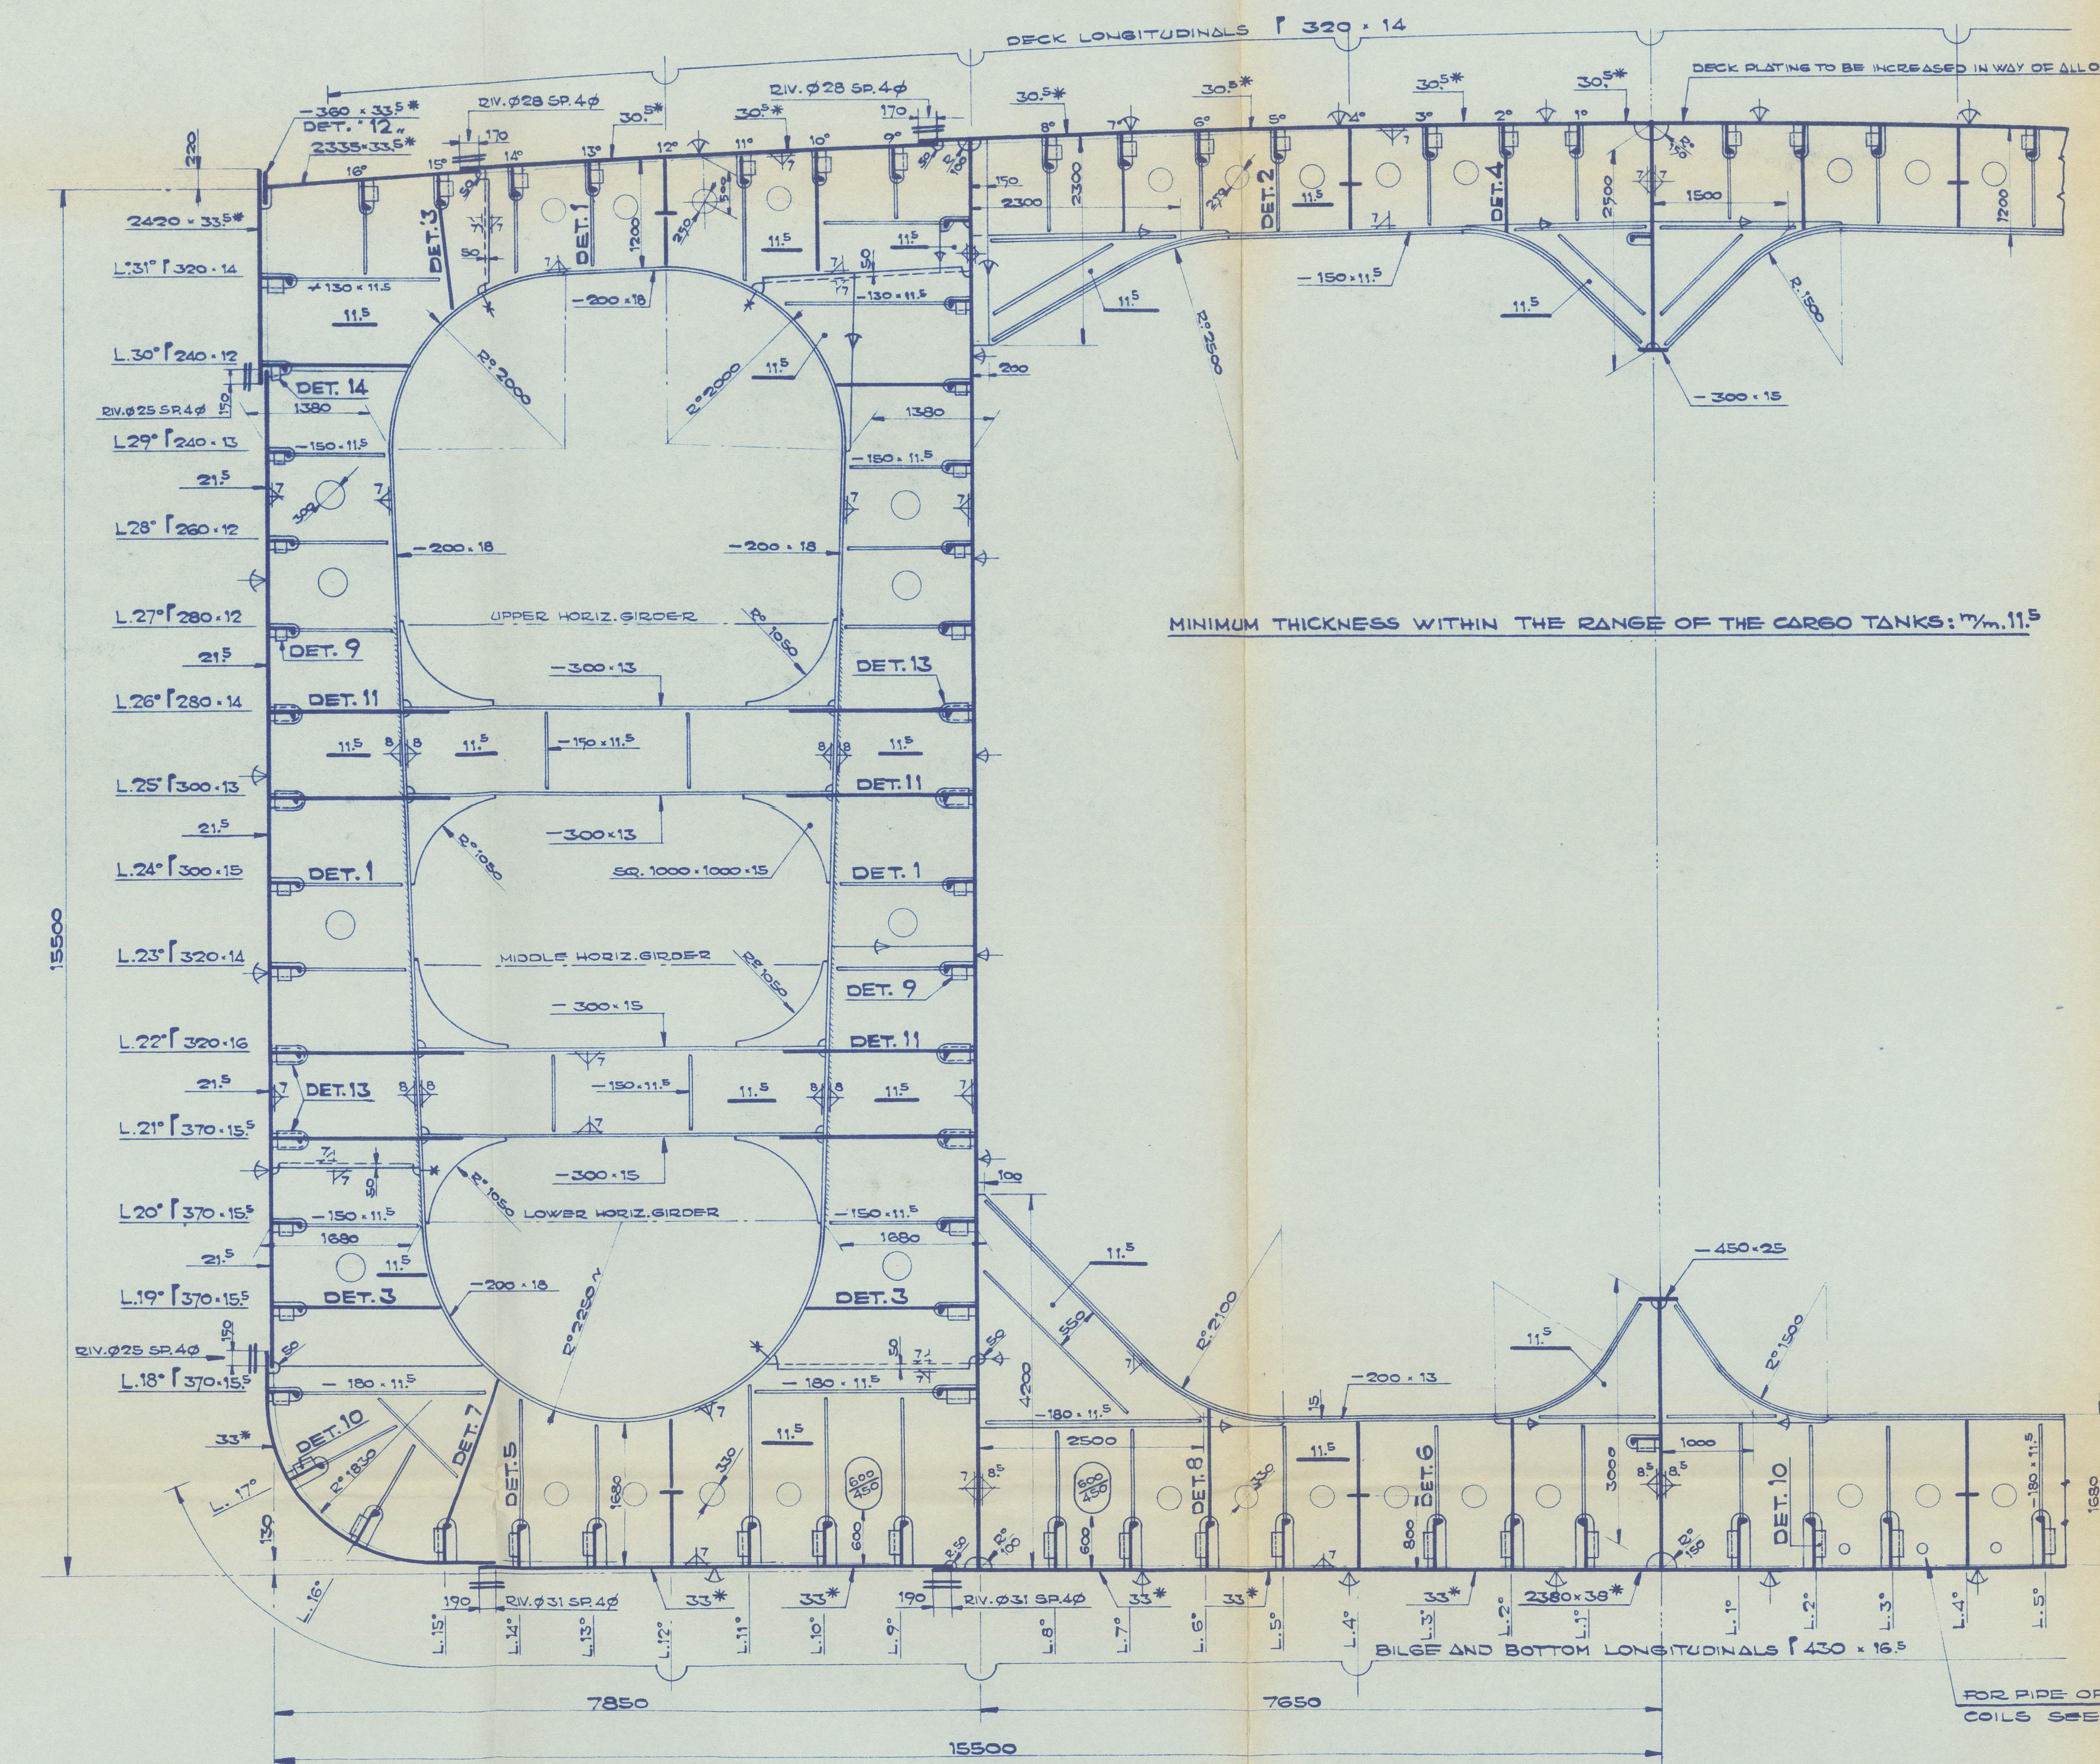


LONG. BULKHEAD

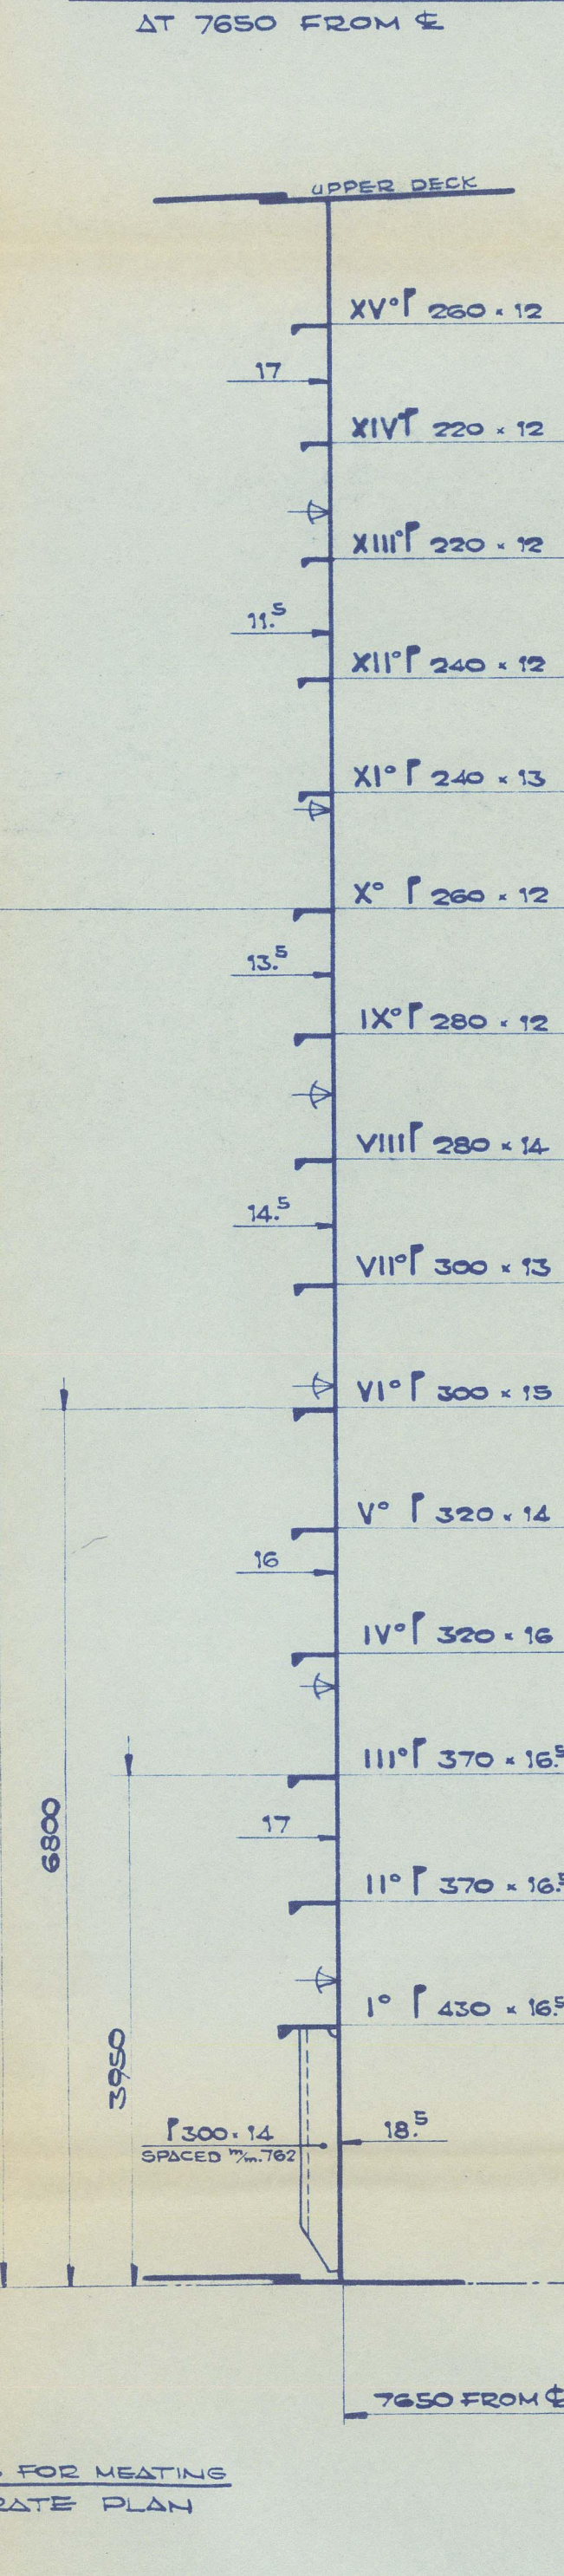


TRANSVERSAL OILTIGHT BULKHEAD

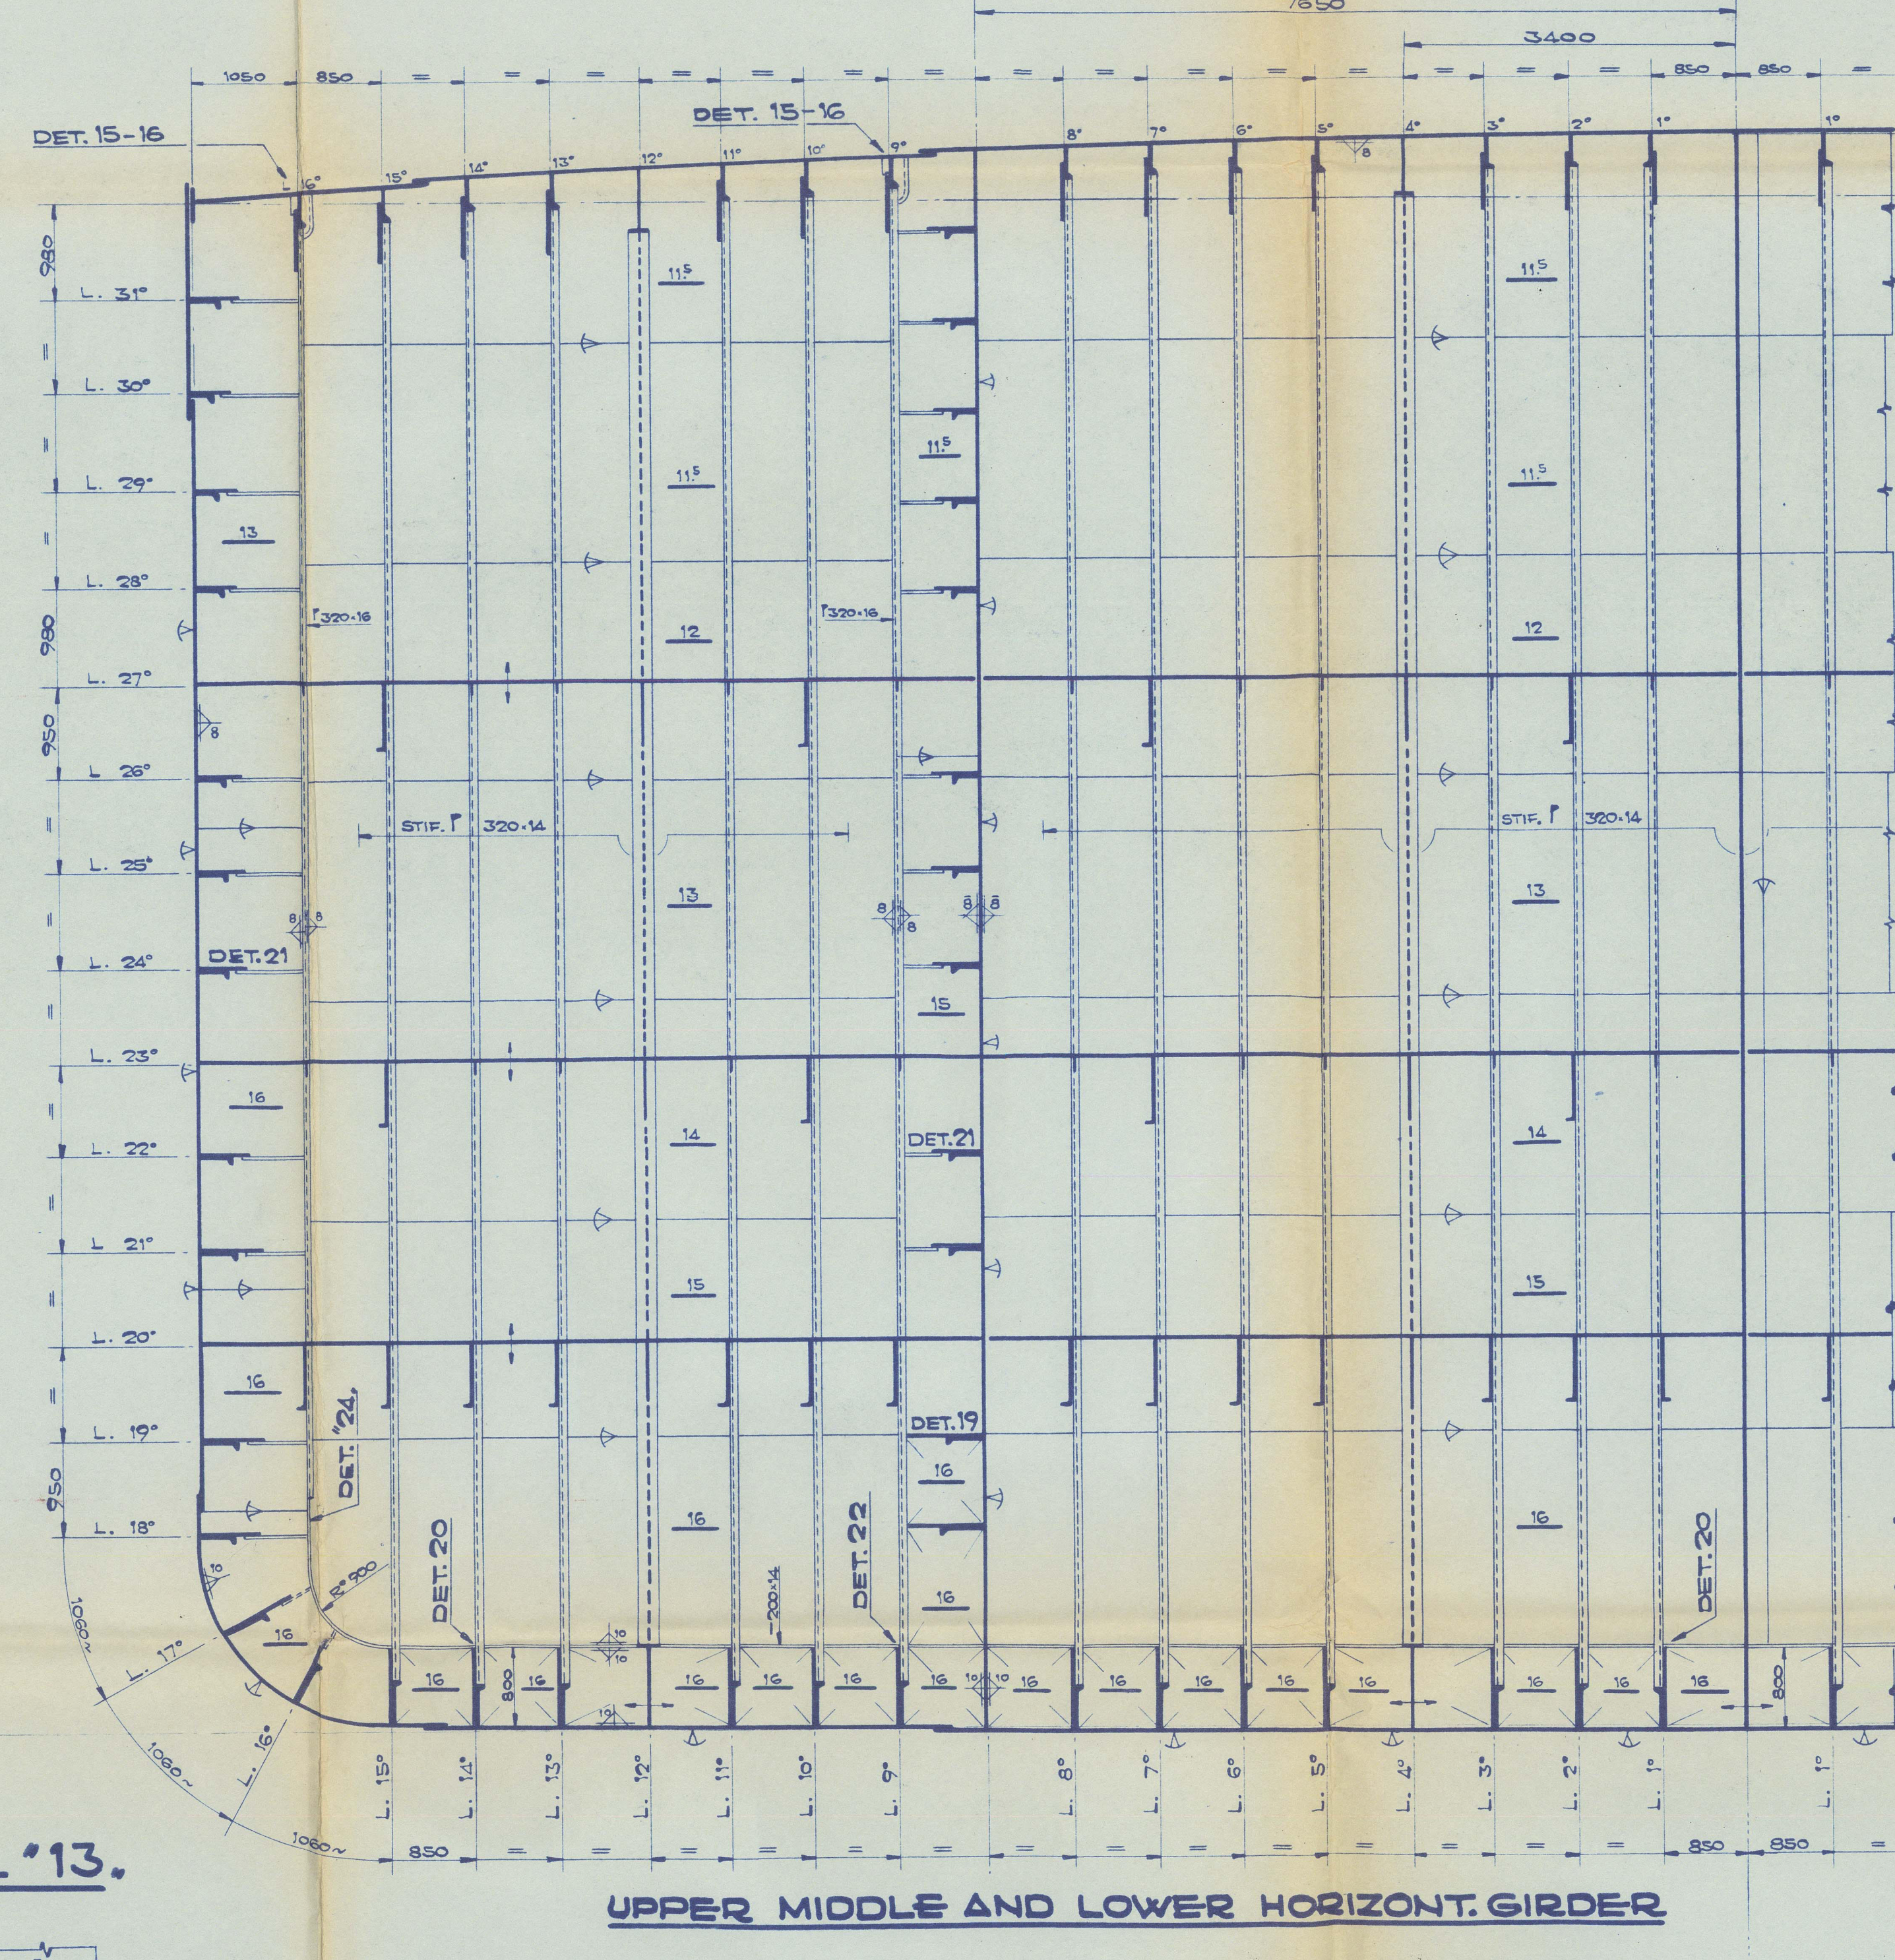


STIFFENERS

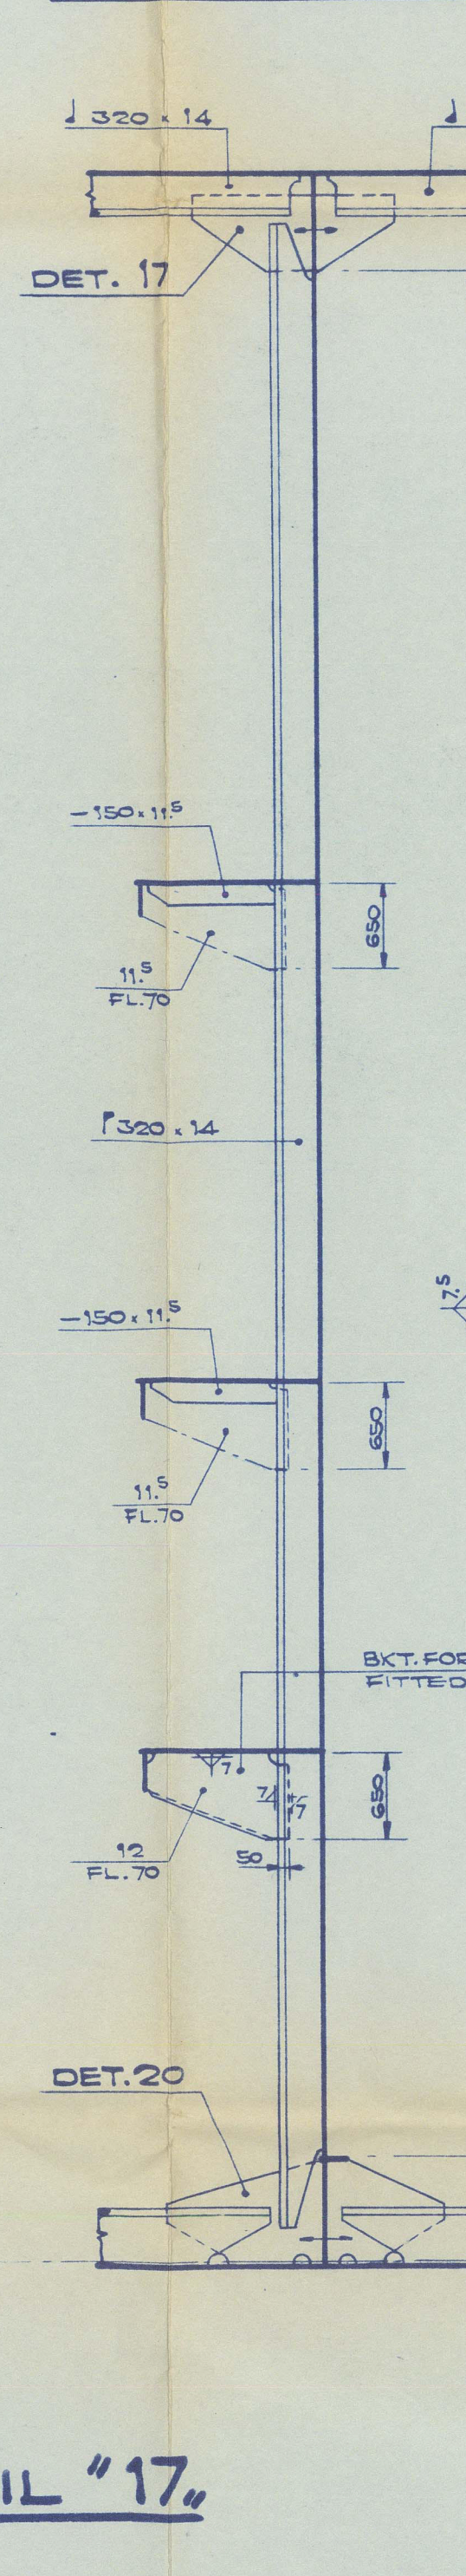


CENTRAL KEELSON

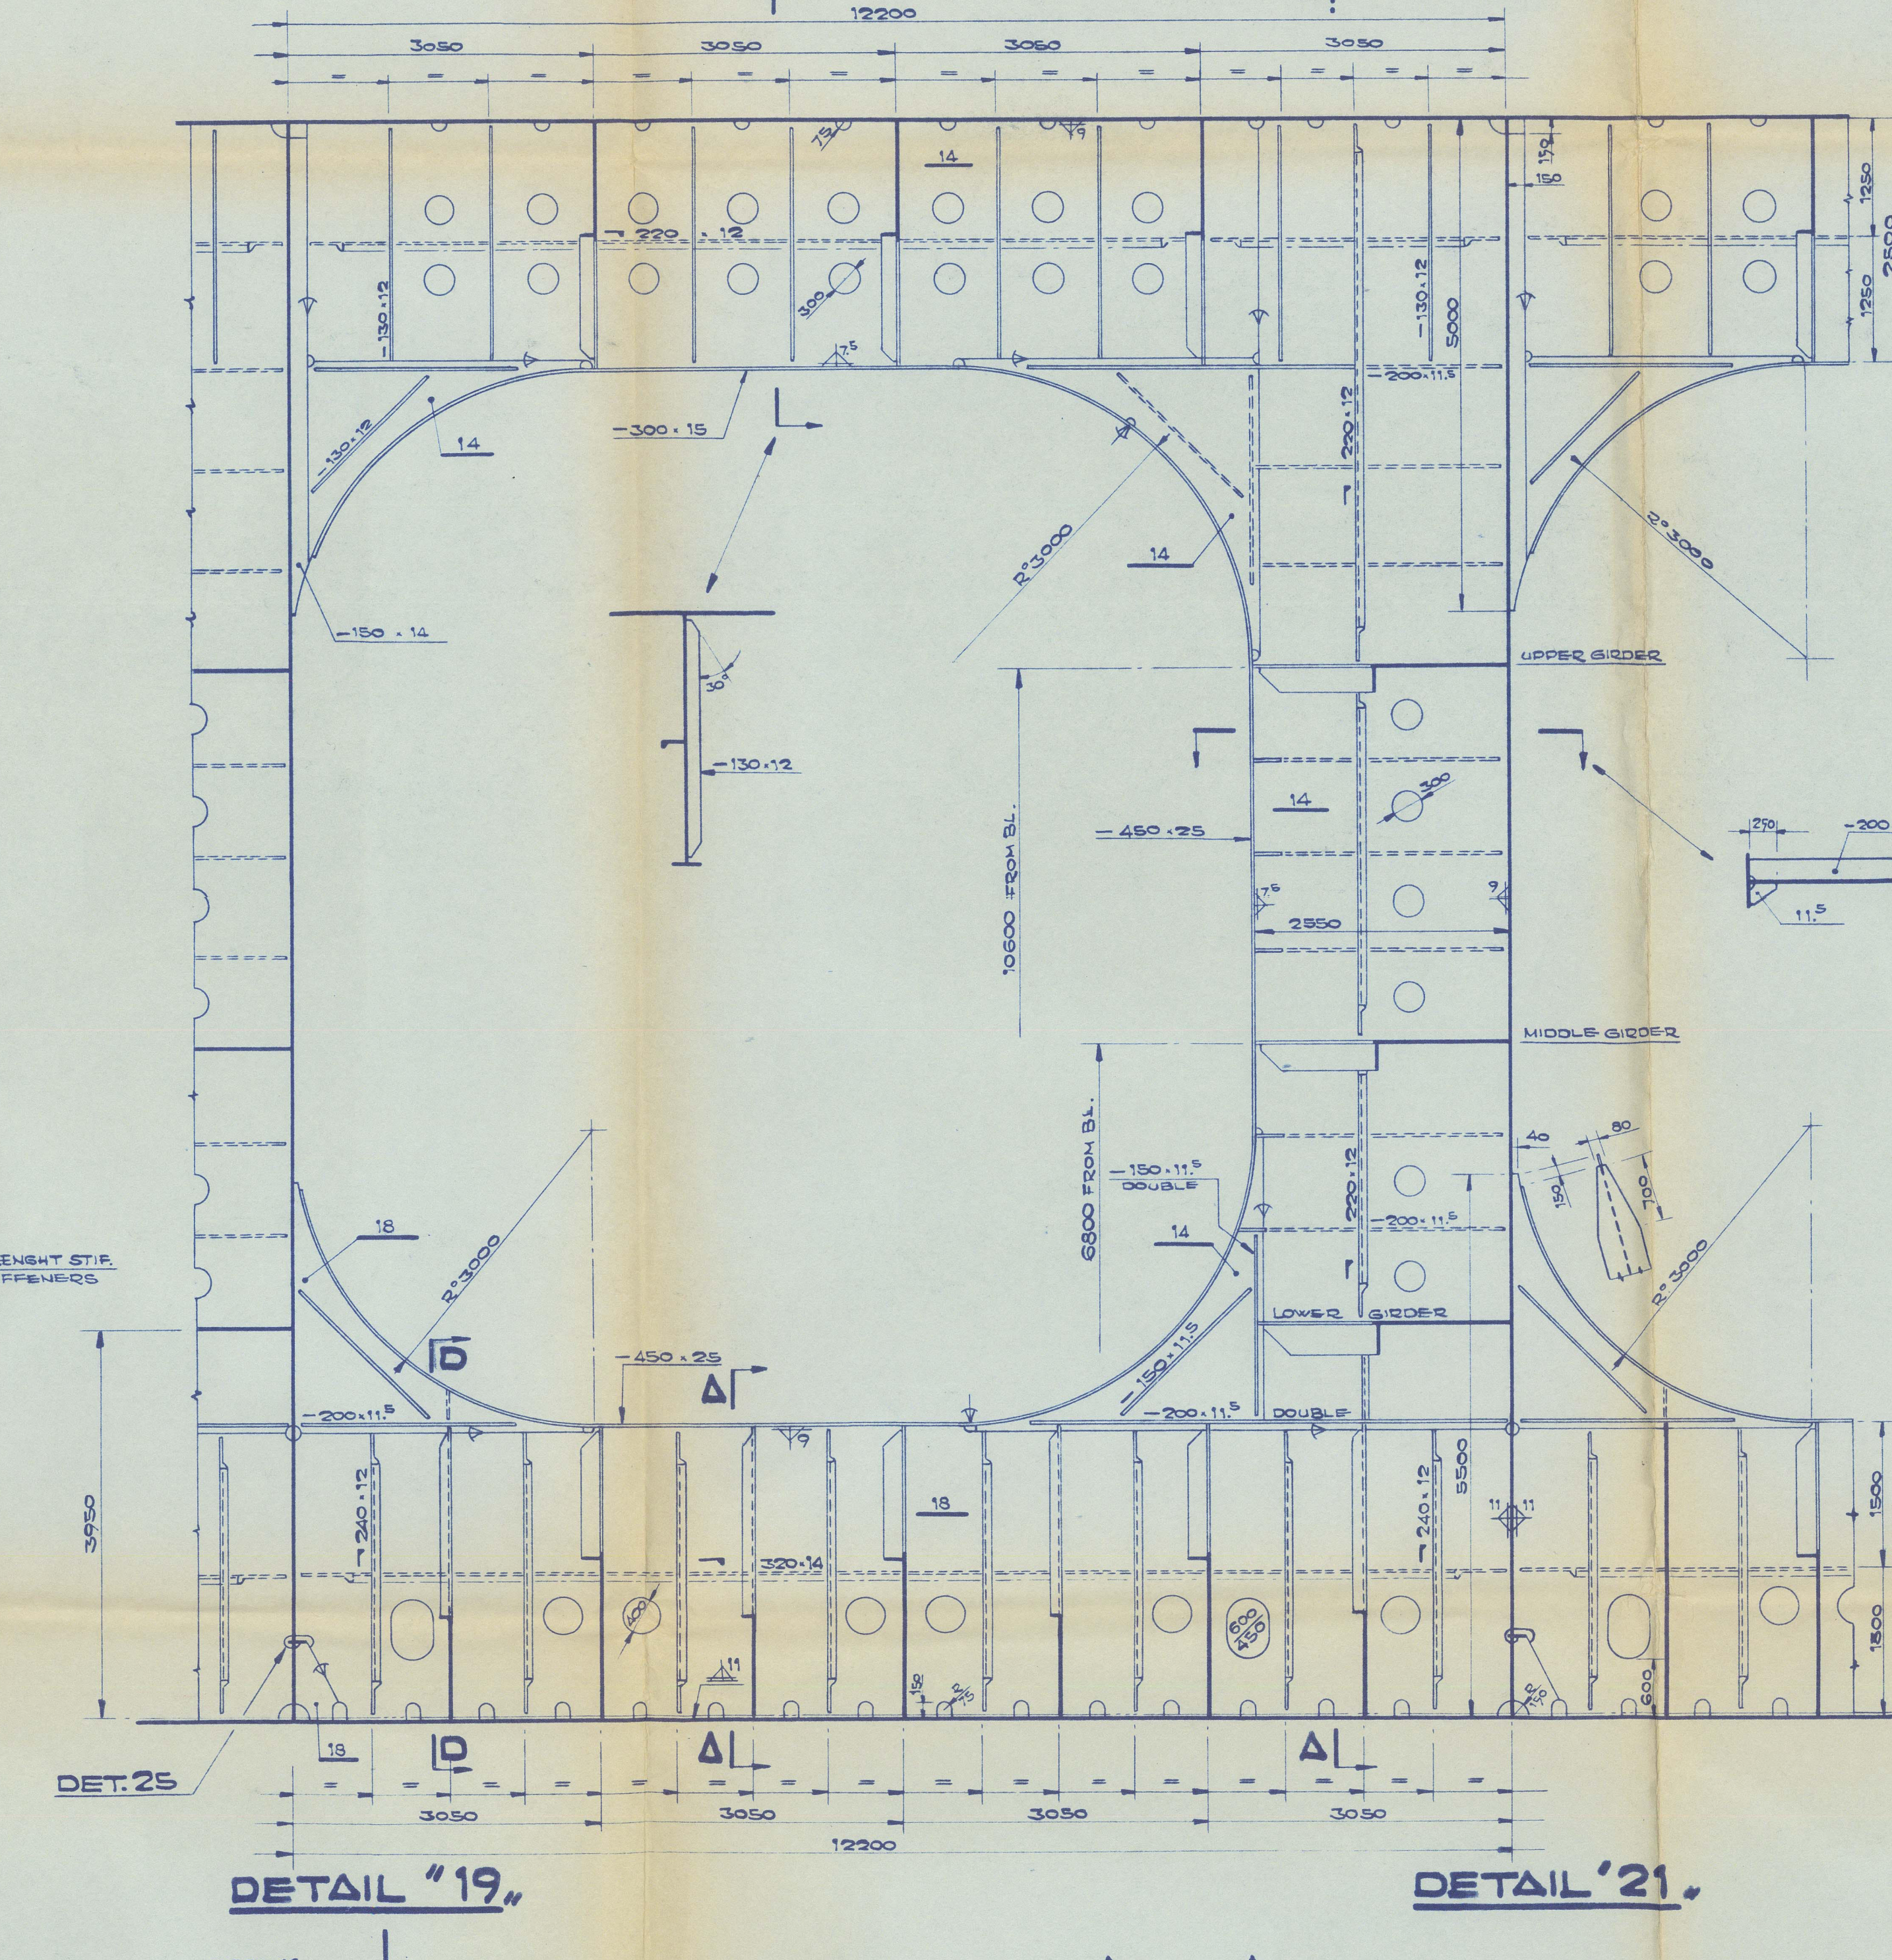


SECTION 'AA'

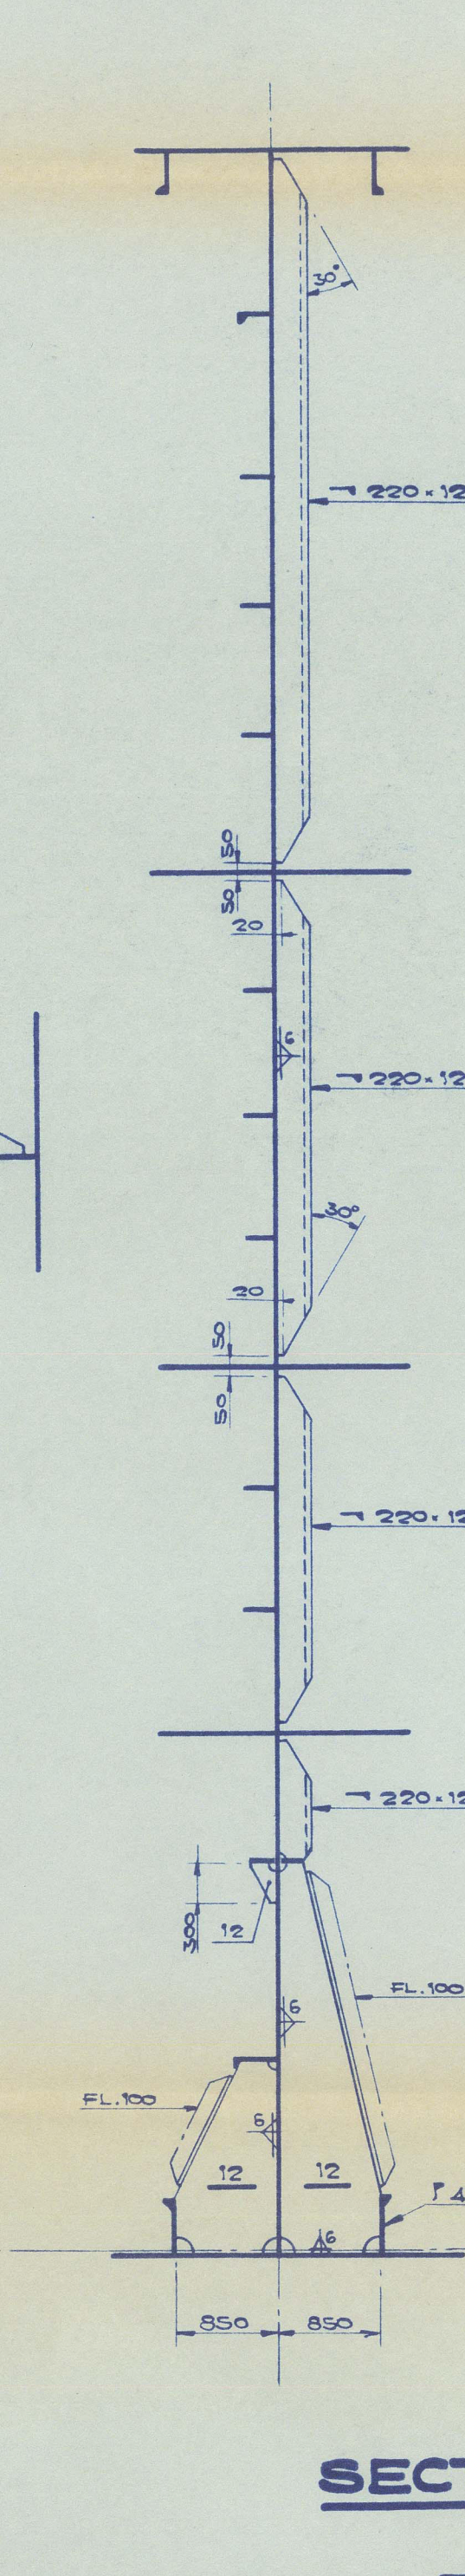


WASH BULKHEAD

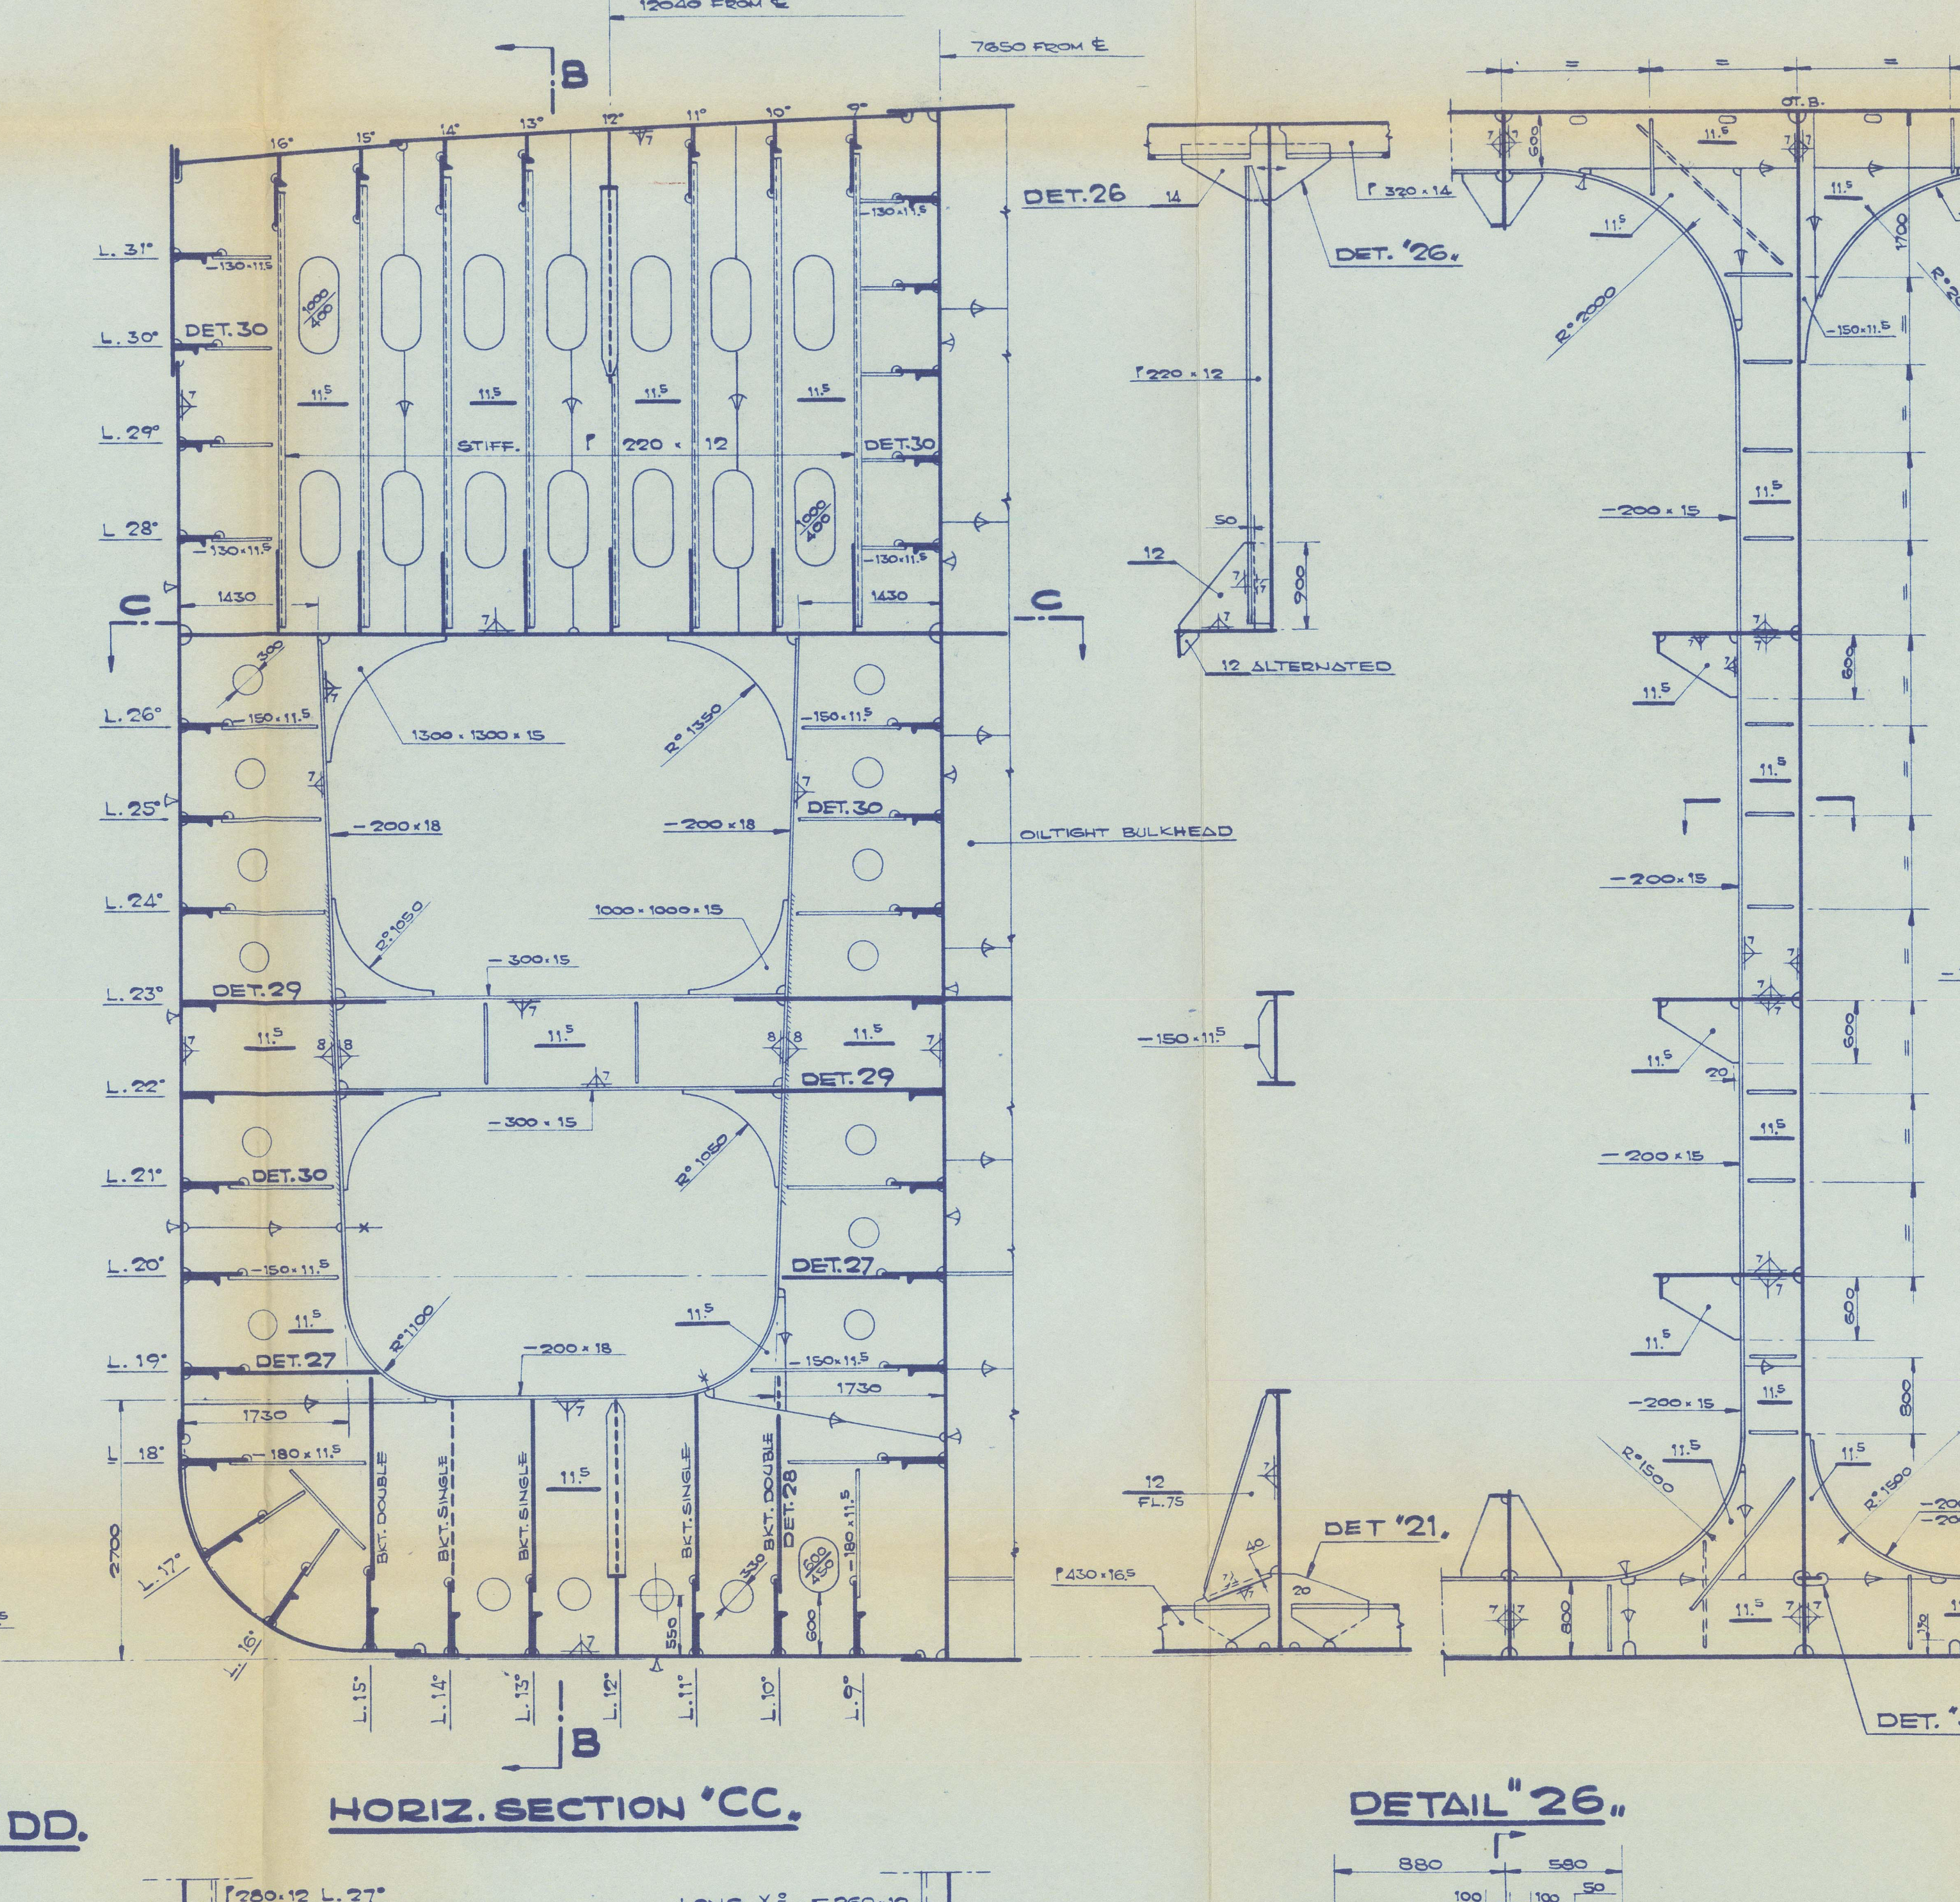

SECTION 'BB'

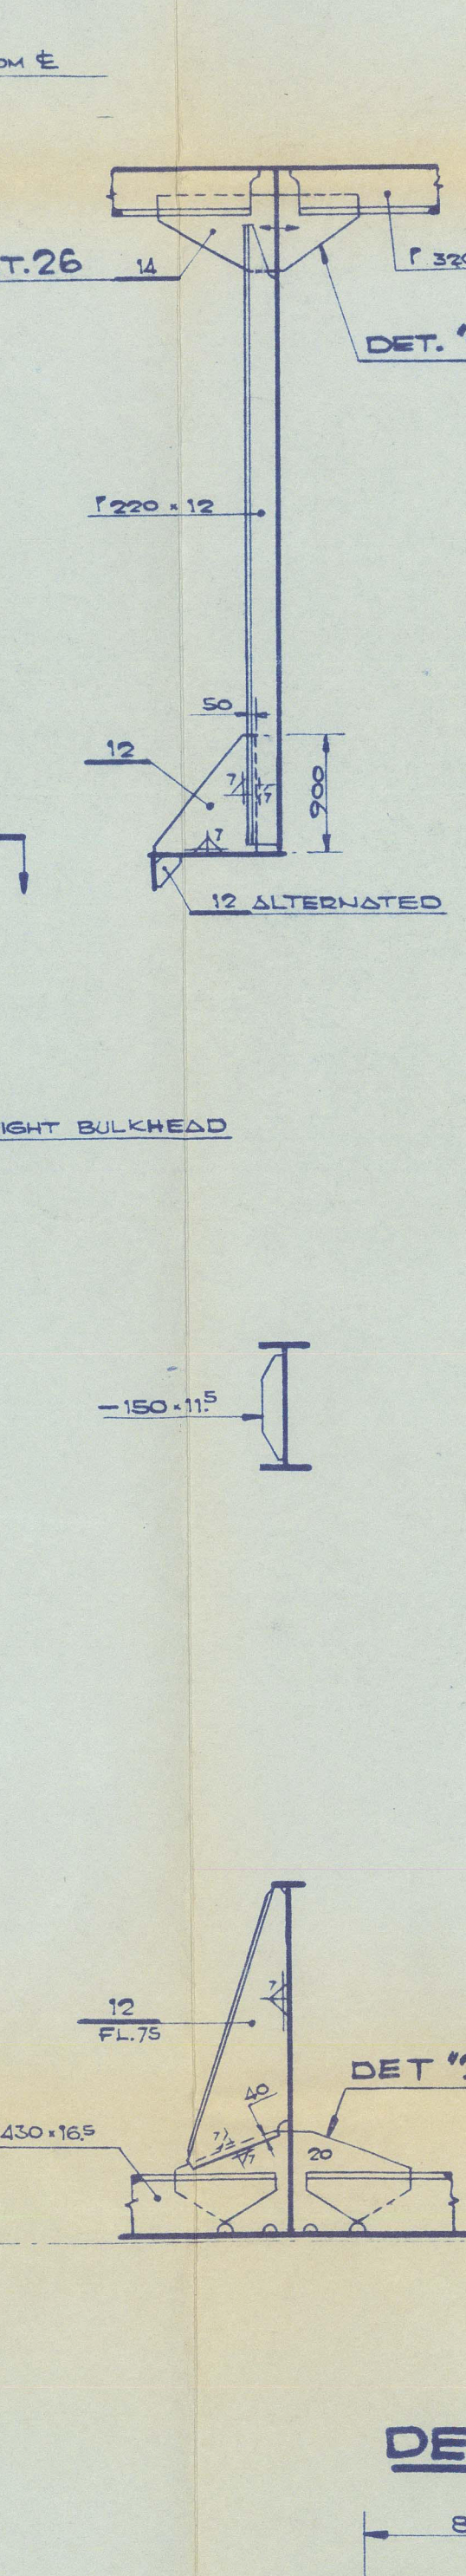

SIDE GIRDERS

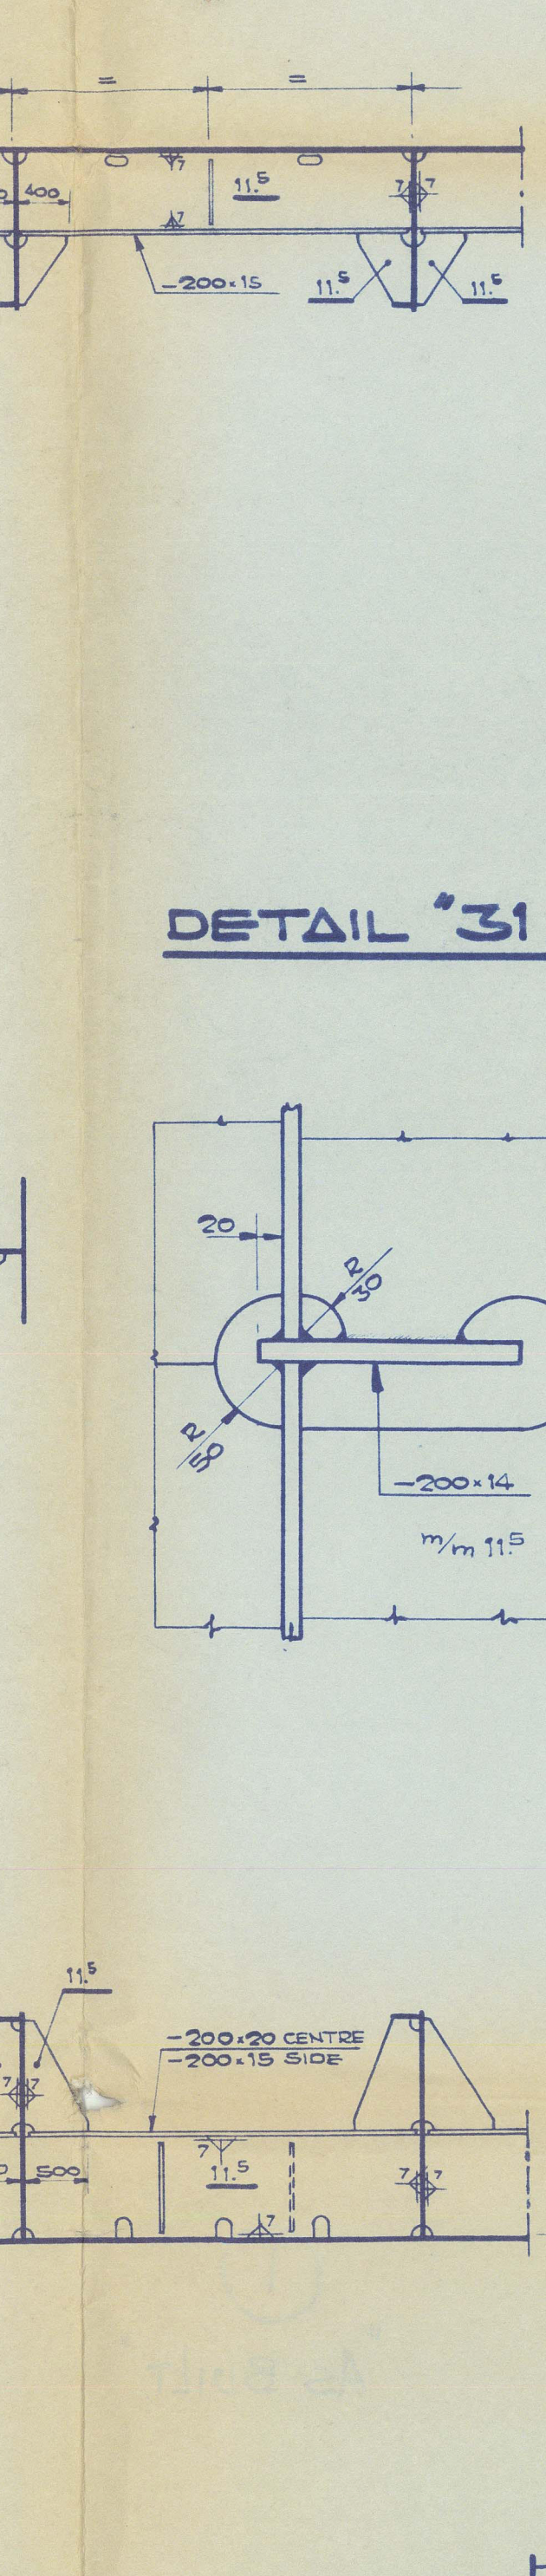

MOTOR OIL TANKER

OF NET 48000 METRIC TONS DEADWEIGHT
WITH 1145 HPS SUMMER DRAFT FROM BASE LINE

CLASS: L.R. 100. A.1 OIL TANKER

LONGITUDINAL FRAMING 'ICE CLASS' & SUITABLE NOTATION
WILL BE MADE REGARDING THE ELECTRIC WELDING
INTENDED FOR CARGOES OF OIL HAVING A FLASH POINT
BELOW 60°C AND INTENDED TO NAVIGATE IN LIGHT ICE CON-
DITION (ICE CLASS 3)

STEEL CONFORMING TO THE REQUIREMENTS OF GRADE 'D'.
WILL BE REQUIRED FOR THE FOLLOWING PARTS OF THE STRUCTURE:
SHEERSTAKE, STRINGER AND DECK PLATING FROM 0.25 L.
AFT OF MIDSHIP TO 0.25 L. FORD OF MIDSHIP, AND IN WAY
OF FORD FRONT WHERE THICKNESS EXCEEDS 20 mm.
KEEL, BOTTOM BILGE PLATING FROM 0.25 L. AFT OF MID-
SHIP TO 0.25 L. FORD OF MIDSHIP.

PRINCIPAL DIMENSIONS:

LENGTH BETWEEN PERPENDICULARS	mt. 215
BREADTH MOULDED	" 31
DEPTH MOULDED	" 15.97
DRAUGHT MOULDED FOR SCANTLING ONLY	11.677
ROUND OF BEAM	" 0.635

THIS DRAW. TO BE USED ALSO FOR YARDS 1594-98

25 MAR. 1964

ANSONO S.A. CANTIERI	1:50 1:100 1:150
48000 MT. TONS DWT MOTOR TANKER	01 00 100 1593
MIDSHIP SECTION	

01549-011376-0076

Lloyd's Register Foundation

GENOA - F.E. RPT. N° 289441

①

"AS BUILT."

ANSALDO S.P.A. GENOA - SESTRI.


YARD N° 1594.

"FEDOR POLETAEV" ★

MIDSHIP SECTION.

RECORDS DEPT.,
LONDON.

①

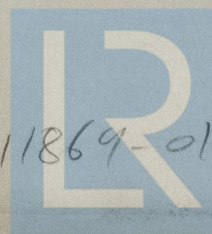

© 2021

011869-011876-0070
Lloyd's Register
Foundation

1/200