






SCOTT & SONS
SHIPBUILDERS
7/4/49
BOWLING, NR. GLASGOW

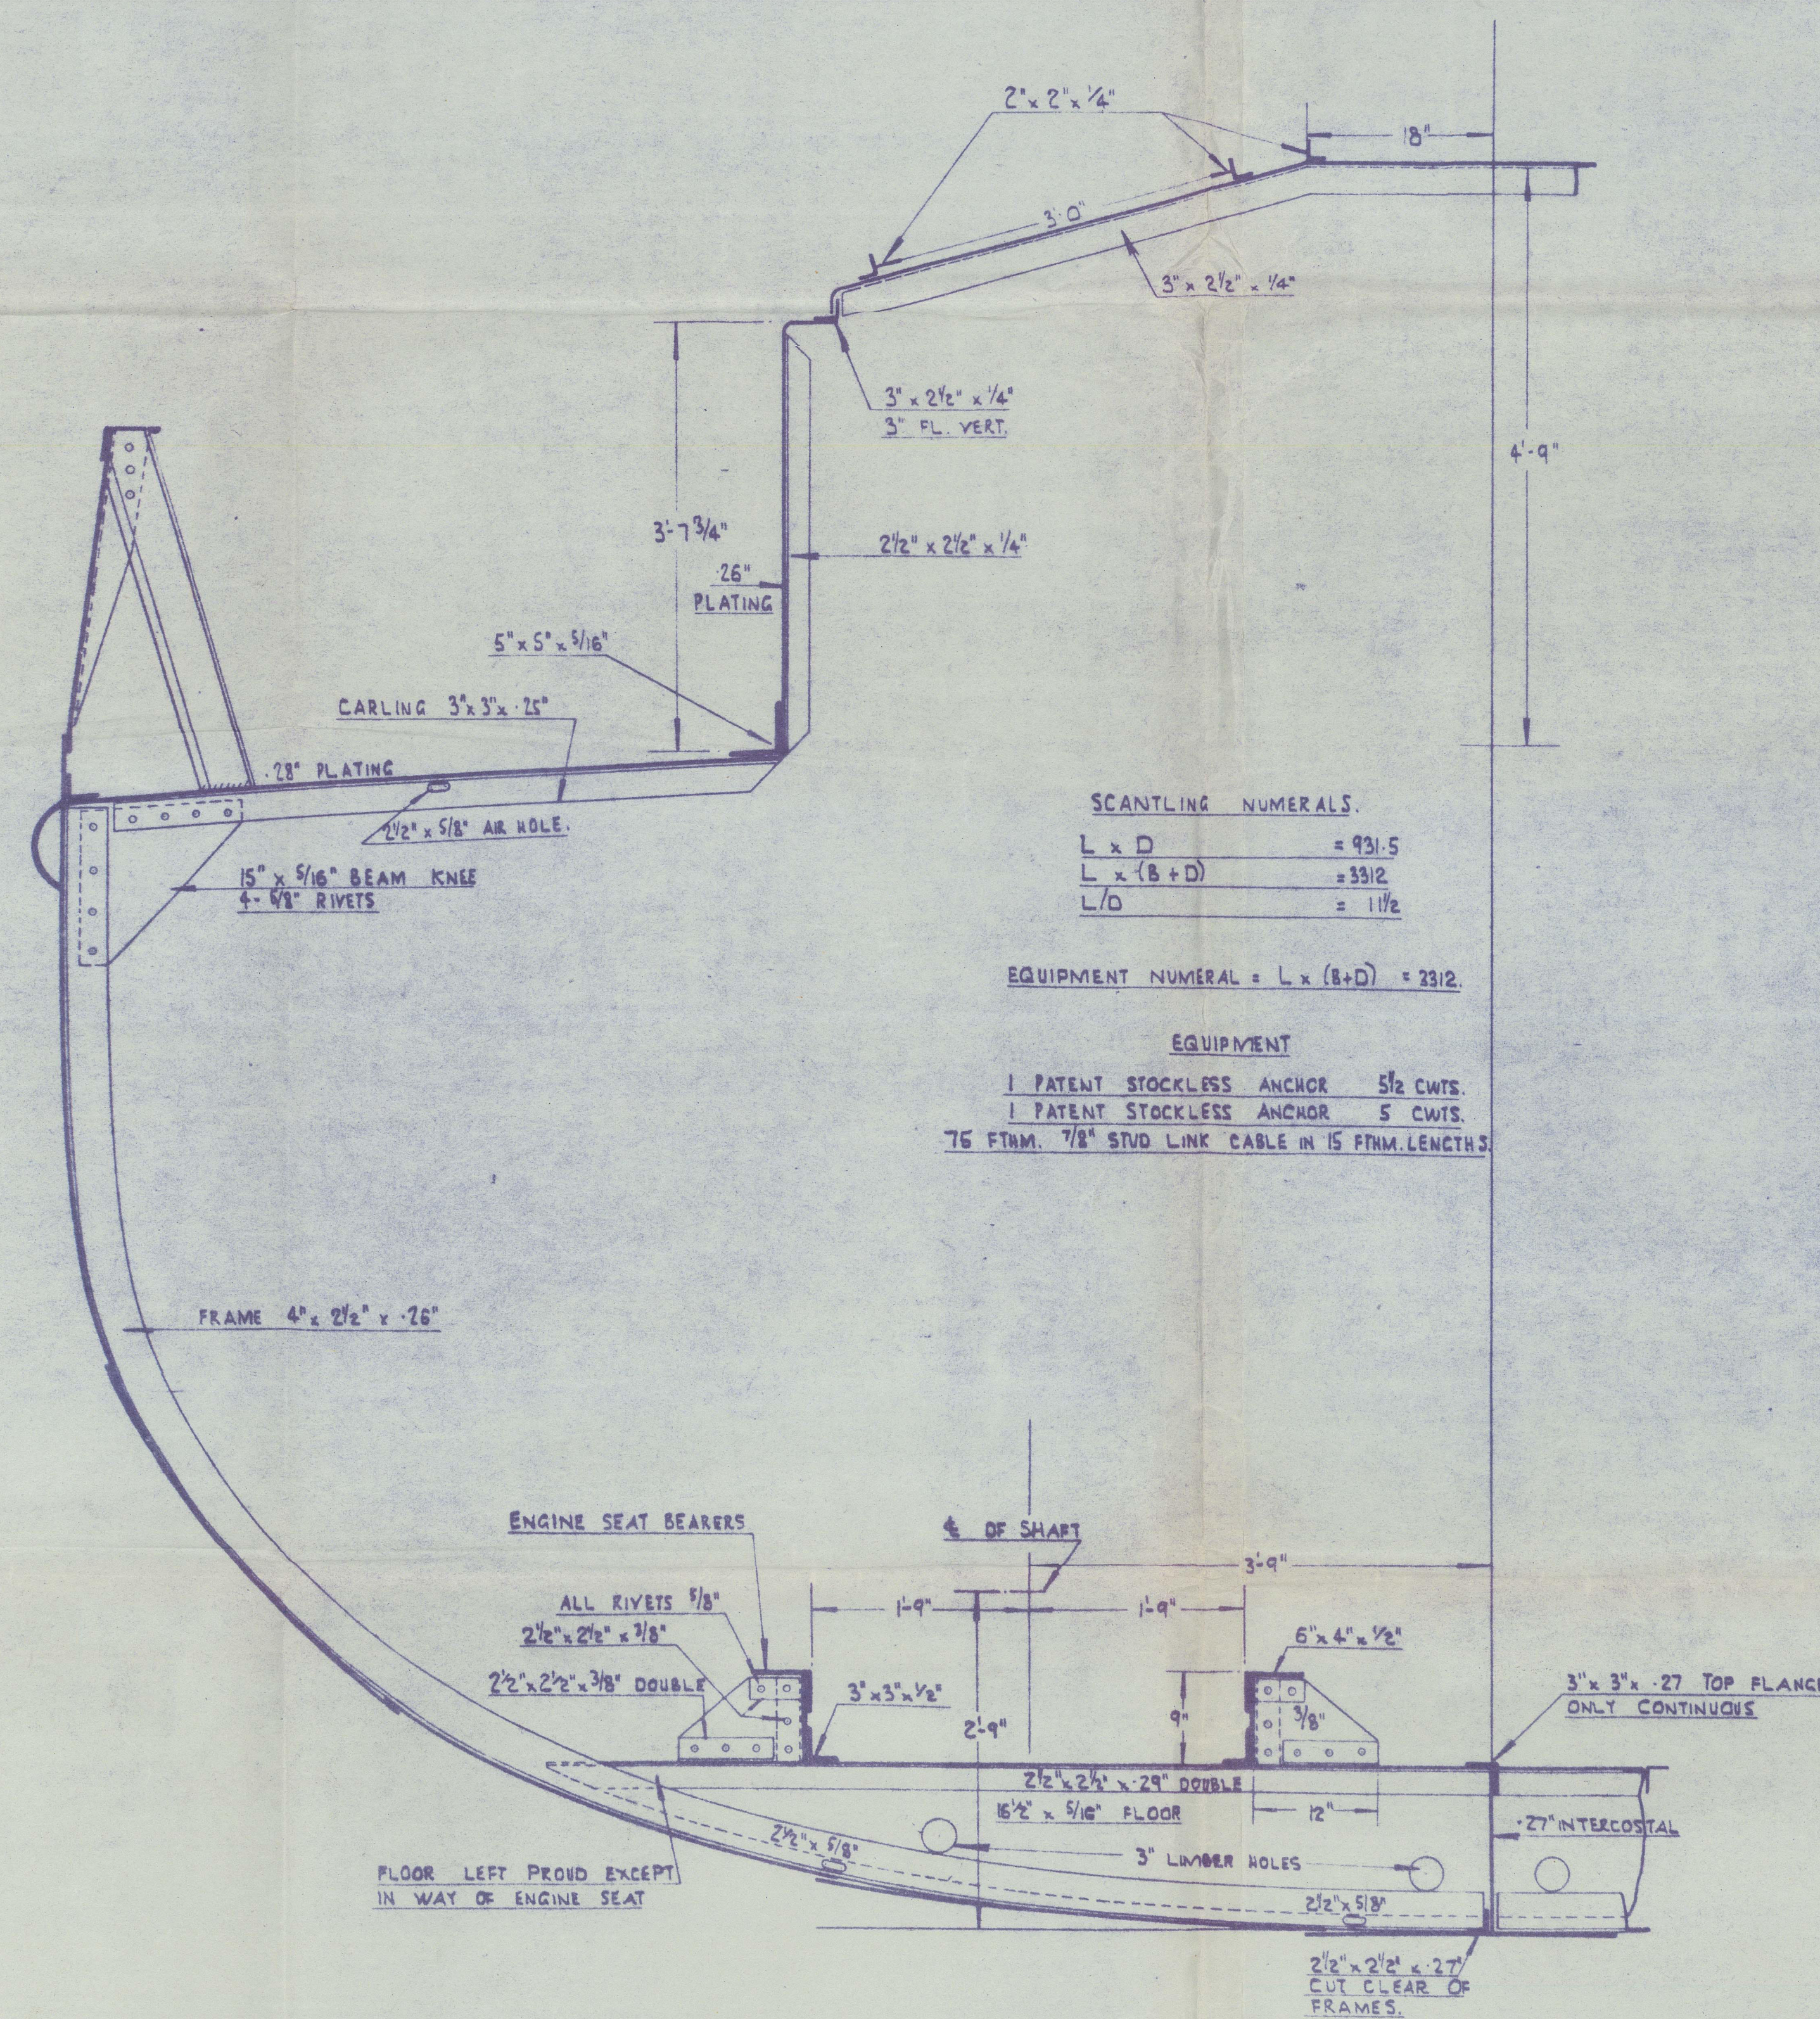

SECTION THRO' ENGINE ROOM.

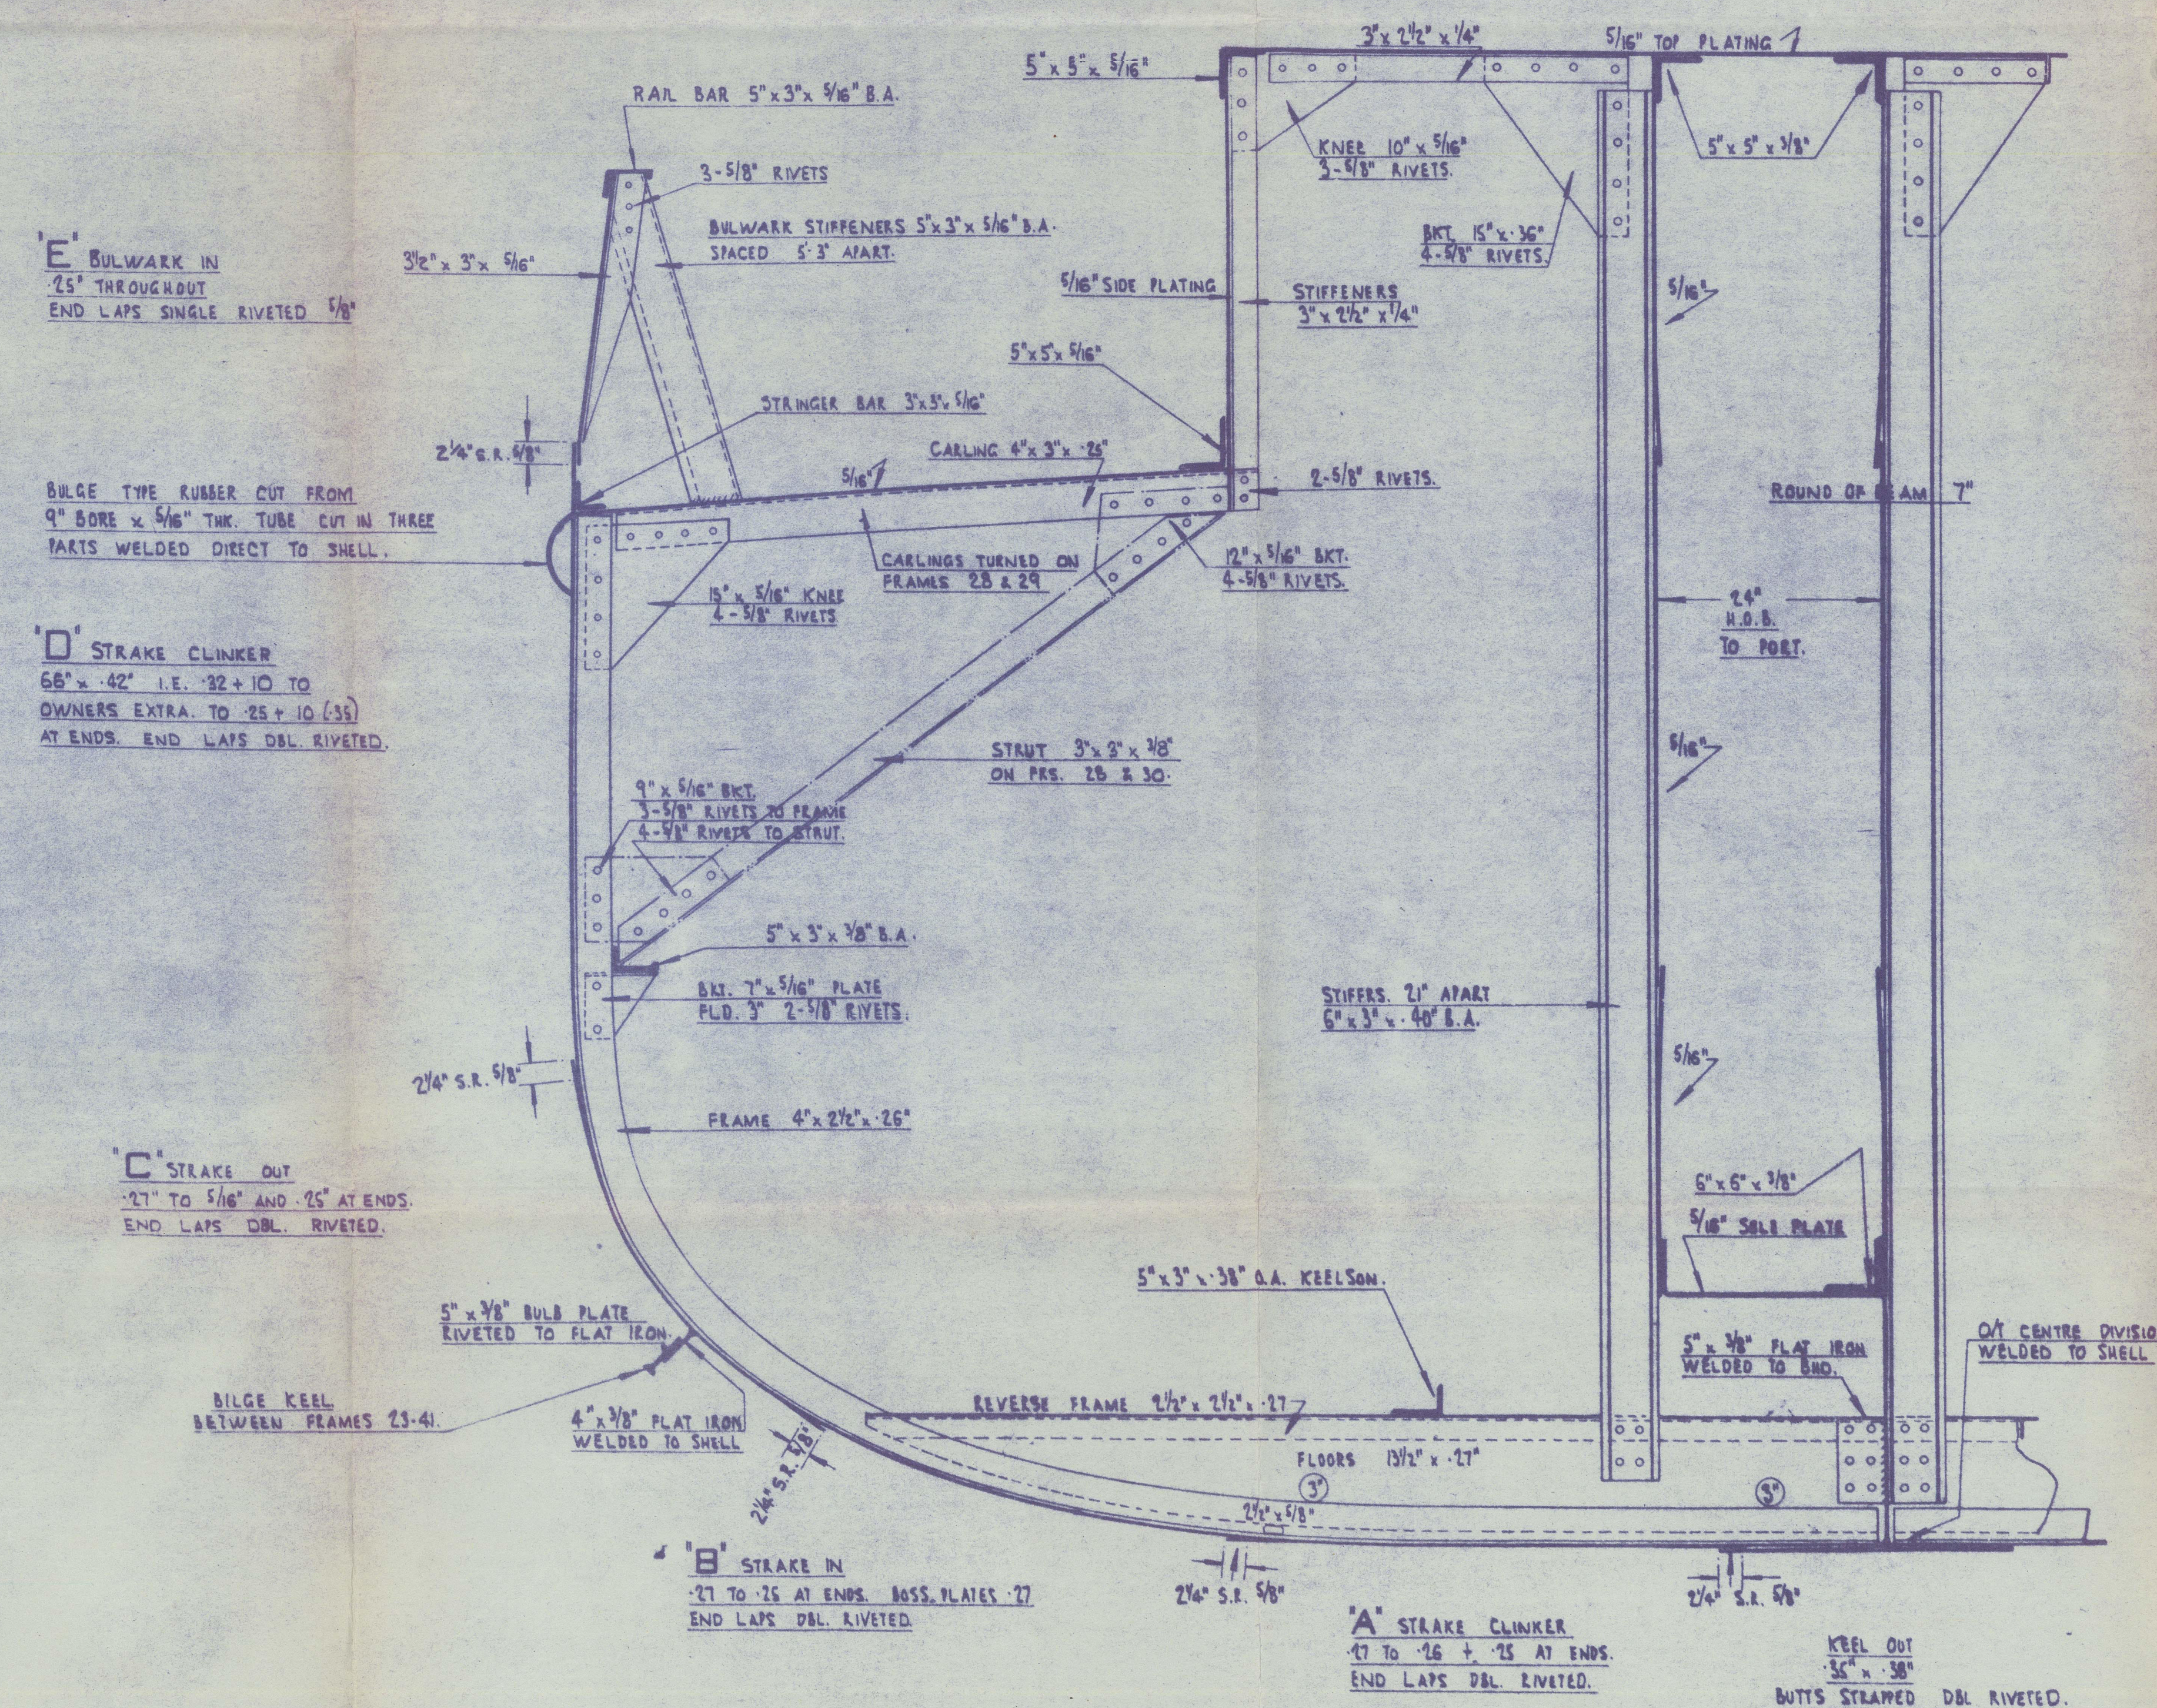

SECTION THRO' OIL FUEL BUNKER.

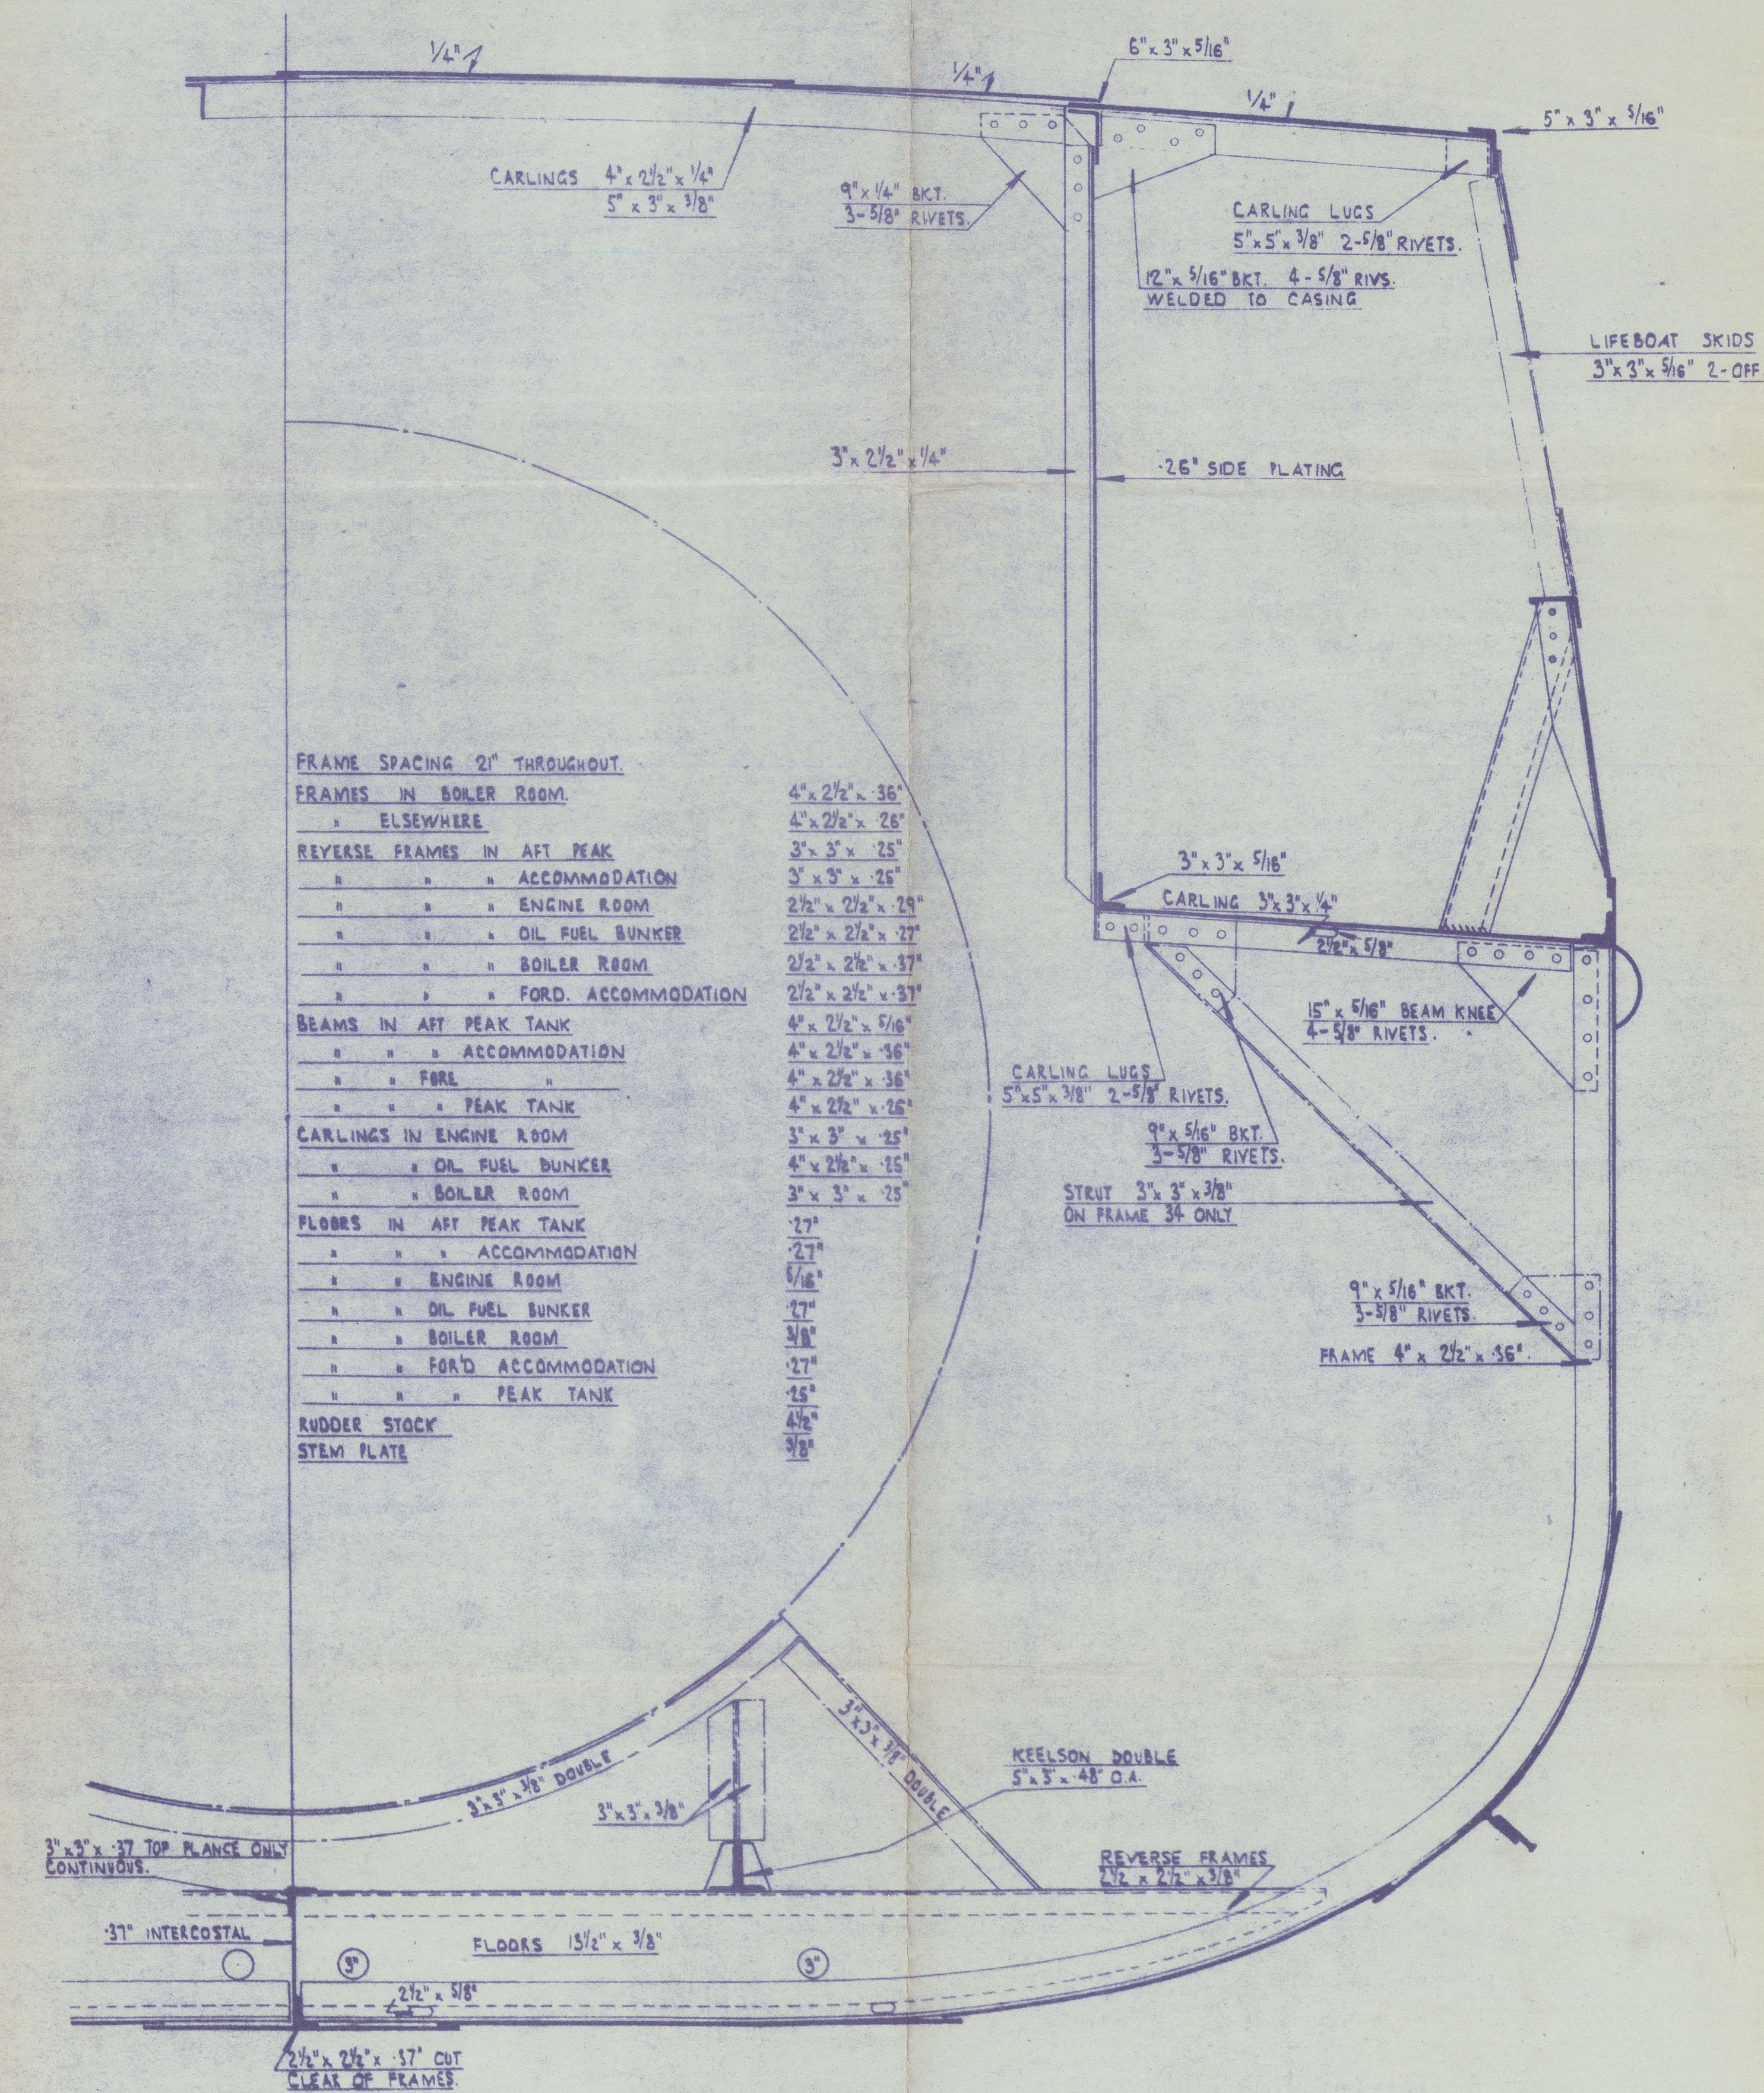


SECTION THRO' BOILER ROOM.

T. N. Sc. TUGS.

N^o 387. "TAFT."

RECORDS DEPT.,
LONDON

N^o 388. "TANB." ★

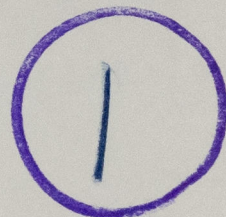

SCOTT & SONS.

BOWLING.

MIDSHIP SECTION

AS BUILT.

GLASGOW

1949.

GLASGOW REPORT NO. 73835/6.



© 2021

Lloyd's Register
Foundation