

PROFILE & DECK PLAN.

NON-PROPELLING BOW-WELL BARGE LOADING BUCKET DREDGER.

TO CLASS 100A.I. DREDGER AT LLOYDS

YARD N^o 265.

DIMENSIONS.


LENGTH OVERALL ON DK. 190'-0"

BREADTH M^{ld} 36'-0"

DEPTH M^{ld} 11'-6"

Scale: 1/4" = 1 foot.

"PERSEVERE"

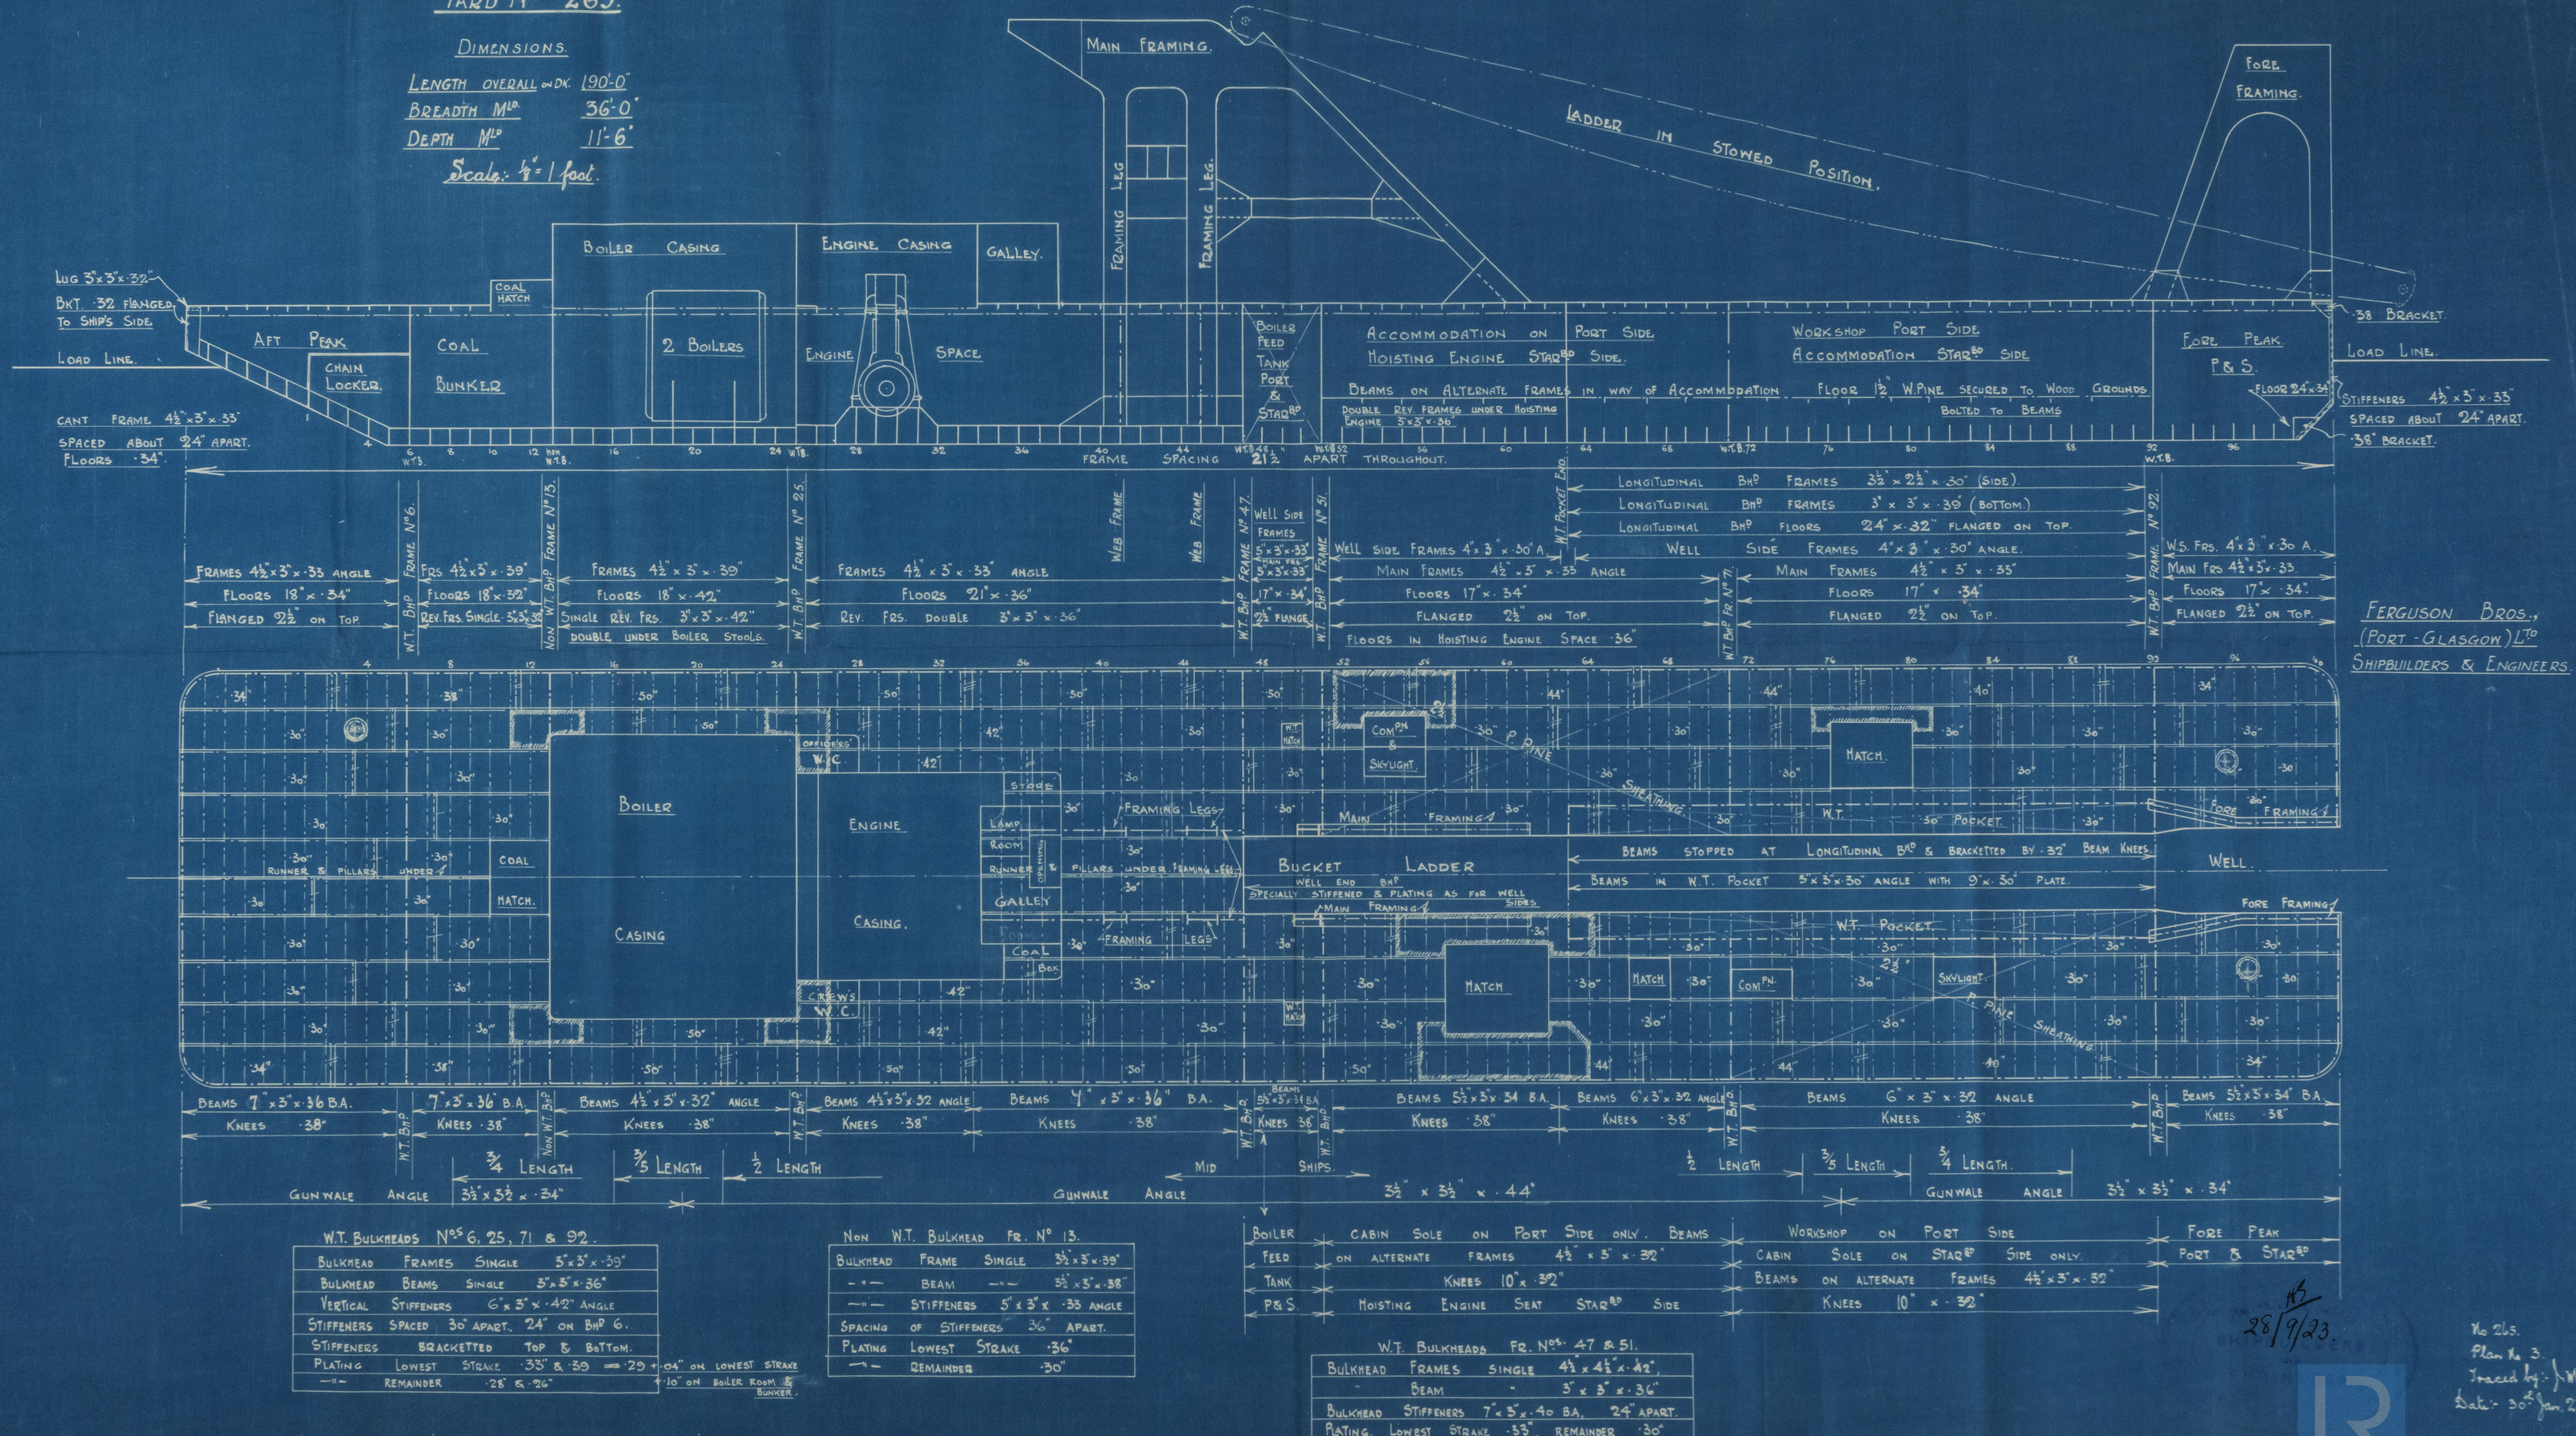

FERGUSON BROS.,
(PORT-GLASGOW) LTD.
SHIPBUILDERS & ENGINEERS.

No 265.
Plan No. 3.
Traced by: J.M.
Date: 30th Jan. 23.

010278, 010288 - 0251


"GOODWORKER"



PROFILE & DECK.

(AS BUILT)

RECORDS DEPT.
LONDON.

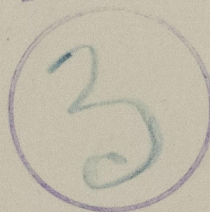

© 2021

Lloyd's Register
Foundation

012078-012088-0251

Ferguson Bros (Port Glas) L^d

No 265.

Non-propelling Bucket Dredger.

"PERSEVERE"

Profile & Becks (as built).

Grk Rep No. 18129.

012078-012088-0251



© 2021

Lloyd's Register
Foundation