


MELBOURNE HARBOR TRUST COMMISSIONERS.
SINGLE SCREW DIESEL HOPPER BARGES.
CLASSIFICATION:- LLOYDS + 100 A.I. HOPPER BARGE
DIMENSIONS:- 170'-0" B.P. x 36'-0" MLD. x 17'-0" MLD.

NUMERAL.

L	170.0'
B	36.0'
D	17.0'
d (MLD. SW.) APPROX.	15.5'
h	15.0'

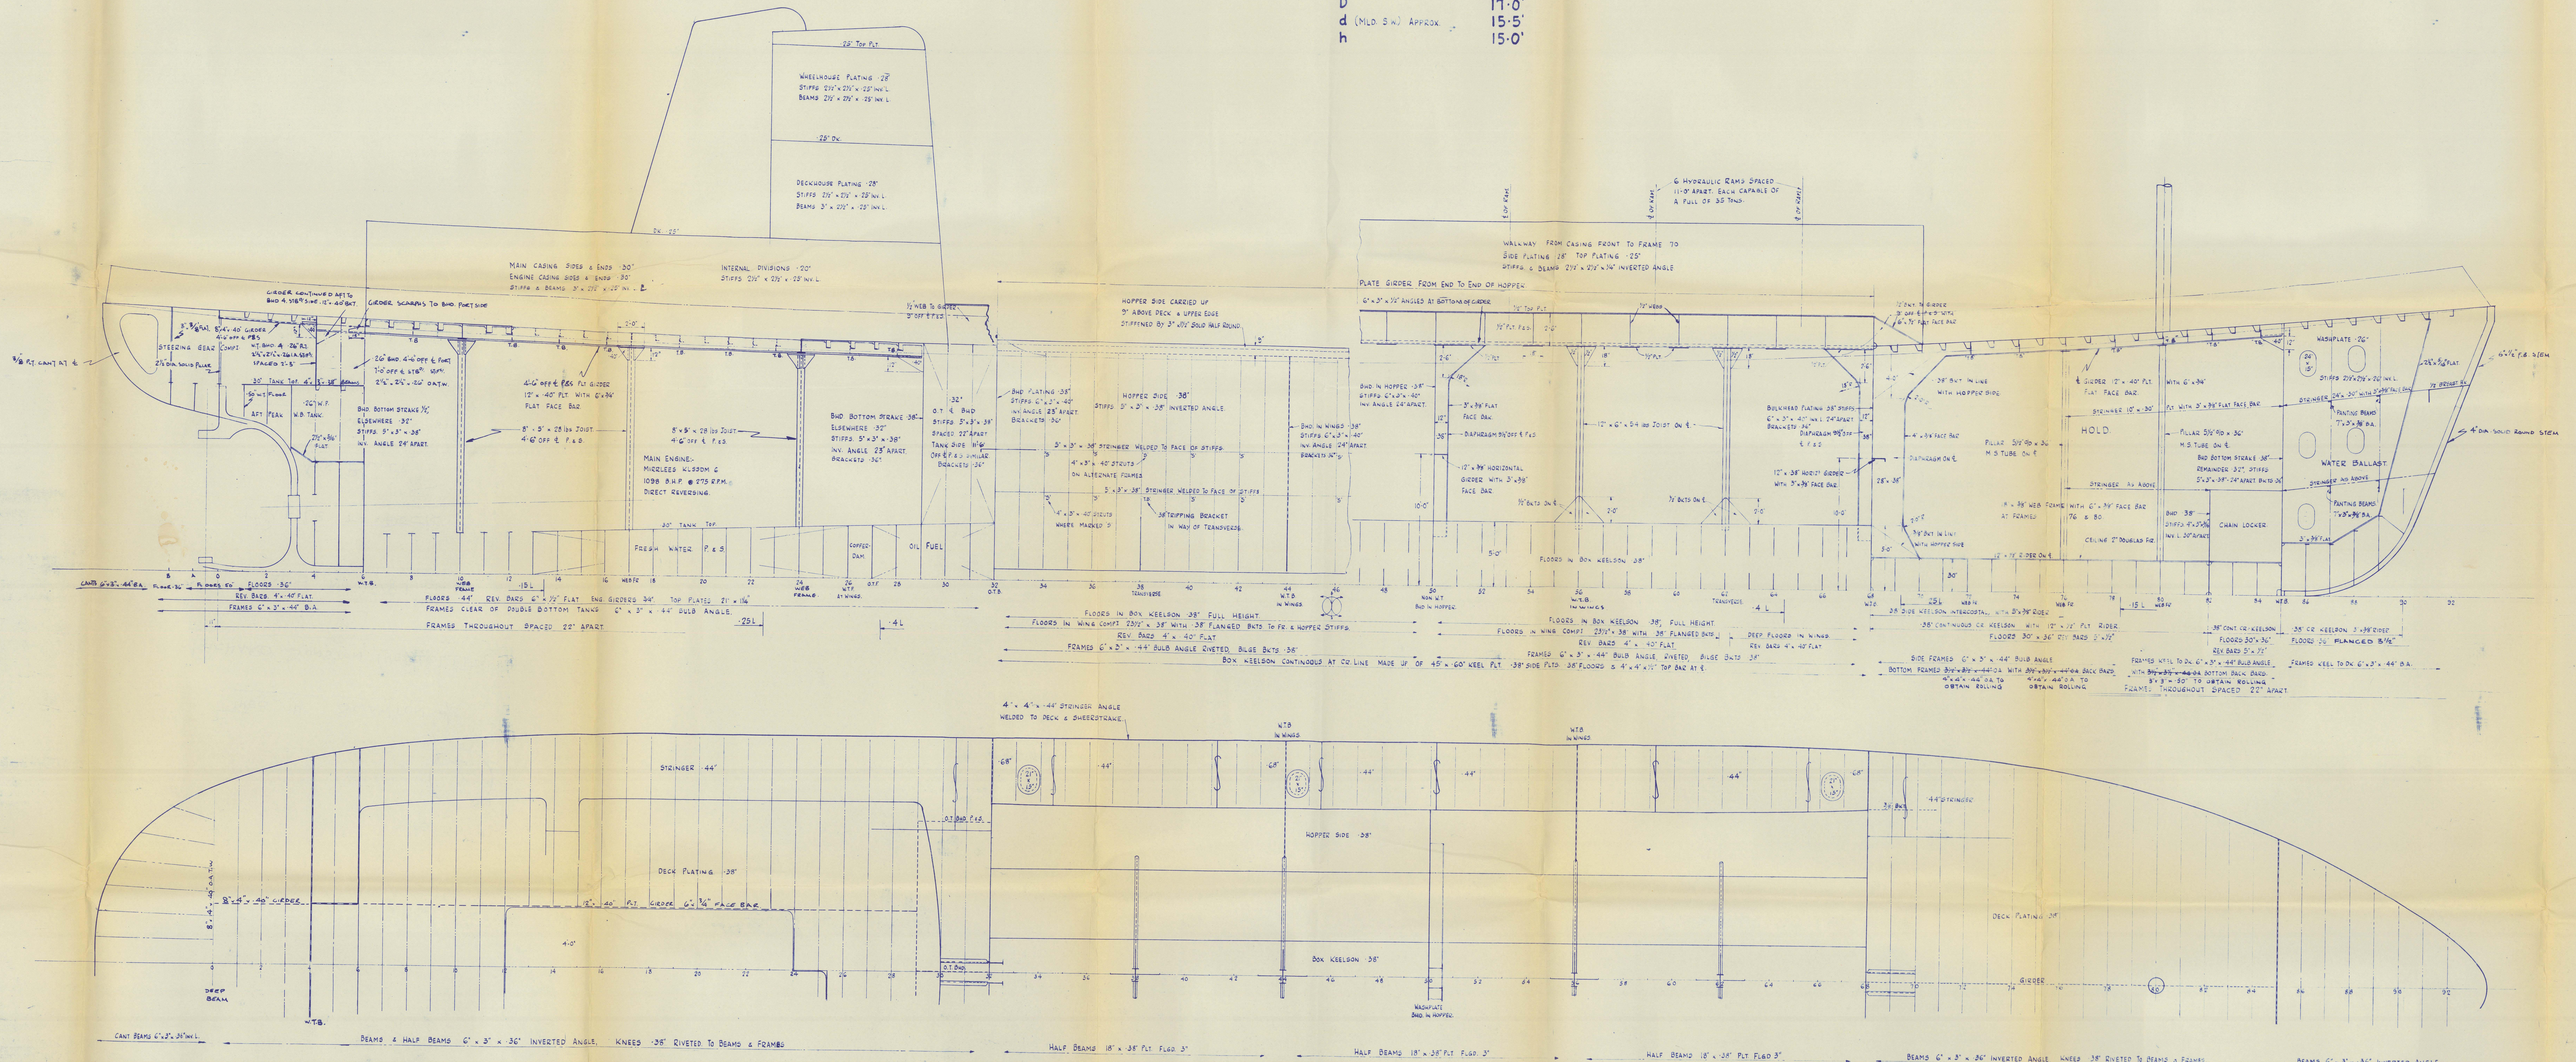

ALL DECK SEAMS & BUTTS WELDED.

BEAMS, GIRDERS & BULKHEADS WELDED TO DECK.
BULKHEADS WELDED DIRECT TO SHELL.

RICHARD DUNSTON LTD.
SHIPBUILDERS,
THORNE, YORKSHIRE.

DRAWN BY <i>J.W.</i>		DATE 15-12-60
TRACED BY		DATE
CHECKED BY		DATE
REVISIONS:		
NO	DATE	PARTICULARS
A	3.1.61	MODIFIED PER ...

APPROVED BY OWNERS 2/1-2/01

This Drawing and the information it contains are the Property of CHARLES DUNSTON LTD
It is not to be Traded, Copied or Published without their Written Consent, nor is the
information thereon to be misused in any way.


YARD N^o. S. 780/1 DRG. N^o 5705/6.A

TITLE:-

PROFILE & DECK. 'AS BUILT'

SCALE- 1/4" TO ONE FOOT.

RECORDS DEPT.,
LONDON.

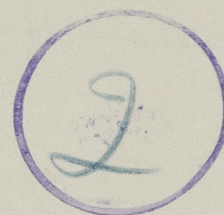

THEO H. SWANTON ★

RICHARD DUNSTON (HESSLE) LTD.

YARD No 781

PROFILE + DECK

"AS BUILT"

HUL. F.E. REPT. No 67905



© 2021

Lloyd's Register
Foundation

012102 - 012107 - 0104