

LLOYD'S STAMP
28-12-60

MELBOURNE HARBOR TRUST COMMISSIONERS.
SINGLE SCREW DIESEL HOPPER BARGES
CLASSIFICATION:- LLOYDS + 100 A. I. HOPPER BARGE.
DIMENSIONS:- 170'-0" B.P. x 36'-0" MLD. x 17'-0" MLD.

LLOYD'S NOTE:-
THE SPANTLING AS SHOWN ARE SUITABLE FOR A SUMMER
DRAUGHT OF 15'-6" MEASURED ABOVE TOP OF KEEL.




NUMERALS

L	170'-0"
B	36'-0"
D	17'-0"
d (MLD. S.W.) APPROX.	15'-5"
h	15'-0"

EQUIPMENT:-

3-18 CWT. STOCKLESS ANCHORS.
210 FATHS. 1 5/16" STUD LINK CABLE
90 FATHS. 3" 6/12 F.S.W.R. TOWLINE.
270 FATHS. 4" MANILLA MOORING LINE.

170 (36 + 15.5) + .85 x 170 (17-15.5)	8872
MAIN DECKHOUSE .75 (7.5 x 43.5)	245
UPPER DECKHOUSE .75 (7.5 x 12.5)	70
WALKWAY .75 (7.5 x 74)	416
EQUIPMENT NUMBER	9603
EQUIPMENT LETTER	k

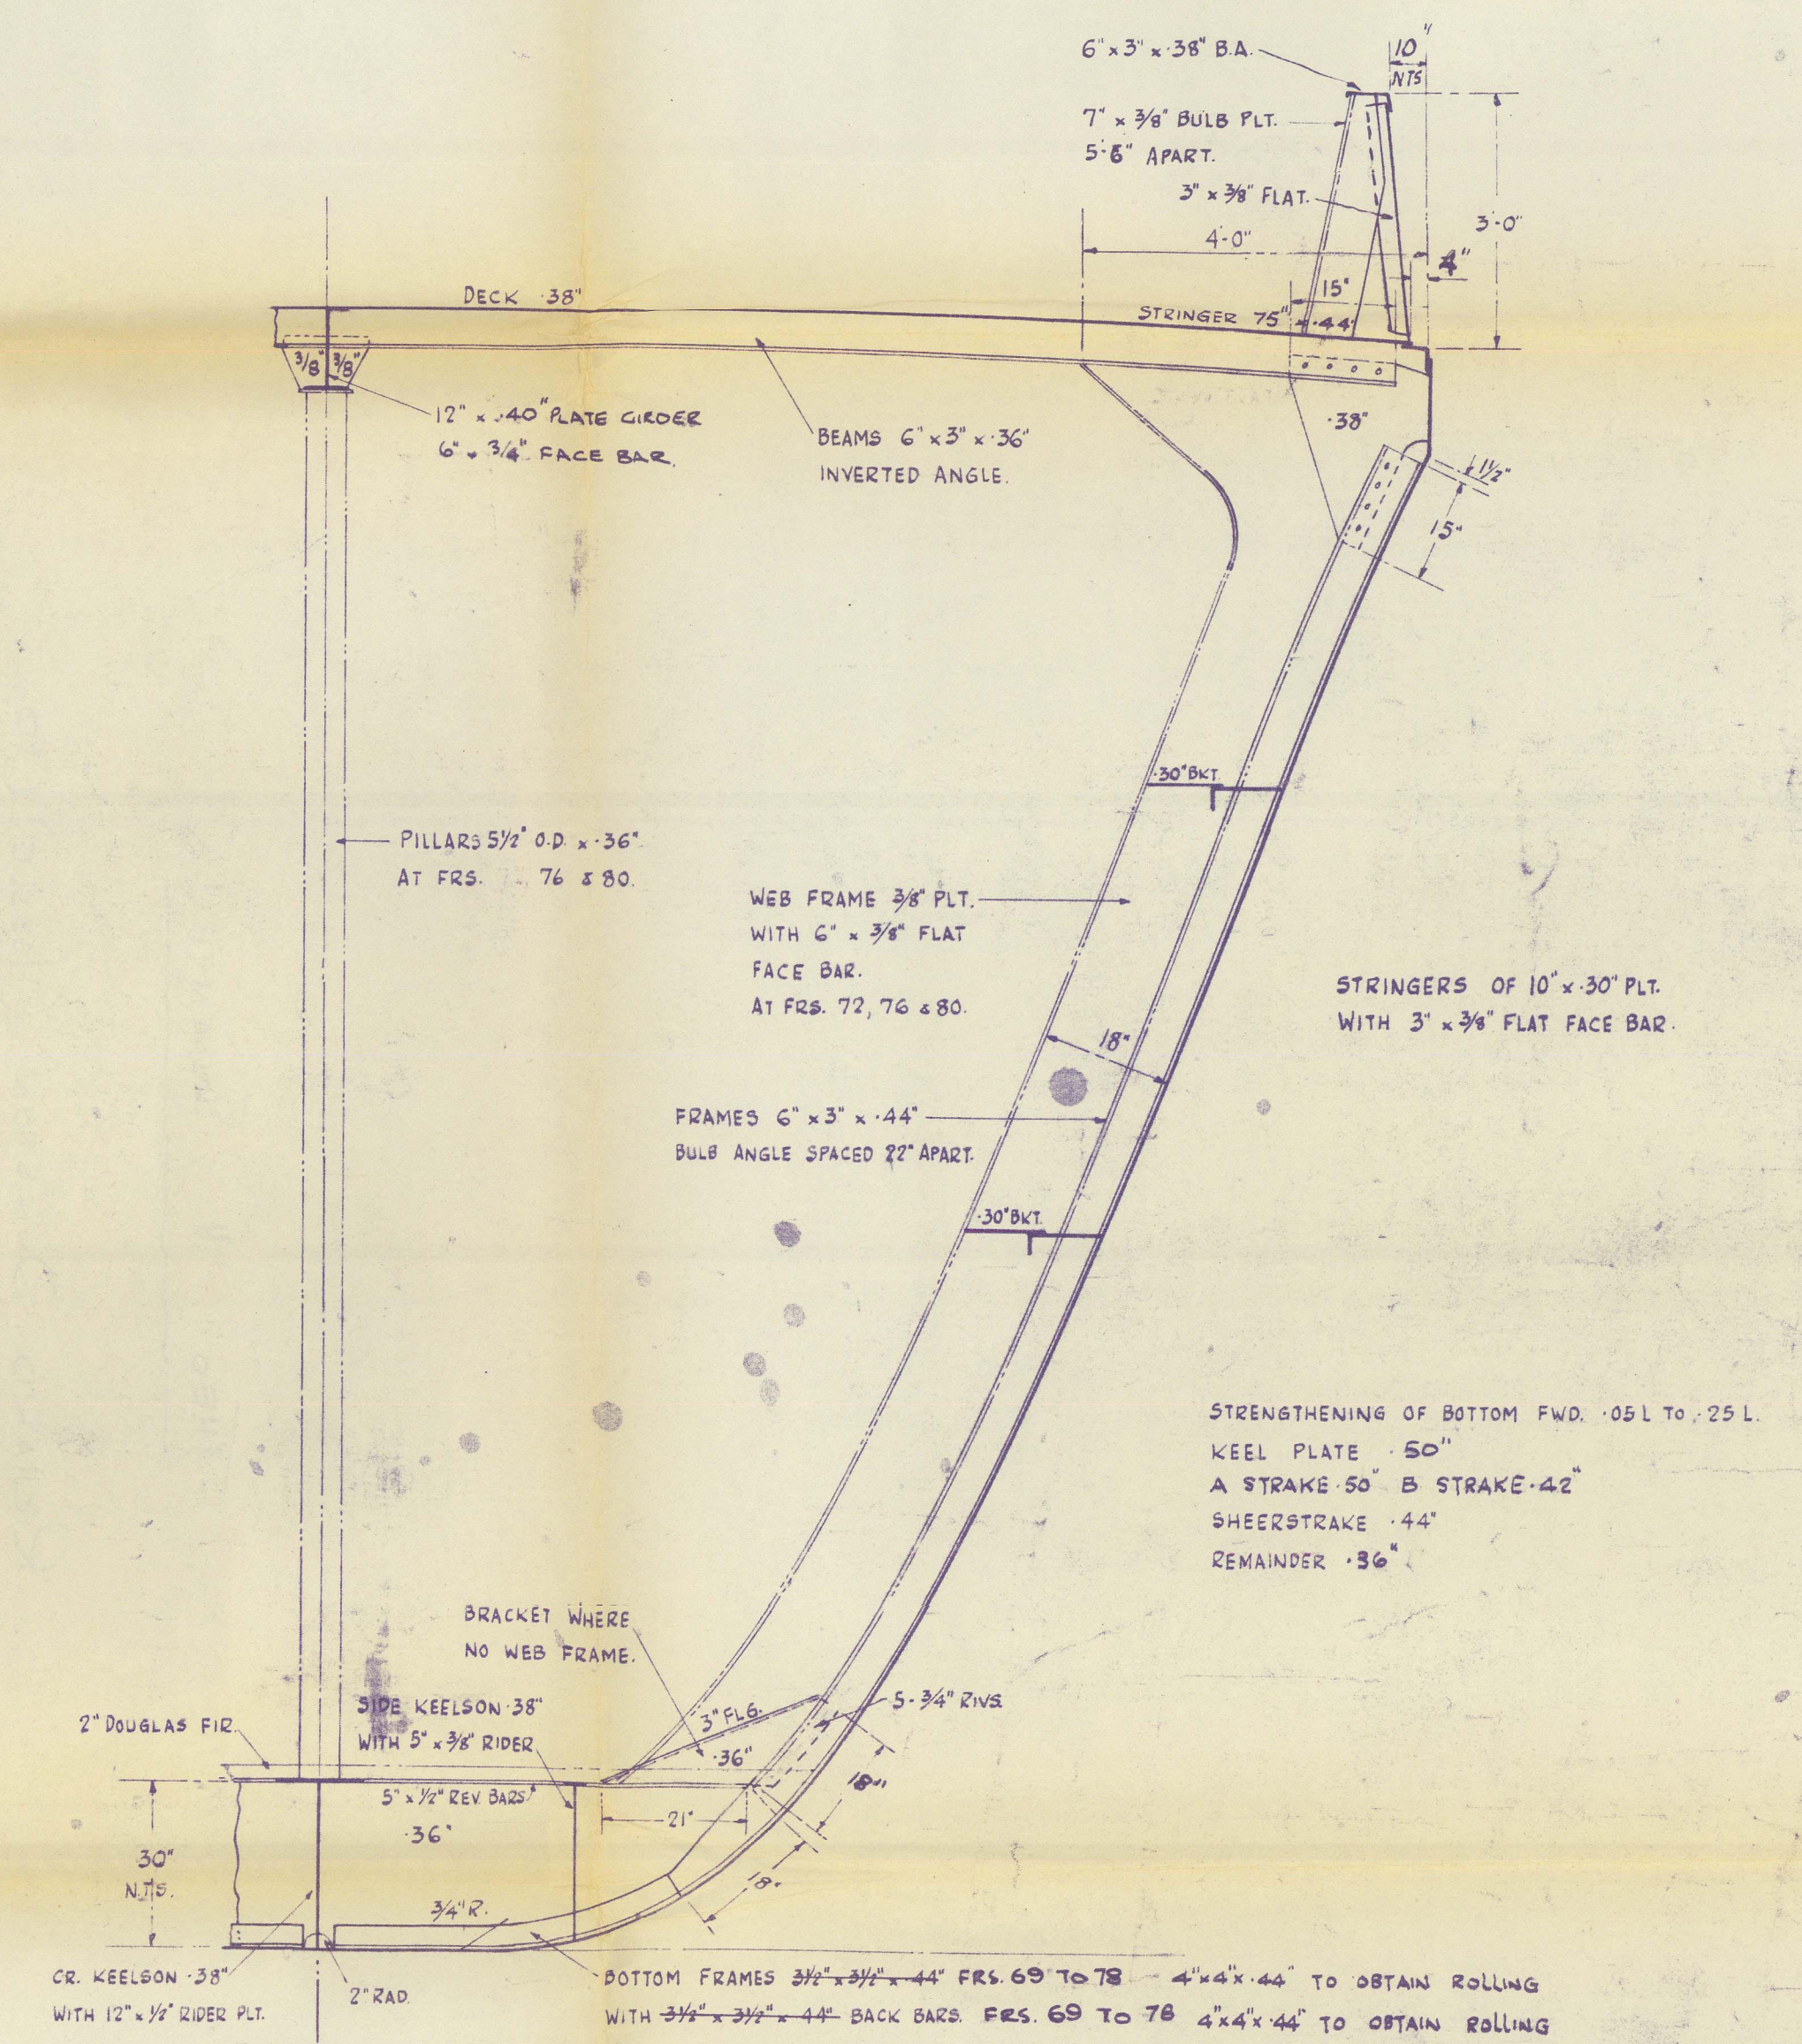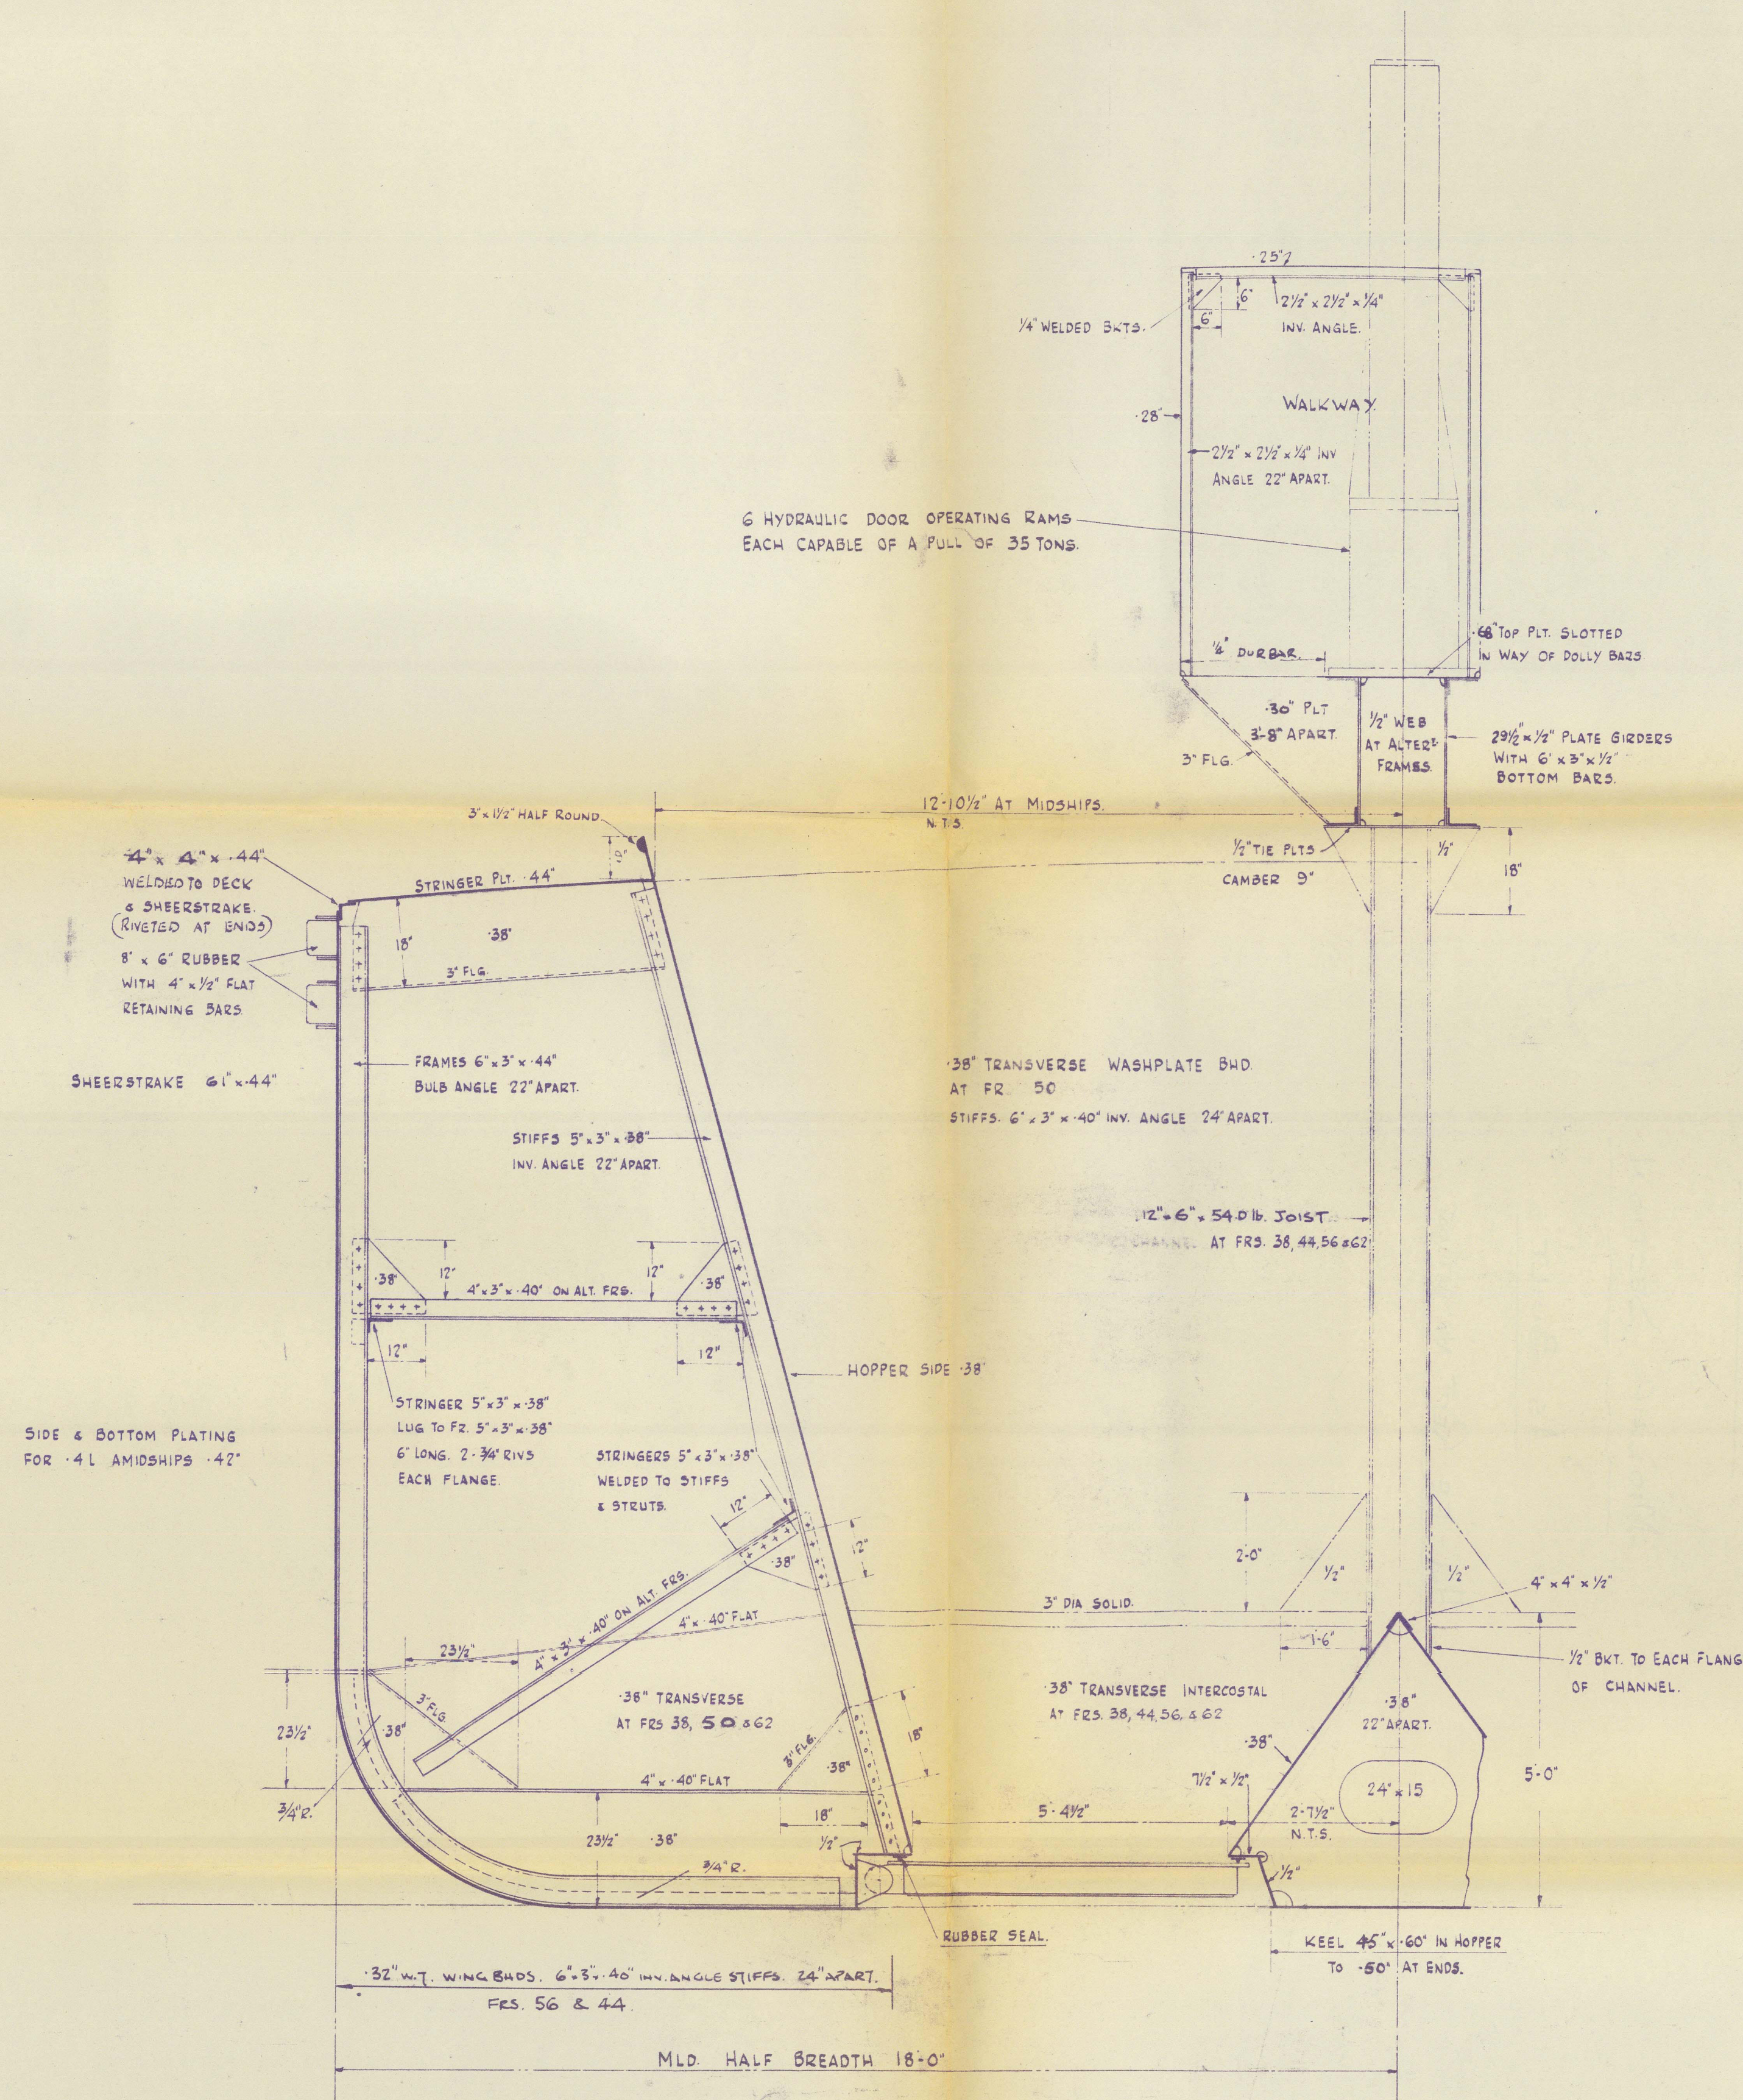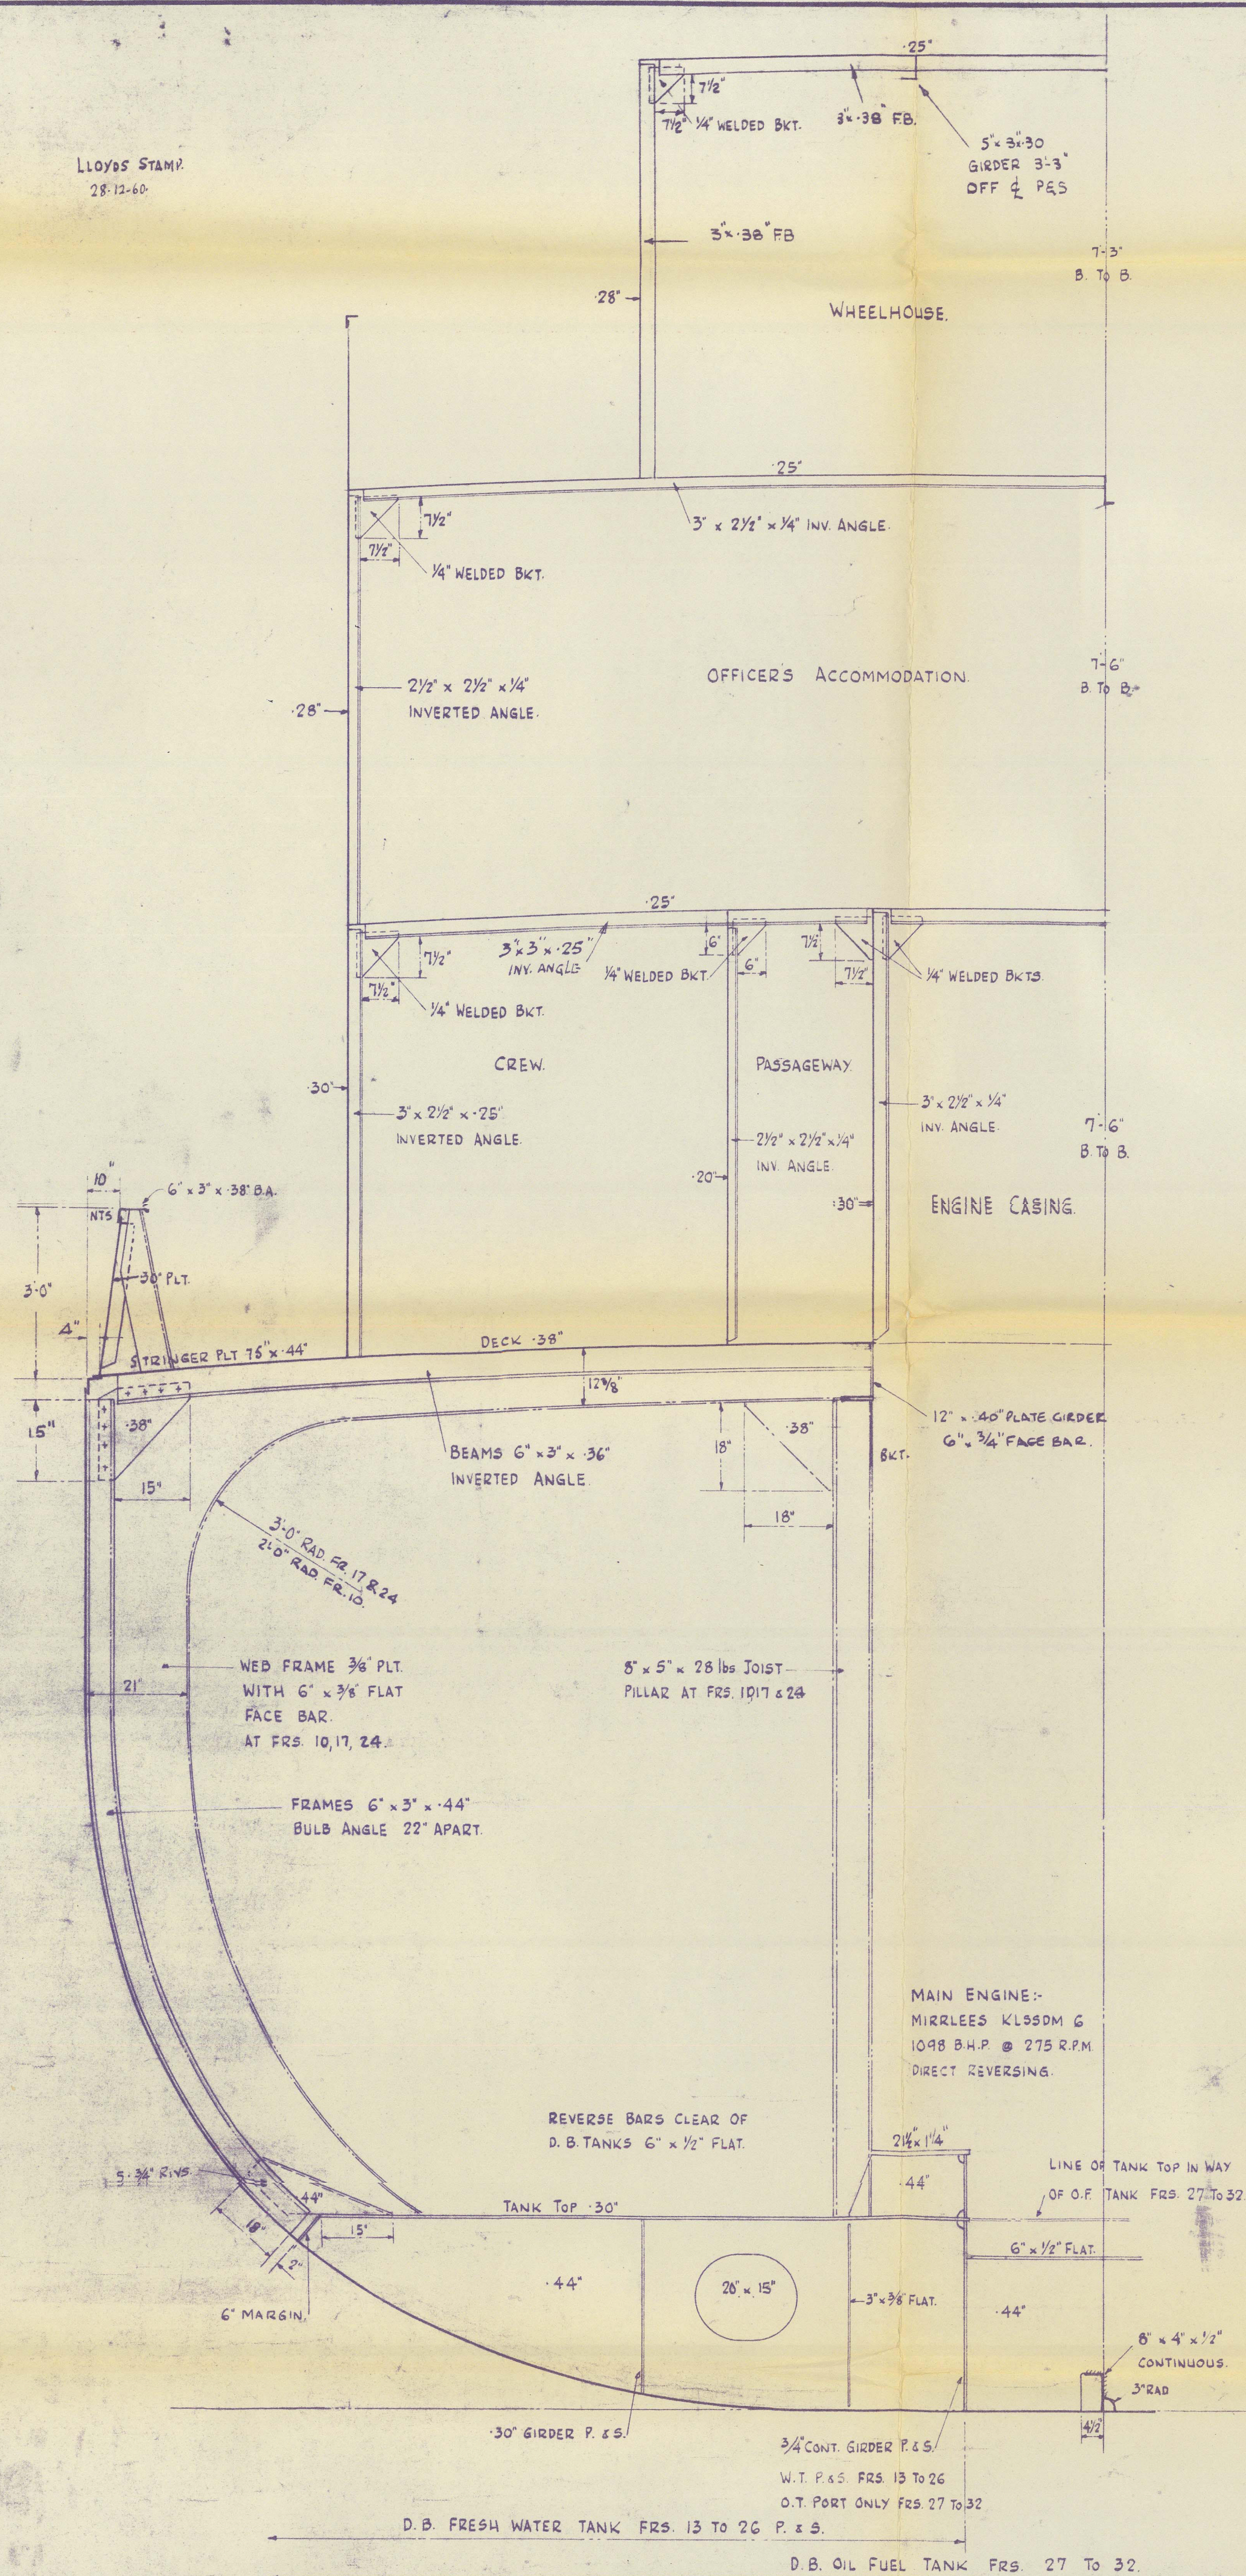

APPROVED BY LLOYD'S 28-12-60			APPROVED BY OWNERS 21-2-61																																
<table border="1"> <tr> <th colspan="3">REVISIONS</th> </tr> <tr> <th>NO.</th> <th>DATE</th> <th>PARTICULARS</th> </tr> <tr> <td>A</td> <td>1-12-60</td> <td>MARGIN IN 12.28.65S TWO INCREASED TO 3.0" AS REQUESTED BY HULLER IN 3094</td> </tr> <tr> <td>B</td> <td>2-1-61</td> <td>MODIFIED FOR LLOYD'S PLAN</td> </tr> <tr> <td>C</td> <td>3-1-61</td> <td>MODIFIED FOR WORKING DRAWING</td> </tr> <tr> <td>D</td> <td>10-2-61</td> <td>BULKHEAD LARGELY IN LINE WITH LLOYD'S LETTER 21-2-61</td> </tr> </table>			REVISIONS			NO.	DATE	PARTICULARS	A	1-12-60	MARGIN IN 12.28.65S TWO INCREASED TO 3.0" AS REQUESTED BY HULLER IN 3094	B	2-1-61	MODIFIED FOR LLOYD'S PLAN	C	3-1-61	MODIFIED FOR WORKING DRAWING	D	10-2-61	BULKHEAD LARGELY IN LINE WITH LLOYD'S LETTER 21-2-61	<table border="1"> <tr> <td>DRAWN BY</td> <td>DATE</td> </tr> <tr> <td>28-11-60</td> <td></td> </tr> <tr> <td>TRACED BY</td> <td>DATE</td> </tr> <tr> <td></td> <td></td> </tr> <tr> <td>CHECKED BY</td> <td>DATE</td> </tr> <tr> <td></td> <td></td> </tr> </table>			DRAWN BY	DATE	28-11-60		TRACED BY	DATE			CHECKED BY	DATE		
REVISIONS																																			
NO.	DATE	PARTICULARS																																	
A	1-12-60	MARGIN IN 12.28.65S TWO INCREASED TO 3.0" AS REQUESTED BY HULLER IN 3094																																	
B	2-1-61	MODIFIED FOR LLOYD'S PLAN																																	
C	3-1-61	MODIFIED FOR WORKING DRAWING																																	
D	10-2-61	BULKHEAD LARGELY IN LINE WITH LLOYD'S LETTER 21-2-61																																	
DRAWN BY	DATE																																		
28-11-60																																			
TRACED BY	DATE																																		
CHECKED BY	DATE																																		
<p>RICHARD DUNSTON LTD. SHIPBUILDERS, THORNE, YORKSHIRE.</p>																																			
<p>This Drawing and the Information it contains are the Property of RICHARD DUNSTON LTD. It is not to be Traced, Copied or Published without their Written Consent, nor is the Information thereon to be misused in any way.</p>																																			
YARD No 5. 780/1			DRG. No 5705/2																																
TITLE:- MIDSHIP SECTION 'AS BUILT'																																			
SCALE:- 1/2" TO ONE FOOT																																			


THEO . H. SWANTON. ★

RICHARD DUNSTON (HESSE) LTD.

YARD No 781

RECORDS DEPT.,
LONDON.

MIDSHIP SECTION

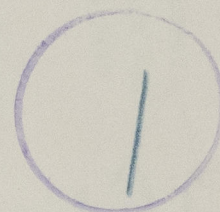

"AS BUILT"

HUL. F.R. REPT. NO 67905



© 2021

Lloyd's Register
Foundation

012102-012107-0105