

SINGLE SCREW DIESEL TUG
LLOYDS CLASSIFICATION - AI "TUG" "RIVER THAMES SERVICE"

DIMENSIONS :-

LENGTH B.P. 76'-0"
BREADTH MLD. 20'-3 1/2"
DEPTH MLD. 10'-6"
DRAFT EXT. 10'-0"

APPROVED BY LLOYDS 31.7.63

NUMERALS :-

L = 76'0" B = 20'2 1/2" D = 10'5"

EQUIPMENT NUMBER 2332


EQUIPMENT

LLOYDS MINIMUM
FOR RIVER THAMES
SERVICE

1-2 1/2 CWT. STOCKLESS BOWER ANCHORS.
3-15 FATHOMS 1 1/16" DIA STUD LINK CHAIN CABLE
15 FATHOMS 5" CIRC. SISAL MOORING ROPE
15 FATHOMS 2 3/4" CIRC. SISAL MOORING ROPE.

NOTES :

SHELL PLATING .38" THK. SHEERSTRAKE .50" THK.
SHELL BUTTS WELDED.
ALL BULKHEADS TO HAVE BOUNDARY BARS RIVETED
TO SHELL PLATING. BARS MAY BE WELDED TO BULKHEAD.
SHELL SEAMS TO BE RIVETED.

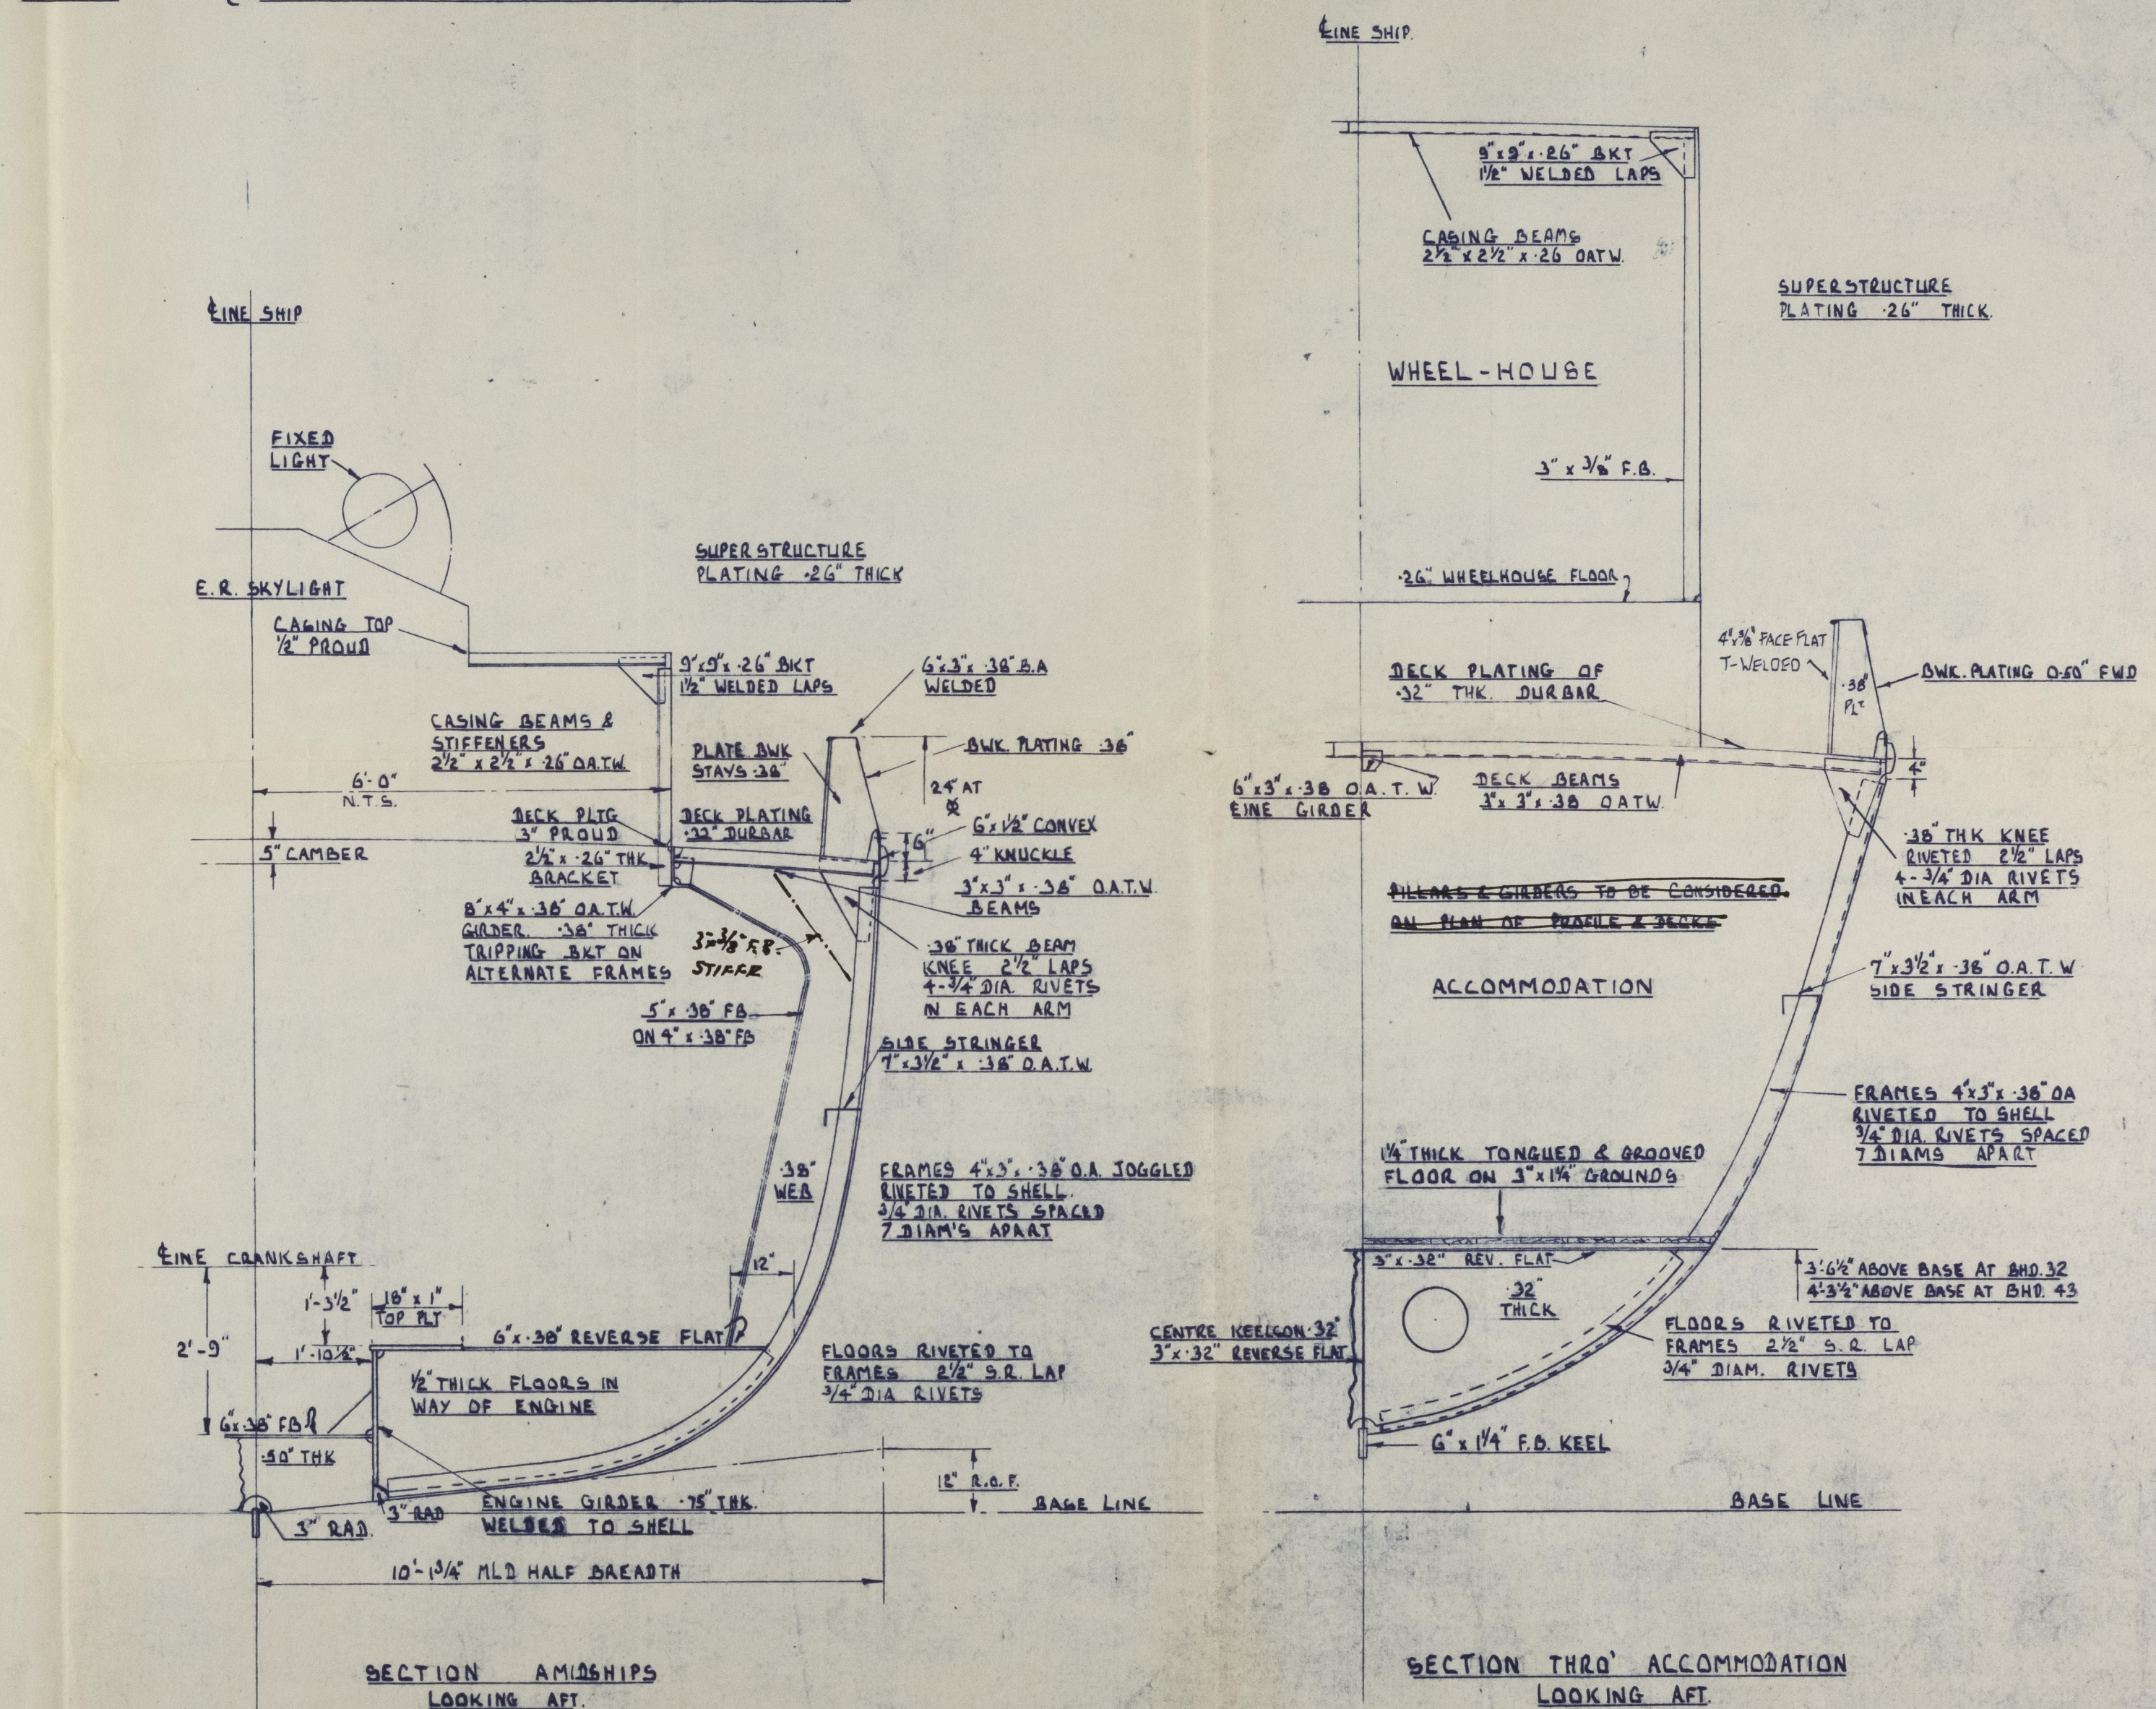

RICHARD DUNSTON (HESSLE) LTD.
SHIPBUILDERS,
HESSLE, YORKSHIRE.

DRAWN BY C.A. DATE 26.7.63

TRACED BY DATE

CHECKED BY DATE

REVISIONS

No.	DATE	PARTICULARS
A	23.8.63	MODIFIED FOR HESSLE MEMO OF 22.8.63

This Drawing and the Information it contains are the Property of RICHARD DUNSTON LTD.
It is not to be Traced, Copied or Published without their Written Consent, nor is the Information
thereon to be misused in any way.

TITLE :- STRUCTURAL SECTIONS "AS BUILT"

SCALE :- 1/2" TO ONE FOOT.

YARD No. T.1143

DRG. No. 7048/24

012108-012112-0165

24

"FRISTON DOWN" ★

R. DUNSTON LTD.

SHIP NO T1143.

STRUCTURAL SECTIONS (AS BUILT)

HVL. F.E. REPT. NO. 70160

RECORDS DEPT.
LONDON.

3

This plan has been verified with the approved plans, and includes any modifications and/or additions to the original approved arrangements made during construction which have been approved locally as being in accordance with or equivalent to Rule requirements.

Signature

Surveyor(s) to Lloyd's Register of Shipping

Date

10/12/64

Lloyd's Register
Foundation

012108-012112-0165