

LLOYDS STAMP  
28-12-60

MELBOURNE HARBOR TRUST COMMISSIONERS.  
SINGLE SCREW DIESEL HOPPER BARGES.  
CLASSIFICATION: LLOYDS + 100 A. I. HOPPER BARGE.  
DIMENSIONS: 170'-0" B.P. x 36'-0" MLD. x 17'-0" MLD.  
*169' 7" to top side of keel (see note)*

LLOYDS NOTE:  
THE SCANTLING AS SHOWN ARE SUITABLE FOR A SUMMER  
DRAUGHT OF 15'-6" MEASURED ABOVE TOP OF KEEL.




# NUMERALS

L	170'-0"
B	36'-0"
D	17'-0"
d (MLD. S.W.) APPROX.	15'-5"
h	15'-0"

# EQUIPMENT:-

3-18 CWT. STOCKLESS ANCHORS.  
210 FATHS. 1 1/2" STUD LINK CABLE  
90 FATHS. 3" 6/12 F.S.W.R. TOWLINE  
270 FATHS. 4" MANILLA MOORING LINE.

170 (36+15.5) + .85 x 170 (17-15.5)	8872
MAIN DECKHOUSE	.75 (7.5 x 43.5)
UPPER DECKHOUSE	.75 (7.5 x 12.5)
WALKWAY	.75 (7.5 x 74)
EQUIPMENT NUMBER	9603
EQUIPMENT LETTER	k

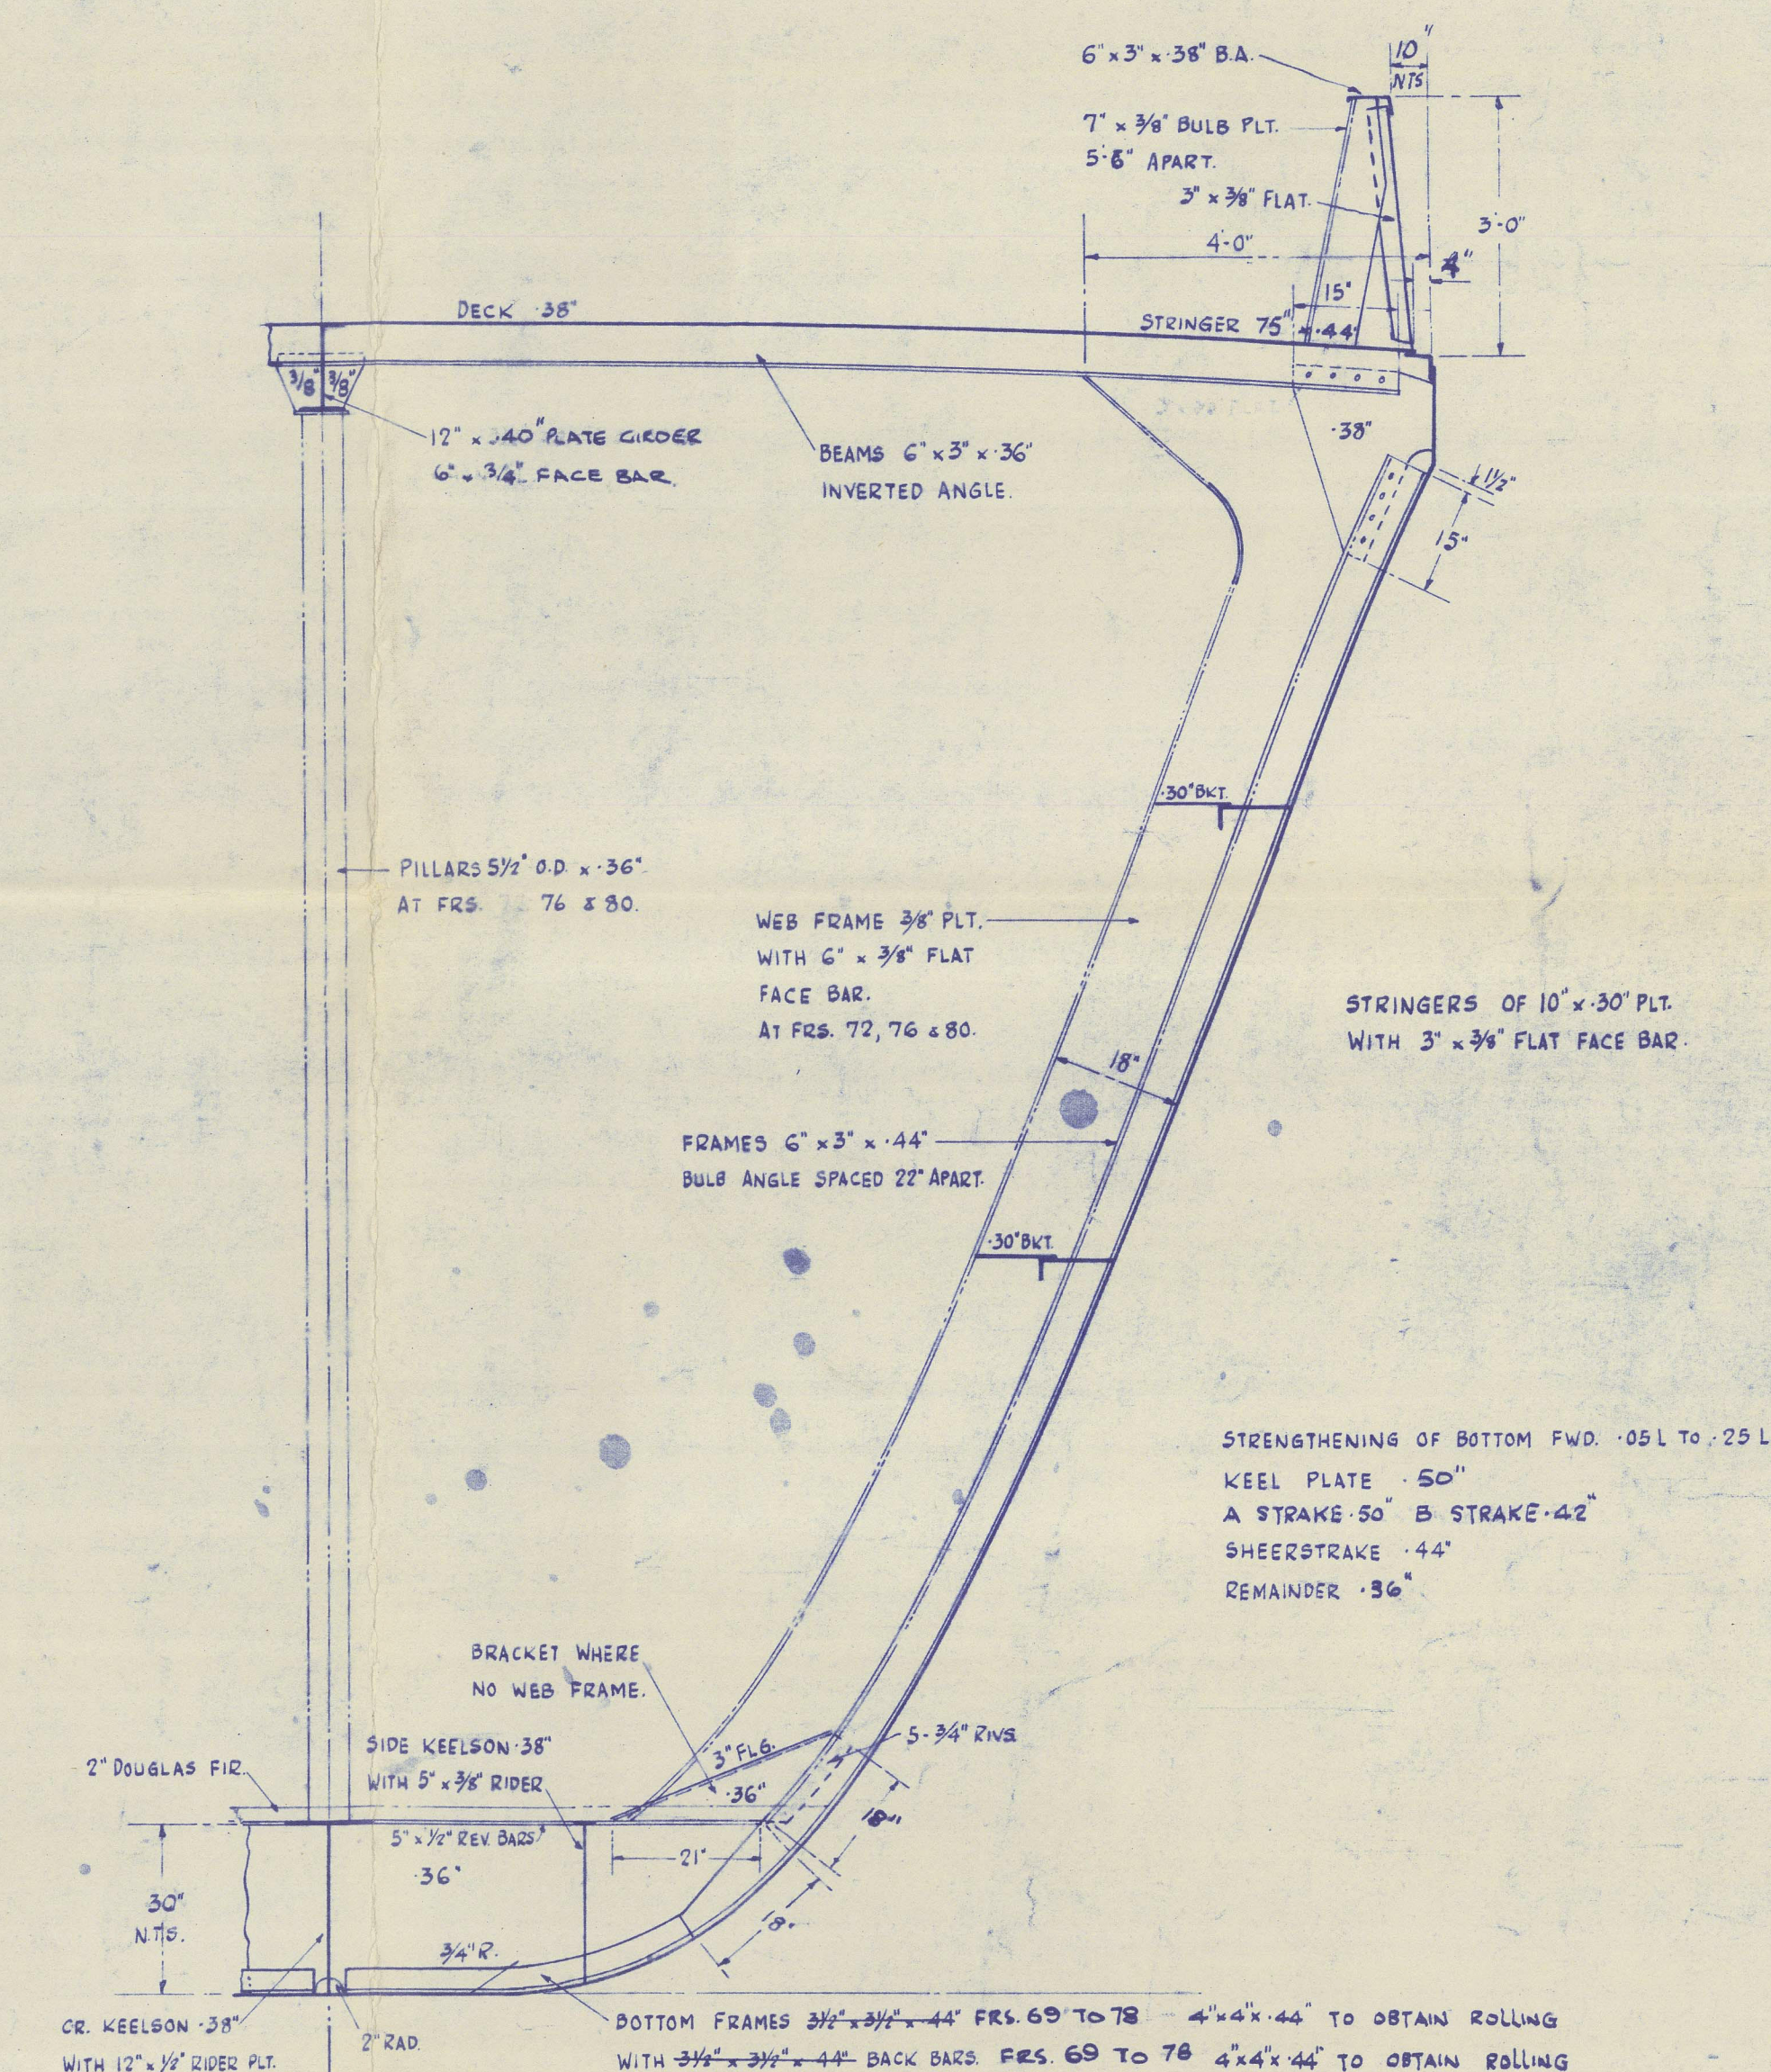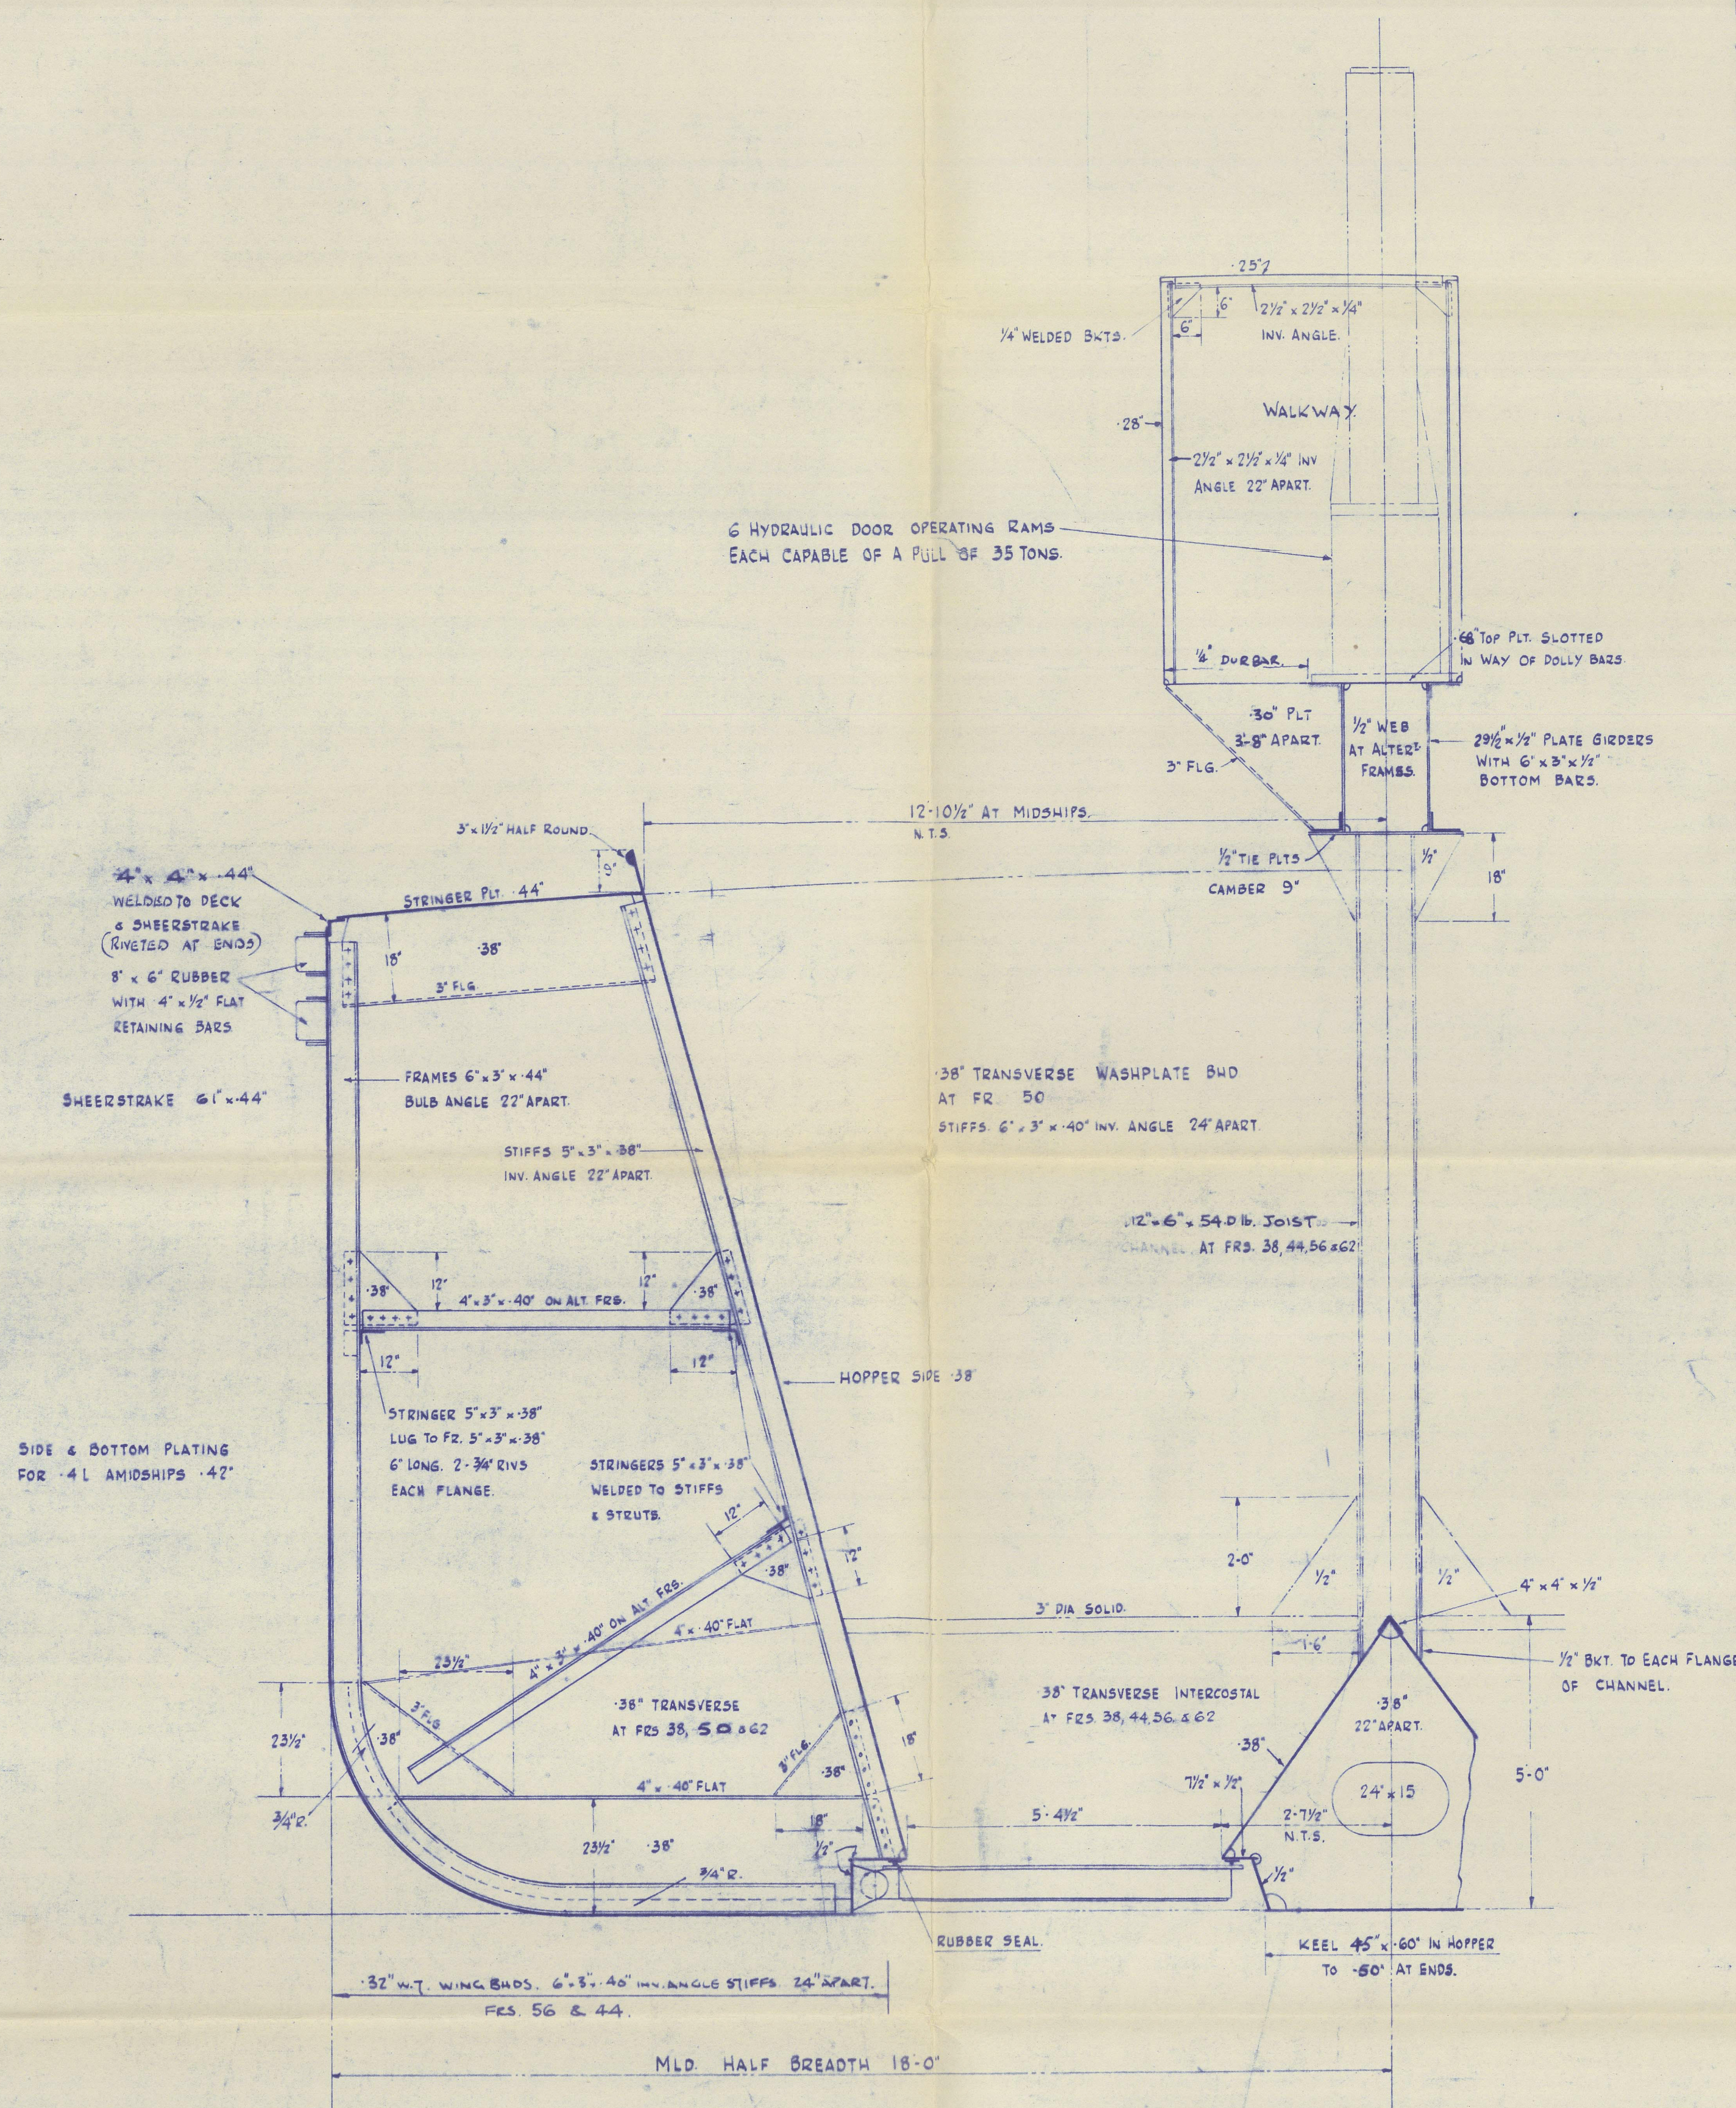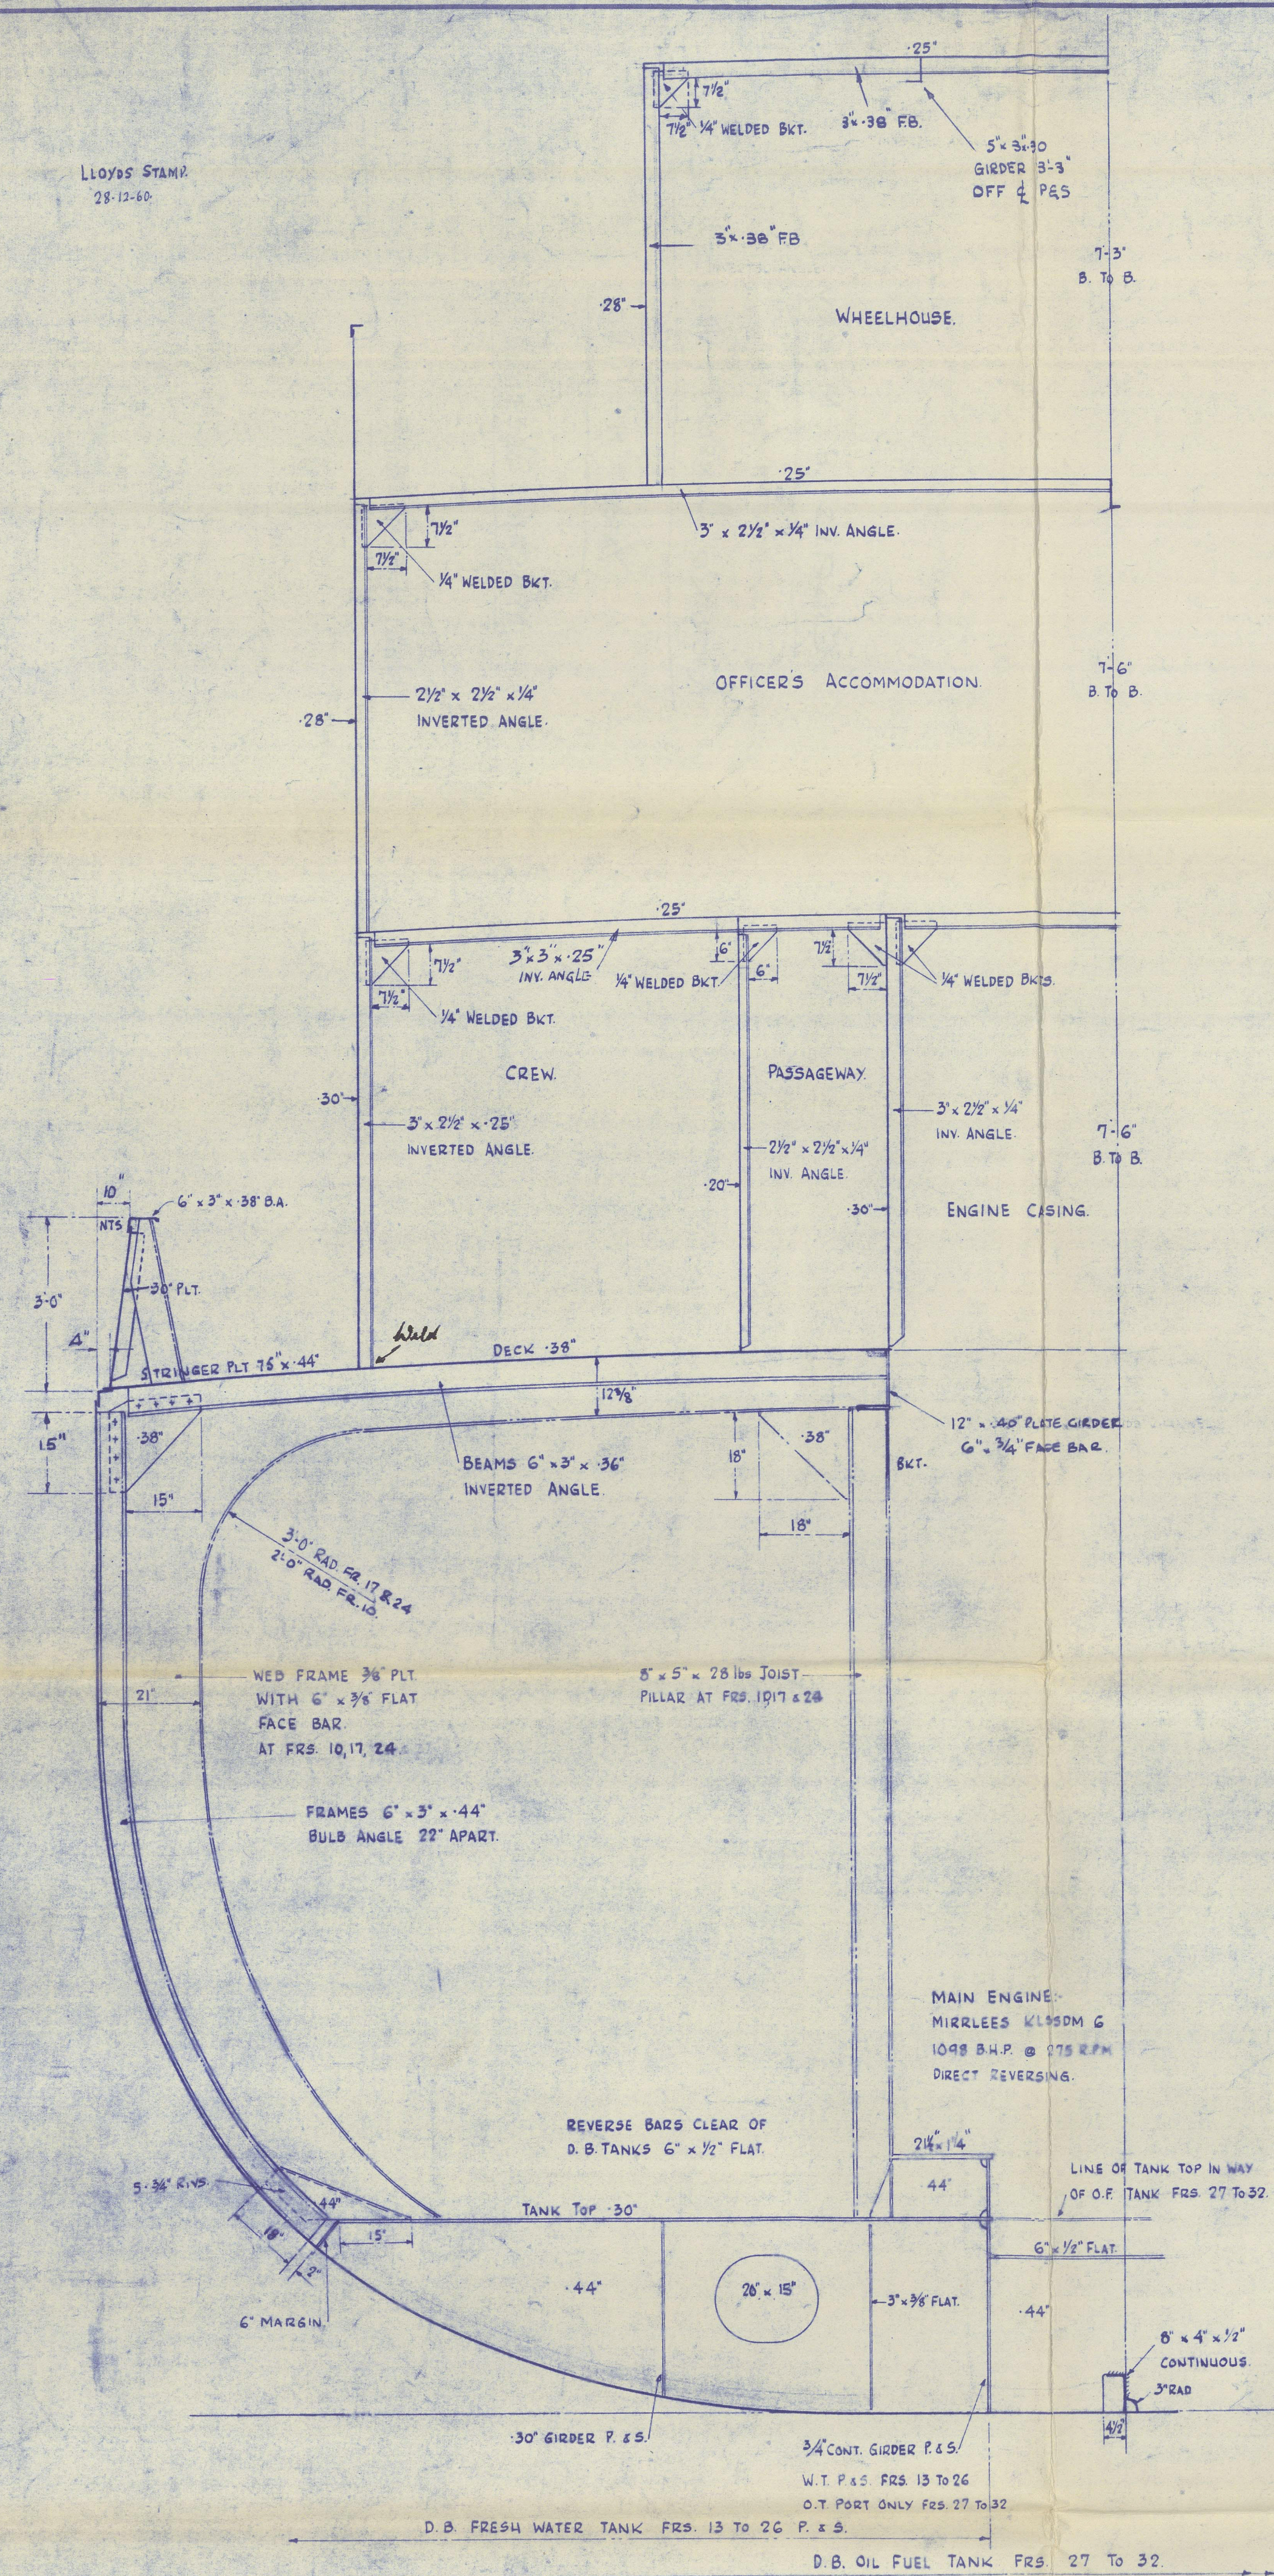

APPROVED BY LLOYDS 28-12-60

APPROVED BY OWNERS 21-2-61

REVISIONS			DRAWN BY <i>896/4</i>	
LYR	DATE	PARTICULARS	DATE	29-11-60
A	7-12-60	MANHOLE IN 50' DIA. TANK FWD INCREASED TO 30" AS SUGGESTED BY HESLOUGH 30/10/60	TRACED BY	
B	2-1-61	NOTIFIED PER LLOYDS PLAN	DATE	
C	13-2-61	MANHOLE RE. MANHOLE THROUGHS	CHECKED BY	
D	20-2-61	QUANTITY LUKALY HANG 10" OWNERS LETTER 21-2-61	DATE	

**RICHARD DUNSTON LTD.**  
SHIPBUILDERS,  
THORNE, YORKSHIRE.

This Drawing and the Information it contains are the Property of RICHARD DUNSTON LTD. It is not to be Traced, Copied or Published without their Written Consent, nor is the Information thereon to be misused in any way.

YARD N <sup>o</sup> 5. 780/1	DRG. N <sup>o</sup> 5705/2 D
TITLE: MIDSHIP SECTION 'AS BUILT'	
SCALE: 1/8" TO ONE FOOT.	



"CHARLES H. MCKAY"



RICHARD DUNSTON (HESSLE) LTD.

YARD NO 780

MIDSHIP SECTION ("AS BUILT")

HUL. F.E. REPORT NO. 67706.

RECORDS DEPT.,  
LONDON.

2



© 2021

Lloyd's Register  
Foundation

012129-012141-0017