

DRAWING No 243/2.  
MOTOR TRAWLER 'MUKSUN'.  
STRUCTURAL SECTIONS.

SCALE:- 1/2" = 1 FOOT & AS MARKED.

CLASS:- LLOYDS 100 A.I. MOTOR TRAWLER.

STRENGTHENED FOR NAVIGATION IN ICE.





DIMENSIONS

LENGTH B.P. 171'-9"  
BEAM MOULDED. 32'-0"  
DEPTH MOULDED. 16'-6"  
RULE DEPTH. 15.75'

LLOYDS NUMERALS:-  $L \times D = 2705$ .  $L \times (B + D) = 8201$ .

EQUIPMENT, LETTER '0'


1 ANCHOR, 13 CWT. STOCKLESS.  
1 ANCHOR, 12 CWT. STOCKLESS.  
1 ANCHOR, 4 1/2 CWT. EX-STOCK.  
300 METRES 1 1/2 DIA. STUD LINK CHAIN CABLE.  
60 FATHOMS 6" CIRC. HEMP HAWP.  
60 FATHOMS 6" CIRC. HEMP WARP.

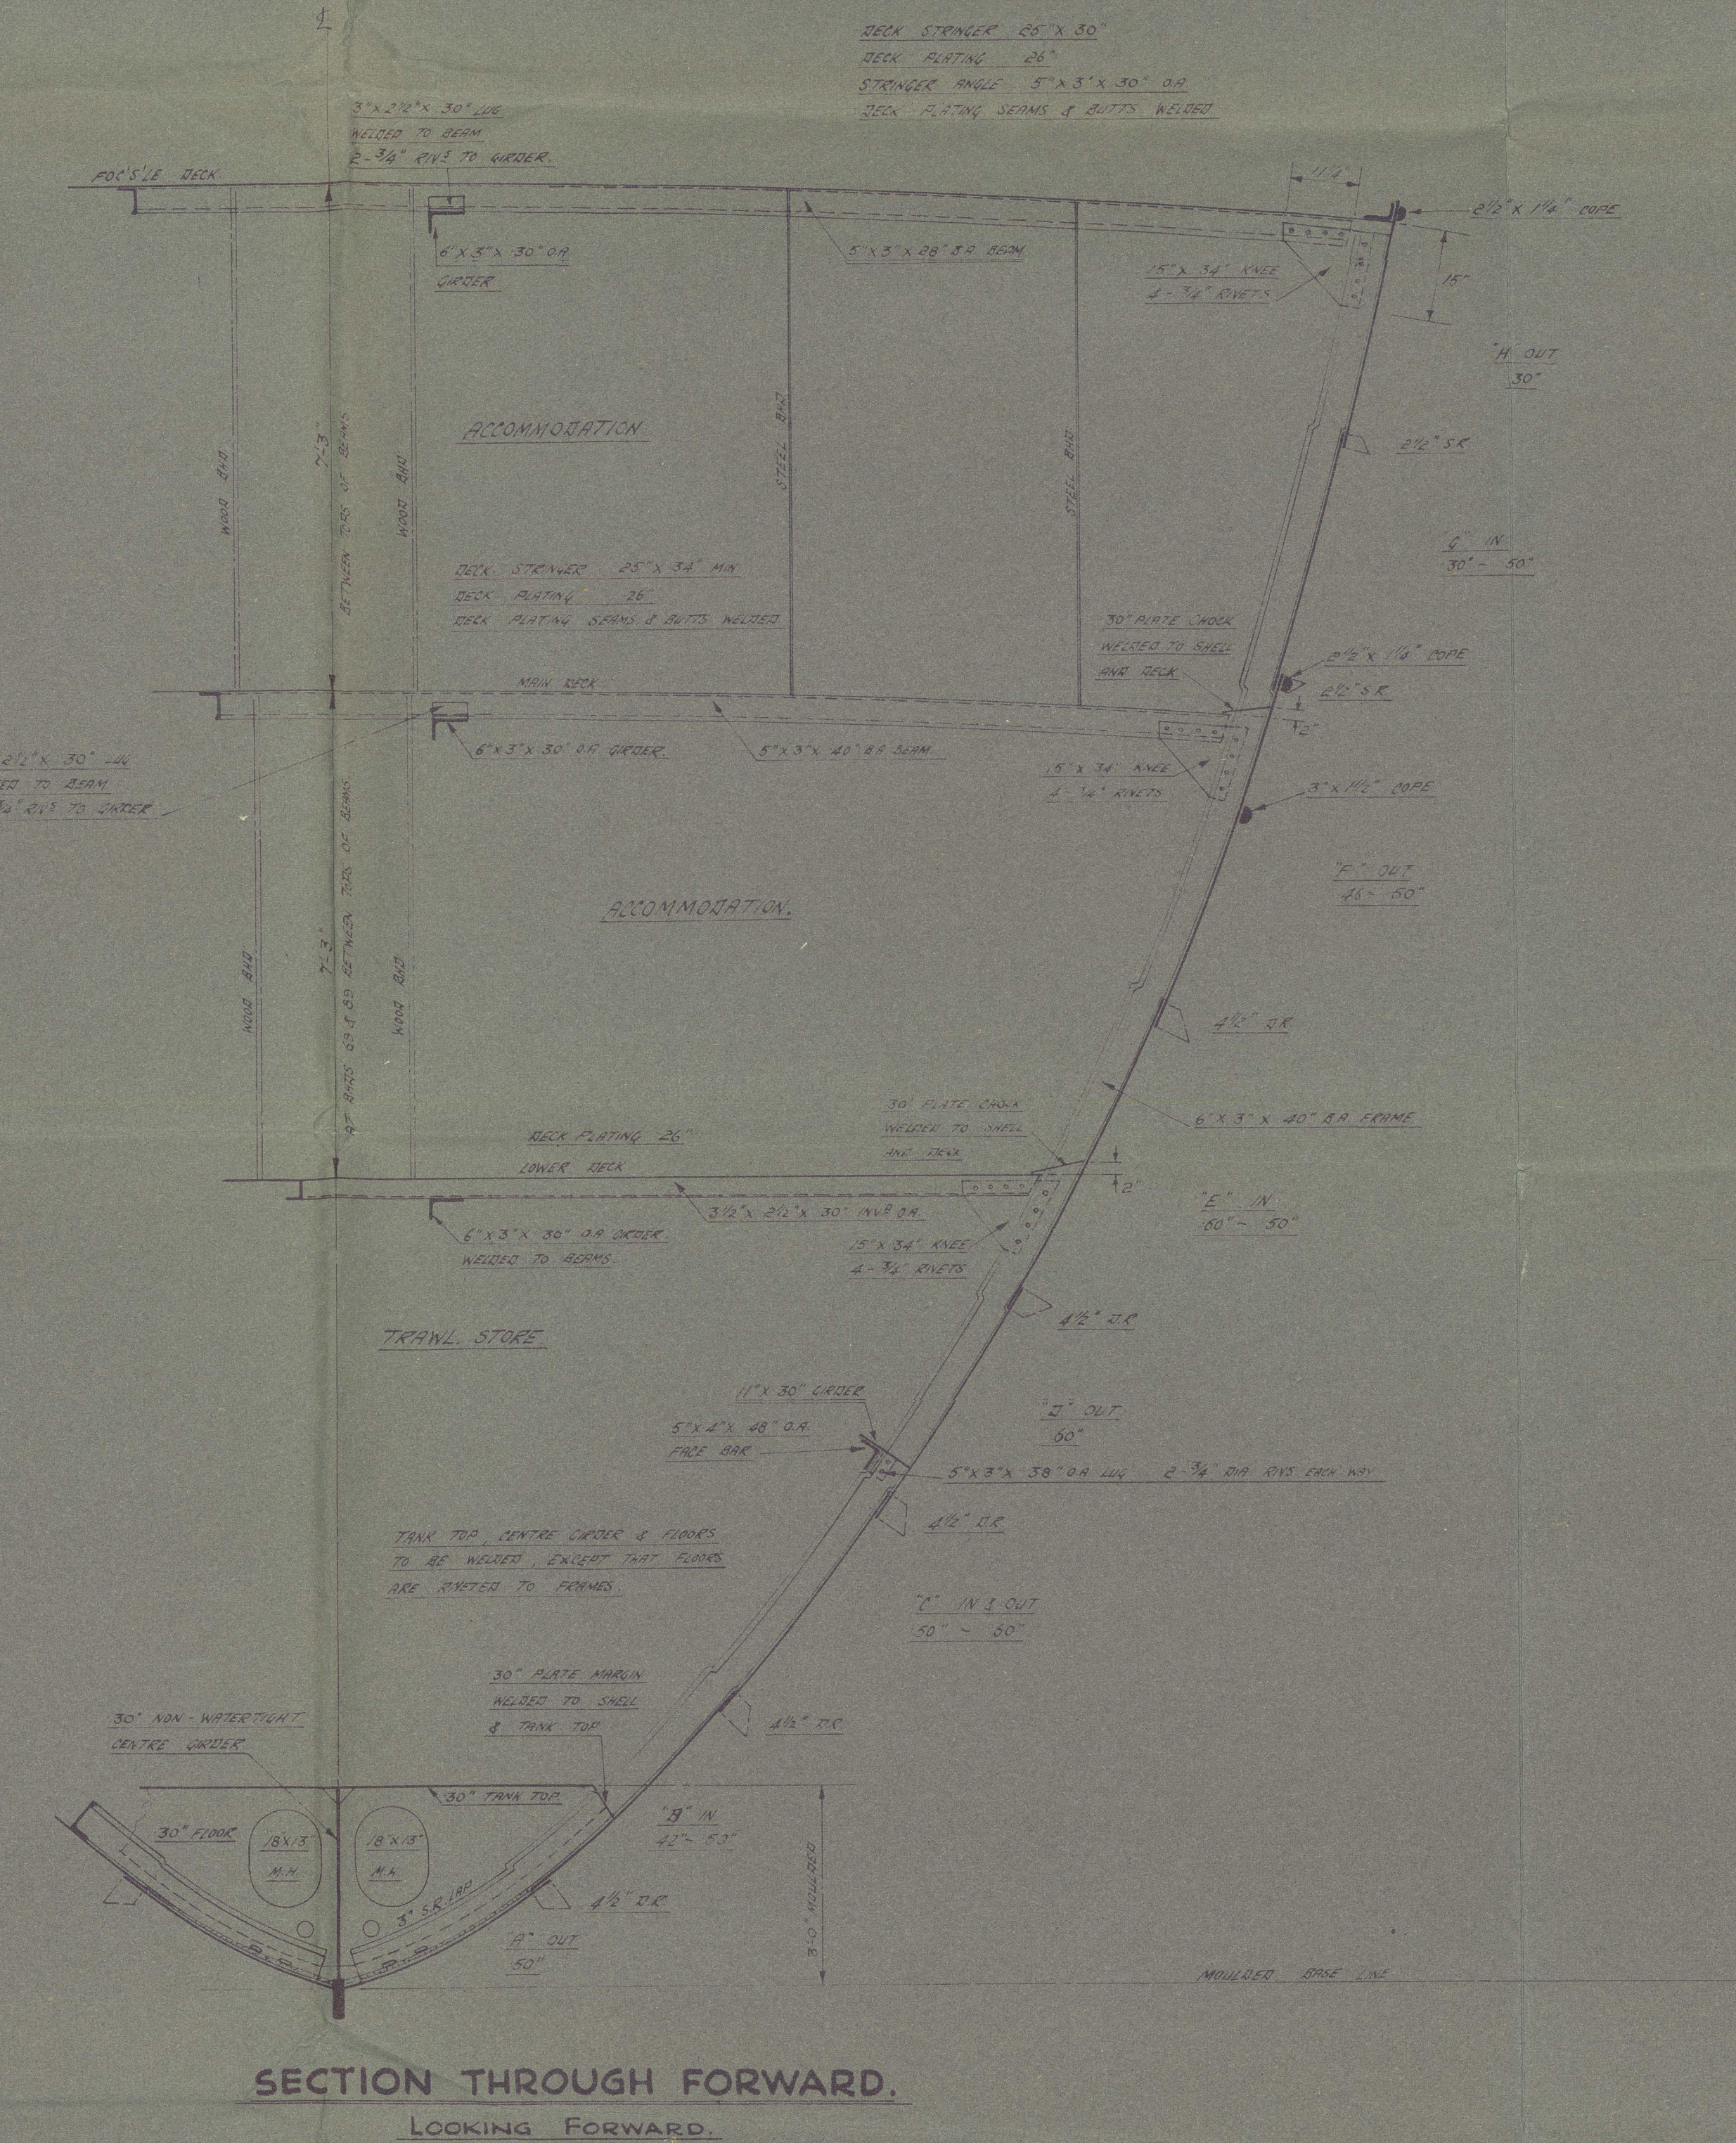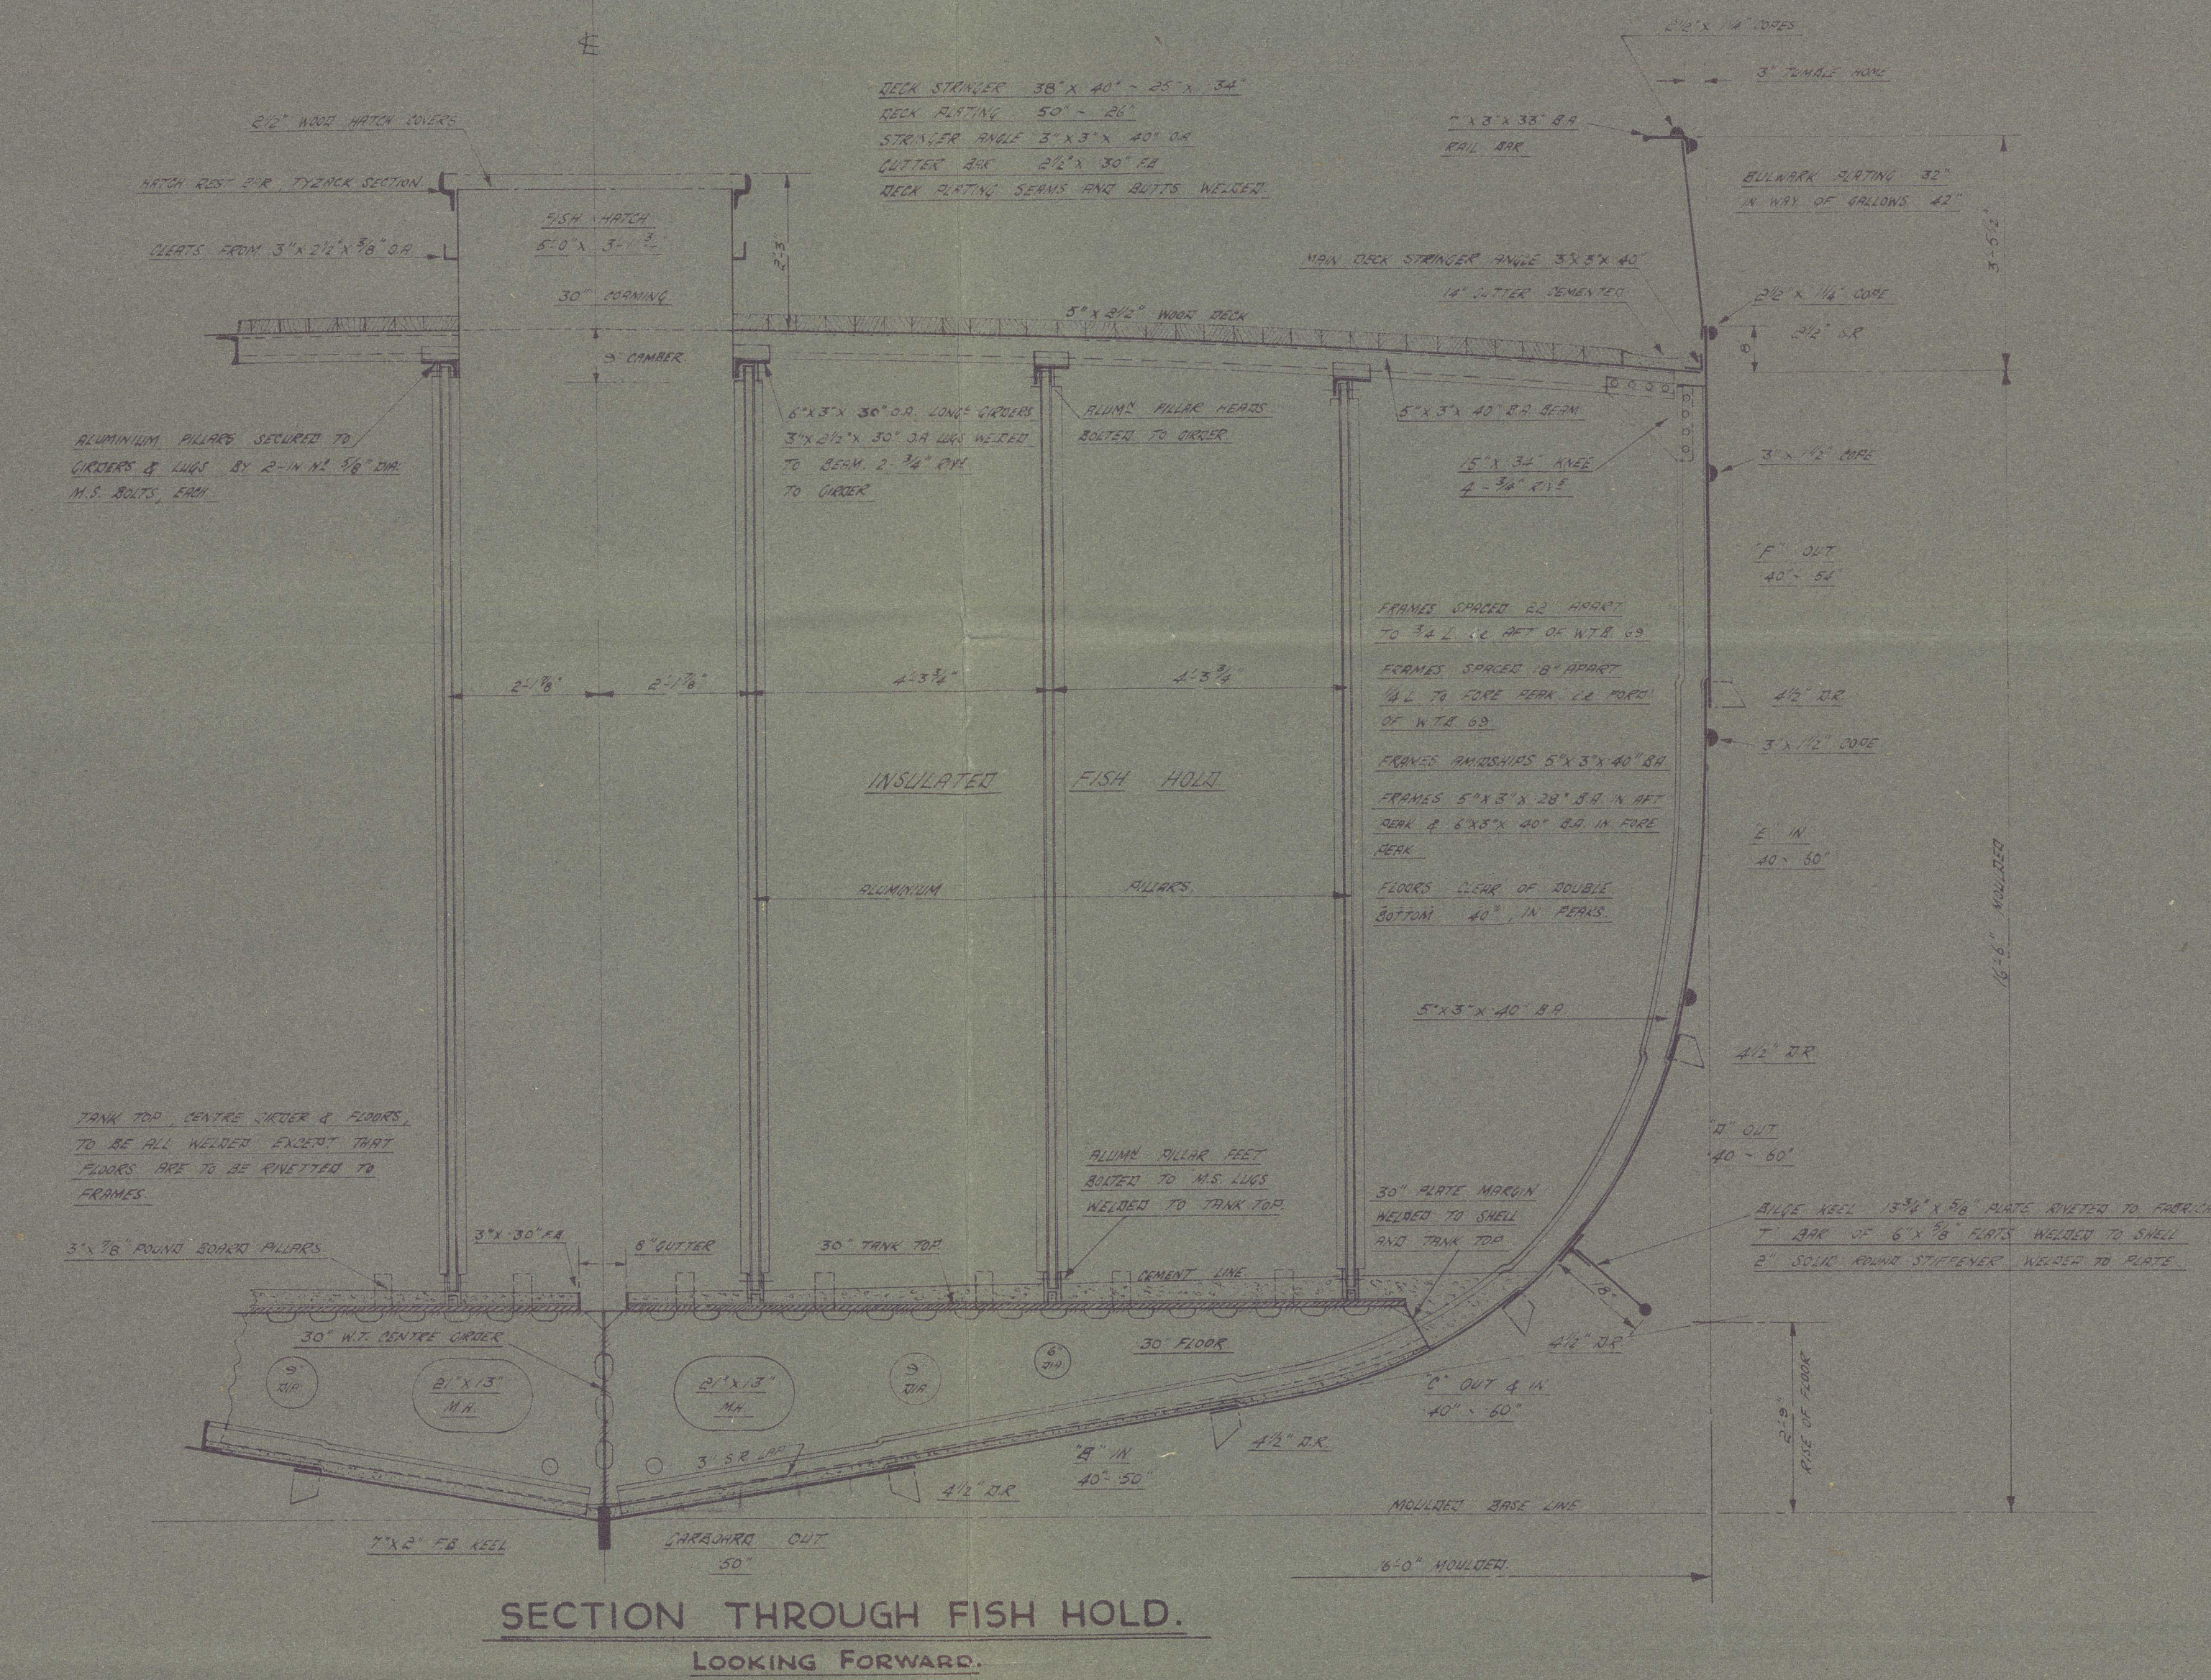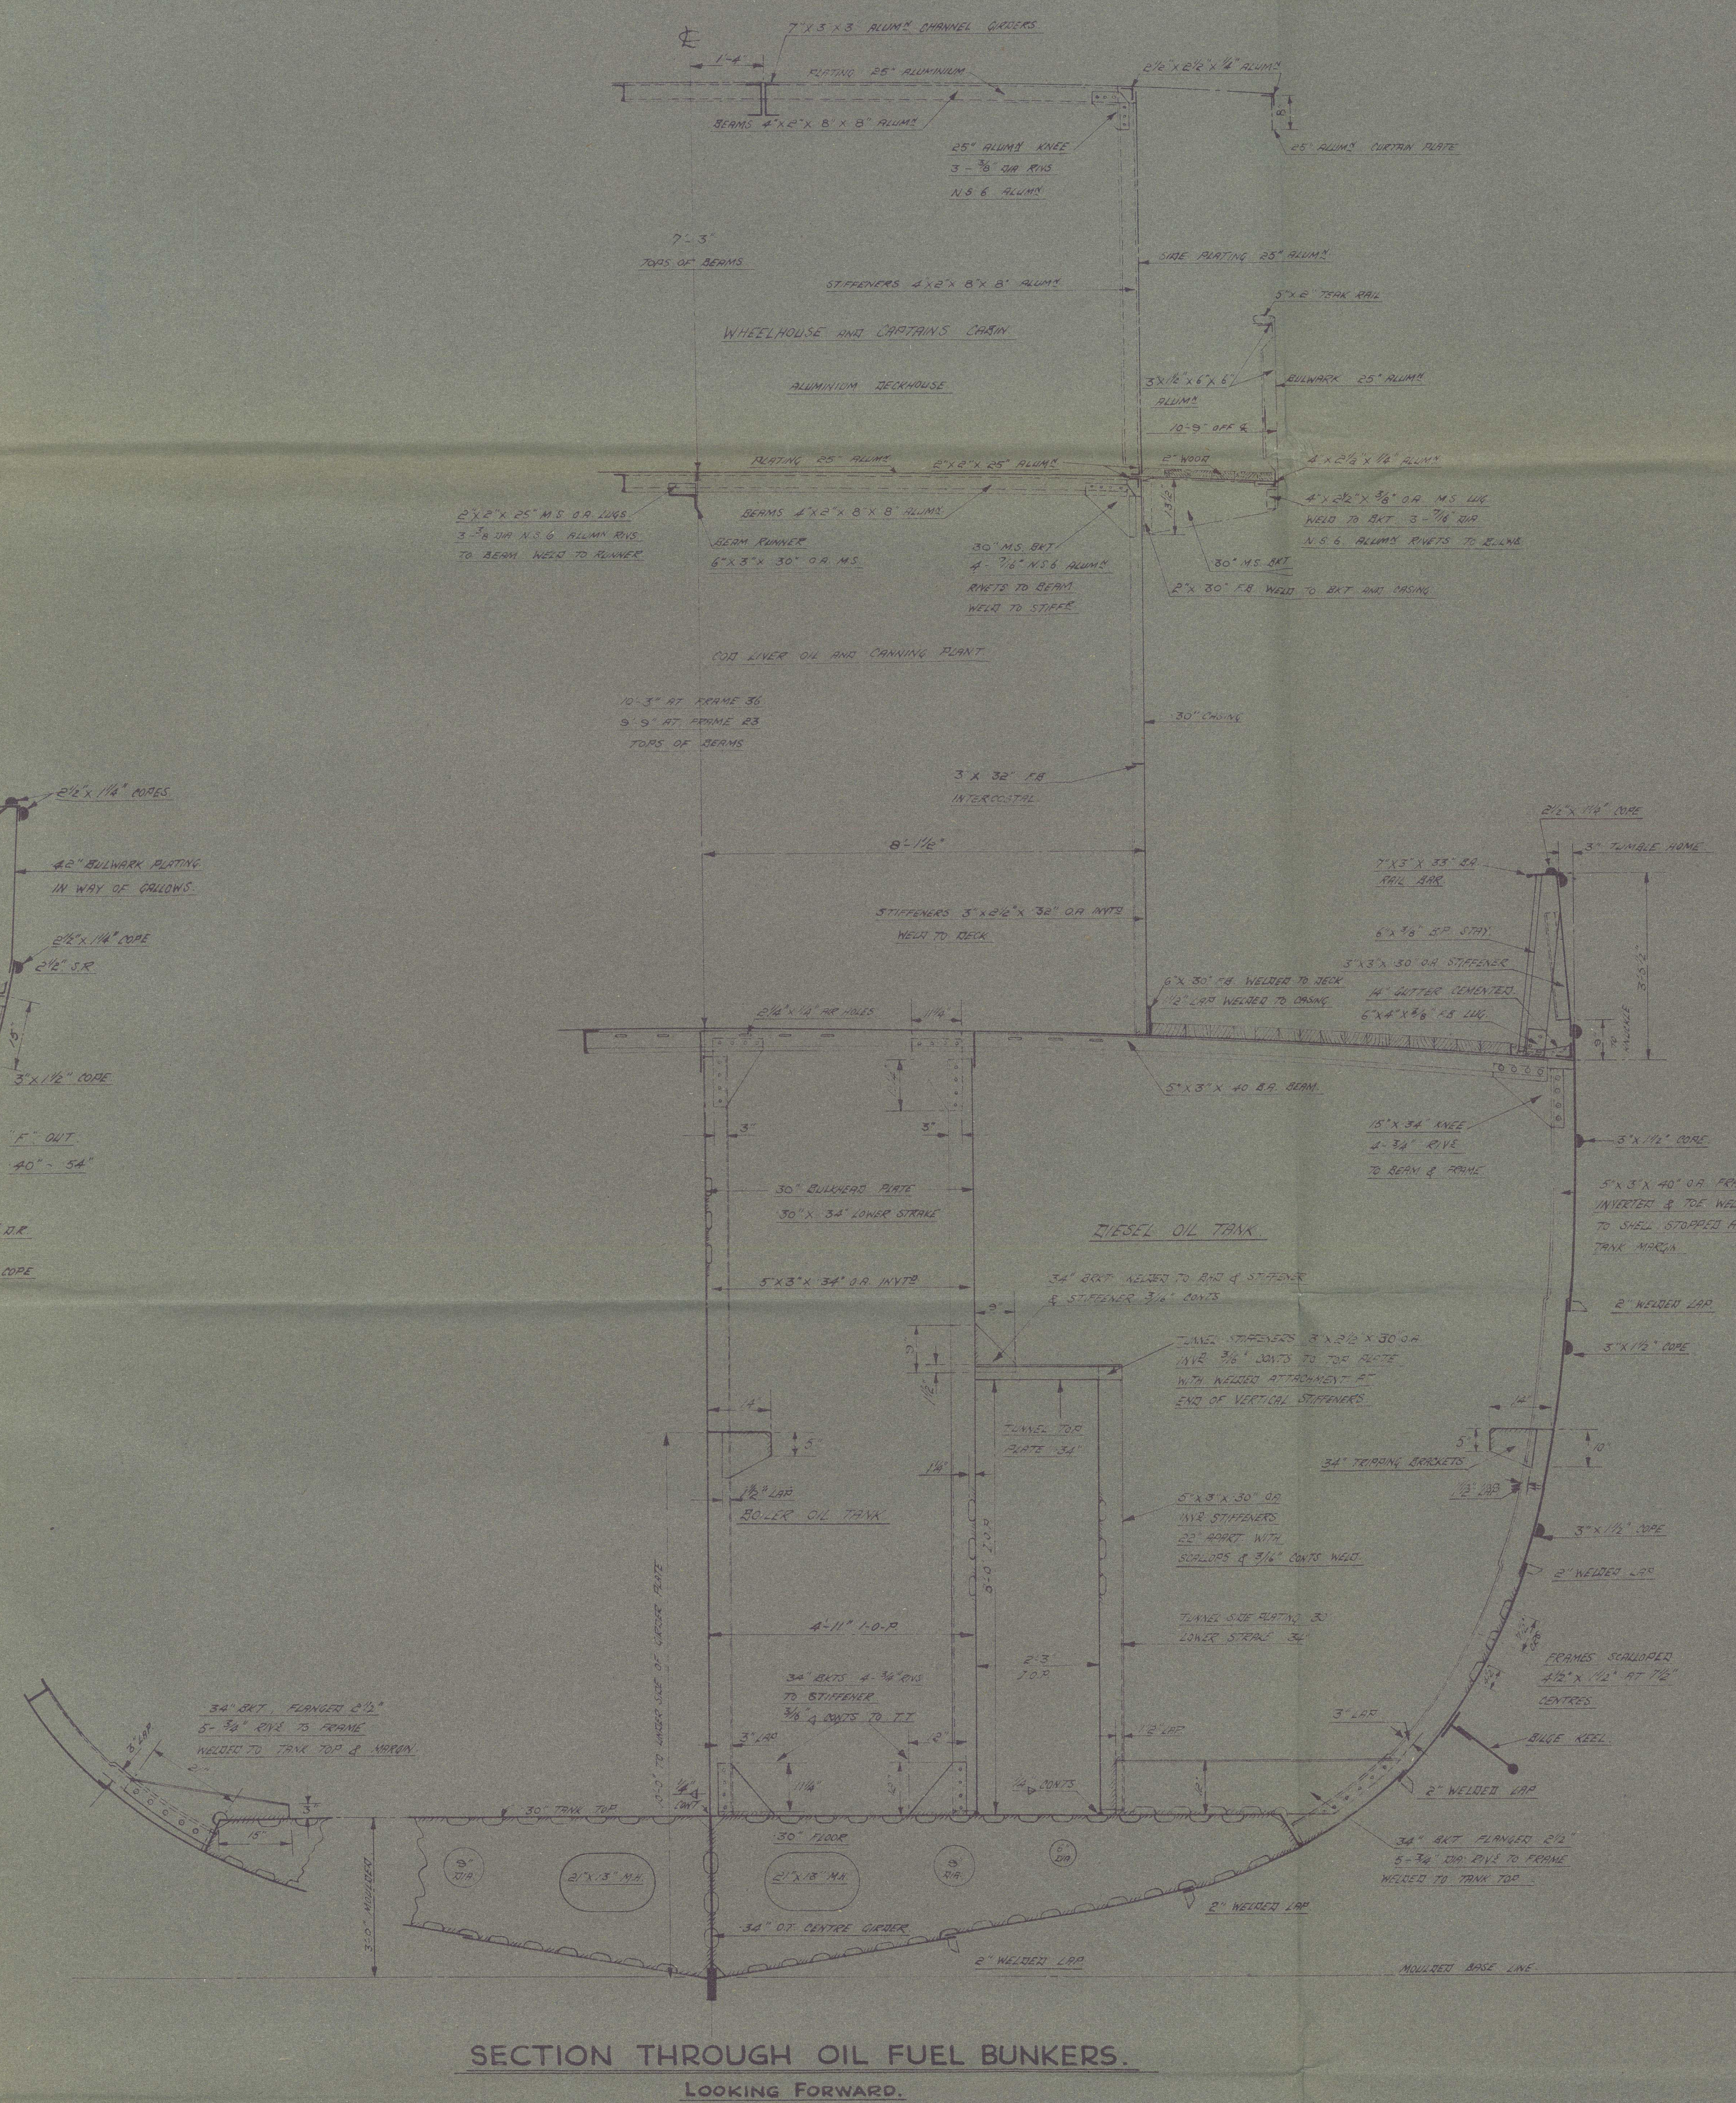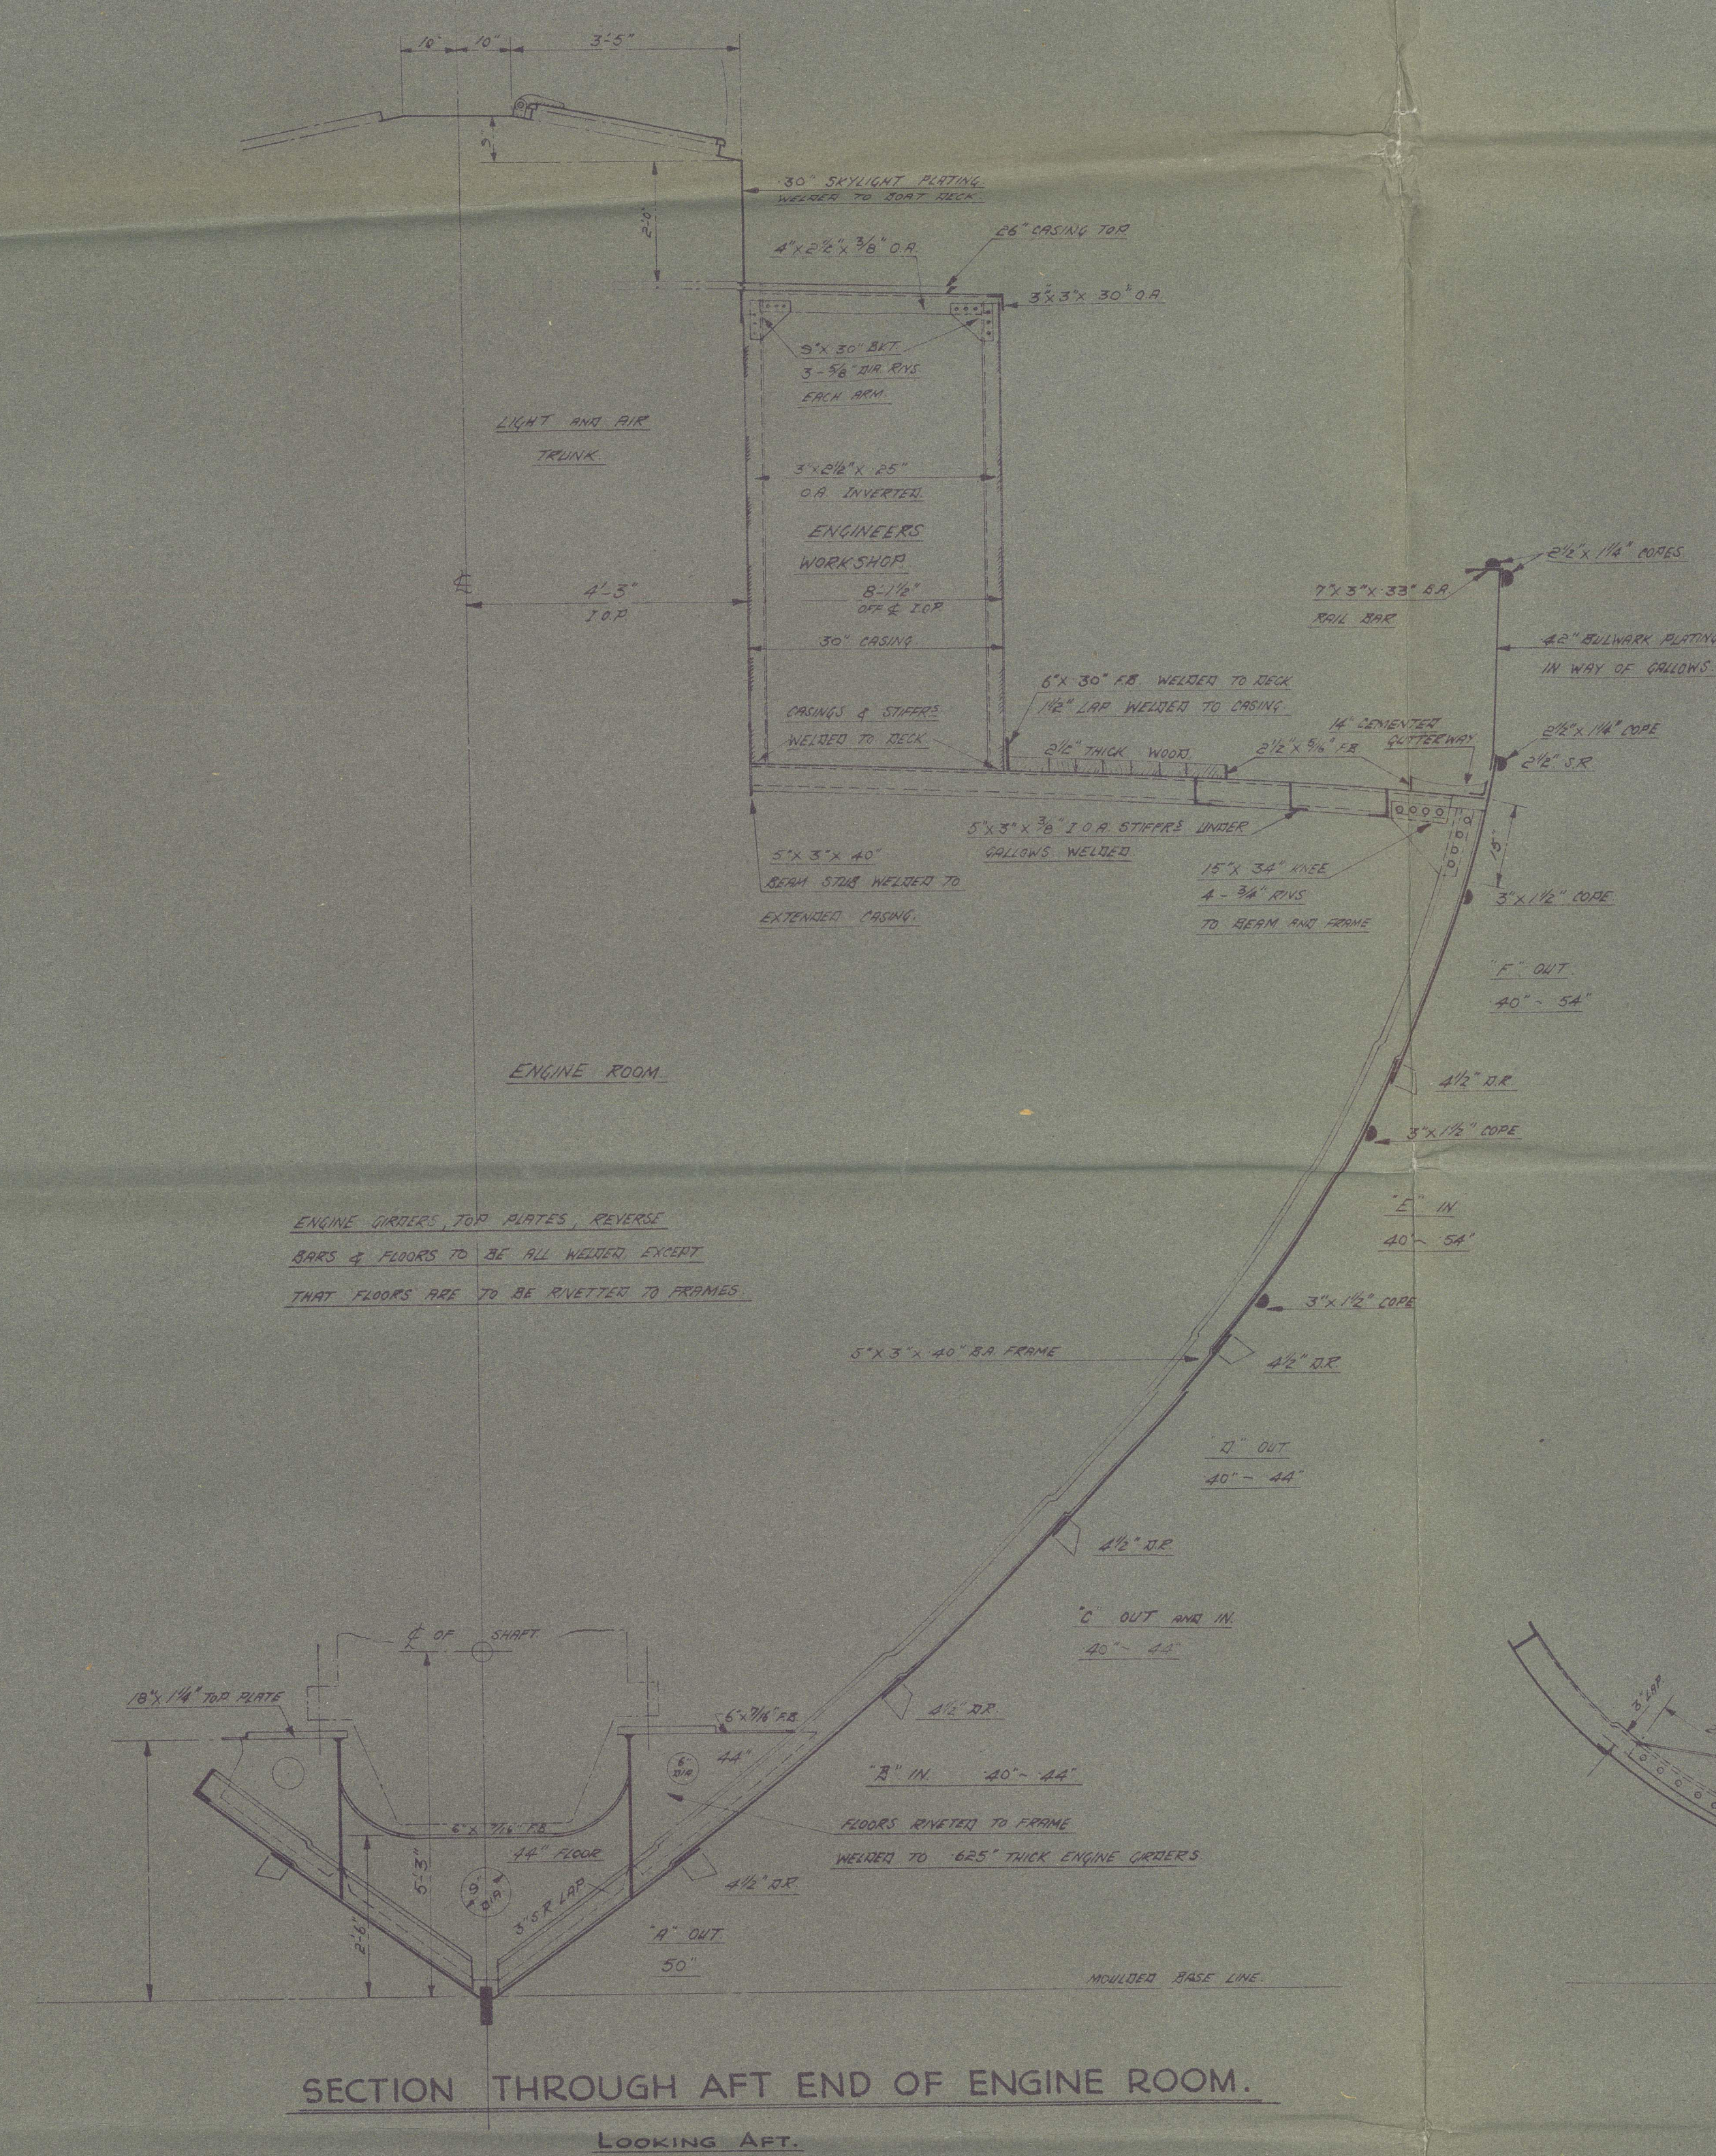



(4A)

Brooke Maxine Kler N<sup>o</sup> 243


Motor Transits "MUKSUU"  muksum

Structural Sections "as built"


Spewick Report N<sup>o</sup> 133835

A#

RECORDS DEPT.,  
LONDON.

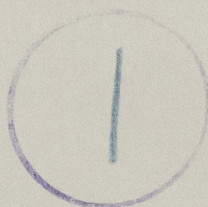

1/1

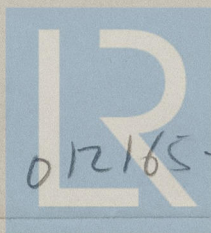

© 2021

012185-012170-0001  
Lloyd's Register  
Foundation