

S 836

SUMIDA MARU ★

SHELL EXPANSION
AND FRAMING

FINISHED PLAN

SCALE LENGTH 1:100 DATE JUNE 15 '60
BREADTH 1:50 DRAWN

YOKOHAMA  SHIPYARD
& ENGINE WORKS

MITSUBISHI NIPPON HEAVY-INDUSTRIES, LTD.
HULL DESIGNING DEPARTMENT

APPROVED

R. Tsumoda

CHECKED

R. Noto

DRAWN

J. Kawasaka

TRACED

S. Furuta

DATE ISSUED

DRAWING NO HO2101F


LLOYD'S REGISTER
OF SHIPPING

RECORDS DEPT.,
LONDON.

9

CERTIFIED COPY OF APPROVED PLAN	PLACE OF APPROVAL Kobe	DATE 1-9-59
CERTIFIED BY <i>[Signature]</i>	DATE JUL 1 1960	

M.V. "Sumida Maru"
As Built
YEA. F.E. Rpt. No. 3311

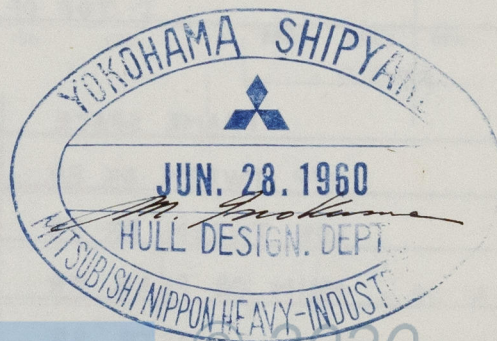

19141

Lloyd's Register
Foundation

012193-012202-0257

012193-012202-0257