


N^{os} 131 & 132. PROFILE & DECK PLAN. AS BUILT

STEEL SCREW MOTOR VESSELS

DIMENSIONS.

LENGTH B.P. 130'-3"
BREADTH MLD. 25'-0"
DEPTH MLD. 9'-6"

Scale:- 1/8" = 1 Foot.

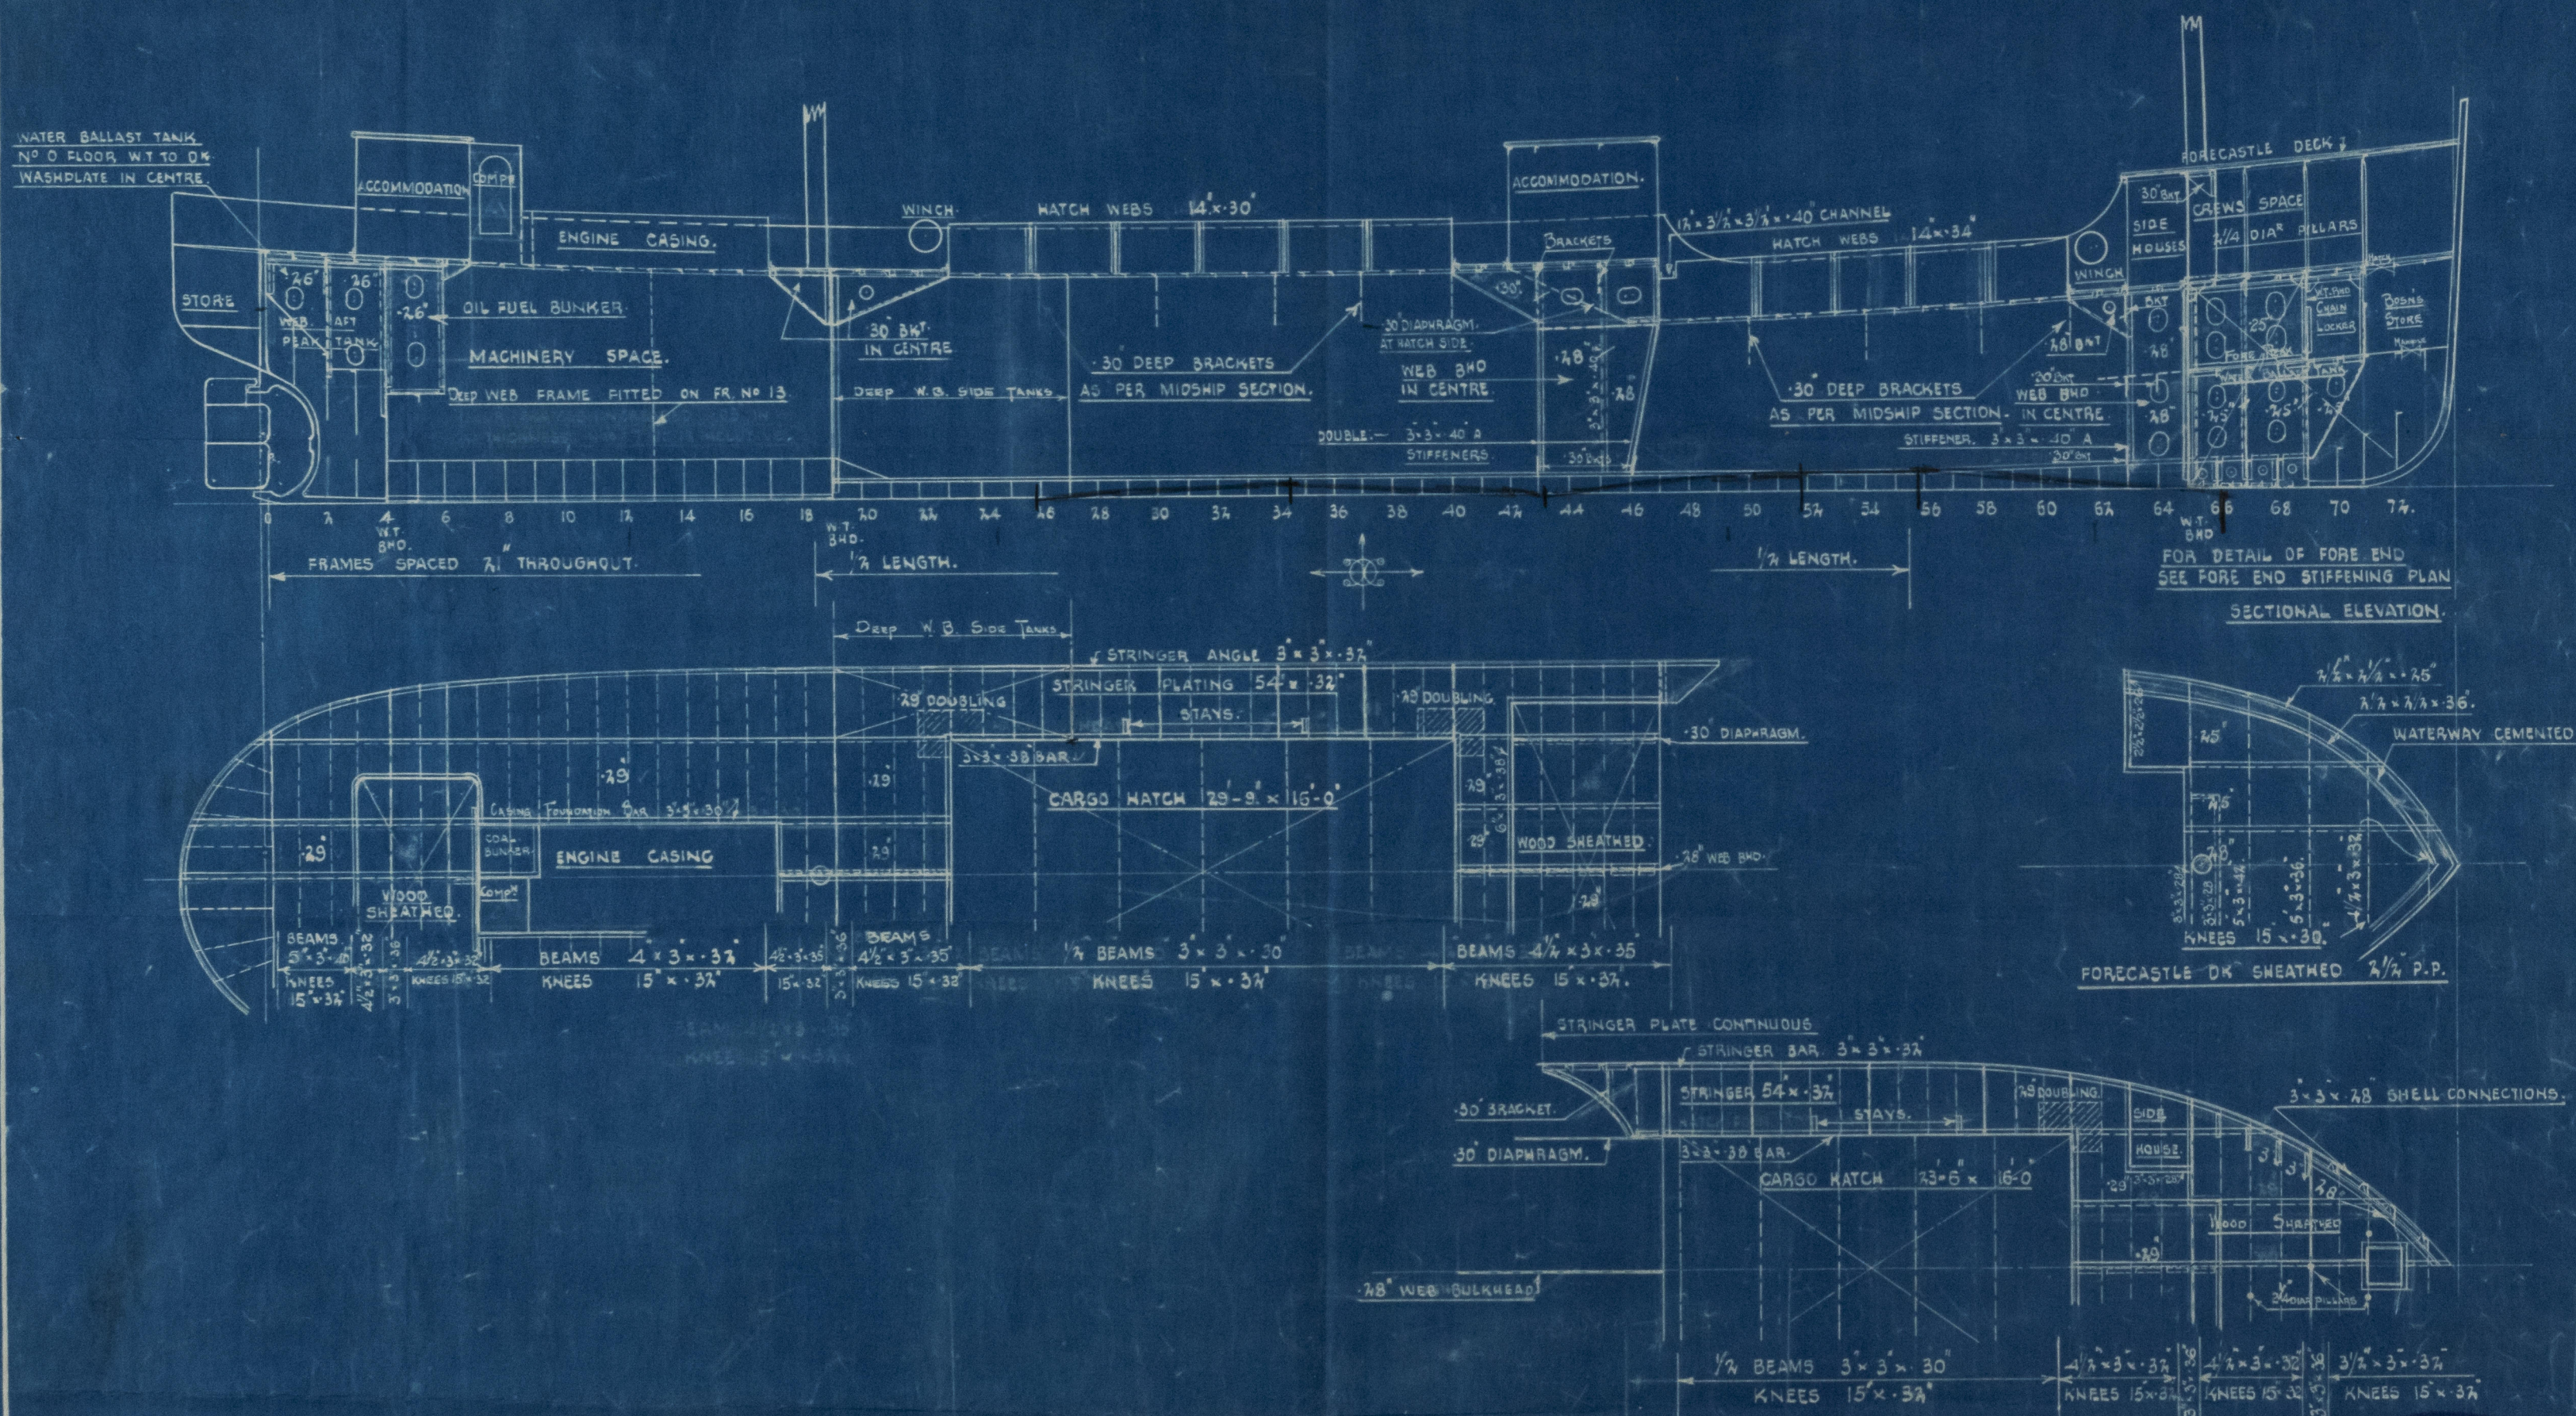

W. & A. LEWIS & SONS LTD.
10 JAN 1945
13, 106
M.V. Nos 131-132
Drawing No 2
27th August 1934
01229-01233-314

N^{os} 131-132,

J. Lewis & Sons Ltd.

Profile and Decks.
as built

S.S. 131. "JOLLY NIGHTS"
abn. Report. 18001.

S.S. 132. "JOLLY DAYS"
abn. Report. 18037.



© 2021

Lloyd's Register
Foundation

012229-012235-0147