
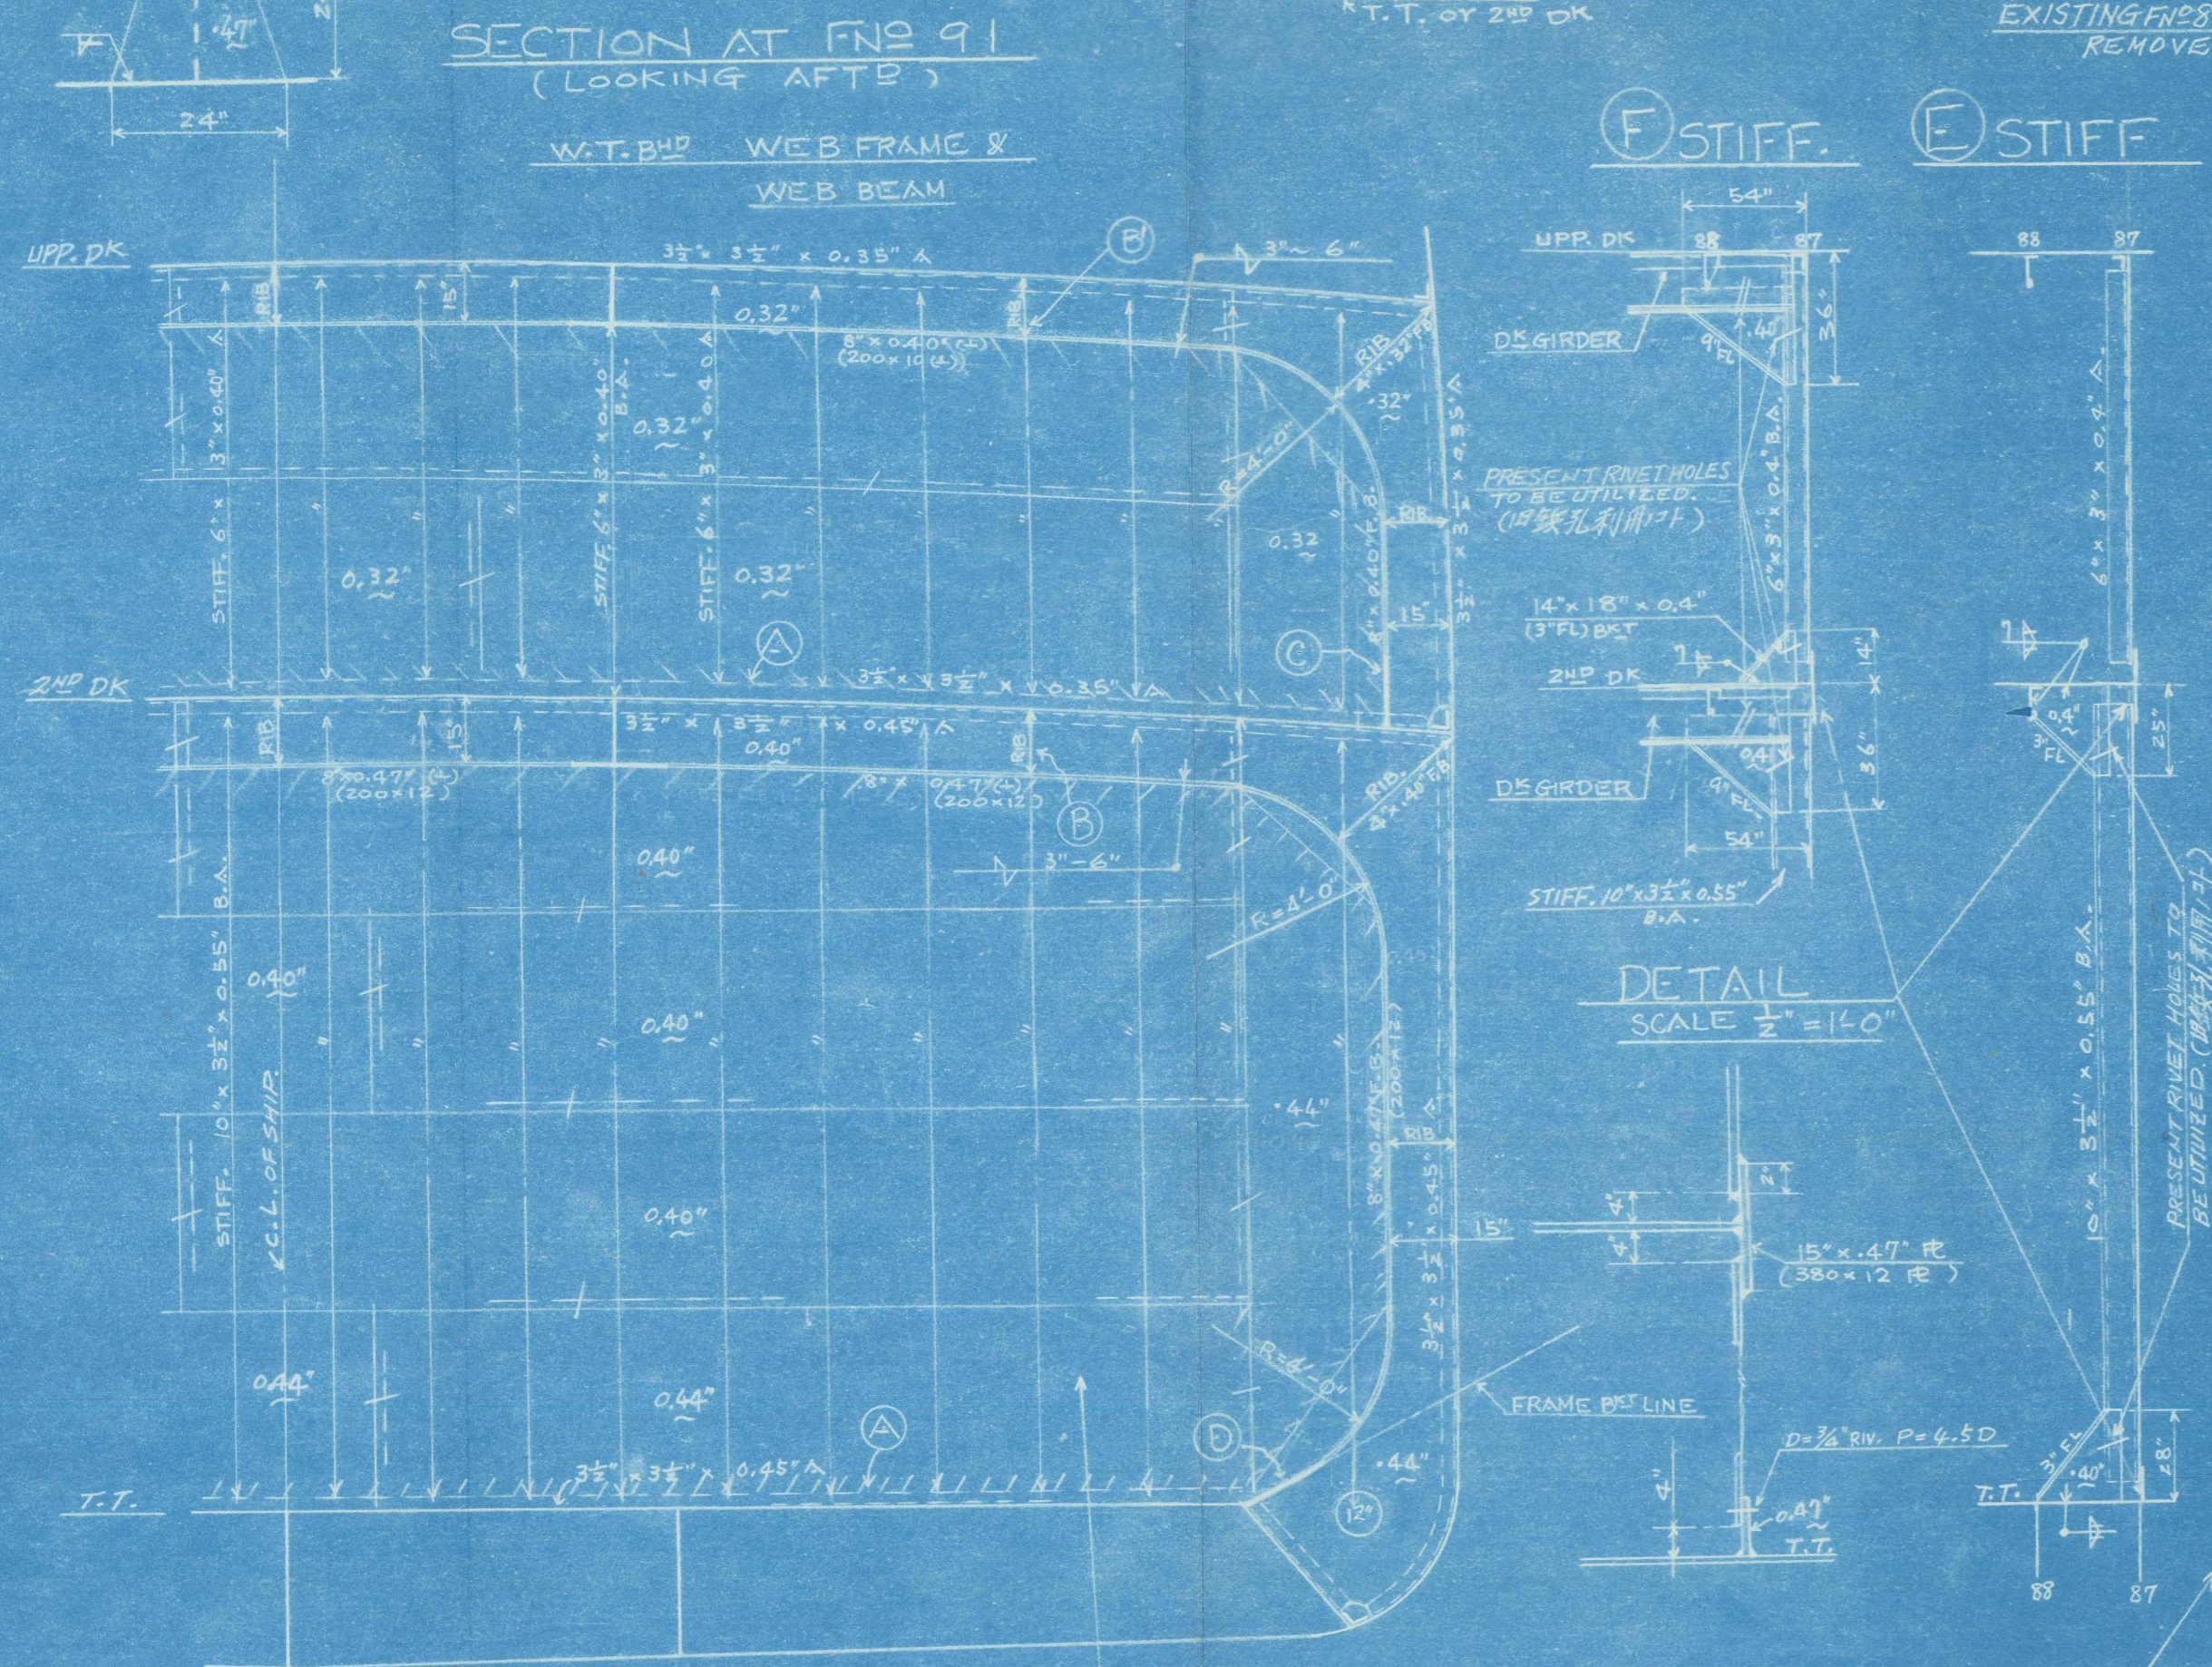


2ND DECK PLAN

NOTE:

1. BOTH SIDES SYMMETRY.
2. RENOVATION SHOWN IN RED.
3. YELLOW PARTS DENOTE REMOVED.
4. FNO 91 W.T. BHD REMOVE TO FNO 87.

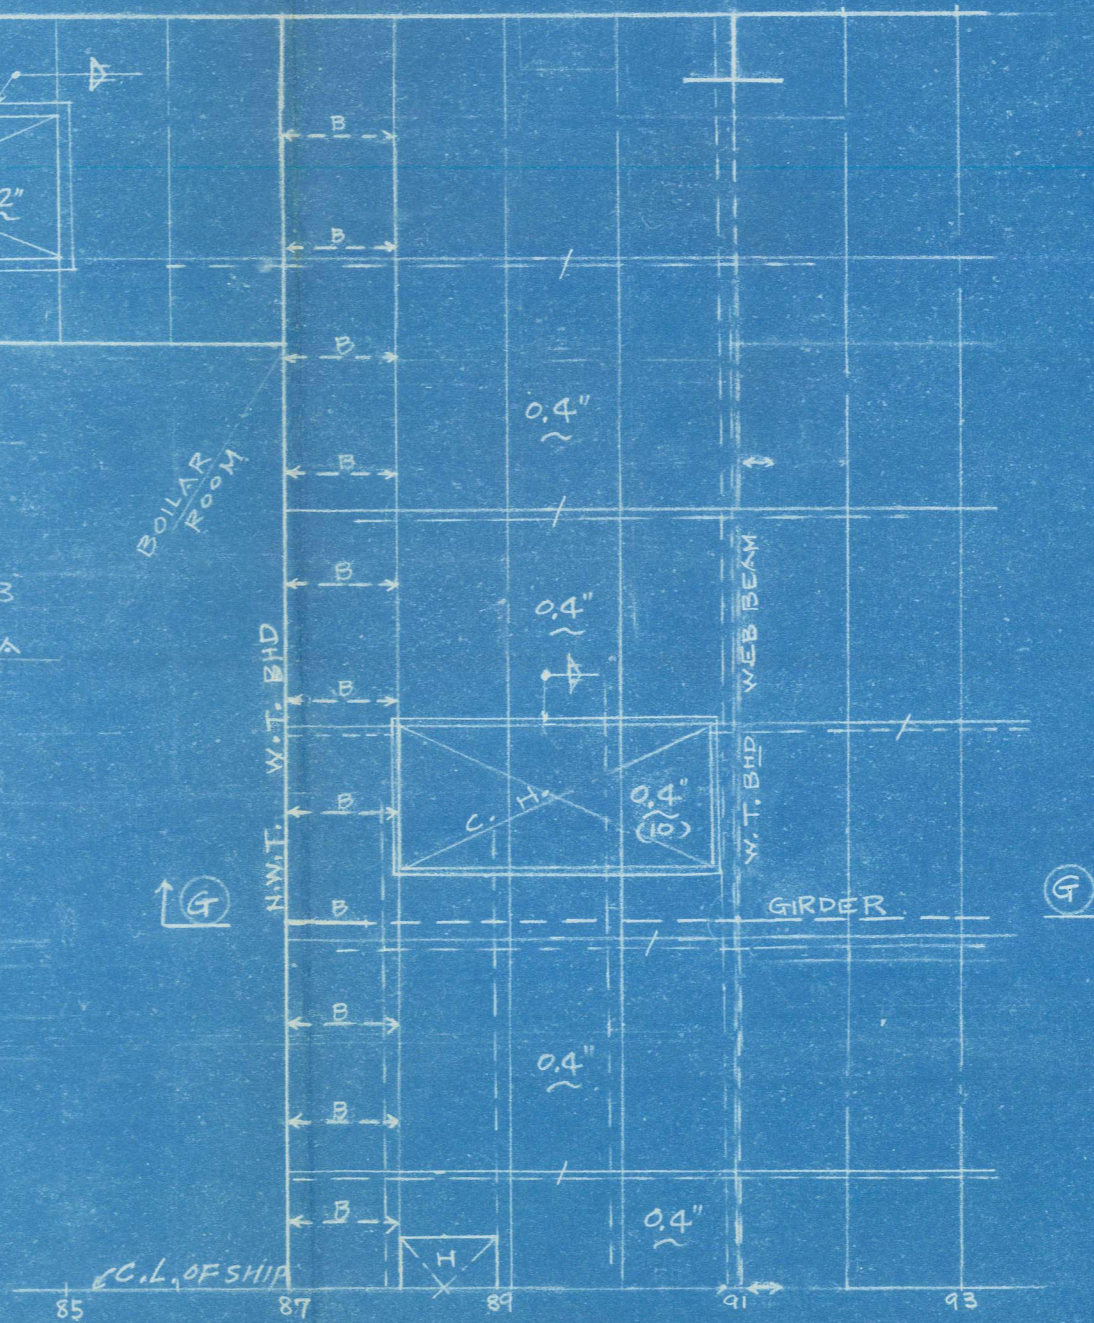

PARTS BHD PLATE WITH STIFF, TO BE REMOVED TO FNO 87.
(一部板鋼等ハ取外シ(スチフナー) FNO 87ニ移動スラスト)

Copy of approved Plan
24.5.52
KOBÉ

NAME OF SHIP TERUTAMA-MARU

FNO 87 W.T. BHD
PLAN

SCALE 1/4" = 1'-0"

SASEBO DOCKYARD
SASEBO SHIP INDUSTRY CO. LTD.
SASEBO, JAPAN

APPROVED: M. Sone
APPROVED: K. Nakamura
IN CHARGE: J. Nakamura
CHECKED BY: B. Takuchi
DRAWN BY: K. Nakamura
ISSUED: FEB. 25, 1952
WORK NO. 22,117
CLASS NO.
PLAN NO. 5427-117

010375 0019-0001

TO LLOYD

Mr. Young.

S/S "Terutama Maru".

F. No. 87. W.T. Bhd plan.

Kob rept No. 701.

TO ACCOMPANY.....*Kob.*.....REPORT No. ~~684~~
DATED.....~~152~~.....



© 2021

Lloyd's Register
Foundation

012273 - 012278 - 0007