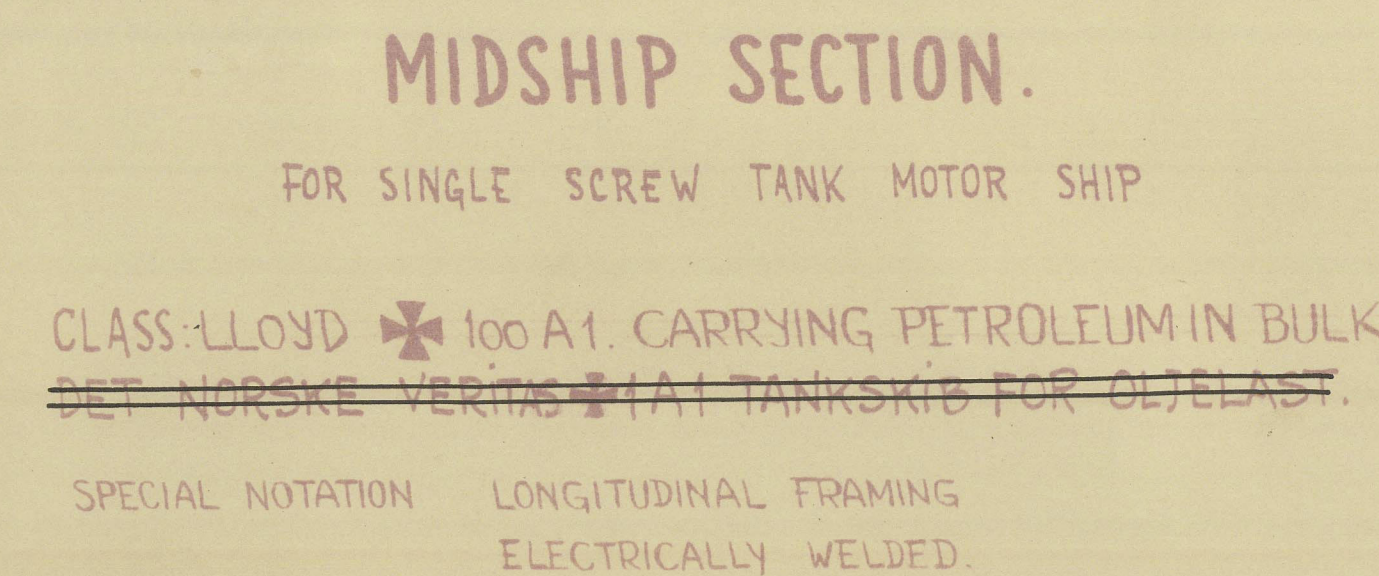
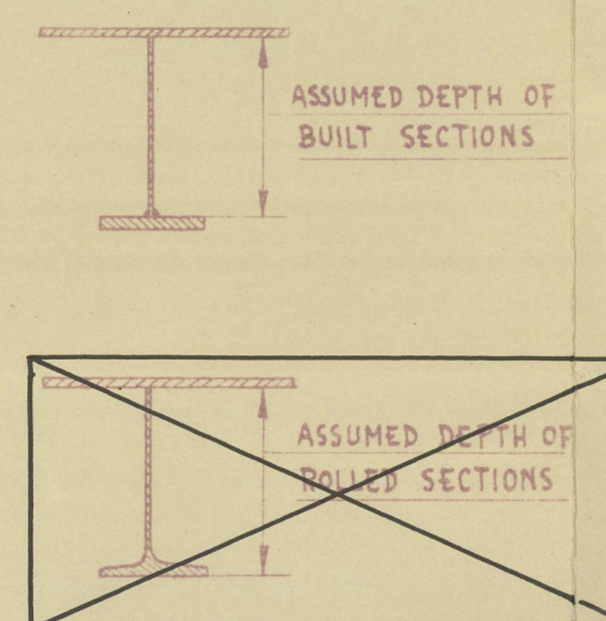
[illegible]

DIMENSIONS:		
LENGTH BETWEEN PP		500'-0" = 152,400 M
BREADTH MOULDED		63'-0" = 19,202 "
DEPTH	"	68'-6" = 11,735 "
HEIGHT OF POOP		8'-0" = 2,438 "
HEIGHT	FORECASTLE	7'-6" = 2,286 "
"	BRIDGE	7'-9" = 2,362 "

L.R. NUMERALS

FIRST LONG. NUMERAL: $L \times D = 500 \times 37.5 = 18750$
 SECOND " " $L \times (B + D) = 500 \times (63 + 37.5) = 50250$
 $L/D = 500/38.5 = 12.99$

EQUIPMENT NUMBER

$L \times (B \div D) = 500 \times (63 \div 38.5)$	= 50750
POOP: $100 \times 8.0 \times 0.75$	= 600
BRIDGE: $45.6 \times 7.75 \times 0.75$	= 265
FORECASTLE: $59.7 \times 7.5 \times 0.75$	= 336
DECK HOUSES ON POOP: $82.85 \times 0.5 \times 50 \div 65 \times 0.5$	= 570
* * * BRIDGE: $32.8 \times 8.5 \times 0.5 + 32.8 \times 9.5 \times 0.5$	= 245
	= 52816

LETTER f†

EQUIPMENT :

3 BOWER ANCHORS STOCKLESS 85.83 CWT. EACH COLL. WEIGHT 257.5 CWT


1 STREAM * 26.5 CWT. ExL. STOCK

300 FATHOMS 2"X6 STUD CHAIN CABLES MIN. WEIGHT 1640 LBS. OR 2 3/4" TAYCO CHAIN

120	"	5" STEEL WIRE 6x24 S
130	"	5 1/2" " " " "

2 x 100 " 2 3/4" " 6 x 42

2x 100 " 2 3/4" " " "

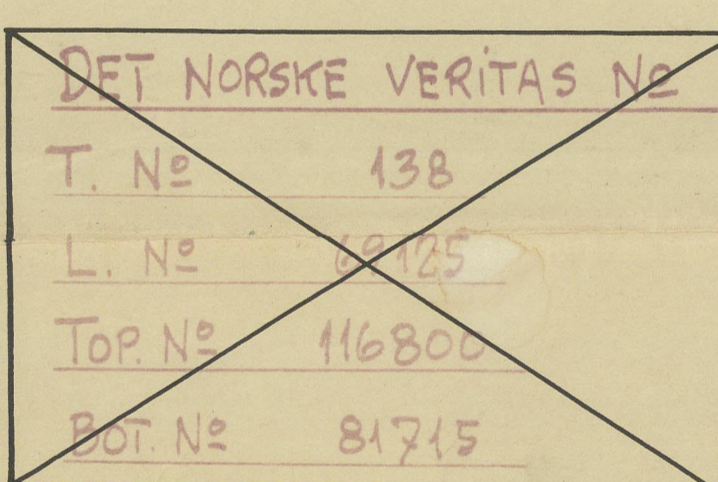

PART NE	CLASS	M/343
343	Lloros	
		<p>MIDSHIP SECTION</p> <p>AS BUILT</p> <p>SKALA: 1/125 Vio</p> <p>KOCKUM</p> <p>MEK. VERKSTADS A-E</p> <p>MALMÖ SWEDEN.</p> <p>RITAV: <i>Yotm</i></p> <p>YOTM <i>Yotm</i></p> <p>GRANIK <i>GRV</i></p> <p>DATUM: 2002 JEN</p> <p>F 214/20</p>

012365-012369-0143
Lloyd's Register
Foundation

Female.

MALMÖ RPT No 3089.


M/T 'SOJA MARGARETA' ★

MIDSHIP SECTION. (AS BUILT.)

Kockums Mekaniska Verkstad A-B
No. 343.

Mms. J. E. Rpt. 3104

RECORDS DEPT:
LONDON

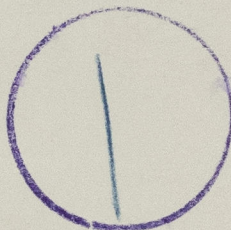

© 2021

Lloyd's Register
Foundation

012368-012369-0106