


Sternframe.



Meitai Mame.

RECORDS DEPT.
LONDON

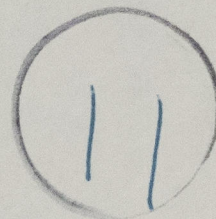


© 2021

Lloyd's Register
Foundation


012377-012385-0308

TO LLOYDS REGISTER OF SHIPPING

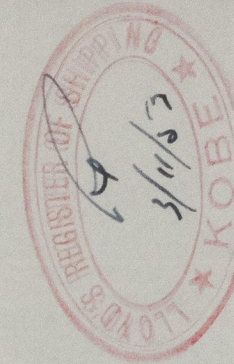


CERTIFIED COPY OF "APPROVED PLAN"

AS BUILT

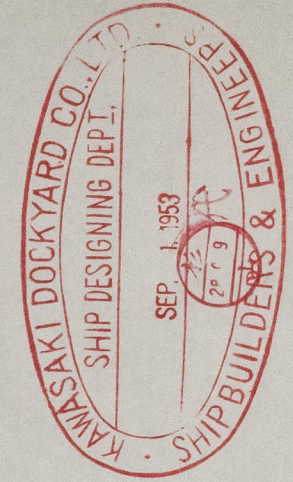

012377-012385-0308

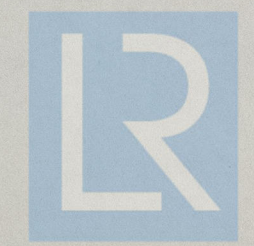

© 2021
Lloyd's Register
Foundation