

No- 212

EQUIPMENT NUMERAL.

$$\underline{\underline{L \times (B+D) = 3260.}}$$

DECKHOUSE = $57 \times 7 \times .5 = 200$

3460 - LETTER "b".

NUMERALS :-

$$\underline{L \times D = \cancel{903} = 903.}$$

$$L \times B + D - \text{---} = 3260.$$

40 — 11.1



DIMENSIONS - L. 100.3 FT. x B 23.5 FT. x D 9.0 FT.

CLASS - 100 A1. WITH FREEBOARD CORRESPONDING TO A SUMMER MOULDED

DRAUGHT OF 6'-9" - SURVEY VESSEL.

SCALE :- 1/2" = 1 FOOT

EQUIPMENT:-

2 BOWER ANCHORS 5 1/4 CWTs STOCKLESS

1 STREAM ANCHOR 1 1/4" CWTS EX STOCK

1120 FMS 3/4" STUD LINK CABLE

45 FMS 2" WIRE ROPE (6/12).

75 FMS 2 1/4" WIRE ROPE (6/12).

90 FMS 4" MANILLA

RIVETING :-


SHELL BUTTS DR. THROUGHOUT

STRINGER BUTTS & KEEL BUTTS OR

DECK SEAMS SR. SHELL SEAMS IN WAY OF QILDR.

DECK BUTTS SR.

RIVETS:- 5/8"

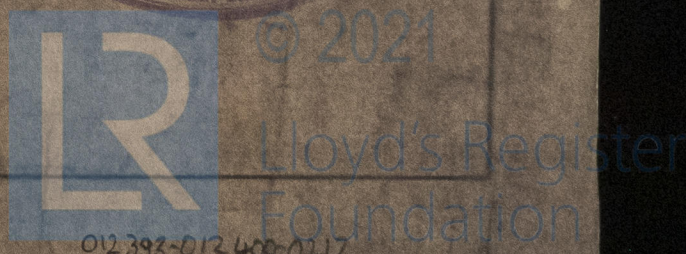

GEO. BROWN & CO. (MARINE) LTD.,

S.S. "BARBOSA".

YARD No. 212.

MIDSHIP SECTION.

(AS BUILT.)

GRK. 1st. ENTRY RPT. No. 20448.



© 2021

Lloyd's Register
Foundation

012393-012400-0217