


N<sup>o</sup> 3685

MIDSHIP SECTION.

PILOT CUTTER FOR TRINITY HOUSE RIVER PILOTS


62'-4" O.A. 60'-0" B.P. x 14'-0" x 7'-11" MLD

SCALE 1" = 1 FOOT.

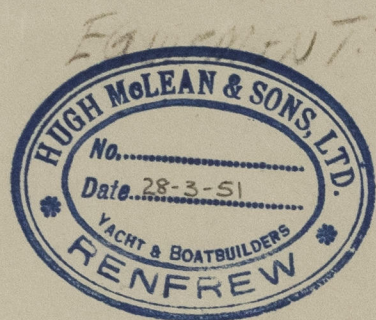


EQUIPMENT: 1 STOCKLESS ANCHOR 2 CINTS.  
1 IRON STOCK ANCHOR 1 CINT (TOTAL)  
60 FATHOMS 1/2" DIA. SHORT LANK CABLE.  
2 @ 20 FATHOMS 4" MANILLA WARPS

WHEELHOUSE FLOOR PORTABLE.

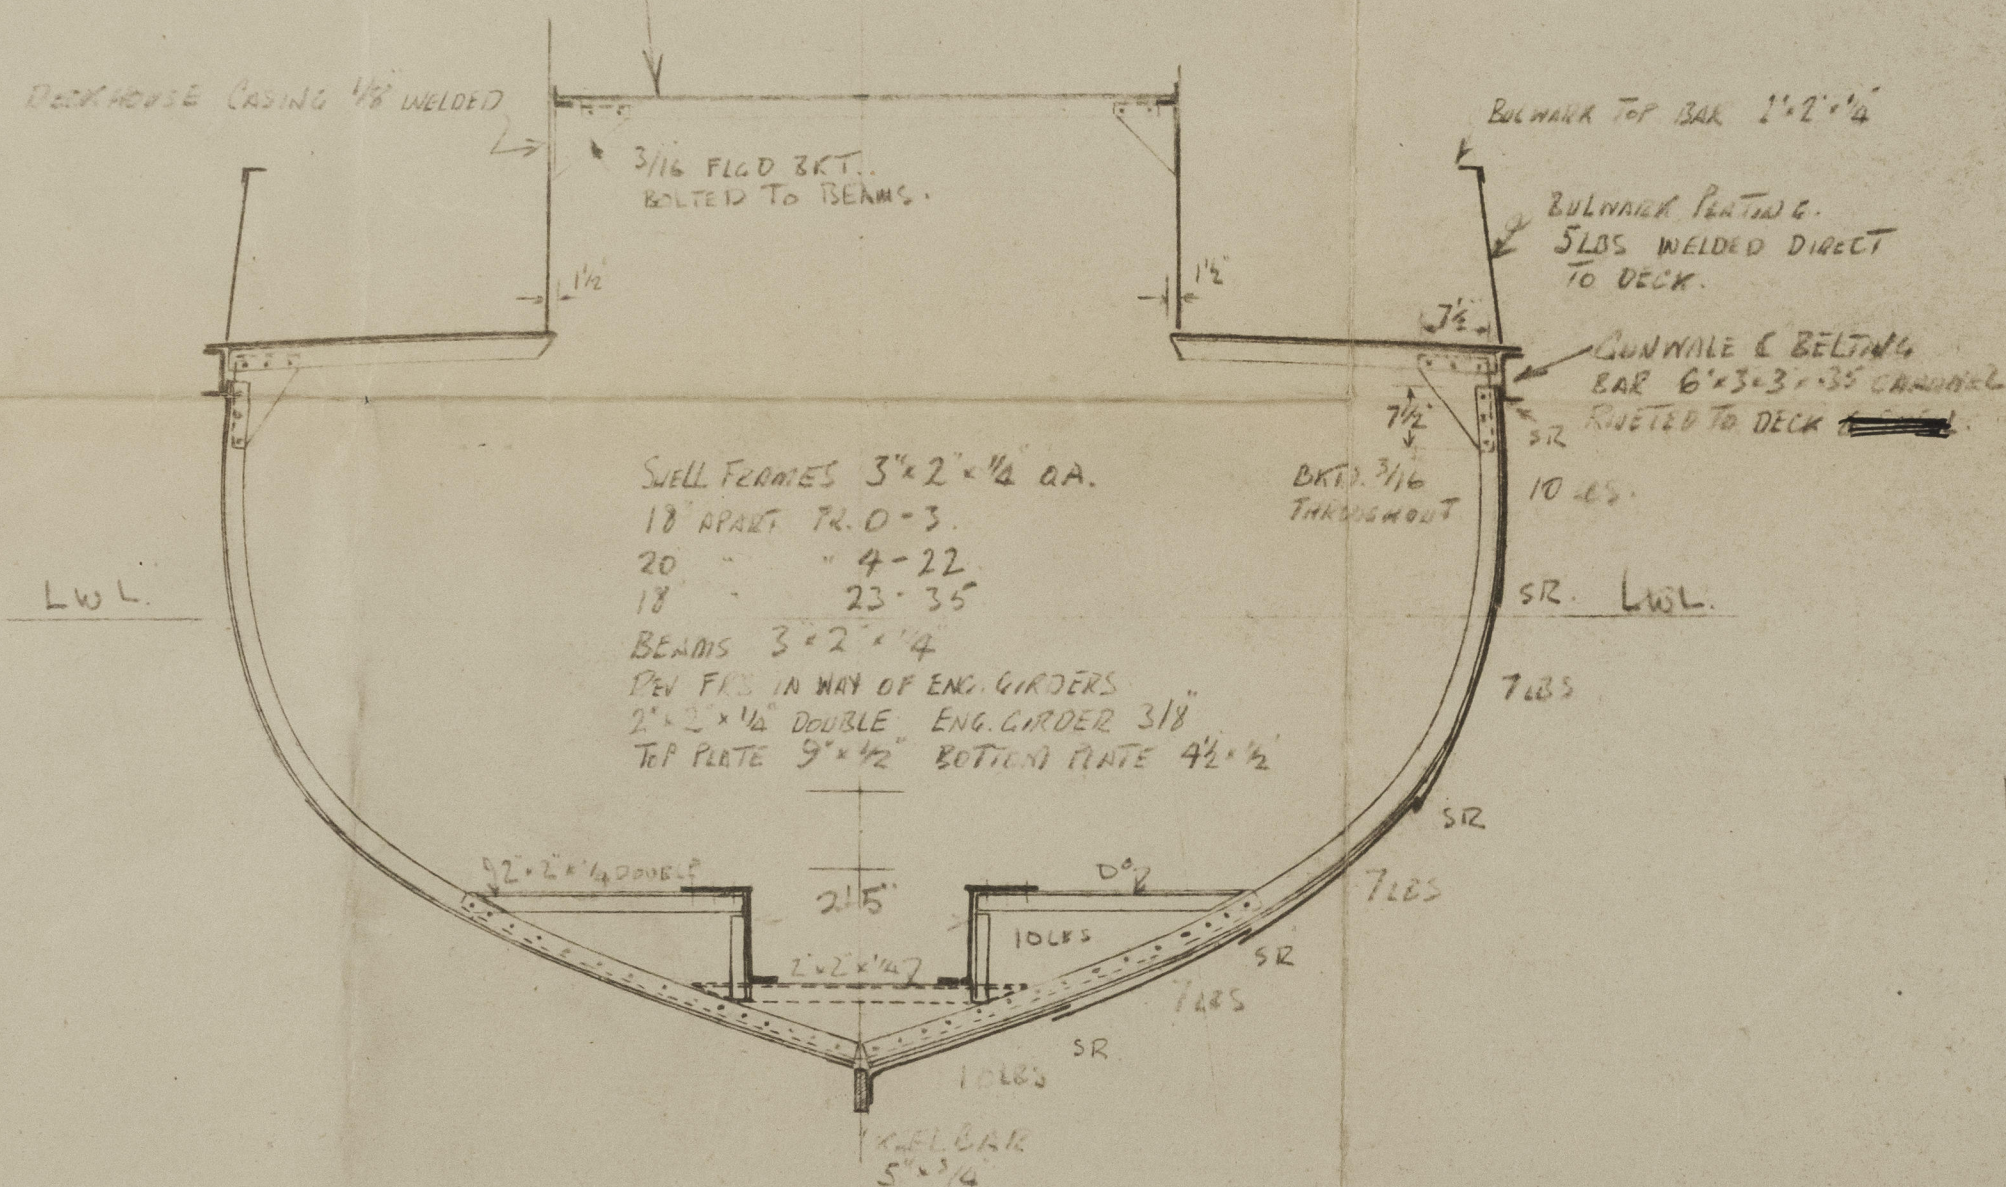

MIDSHIP SECTION  
ABOUT FR. 17

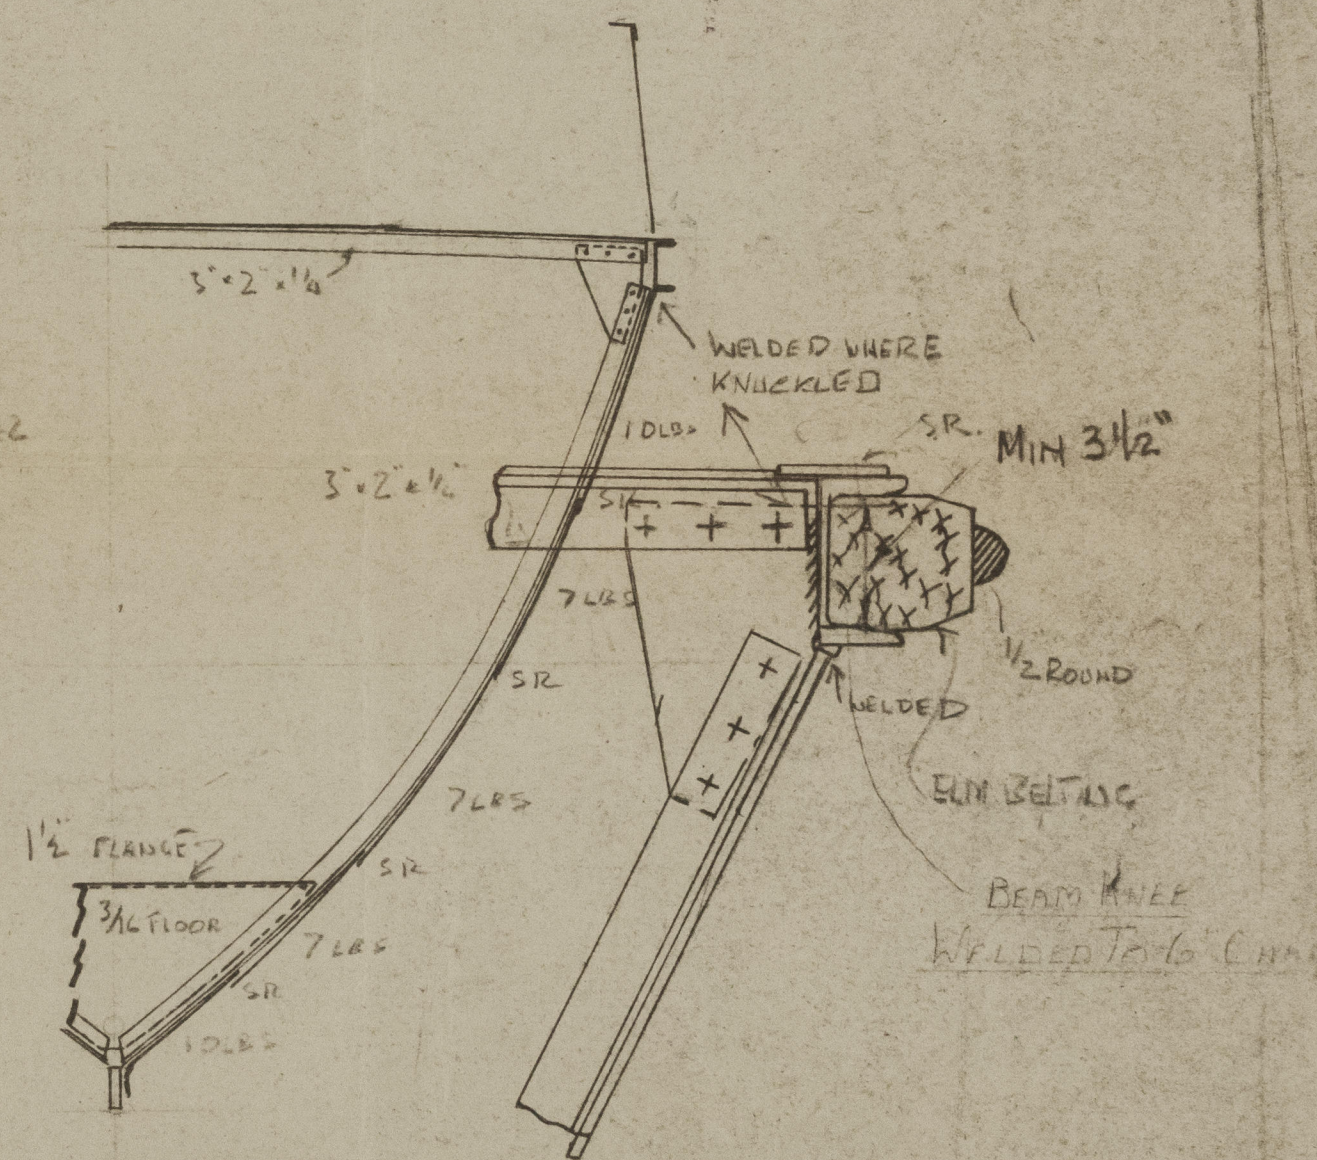

SECTION FORE



© 2021

Lloyd's Register  
Foundation

012460-012472-0197



B. C. SHIP.

M. S. "RIVER THAMES." ★

(PLOT SHIP FOR TRINITY HOUSE)

YARD N<sup>o</sup> 3685

HUGH M<sup>c</sup>. LEAN & SONS L<sup>d</sup>.

RENFREW.


MIDSHIP SECTION

AS BUILT

G/S.

/3/57.

RECORDS DEPT.,  
LONDON

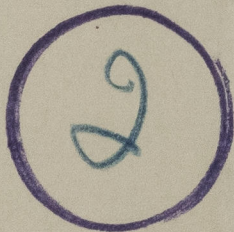

© 2021

Lloyd's Register  
Foundation

012460-012472-0197