

W.  
BR. GUIANA RLY. 699

LLOYDS LENGTH ON W.L. 125' 6"

# T.S.M.V. "BARIMA"






## PROFILE & DECK PLAN.

SCALE 1/4" = 1 FOOT

DIMENSIONS--132' 0" O.A. (125' 9" S.P. x 29' 0" x 10' 0")  
TO CLASS "A.I." WITH FREEBOARD FOR RIVER AND COASTAL SERVICE.

LLOYDS NUMERALS.  
L x D = 1255.  
L (B + D) = 4895.  
d = 9.0  
D = 12.55

STEM 5/2 x 1/8" FORGED STEEL.

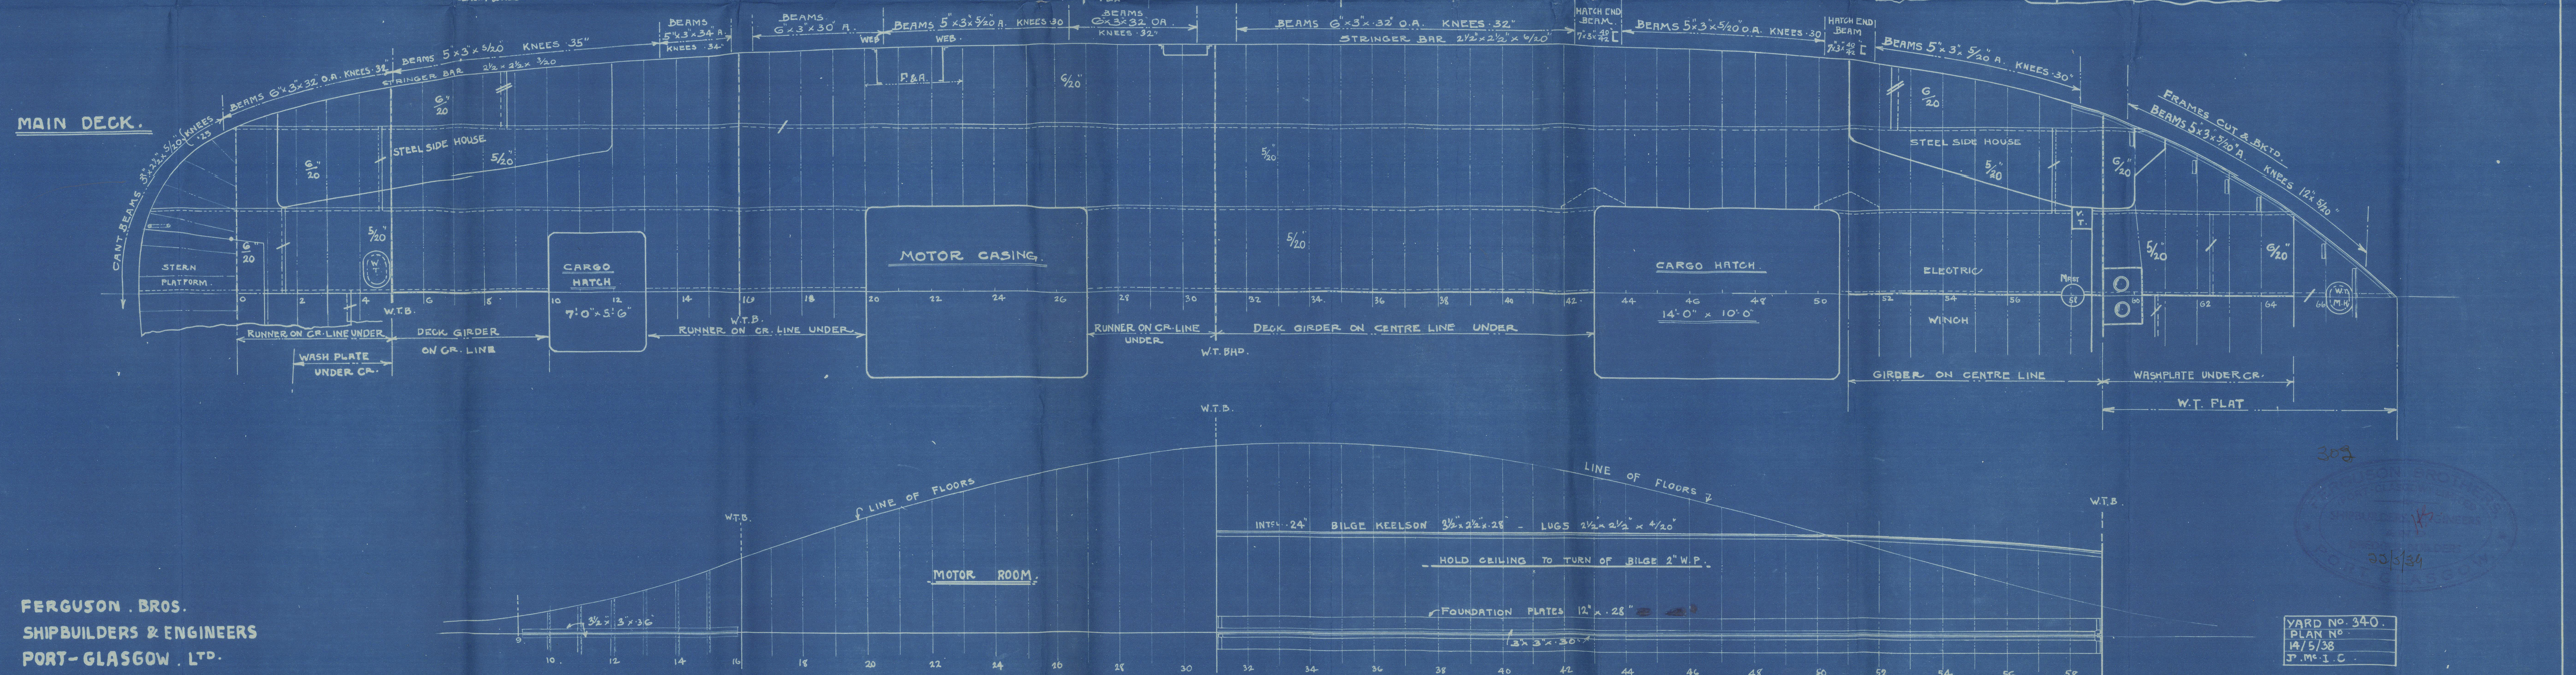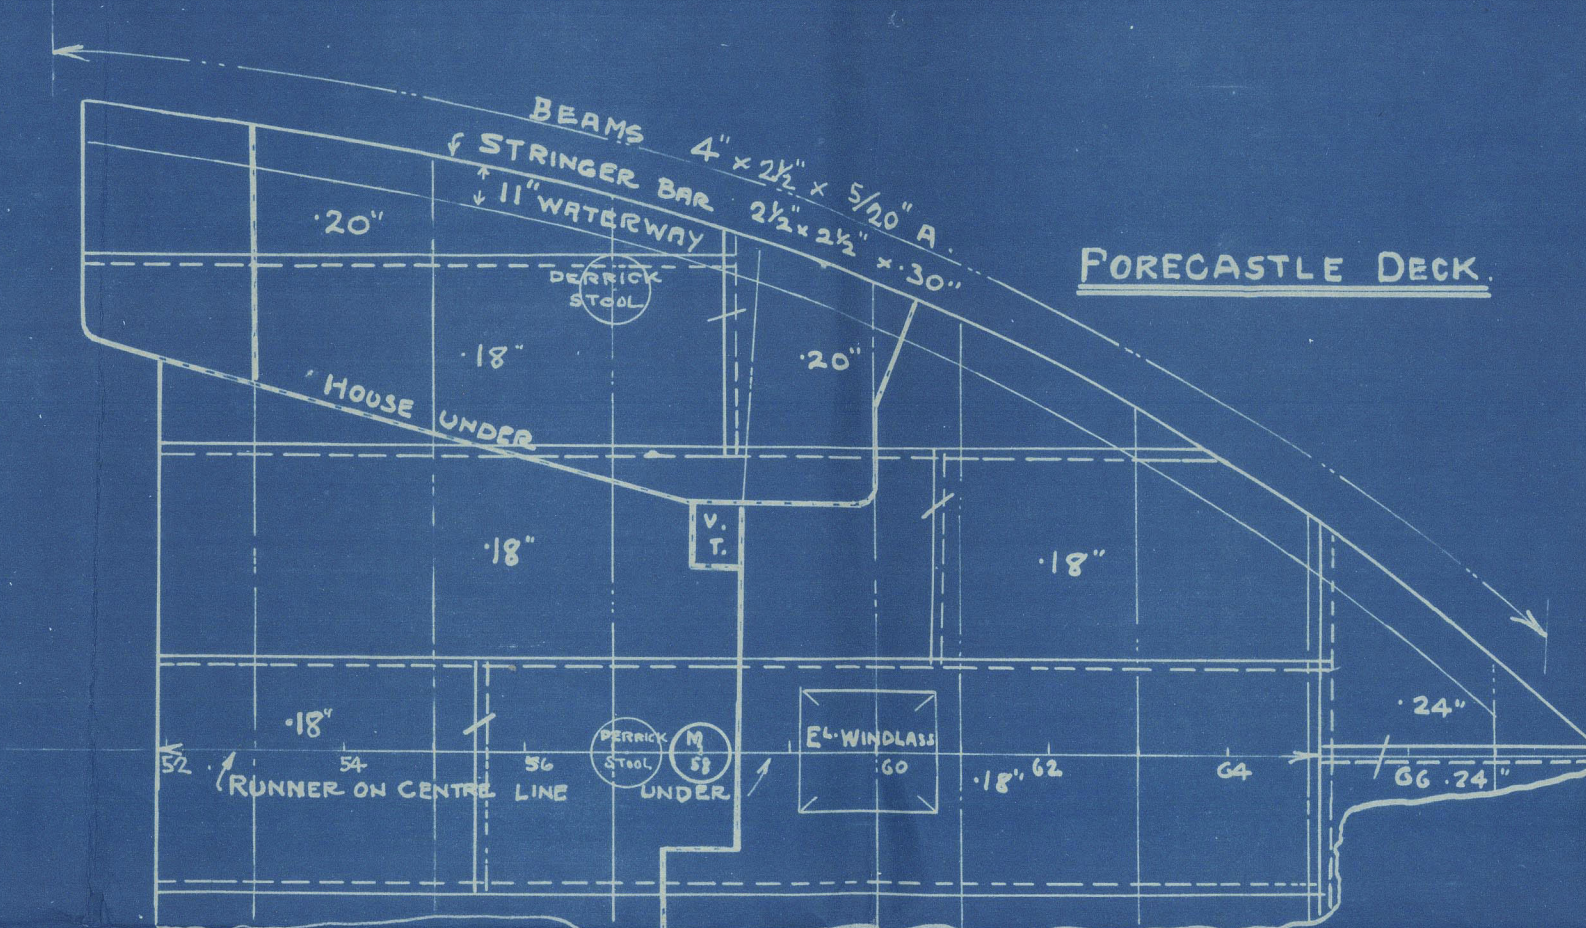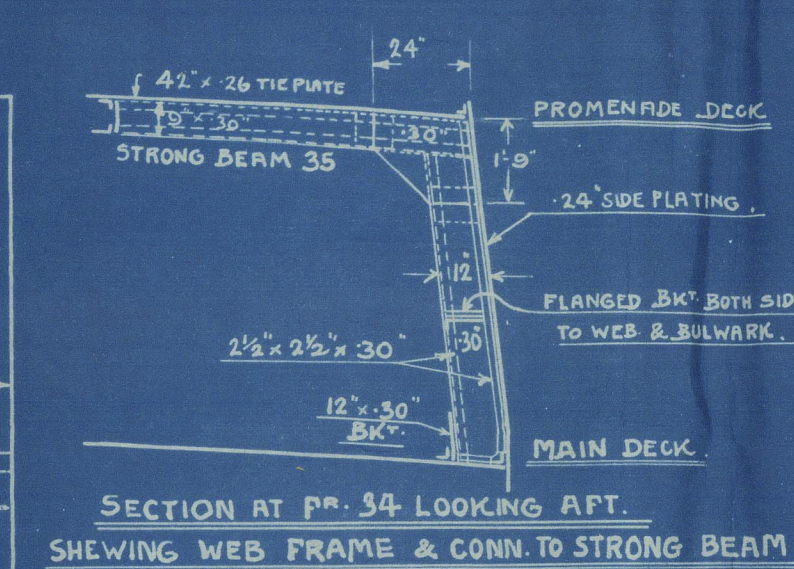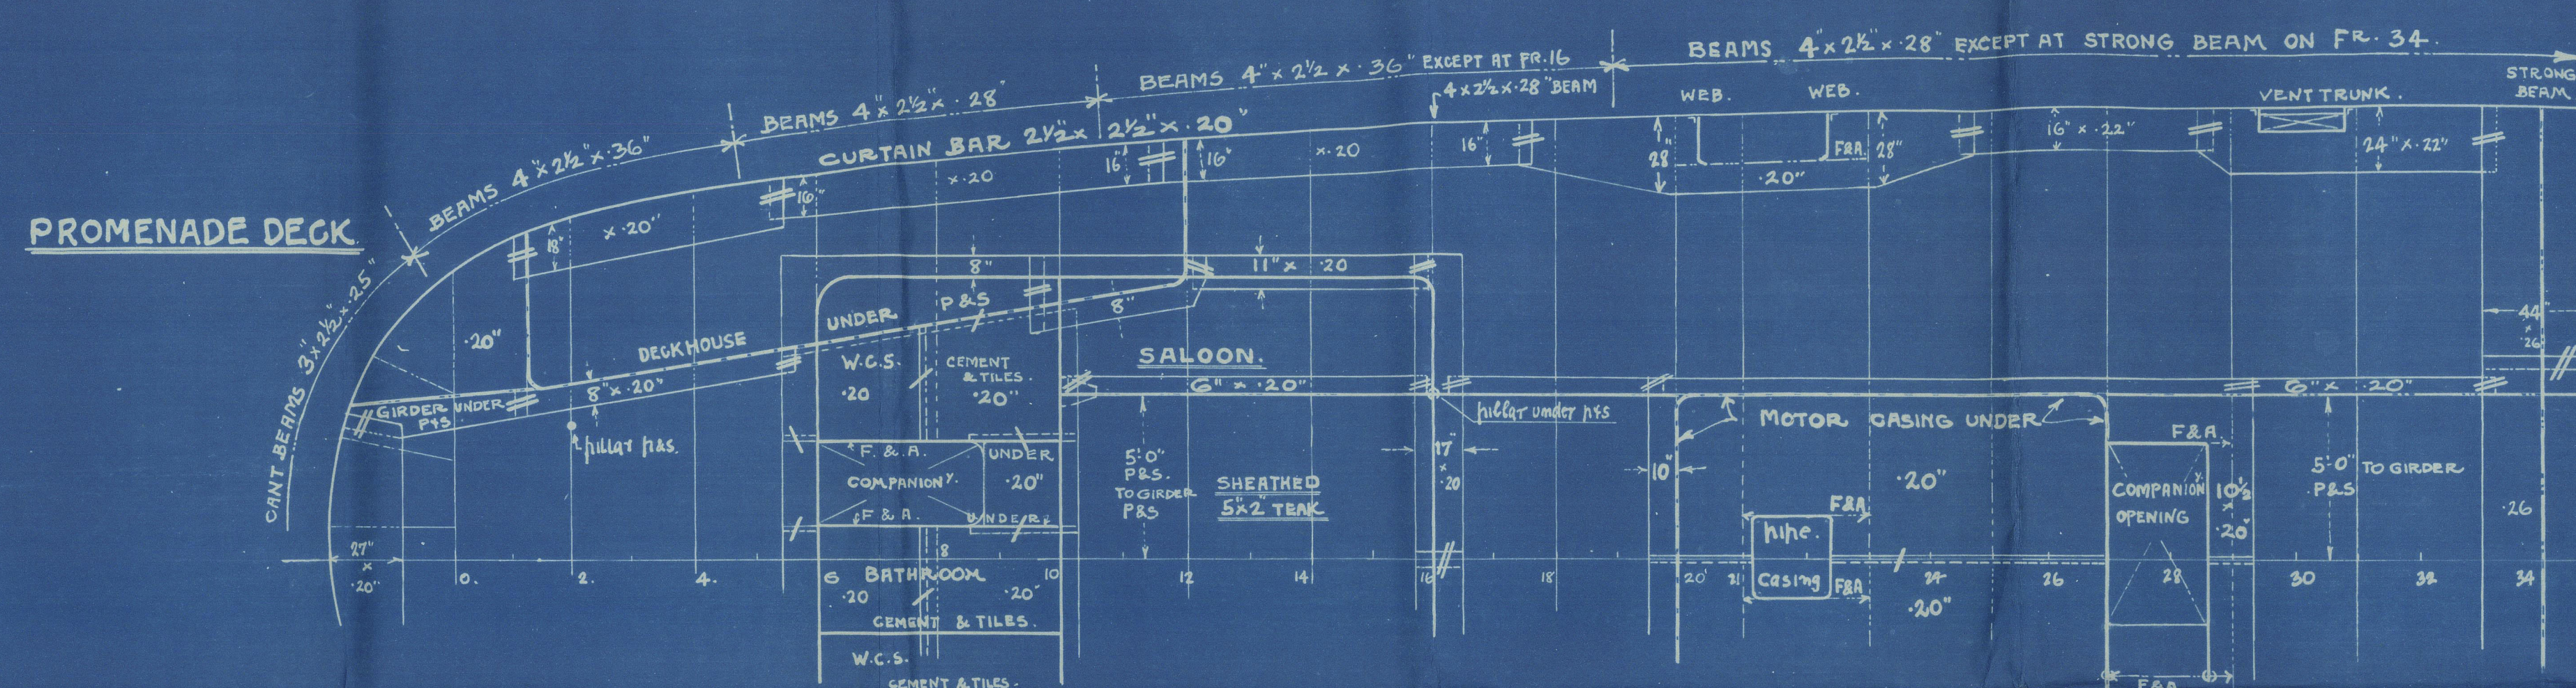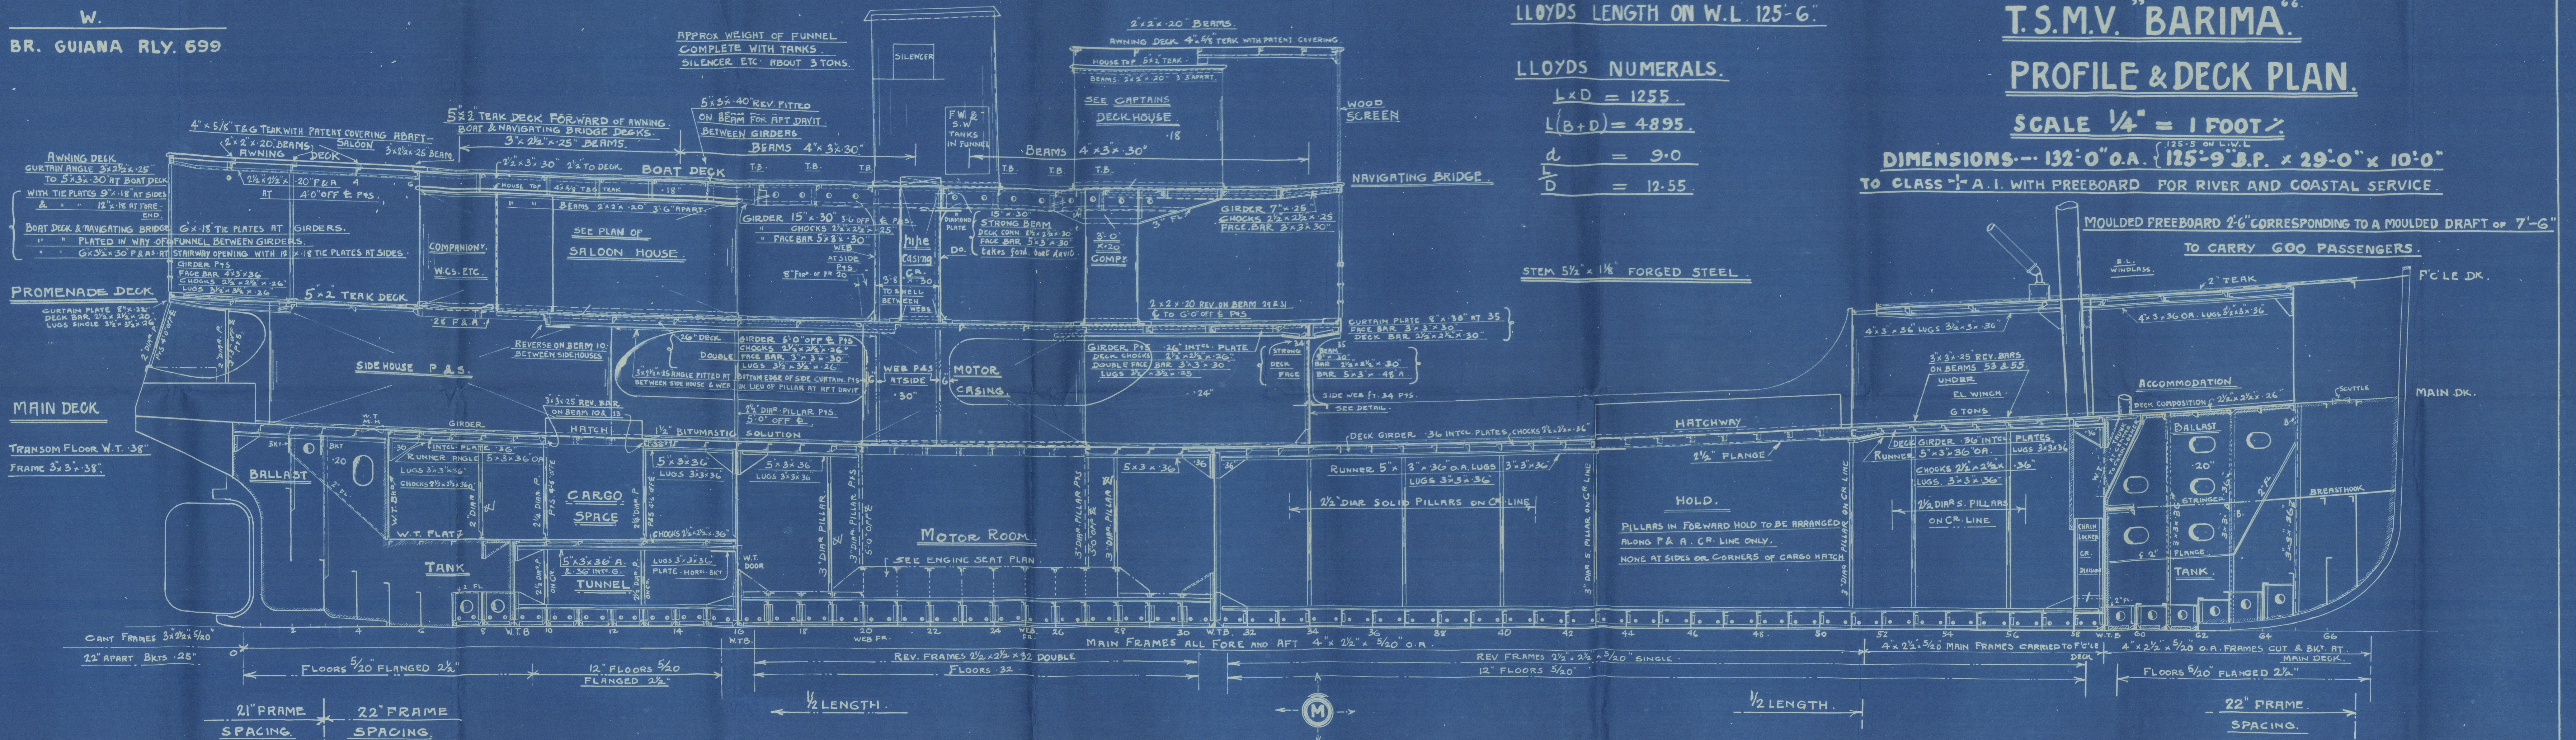

FERGUSON, BROS.  
SHIPBUILDERS & ENGINEERS  
PORT-GLASGOW, LTD.

YARD NO. 340  
PLAN NO.  
14/5/38  
J.M.C.



Luxmoor Bros (Port Glasgow) Ltd  
U.S. Barina Lord No 340  
Profile & Deck Plan  
as built

"Barina"

Genl. List Entry  
Report No 20454.

012585 - 012590 - 0181



© 2021

Lloyd's Register  
Foundation