


D.W. 15,000 TONS CARGO BOAT. M.S. "NISSHUNMARU" GENERAL ARRANGEMENT.

SCALE $\frac{1}{200}$

PRINCIPAL PARTICULARS.
LENGTH (B.P.) 153.000
BREADTH (M.S.) 21.000
DEPTH (C.L.) 11.500
LOAD DRAUGHT (EXT.) 9.998 m
GROSS TONNAGE 6255.42
NET TONNAGE 5998.14
DEAD WEIGHT 6255.42
MAIN ENGINE 131-5530 HP DIESEL
SPEED SERVICE 13.0 knots
TRIAL

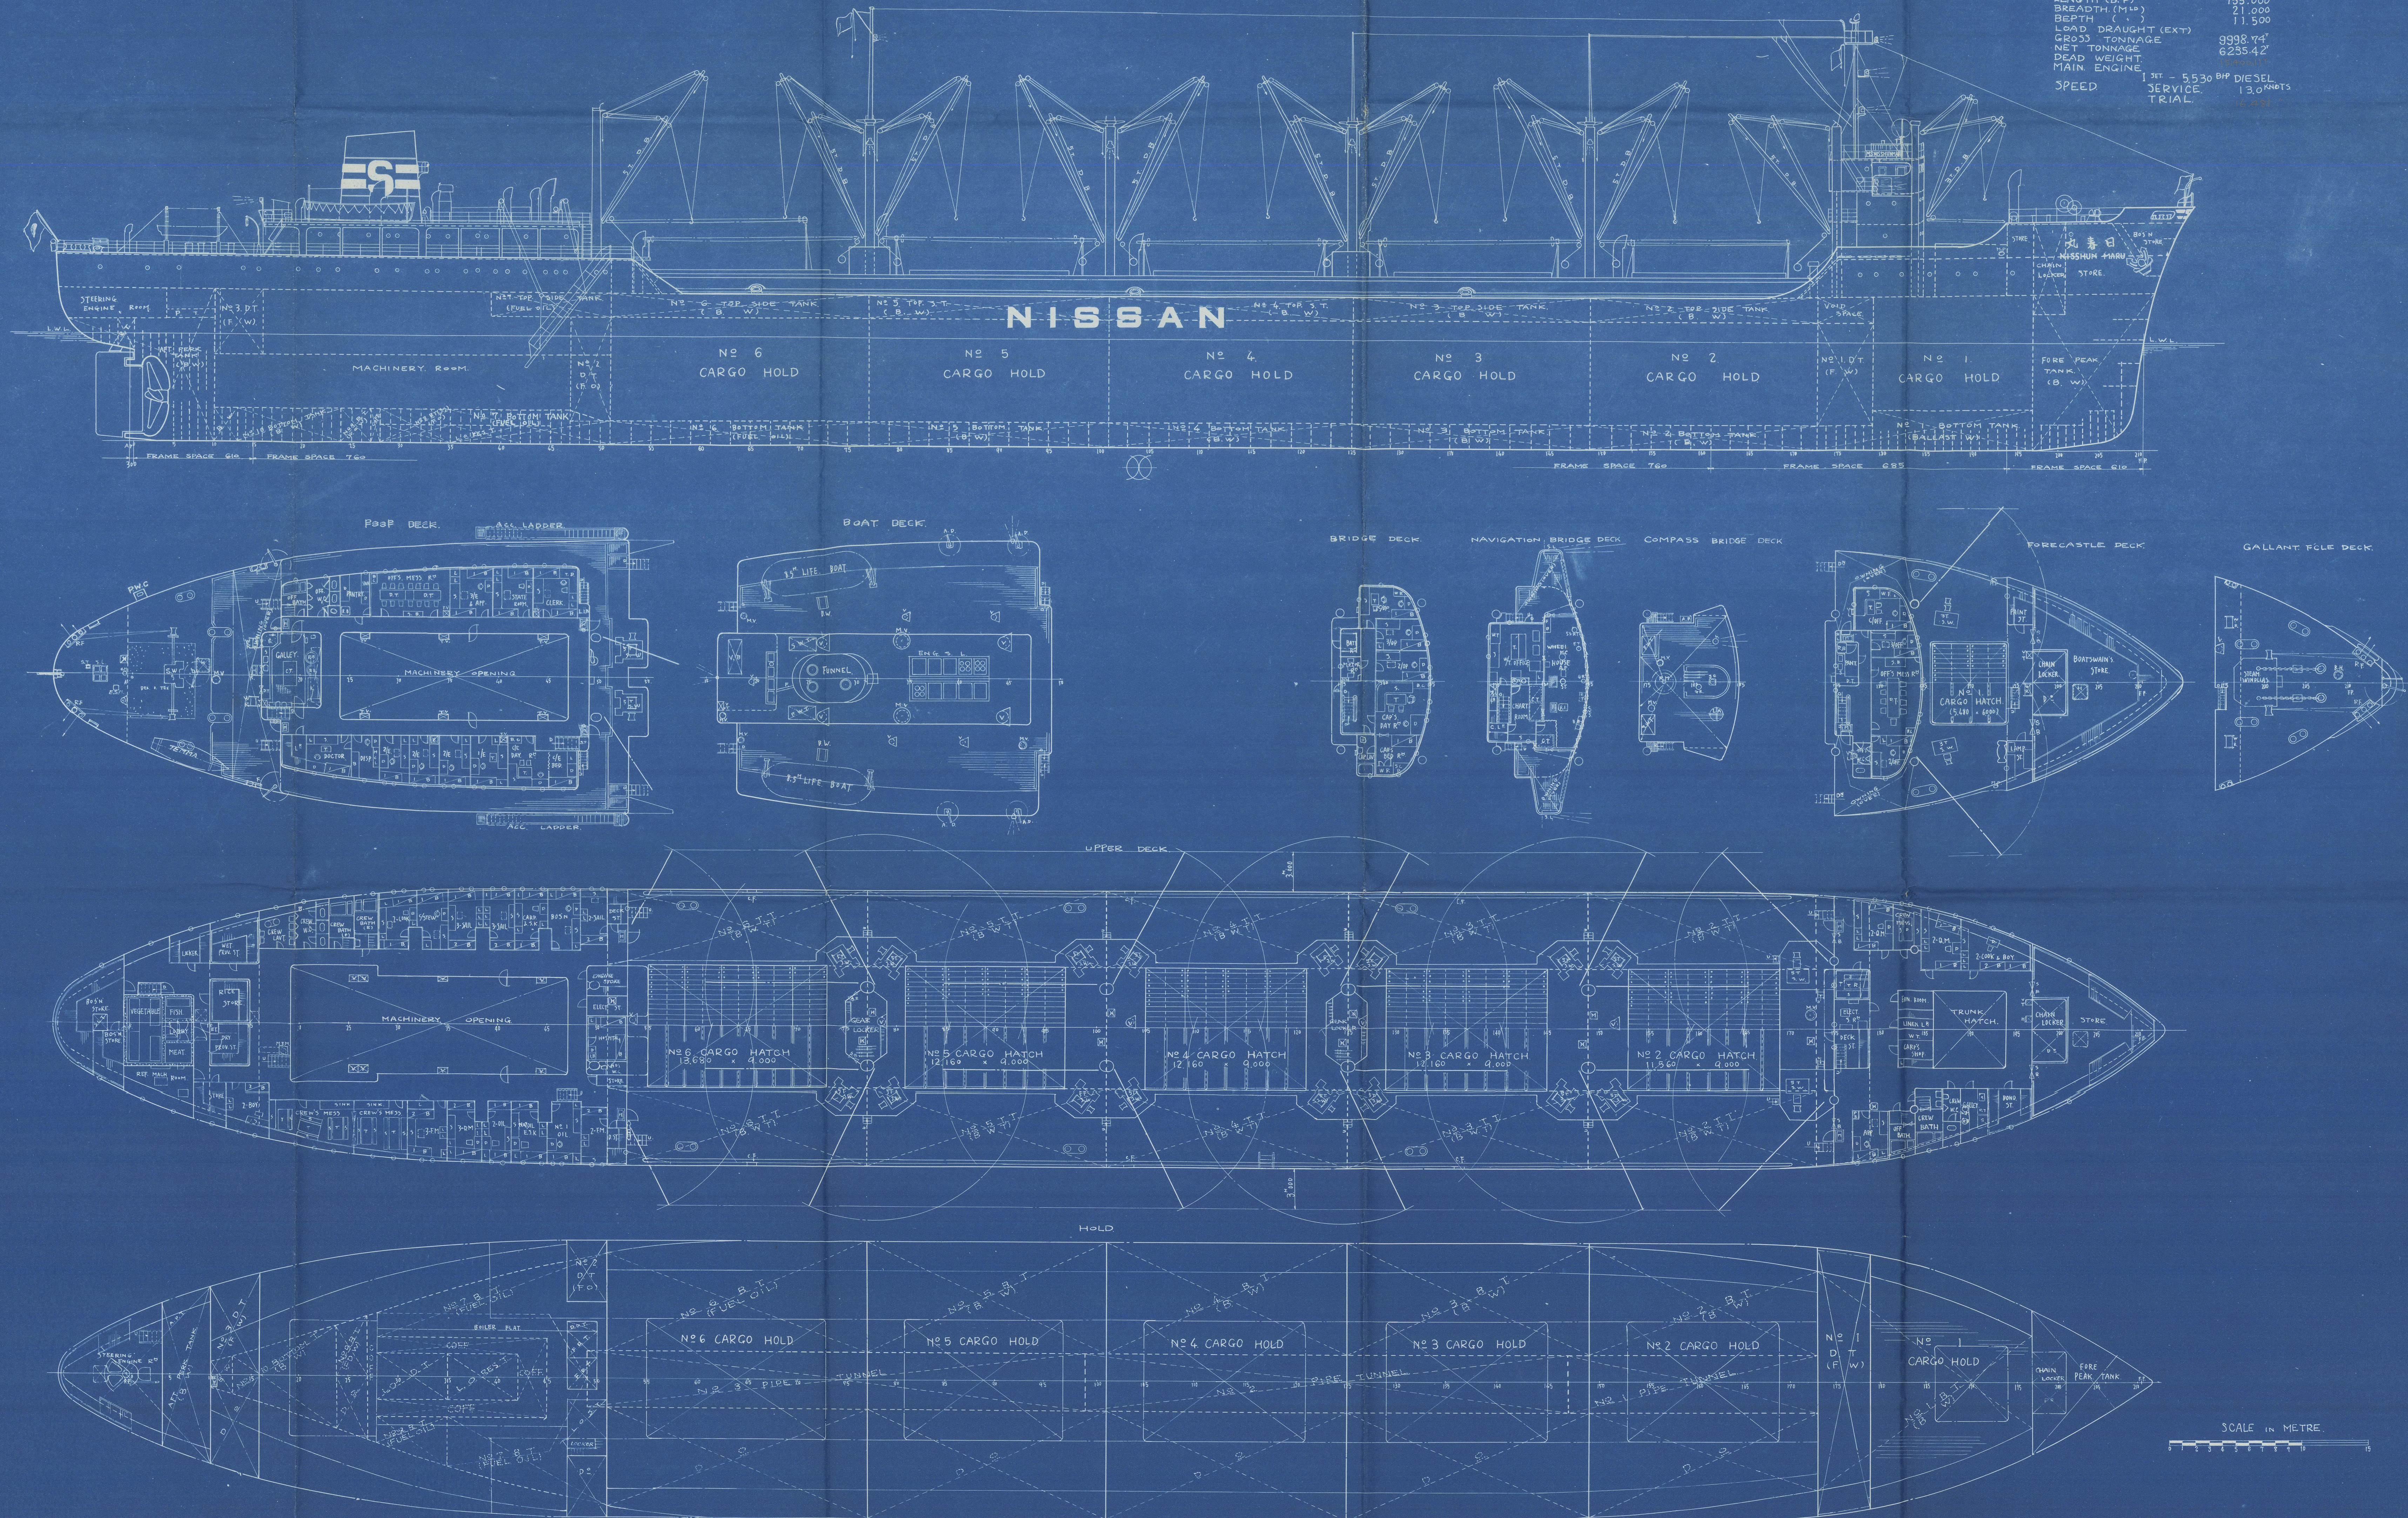

BIBLIOGRAPHY

NISSHUN-MARU

DW 15,000T.
CARGO BOAT.

GENERAL
ARRANGEMENT

SCALE $\frac{1}{200}$

FINISHED PLAN

TSURUMI
YOKOHAMA

S. Shimokita

M. Nakamura
Y. Oishi
JULY 1955

J.F.O.

012610 012612-0062

"As BUILT"


"NISSHUN MARU" ★

Yka F.E. Rpt. No. 1723.



RECORDS DEPT.
LONDON.

General
arrangement

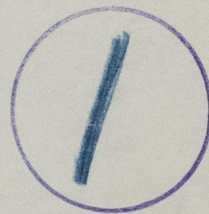

© 2021

Lloyd's Register
Foundation

012610-012612-0062