


1) DESIGNED BY SHIMIZU  
SHIPYARD N.S.T. CO. LTD.

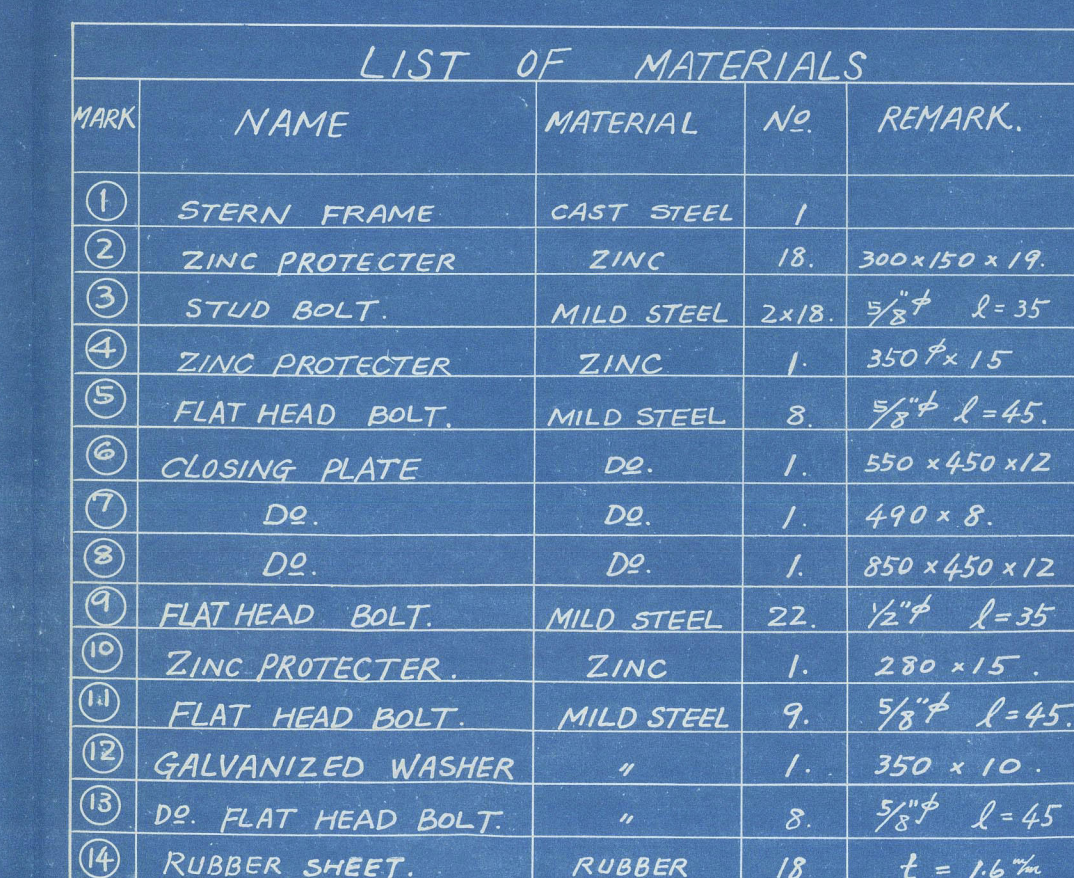

① IS TO BE TESTED AND CERTIFICATED BY "LLOYD'S REGISTER OF SHIPPING" AND "NIPPON KAIJI KYŌKAI" AND SOCIETIES' MARKS ARE TO BE STAMPED ON THEM AND MANUFACTURER'S NAME IS CAST ON.

1. THIS PLAN SHOWS FINISHED DIMENSIONS.
2. FINISHING MARK.
- |    |                 |
|----|-----------------|
| ▽▽ | FINE FINISH     |
| ▽▽ | ORDINARY FINISH |
| ▽  | ROUGH FINISH    |
| ~  | SMOOTH SURFACE  |
3. \* MARKED DIMENSIONS SHOW THE NORMAL SECTION FOR BOUNDARY LINE.
4. DESIGNED FOR 13.5 KT. SEA SPEED.

NISSHUN-MARU.

D. W. 15.000 TONS TYPE  
DIESEL CARGO BOAT

STERN FRAME.

SCALE  $\frac{1}{25}$ .  $\frac{1}{10}$ .

### FINISHED PLAN

NIPPON STEEL TUBE CO., LTD.  
SHIMIZU SHIP-YARD  
SHIMIZU, JAPAN

HULL DEPT  
DESIGNING SECTION

CHIEF OF NULL DEPT

CHIEF DESIGNER S. Shimokubo  
APPROVED BY

APPROVED BY \_\_\_\_\_  
CHECKED BY \_\_\_\_\_

DESIGNED BY: \_\_\_\_\_



FINISHED PLAN

LLOYDS




M.V. NISSHUN MARU

As Built

YKA. FE. ~~NO.~~ NO. 1723

Certified Copy of  
Approved Plan

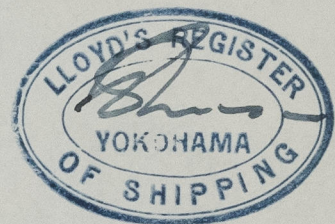

RECORDS DEPT.  
LONDON.

Stemframe



17 © 2021

Lloyd's Register  
Foundation

012610-012612-0068