

UNITED SIX.
350 TON ALL WELDED SEA-GOING BARGE
FOR SERVICE AT CHITTAGONG

SCALE $\frac{1}{2}$ " = ONE FOOT

MIDSHIP SECTION

AS BUILT

DIMENSIONS


LENGTH O.A. 115'-4"

LENGTH B.P. 106'-11"

BEAM MLD² 24'-0"

DEPTH MLD² 9'-0"

SERVICE DRAUGHT 7'-3" MLD²

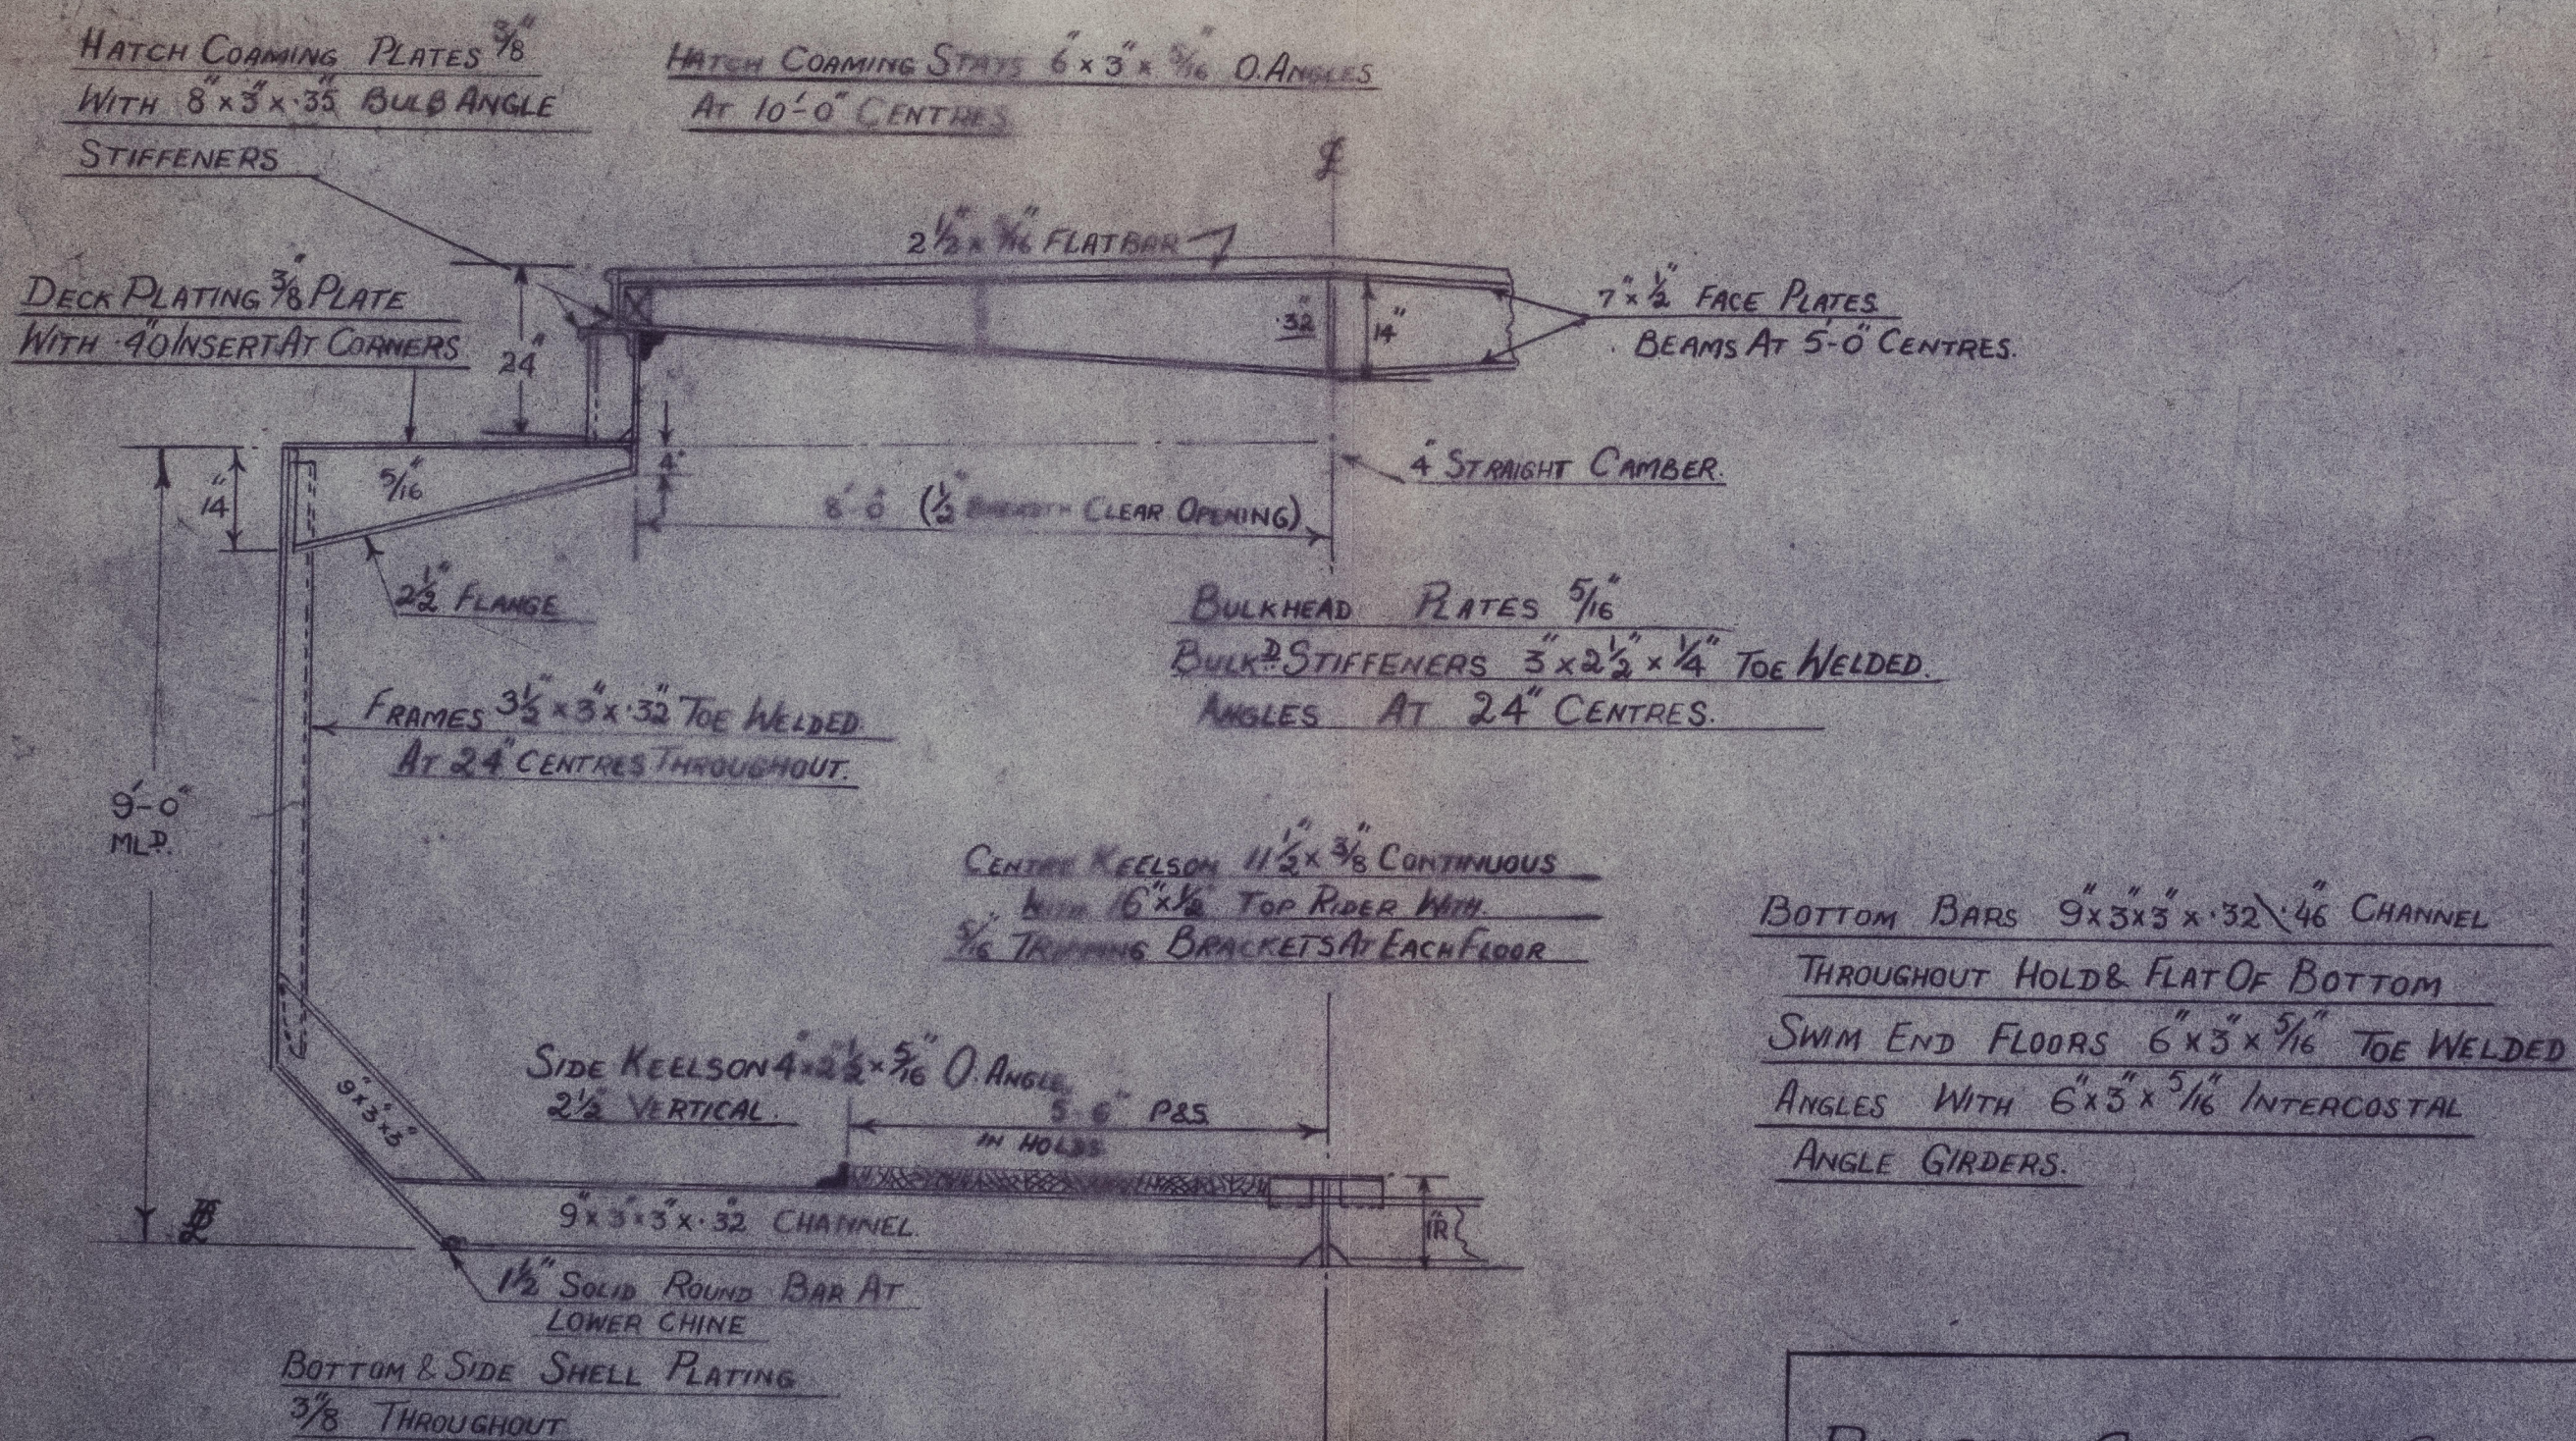

BOTTOM BARS 9"x3"x3"x32x46 CHANNEL
 THROUGHOUT HOLD & FLAT OF BOTTOM
 SWIM END FLOORS 6"x3"x5/16" TOE WELDED
 ANGLES WITH 6"x3"x5/16" INTERCOSTAL
 ANGLE GIRDERS.

BUILDERS CARSTAIRS & CUMMING LTD

DATE OF BUILD - 12-62

YARD No. -

2021
 Lloyd's Register
 Foundation
 012734-012743-0052

"UNITED SIX" ★


KRH RPT. NO. 654

Midship Section
(as built)

RECORDS DEPT.
LONDON.



© 2021

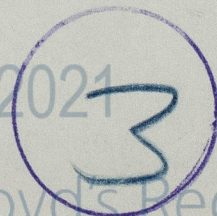

Lloyd's Register
Foundation

012734-012743-0057