


CENTRE GIRDERS TO
TRANSV. BULKHEADS

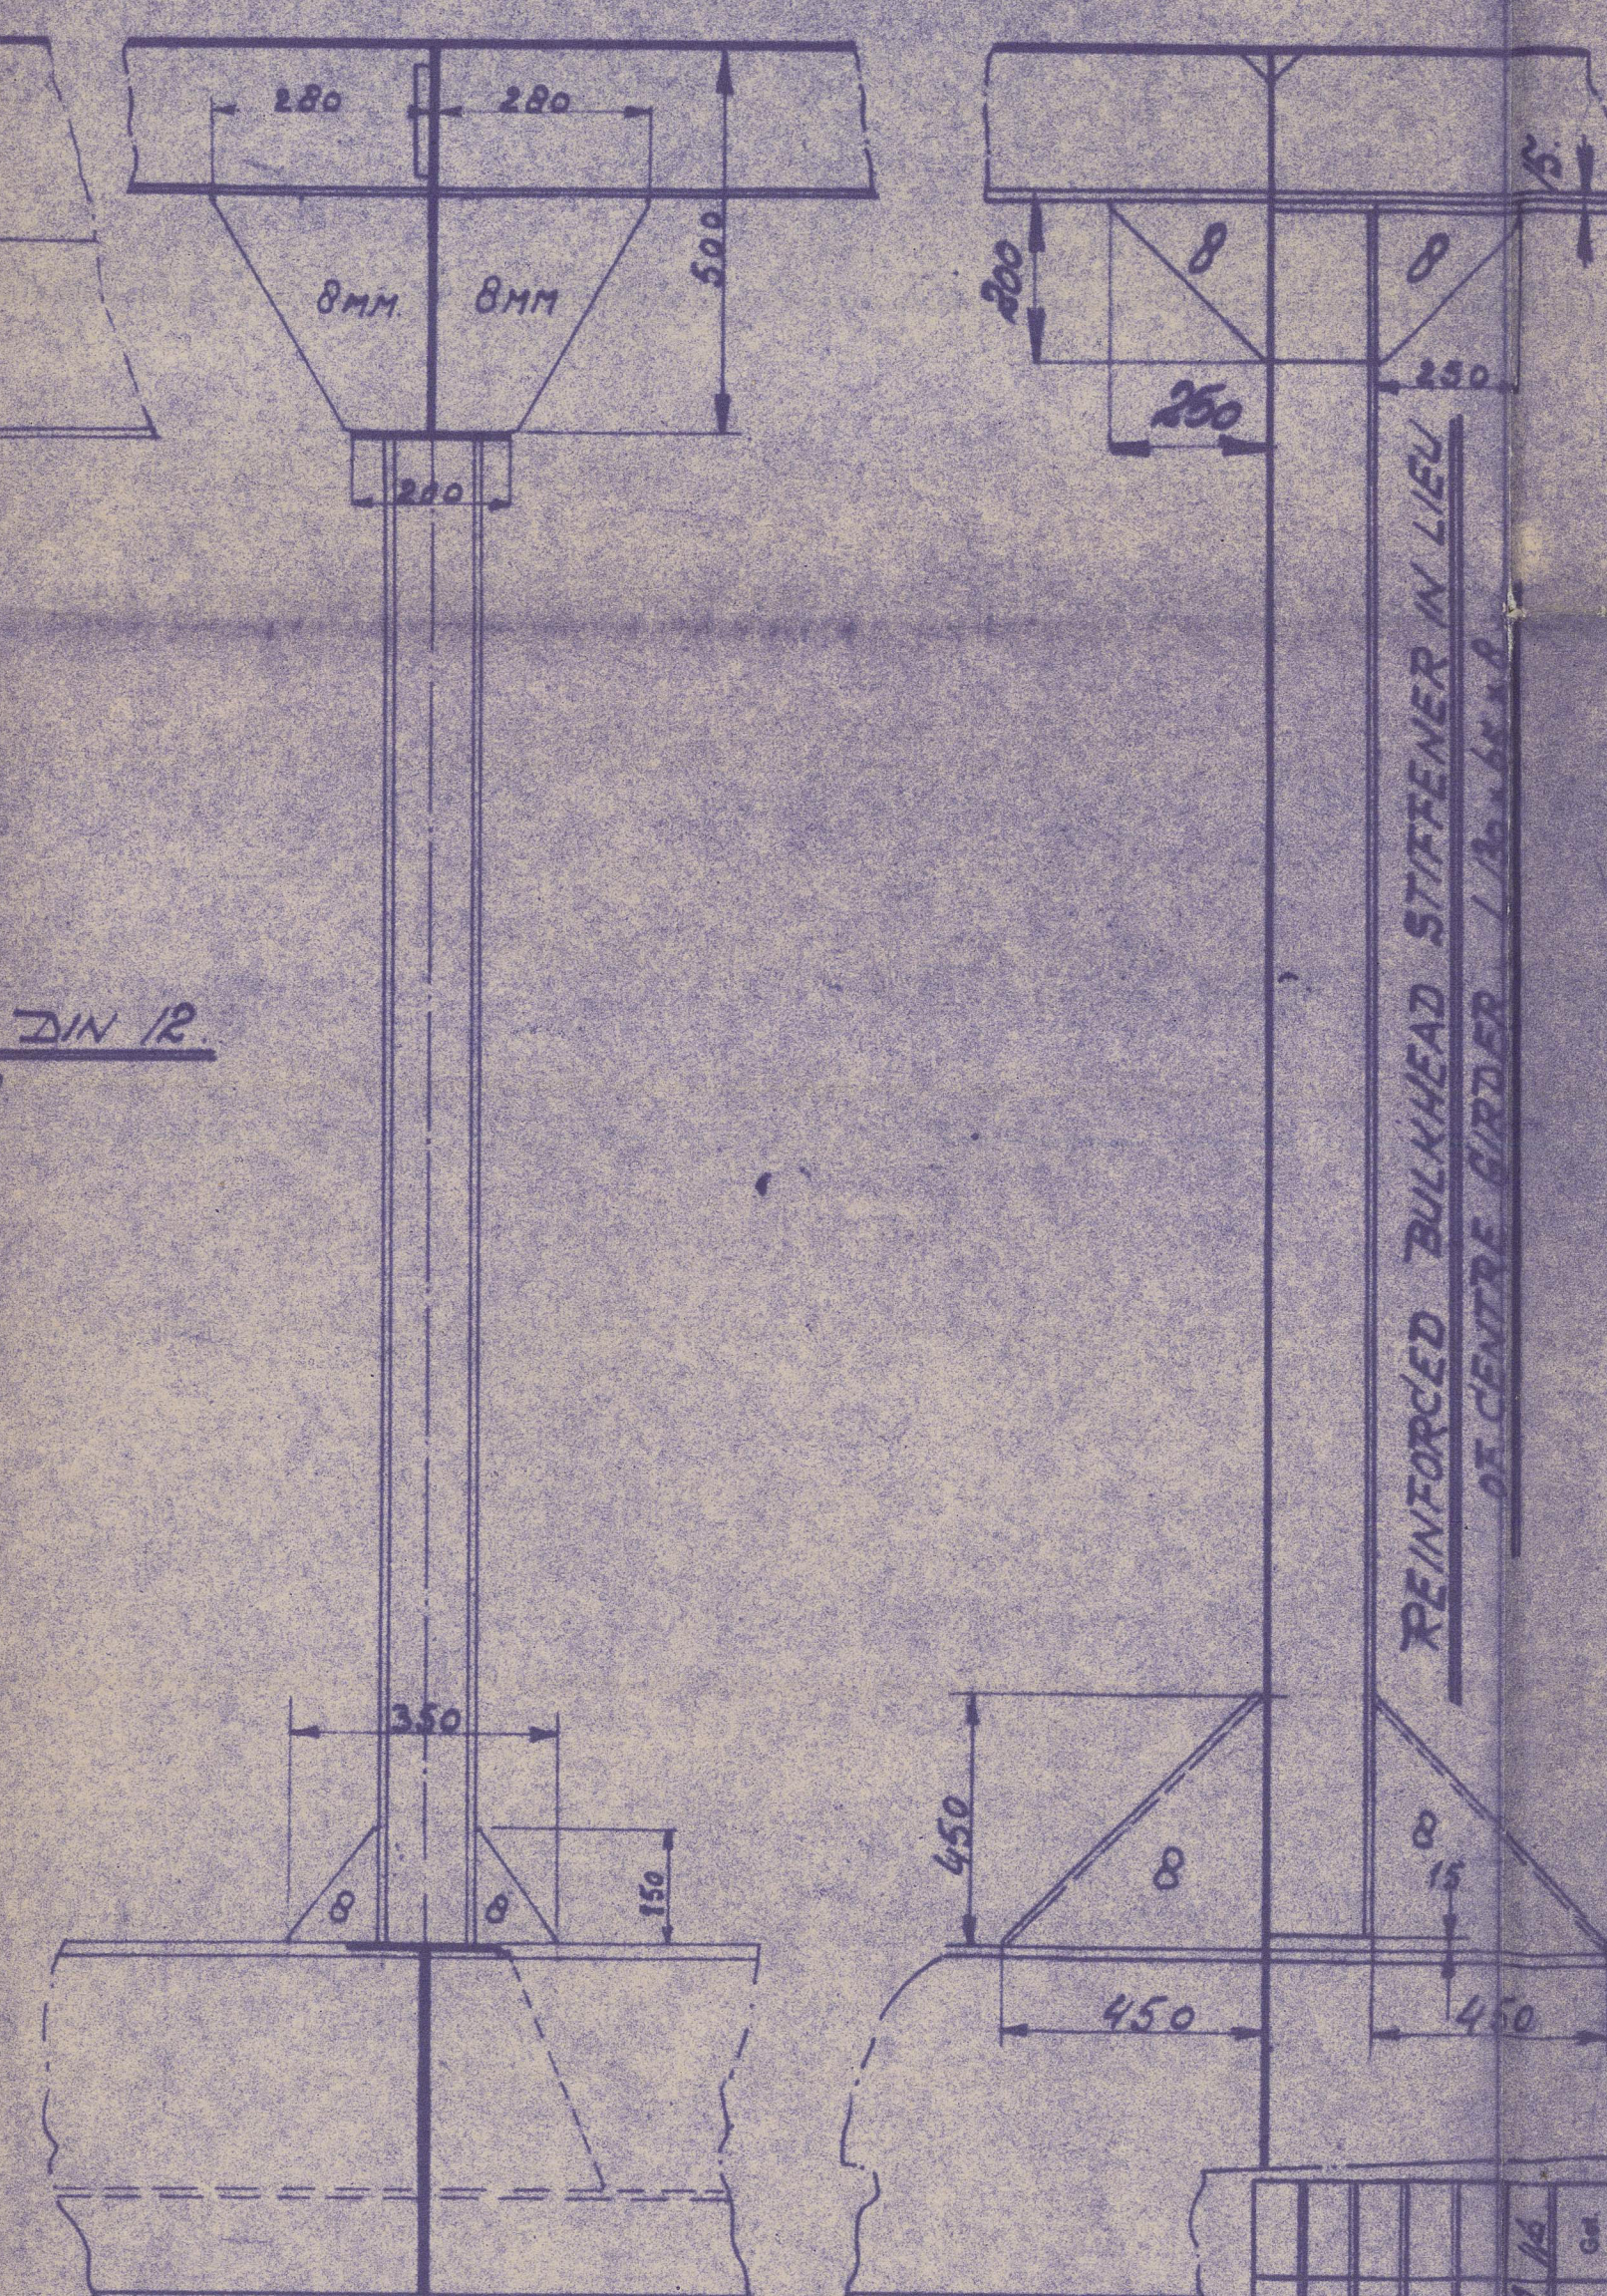

AS BUILT

FLOATING SHEERLEGS
60 TON.

	3		RELATIONS TO ROTTERDAM REPORT NO.					
	2							
	1							
POS.	Aant.	Omschrijving	Mod.	Mat.	Const.	Mech.	E.B.	
		N.A.S.			N.A.B.S.		N.A.V.	
Gr.		Korabelle Kousdon Yard No 64g-650						
Dat.								
Aant.	N. N.N.	N.V. NEDERLANDSE KRAANBOUW M.J. - UTRECHT						
School	/ / 0.	RELATIONS TO ROTTERDAM REPORT NO.					52845A 52844A	
Via		<u>1542-02.</u>						
Pm.		v Grot bewarkt						
		v Glad bewarkt						
		v v v Zeer old lev.						
		MIDSHIP SECTION						

MIDSHIP SECTION

RECORDS DEPT.
LONDON.



yesclitmak II



midship Section.



© 2021

Lloyd's Register
Foundation

012875-012881-0238