



LLOYD'S PLAN  
AS BUILT

# S. S. "EUDUNDA" SHIP NO 35.

## PROFILE & DECK PLANS.



SCALE: 1/8" = ONE FOOT.

DIMENSIONS - LENGTH B.P. 331' x 47'-9" x 26'-1" MLD. TO UPPER DECK.  
LHERWOOD SYSTEM [PATENT]

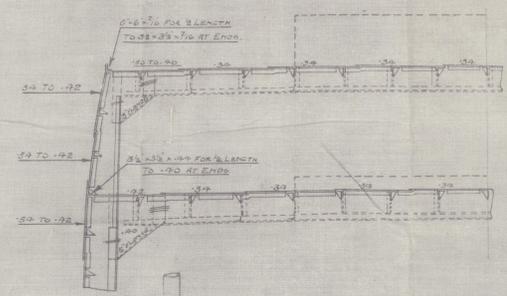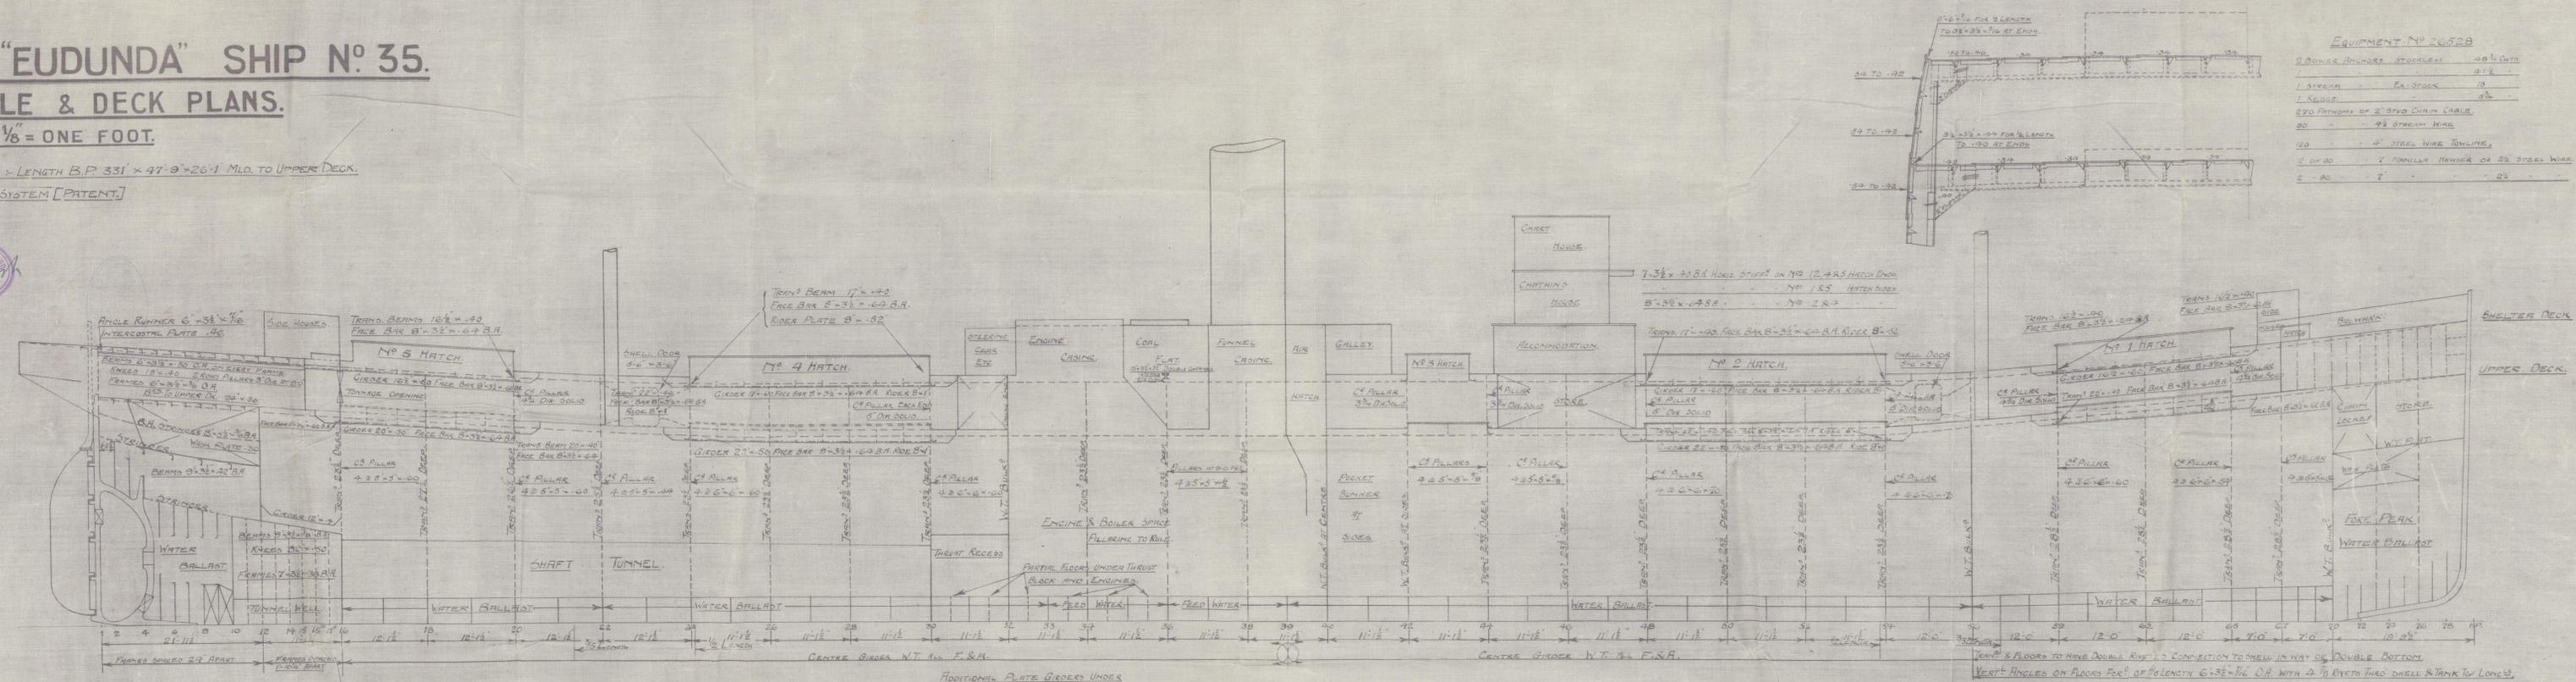

EQUIPMENT NO 26528

2 BINDER BRACKETS STOCKS	20 1/2
1 SHREIN	EX STOCK
1 SLOPE	EX STOCK
270 PATTERNS OF 2" STOD CHAIN CABLE	3 1/2
20	1/2" STEEL WIRE
100	1/2" STEEL WIRE TOWLINE
2 OF 20	1" MANILLA HANGER OR 2" STEEL WIRE
5 - 20	7

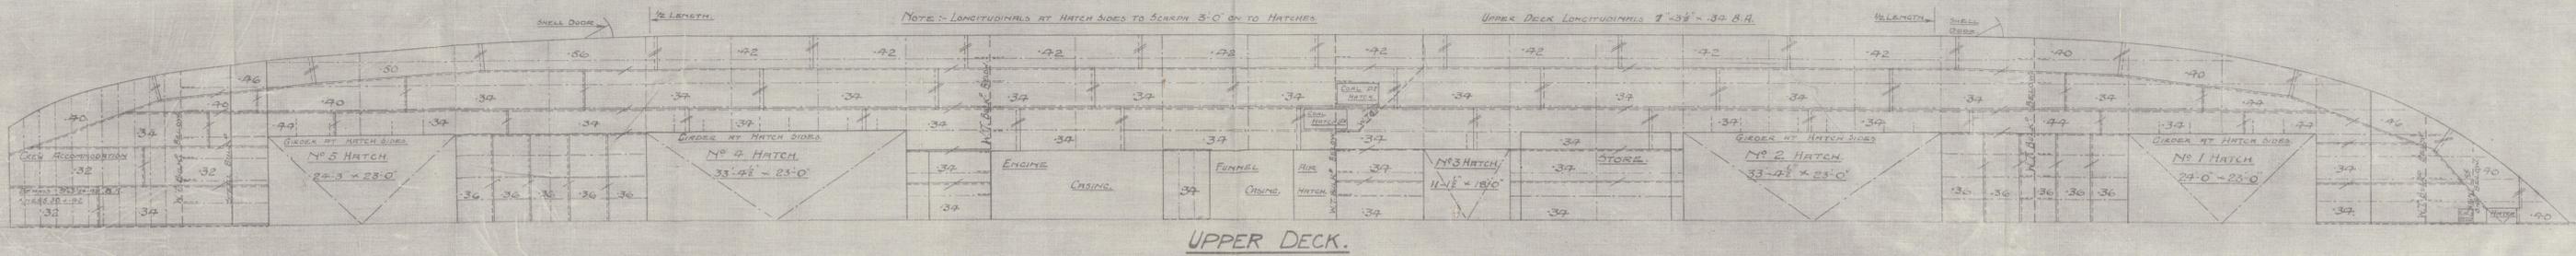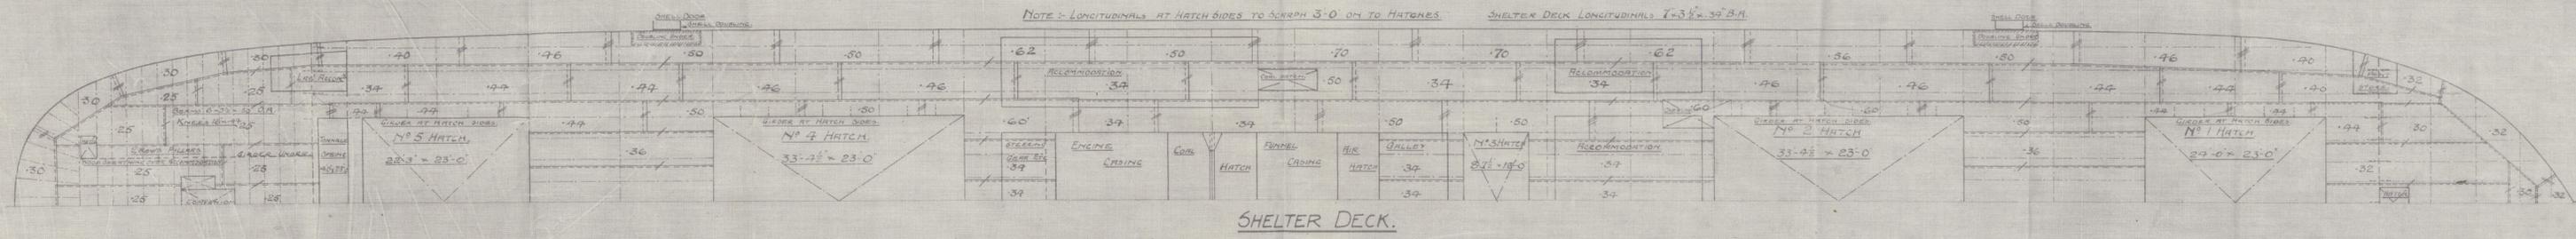

"EUDUNDA"

Cockatoo Naval  
Docks

N<sup>o</sup> 35.



PROFILE, +  
DECKS.

Syd. 6732

Mangola \*



© 2021

013346-013355-0278

Lloyd's Register  
Foundation