

UNITED FOUR

350 TON SEAGOING BARGE

(ALL WELDED) FOR SERVICE AT CHITTAGONG



SCALE $\frac{1}{8}$ " & $\frac{1}{4}$ " = ONE FOOT

AS BUILT GENERAL ARRANGEMENT


DIMENSIONS L.O.A. - 115'-4"
 MOULDED L.B.P. - 106'-11"
 " BEAM - 24'-0"
 " DEPTH - 9'-0"
 DRAUGHT - 7'-3"



Attach to KRH Report No. 174

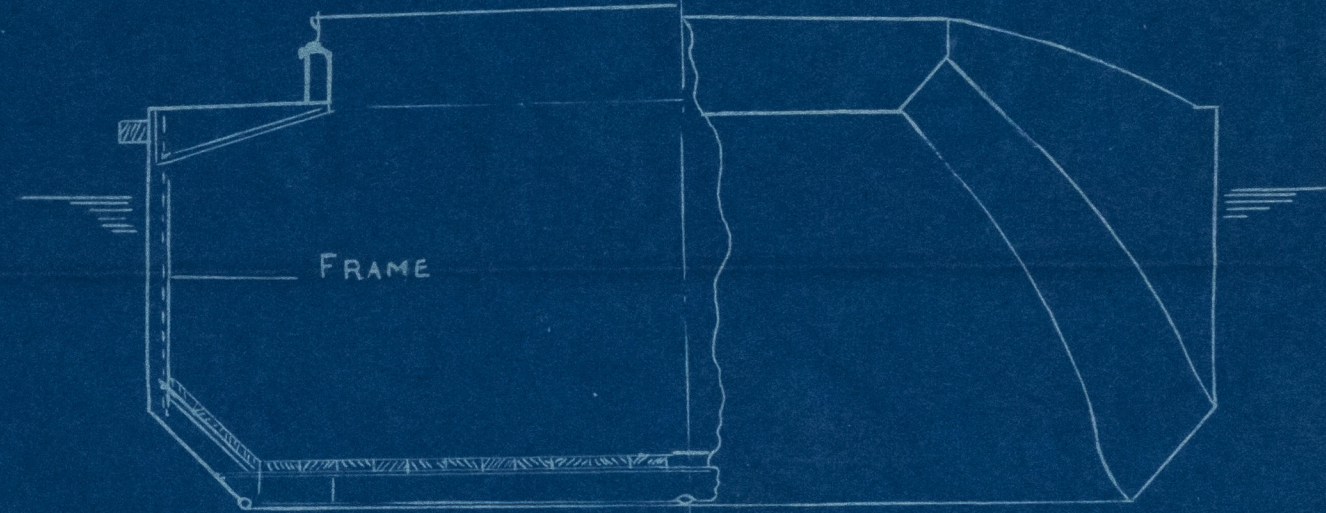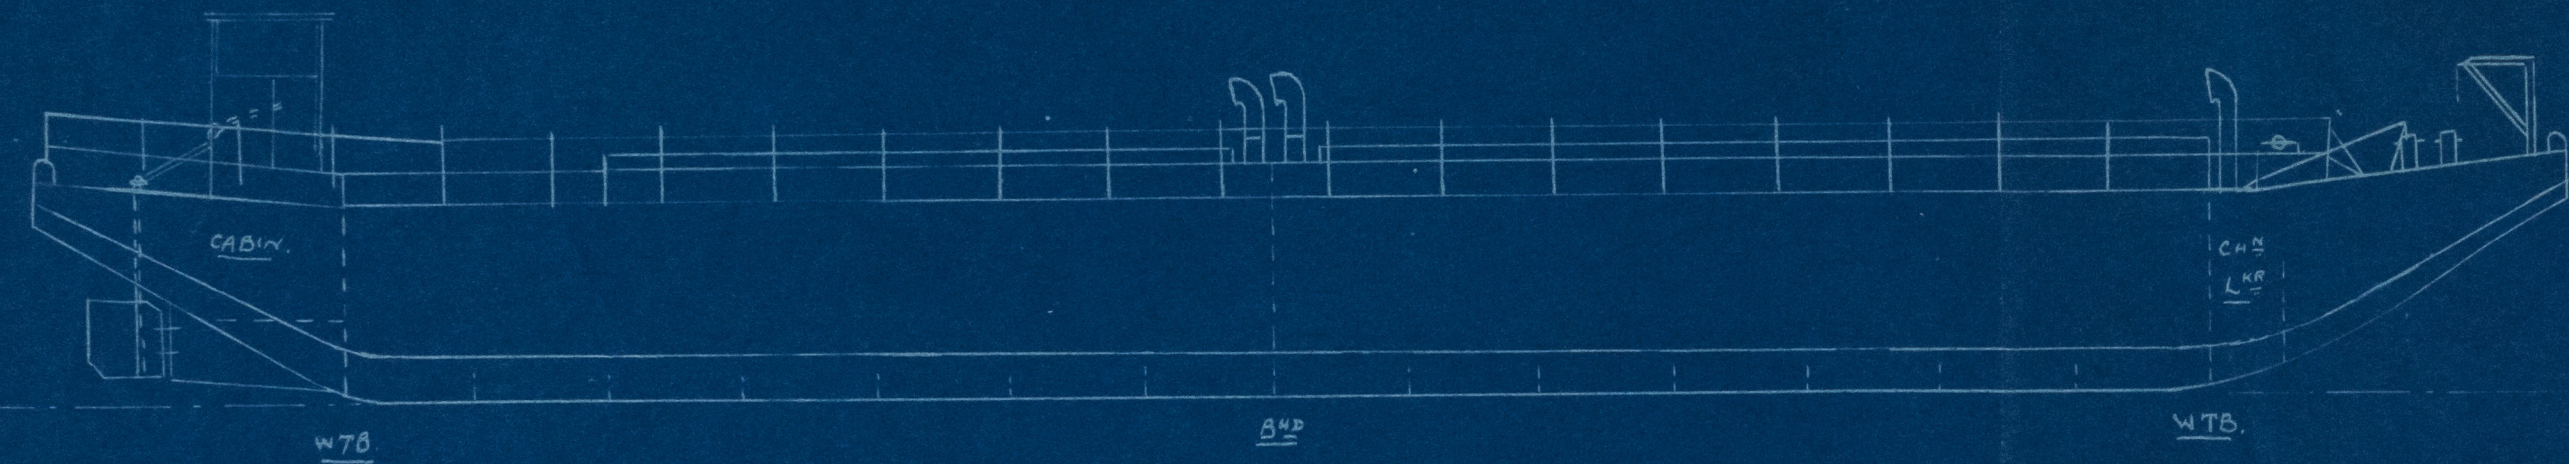

TYPICAL SECTIONS THRO'
 HOLD & FORE END.

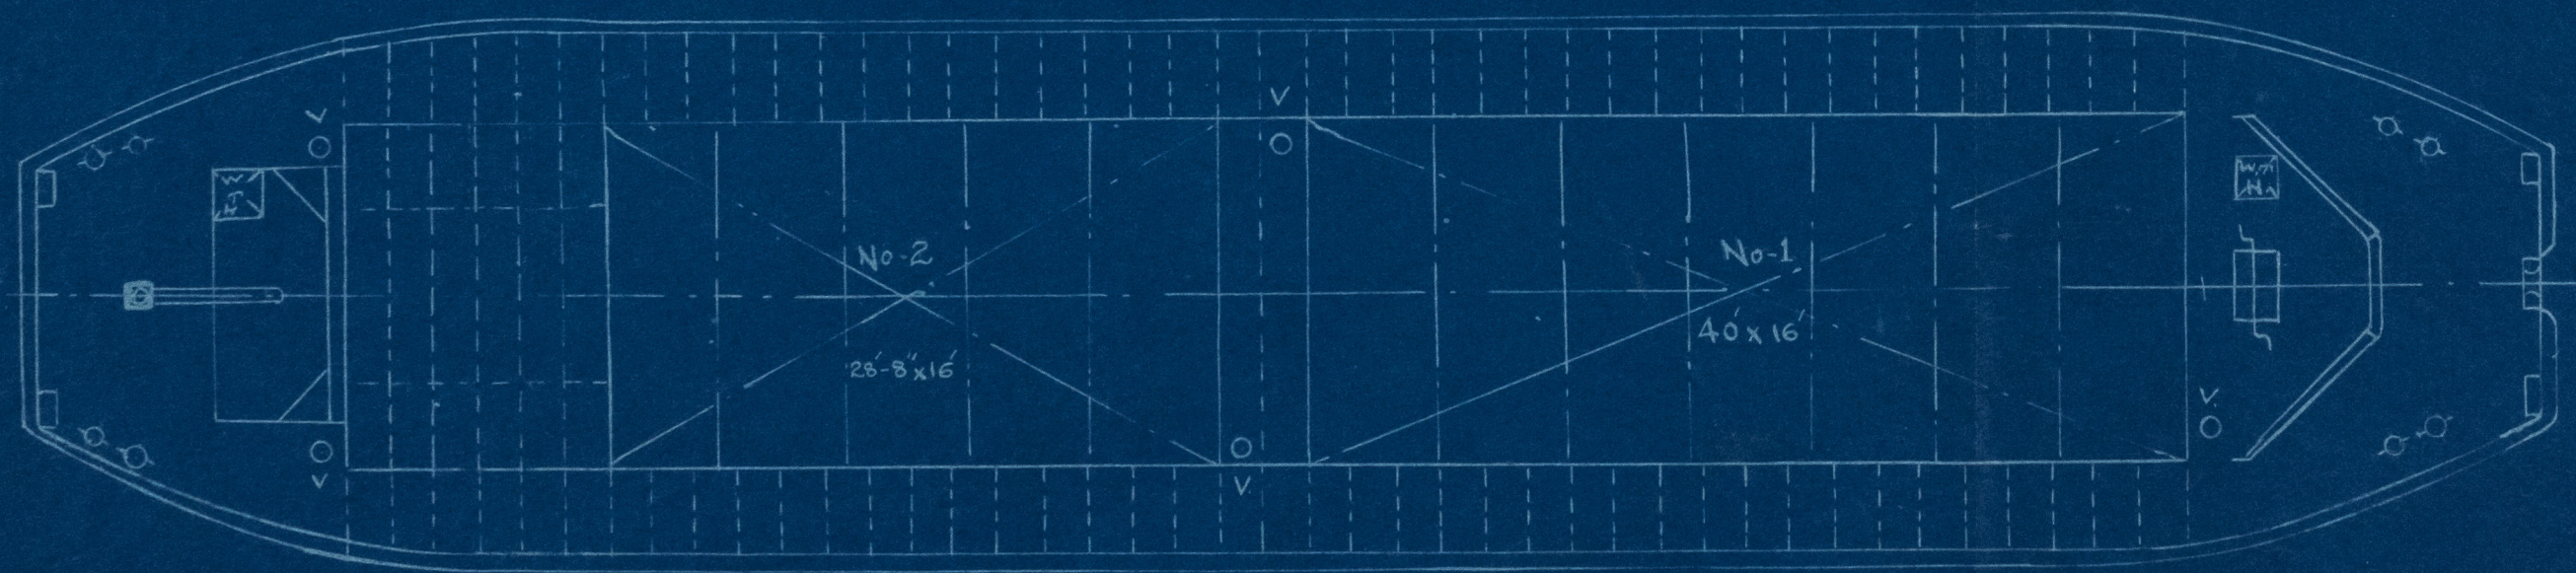

12.4.64

| | |
|---------------|---------------------|
| BUILDERS | C & C LTD. KARACHI. |
| DATE OF BUILD | |
| YARD No | C & C LTD. |