

UNITED FOUR
350 TON ALL WELDED SEA-GOING BARGE
FOR SERVICE AT CHITTAGONG

SCALE $\frac{1}{2}$ " = ONE FOOT

MIDSHIP SECTION


AS BUILT

DIMENSIONS

LENGTH O.A. 115'-4"
 LENGTH B.P. 106'-11"
 BEAM MLD^d 24'-0"
 DEPTH MLD^d 9'-0"
 SERVICE DRAUGHT 7'-3" MLD^d

*Confirmed to accommodate with
 approved arrangements.*

Added to KRA 174

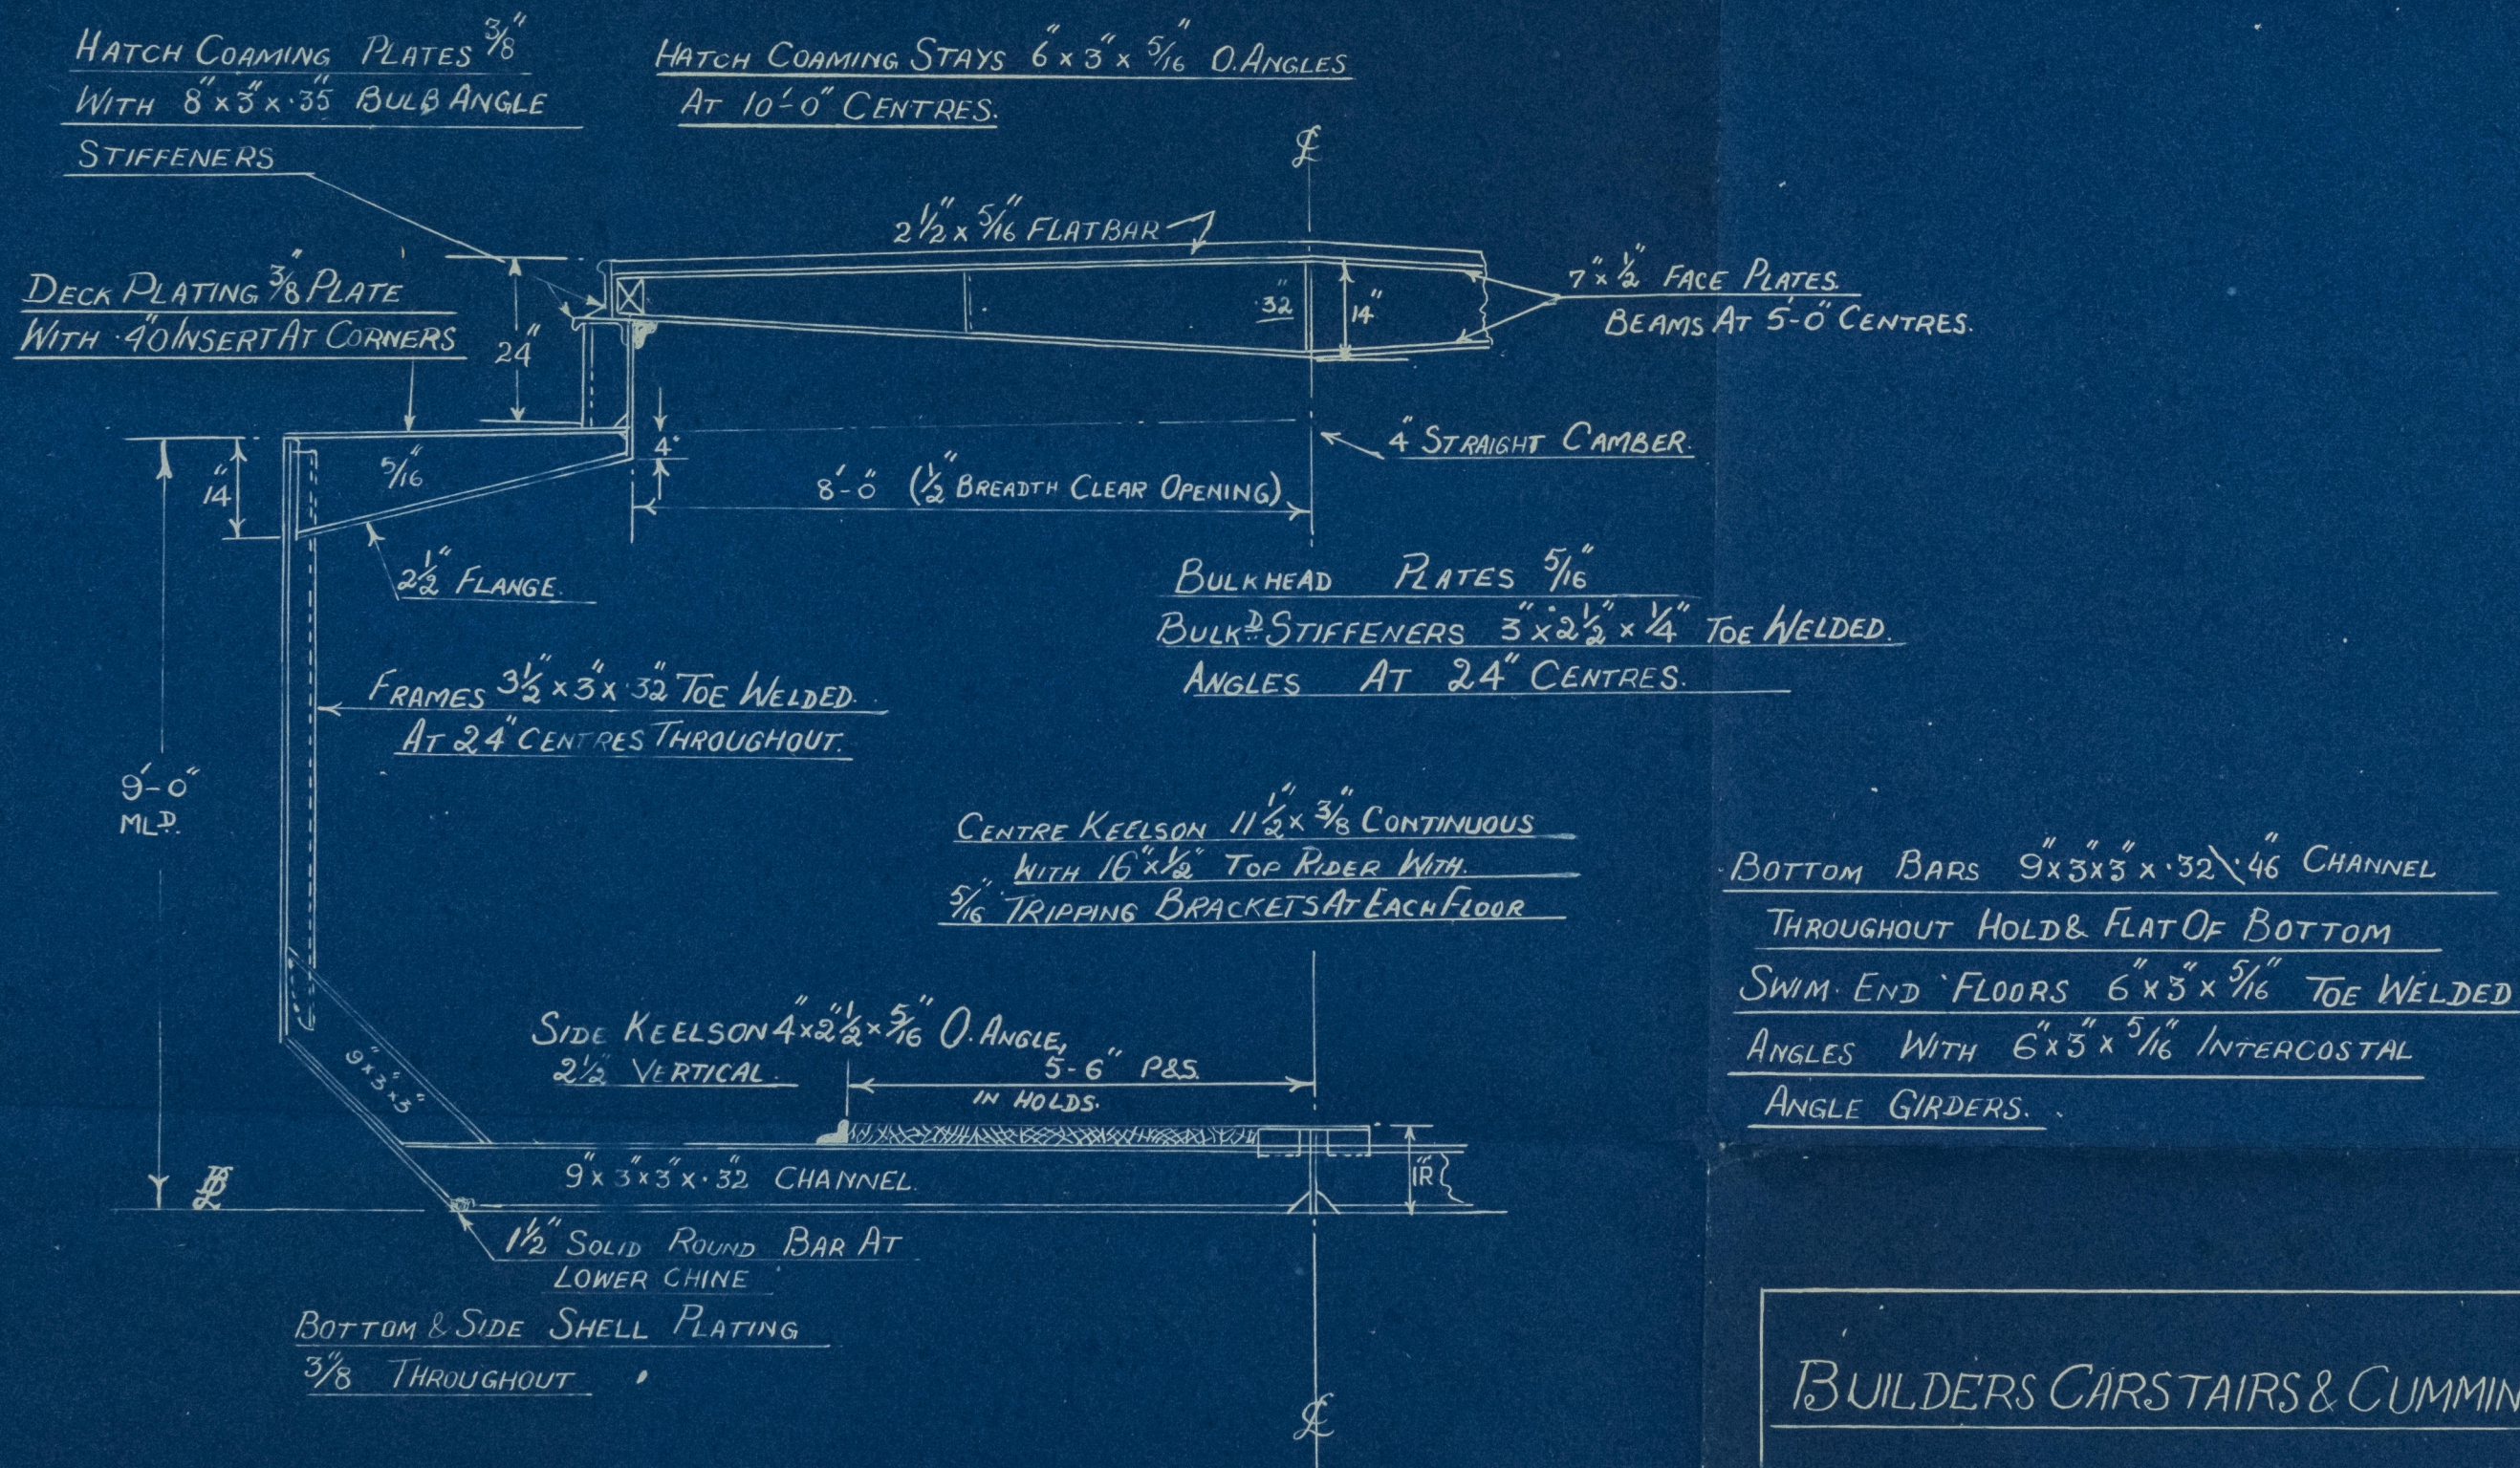

BUILDERS CARSTAIRS & CUMMING LTD

DATE OF BUILD 12-62

YARD No

C. & C.