

"UNITED FOUR"










350 TON ALL WELDED SEAGOING BARGE.

SHELL EXPANSION & DETAILS OF
SWIM END SECTIONS.

SCALES $\frac{1}{2}$ " $\frac{1}{4}$ " = ONE FOOT

AS BUILT

Constructed in accordance with approved anqts.

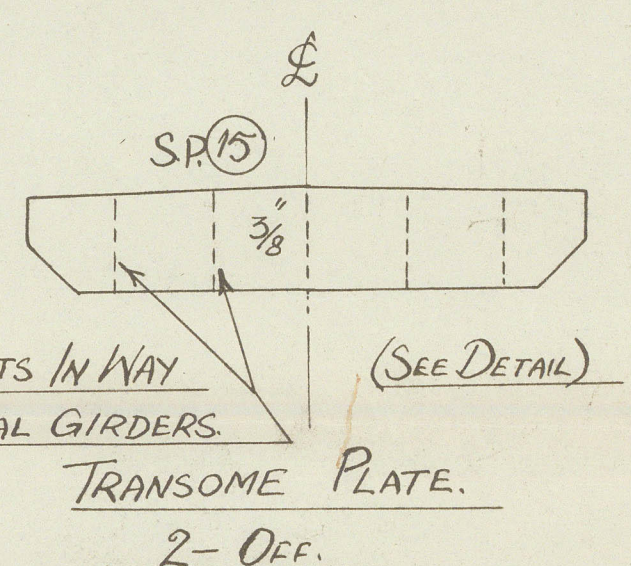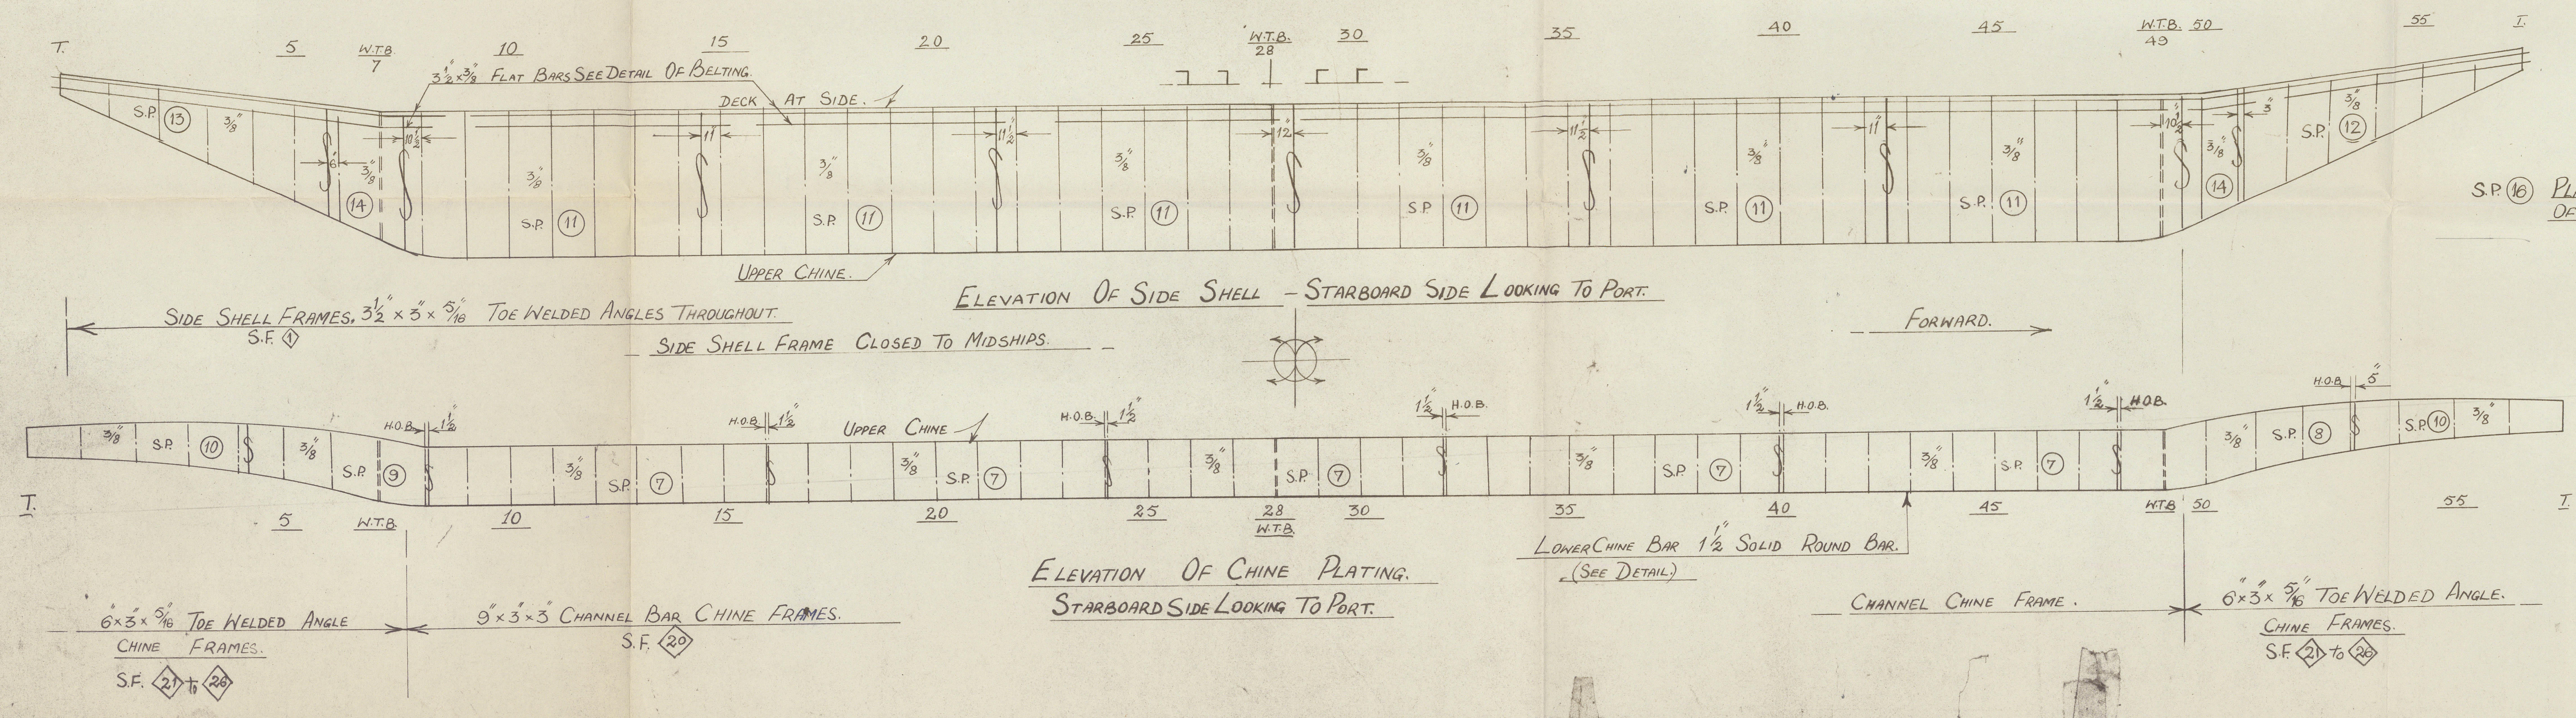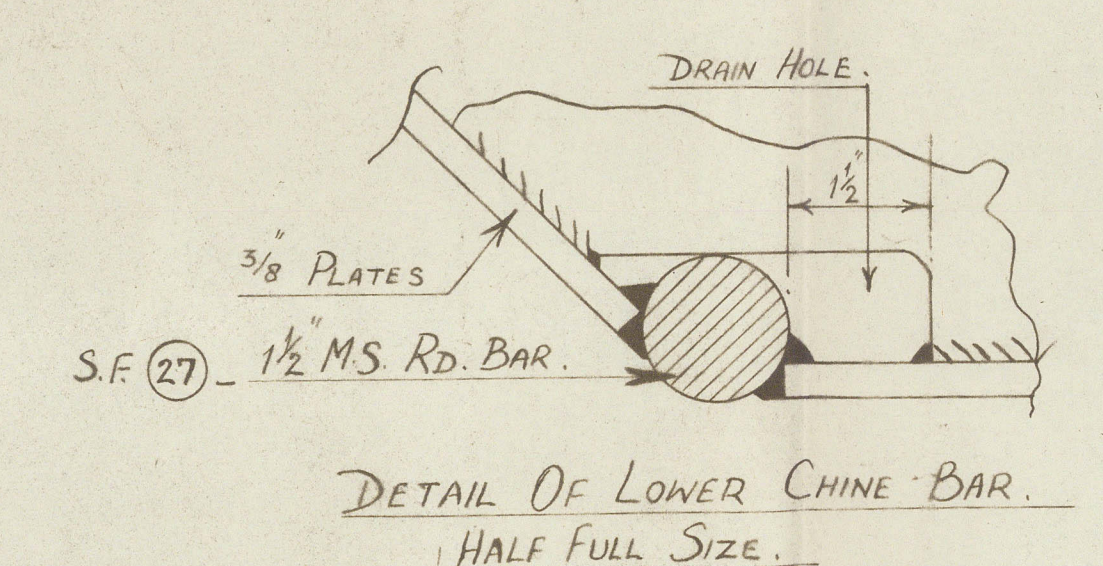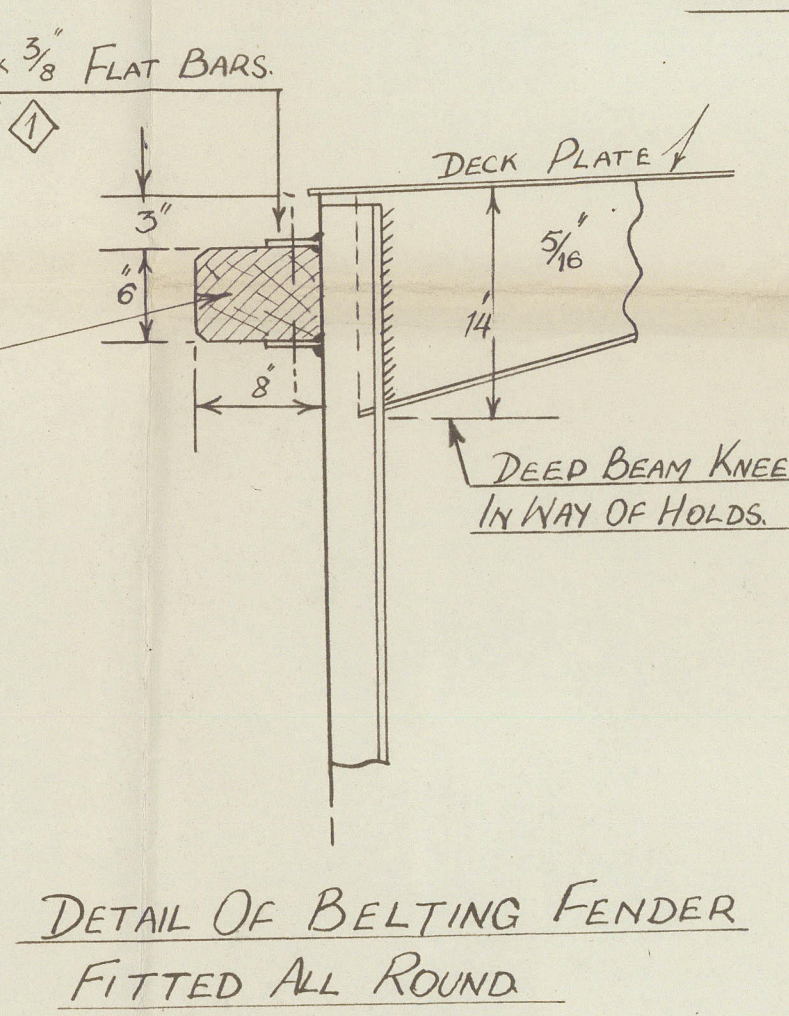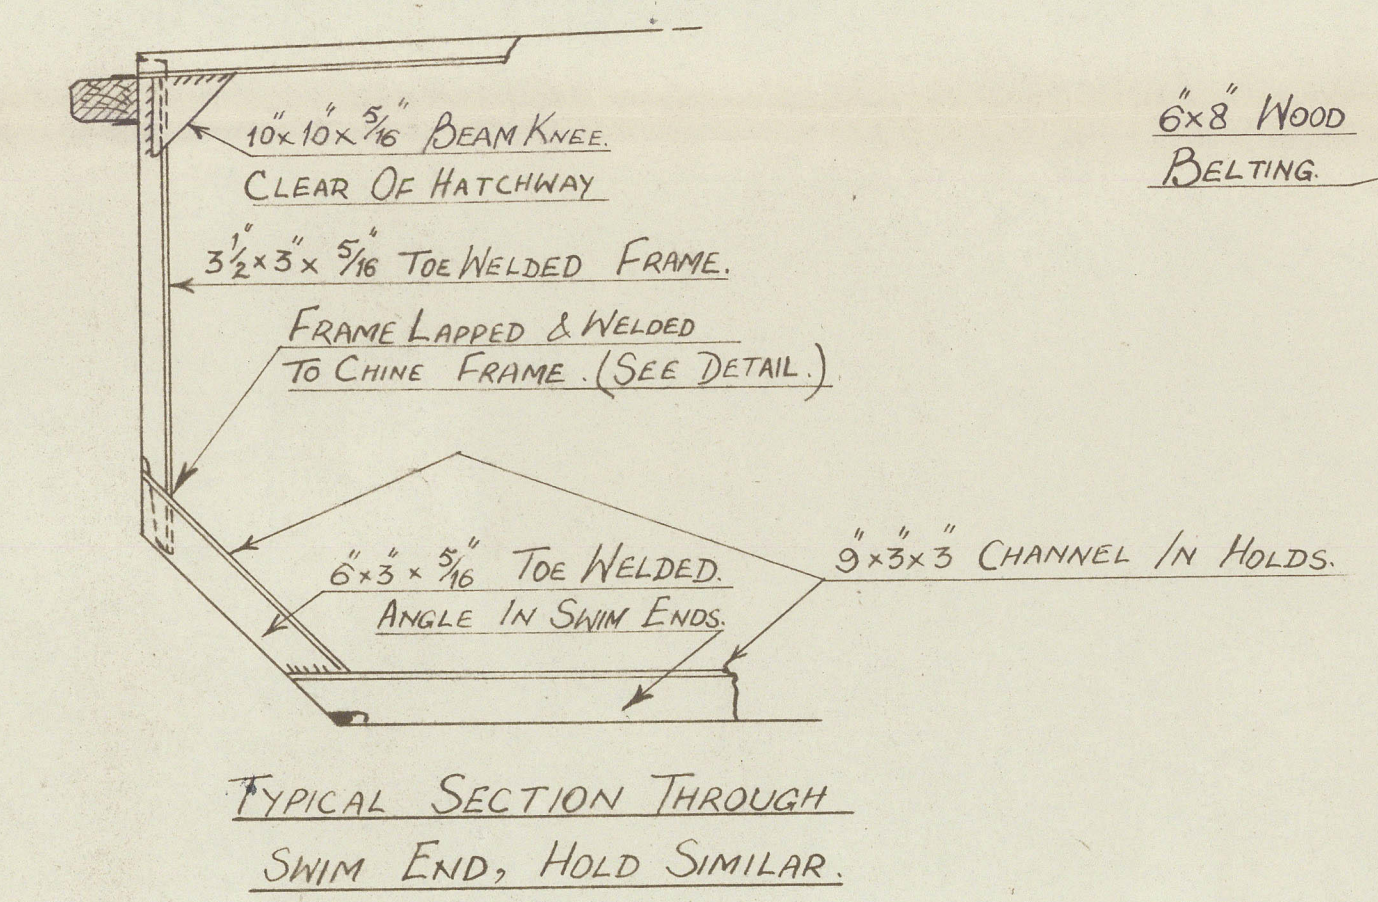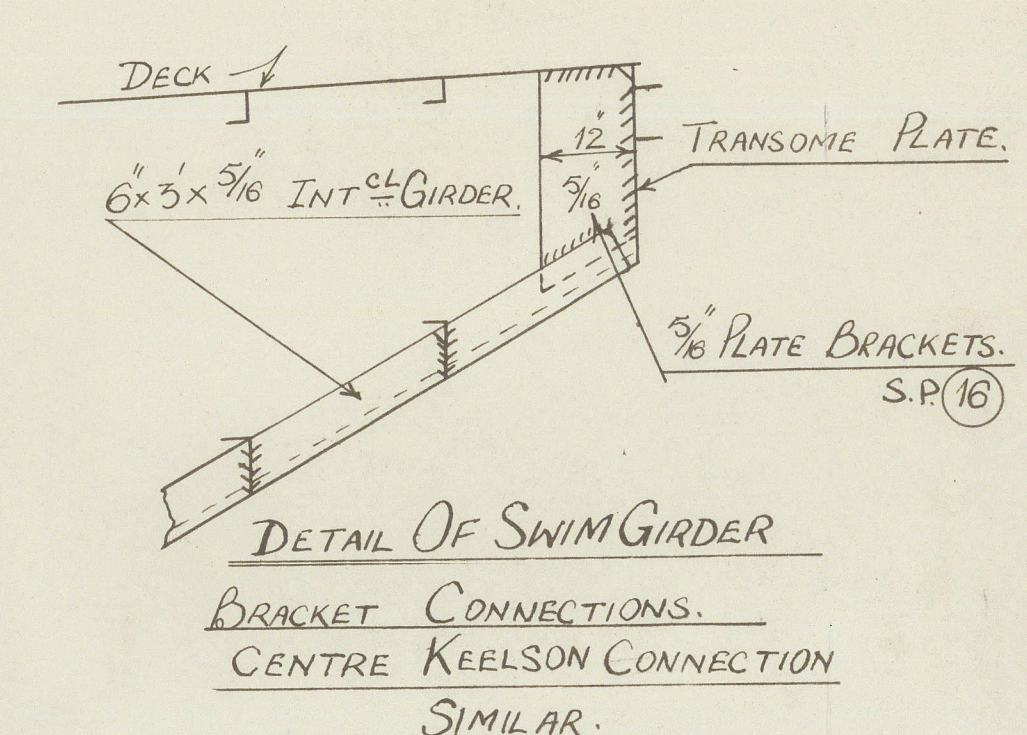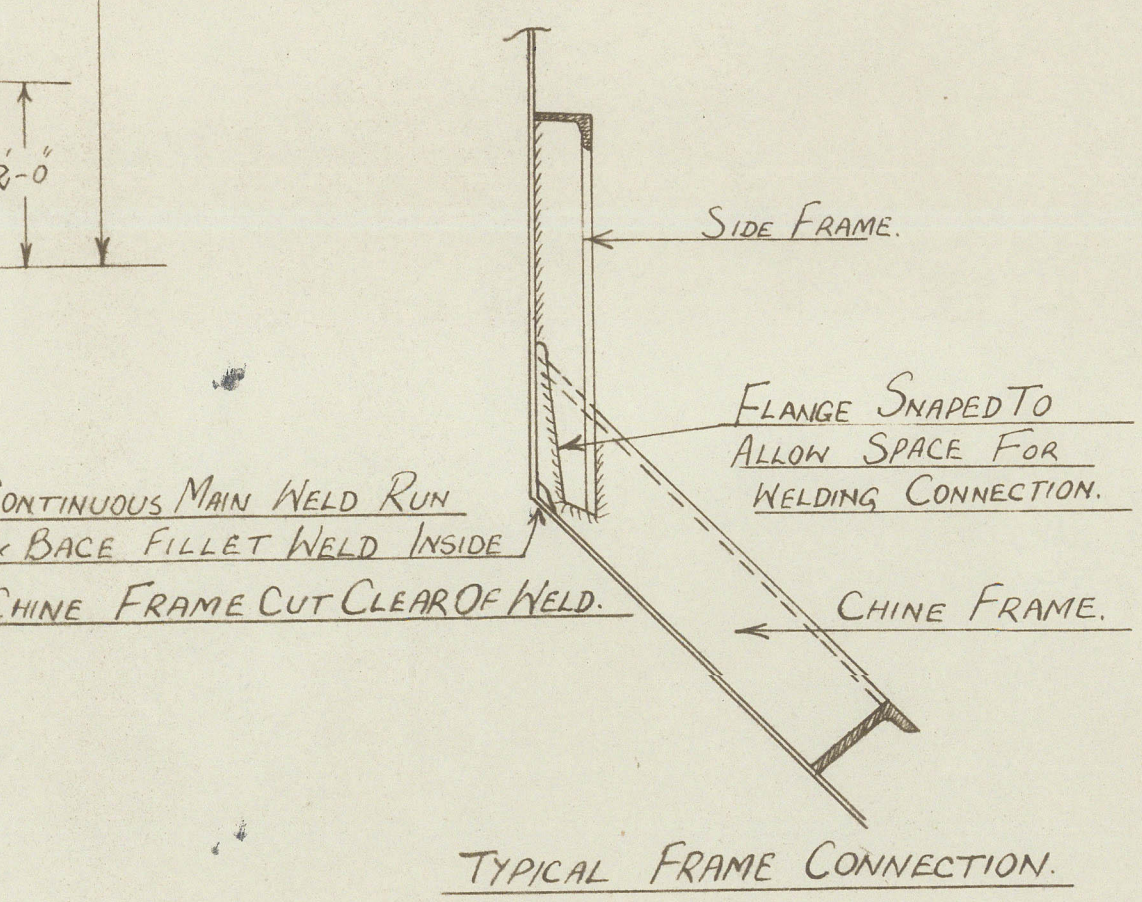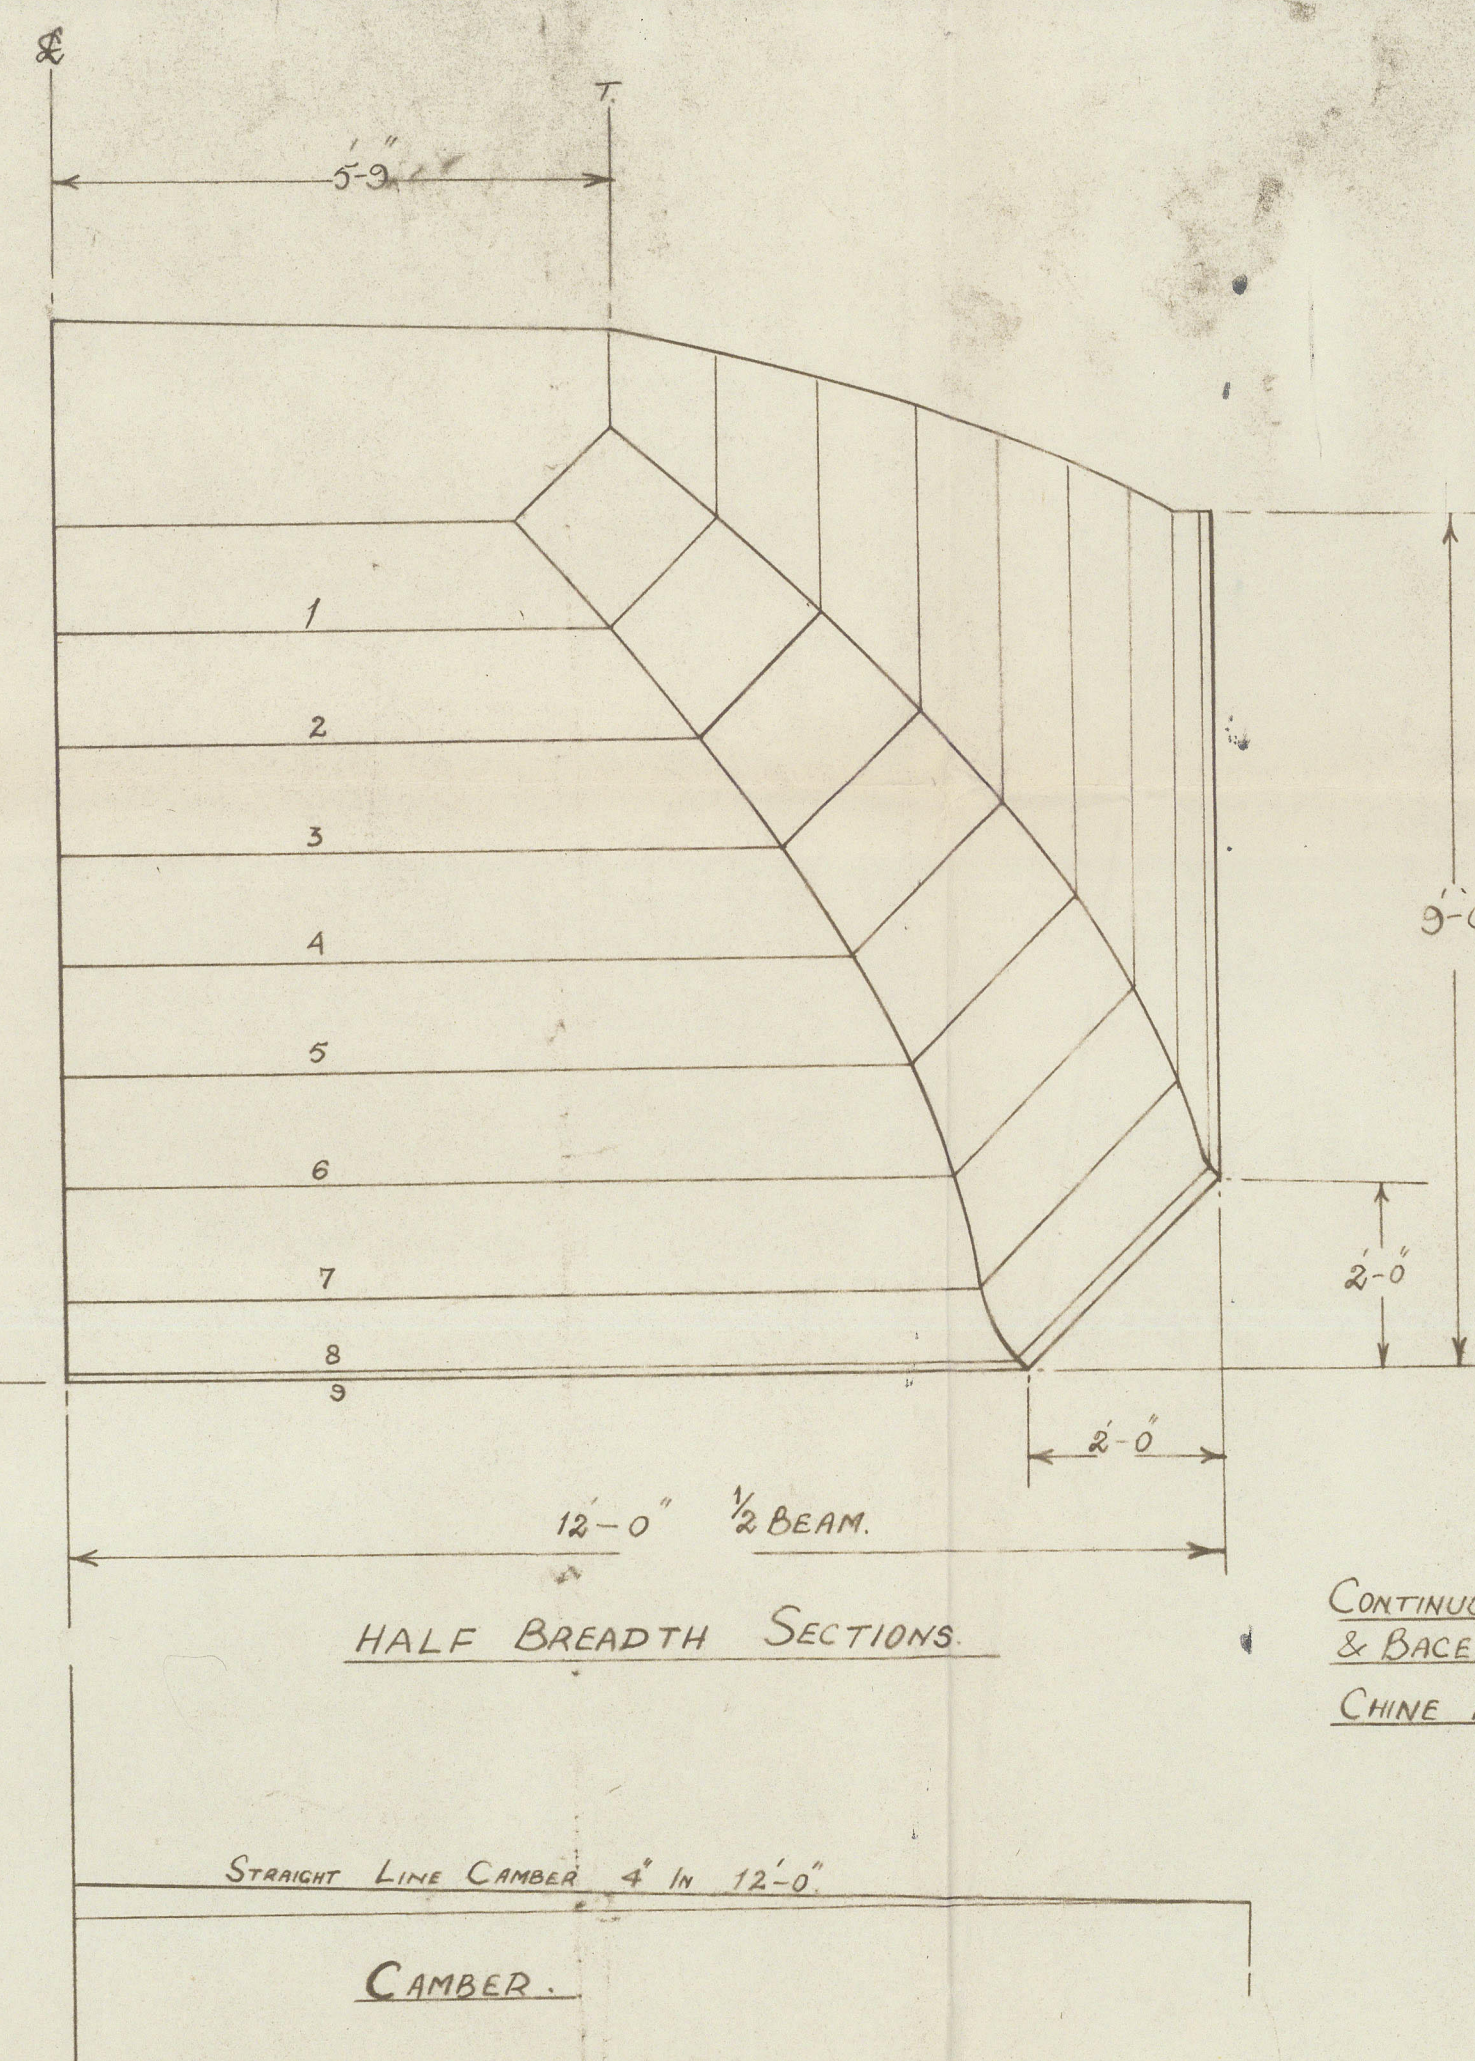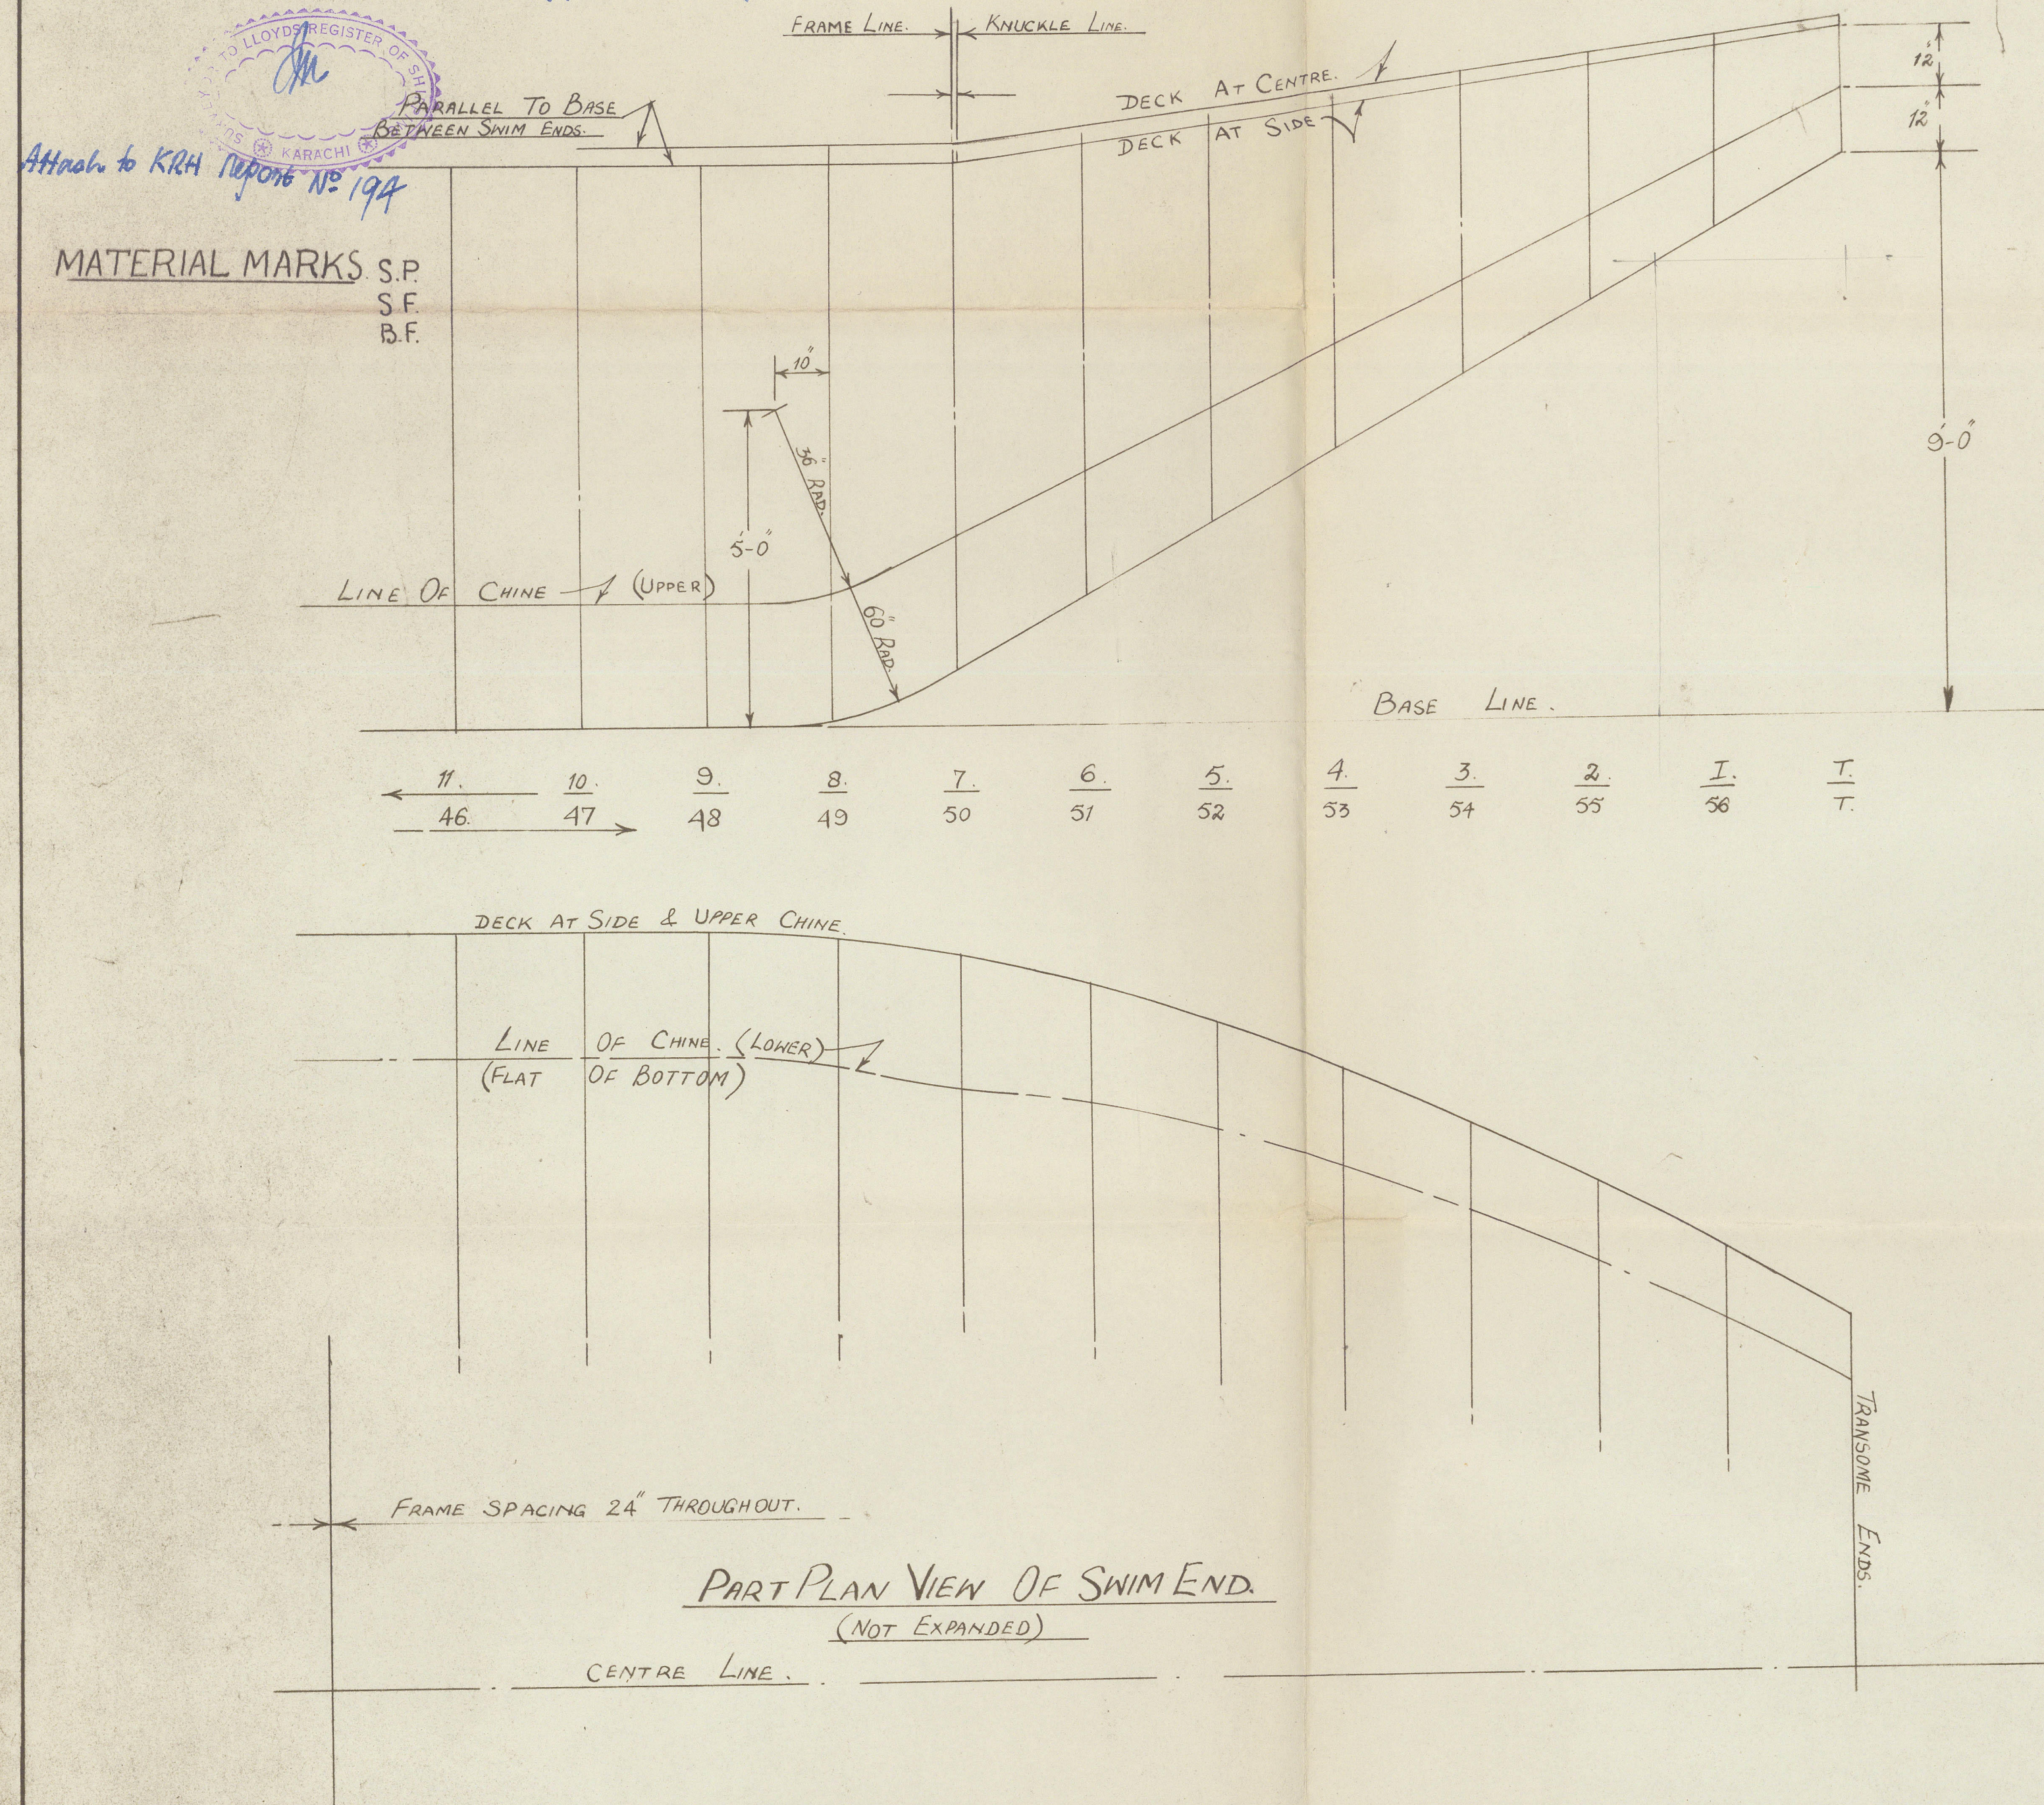

BUILDER C & C LTD KARACHI.
DATE OF BUILT
YARD No.